

SURRY COUNTY HEALTH DEPARTMENT

(SEPTIC TANK) IMPROVEMENTS PERMIT AND CERTIFICATE OF COMPLETION/OPERATION

New Repair Existing

THIS PERMIT IS VOID FIVE YEARS AFTER DATE OF ISSUE

Owner or Contractor KATHRYN G. Powell Permit No. THP13293-03

Location Highway 712 Cornhill Rd. TL Court. id.

Subdivision Name _____ Lot No. _____ Section/Block _____

	Yes	No
Mobile Home _____	(<input checked="" type="checkbox"/>)	()
House _____	()	(<input checked="" type="checkbox"/>)
Business _____	()	(<input checked="" type="checkbox"/>)
Washing Machine _____	(<input checked="" type="checkbox"/>)	()
Dishwasher _____	(<input checked="" type="checkbox"/>)	()
Garbage Disposal _____	()	(<input checked="" type="checkbox"/>)

Lot Size 41.15A' Parcel # _____
 Site Classification
 () Suitable
 () Pfov. Suitable
 () Unsuitable

No. of Bedrooms 3

COMMENTS: _____

Max. No. Employees _____ #Shifts _____

Water Supply: _____

A. Individual Well

Estimated Sewage Flow 360 GPD

B. Governmental System _____

Application Rate 4 G/SF/D

C. Community System _____


Sanitarian Chris Niggin R.S.

D. Other _____

_____ Basement with Plumbing

_____ Basement without Plumbing

No Basement

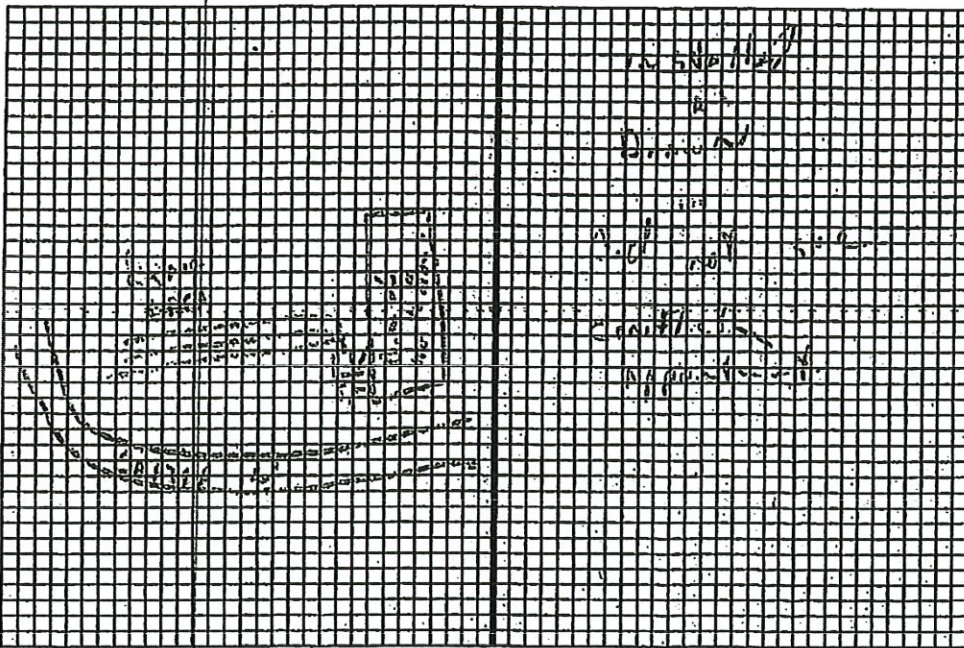

Size of Tank 1000 gals.
 Size of Pump Tank NA gals.
 Nitrification Field 700 sq. ft.
 No. of Lines 3
 Width of Lines 3'
 Length of Lines 100'
 Depth of Stone 12"
 Other _____
 Installed by VAS

Comments: Follow contour. Do not cut on 11' over system area. Keep well 100' from system.

The undersigned person hereby agrees that he has read the foregoing application and that the contents of same are true. It is understood that any permit herein shall be void and of no effect if any of the above facts are not true.

Date of Application 11-22-93

Certification of Completion/Operation by Chris Niggin R.S. Date 1-11-94

Construction must comply with all other applicable State and Local Regulations.

NOTICE: System installed according to Rules and Regulations but not a guarantee that it will function satisfactorily for any given period of time.

Powell, Kathryn G.

(2) (R) (E)