

EFFECTIVE JAN. 1, 1968

CHECKER MOTORS CORP., KALAMAZOO, MICH.

735

SHEET NO.

DWN DENER  
CHK DE 2-2-68

GRAPHIC ILLUSTRATION


DATE

FRONT SUSPENSION

MODEL B-11 CHASSIS

150 B-12W B-12E

- 1 92845-L.H.
- 2 92844-R.H.
- 3 18100 (4)
- 4 92270-AS REGD.
- 5 92271-AS REGD.
- 6 13101 (4)
- 7 120371 (4)
- 8 92313-L.H.
- 9 92312-R.H.
- 10 92261 (4)
- 11 92355 (4)
- 12 92273-AS REGD.
- 13 92264 (4)
- 14 92263 (4)
- 15 124944 (8)
- 16 94399 (2)
- 17 98123 (2)
- 18 70285 (2)
- 19 103385 (2)
- 20 702735 L.H.
- 21 70273 G.R.H.
- 22 181707 (4)
- 23 94290 (4)
- 24 131101 (4)
- 25 181659 (4)
- 26 186417 (4)
- 27 120369 (4)
- 28 92293 (2)
- 29 701013
- 30 92475 (2)
- 31 106417 (4)
- 32 180122 (4)
- 33 92474 (2)
- 34 704180 (6)
- 35 92145 (6)
- 36 92475 (2)
- 37 704151 (2)
- 38 704182 (2)
- 39 442828 (2)
- 40 701964 (2) STD.
- 41 92294 (2)
- 42 181608 (4)
- 43 120214 (4)
- 44 704142 (4)
- 45 94408 (4)
- 46 442828 (2)
- 47 701973 (2) HD.
- 48 702327 (2) 6CK
- 49 92292 (2) Y-8
- 50 701915 L.H. "C" (SUPERSEDES 95197)
- 51 701916 R.H. "C" (SUPERSEDES 95198)
- 52 703191 L.H. "VA" (SUPERSEDES 95767)
- 53 703192 R.H. "VA" (SUPERSEDES 95768)
- 54 94375 (2)
- 55 94415 (2)
- 56 94567 (2)
- 57 94365 (2)
- 58
- 59 701592 (2)
- 60 94363 (2)
- 61
- 62 94450 (10)
- 63 701360 (2)
- 64
- 65 702669 (2)
- 66 702988 (2)
- 67 ~~701973 (2) HD.~~
- 68
- 69 701440 (2)
- 70 ~~701973 (2) HD.~~

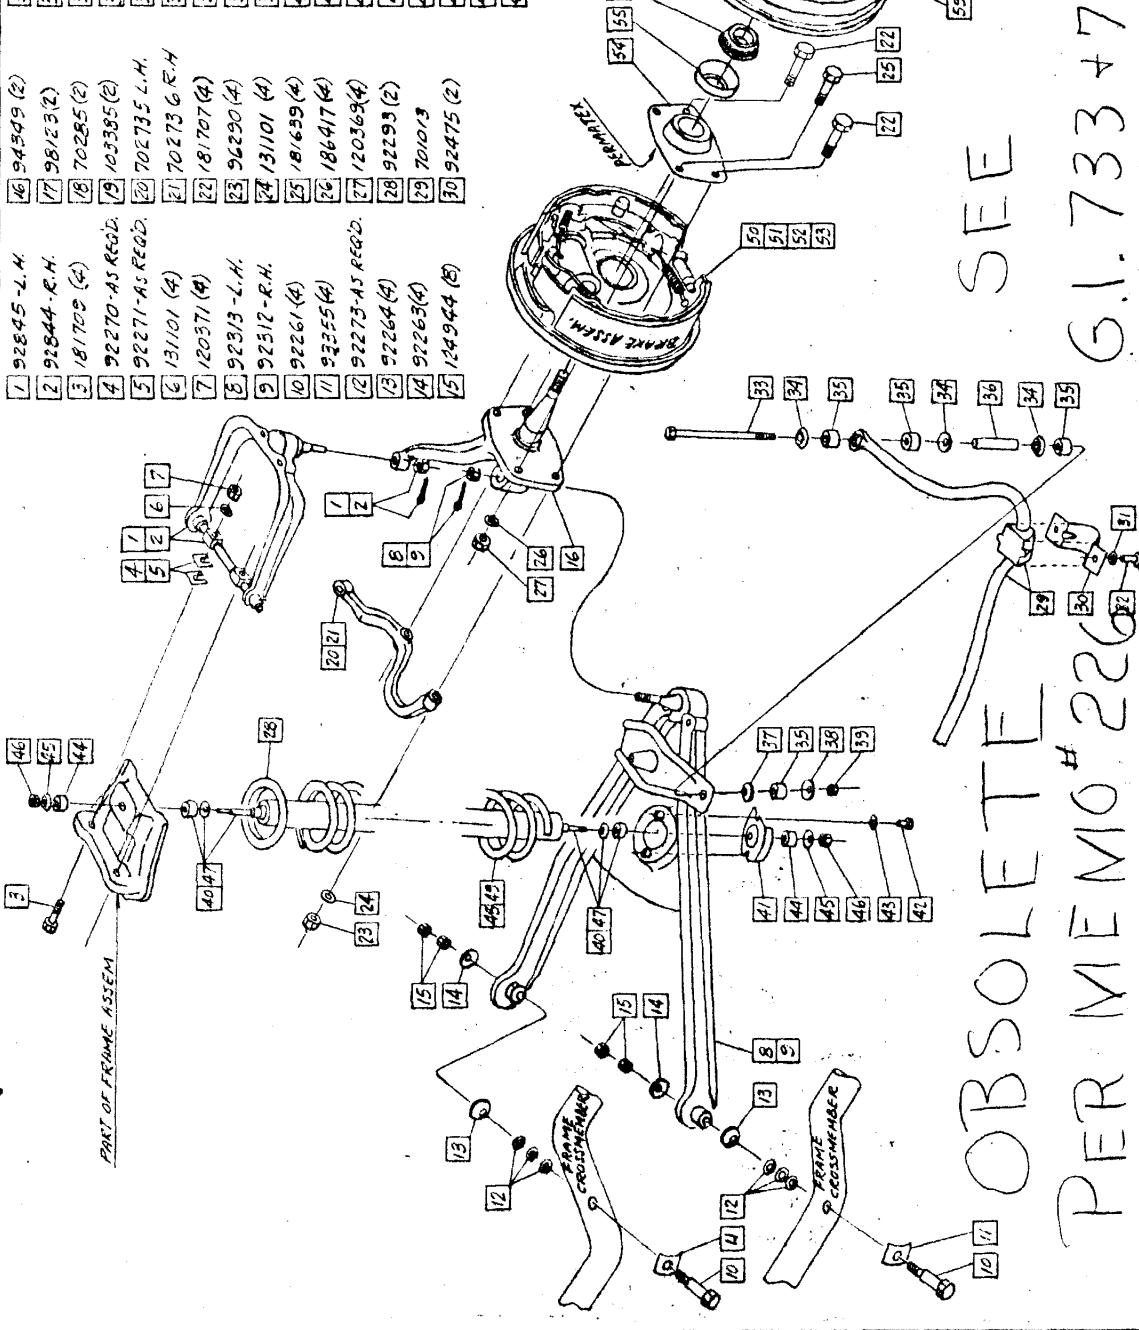

SEE  
61.733+734  
OBSOLETE #226  
PER MEMO