



Heritage

KMR.CDD.MaQ.1920-1921.01

Building Completion Report.

MUNICIPAL OFFICE,

Karachi, 15th Feb 1921.

To

THE ENGINEER,

KARACHI MUNICIPALITY.

SIR,

I beg to report, the building work on plot No. 64 Sheet
18 Mar/4 Quarter owned by Mr. Narindas Likhanda
is completed according to the plan approved by the Municipality. Orders are
requested to file the correspondence.

File
S

Yours obediently,

Building Surveyor "B" Section,
Karachi Municipality.



Heritage

KMR.CDD.MaQ.1920-1921.01

Form No. 6-300-25-9-20.

No. L. S. 6623

OF 192 .

MUNICIPAL OFFICE,

Karachi, 18 // 1920.

MEMO:

Building Surveyor Section B is informed
that Mr. Naraindas Tukandas has been permitted
to make additions & alterations on
his house
on plot No. 64. A. 8. Alli Kukur Street
market Quarter report should be made to the
Undersigned when the house is completed.

M. I. MECH. E.,


Ag. Engineer,
Karachi Municipality.

DR 103N433

PLAN SHOWING ADDITIONS & ALTERATIONS
ON SURVEY NO 64 & 65A SHEET A-18 MARKET Q.
SCALE 8"=1"


BLOCK PLAN
SCALE 20"=1

10275

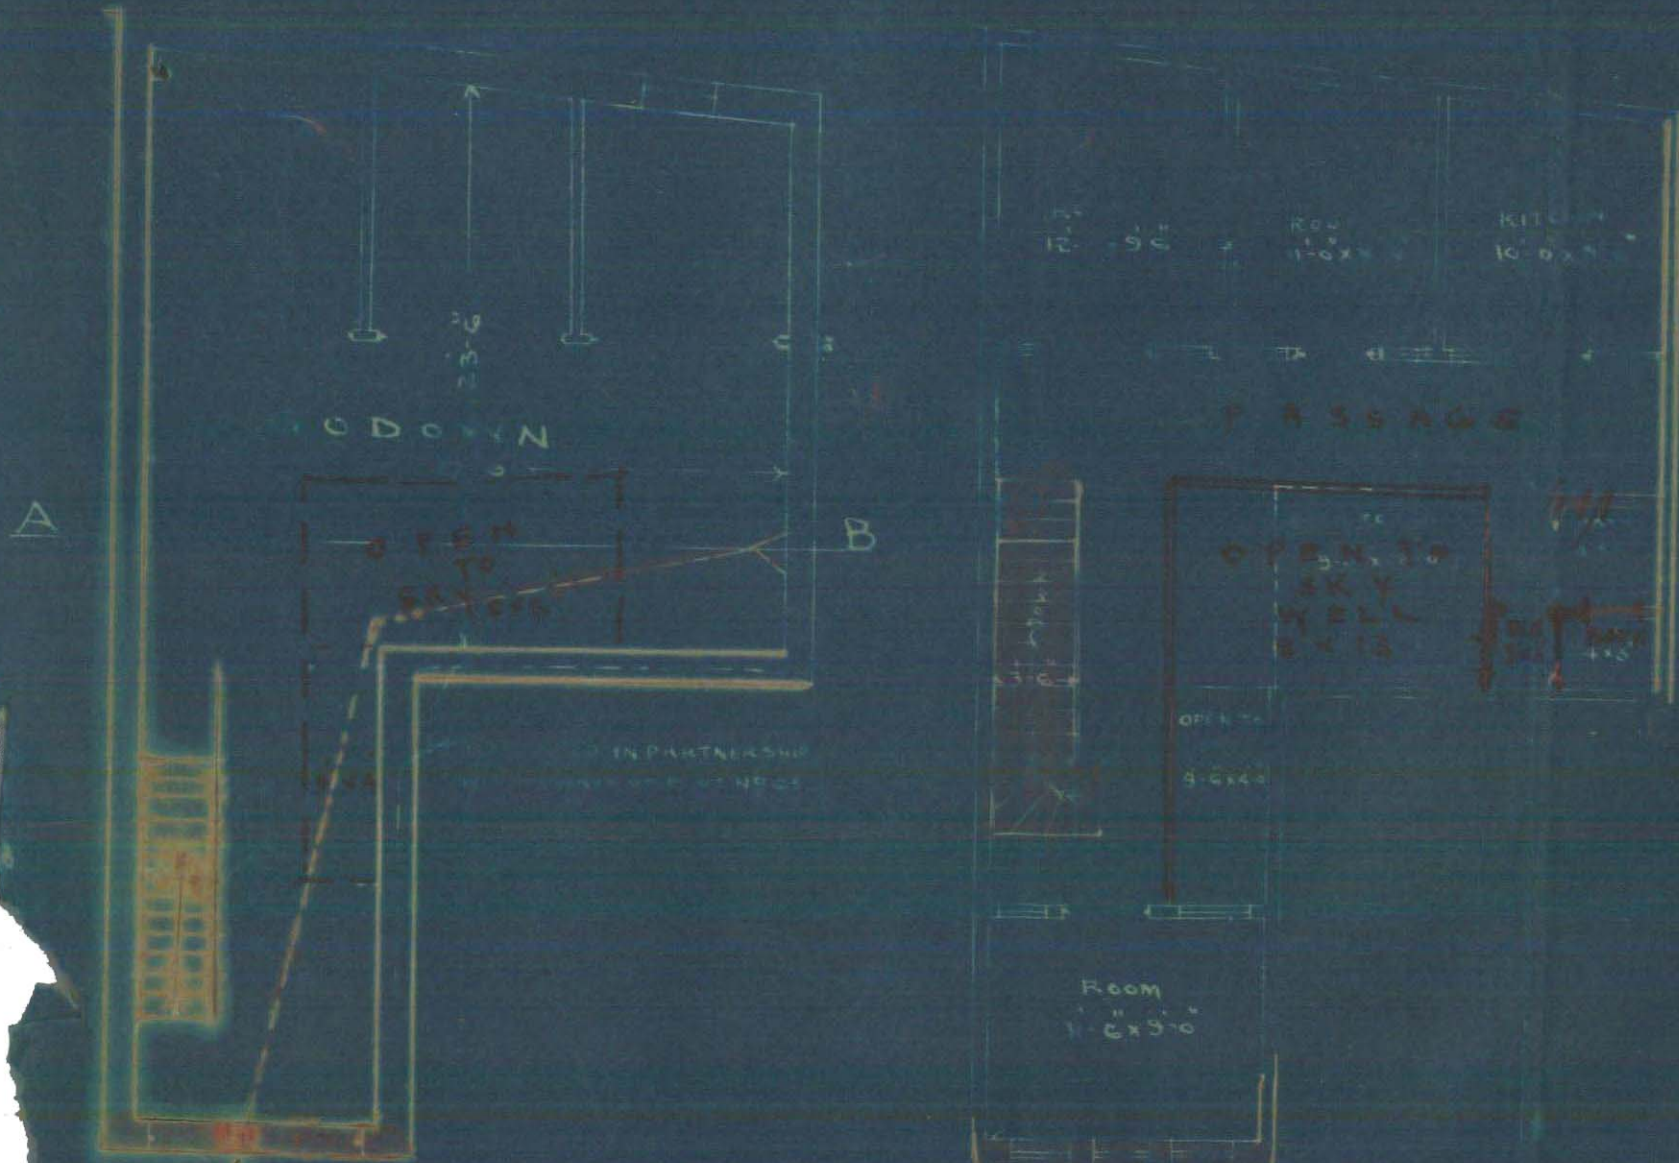

GRO PLAN


FIRST FLOOR PLAN

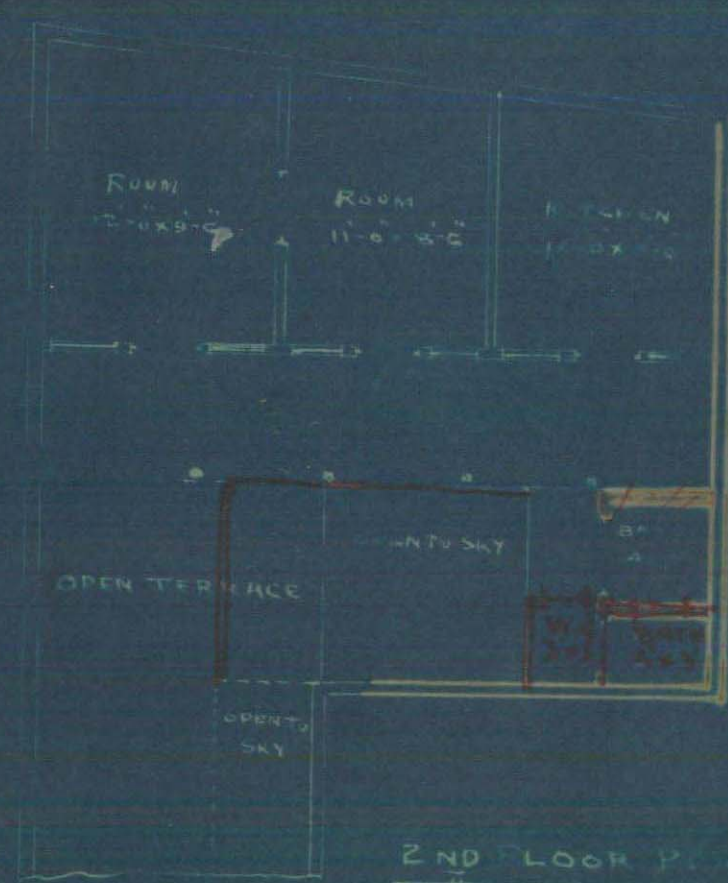


2ND FLOOR PLAN



ALLI KABAR STREET
13'-0" WIDE

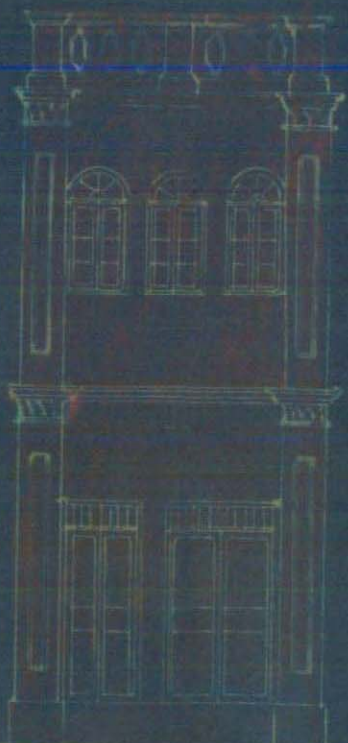

FRONT ELEVATION

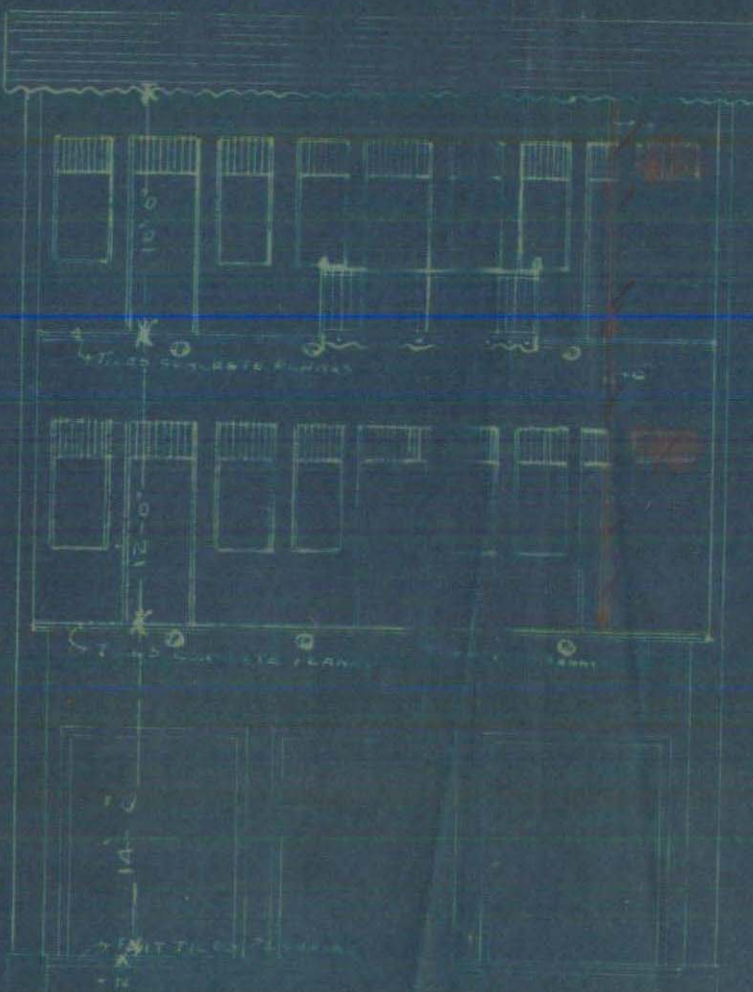

SECTION A-B

J. A. Shrestha & Co. Architects & Surveyors