

No L.S. 8607 of 1921

Municipal Office

Karachi 11th February 1921
12

M E M O.

With reference to his application dated the 24th Instant Mr: Trikamdas Prifamdas owner of Plot No 115A23 Napier Quarter is informed, there will be no objection to the alterations made by him but he should not do any work contrary to the Plan in future without permission.

D. Barington Brown.

M. C. A. M Inst. C. E.

ENGINEER

H. Karachi Municipality*Panoo Dulal St.**Sir.*

The additions & alterations have been completed according to the approved plan. This may be filed please

*26/5/21**Yours obedt.**W. B. H.**File**W.*

M. C. A. M. I. C. E.

Engineer,

Karachi Municipality

Memo: —

With ref to his app dated the 24th
ultimus. Mr Triunfo Prianda
owner of plot no 115 A23 Napier 9th
is ~~informed~~, there will be no obj^s
to the alterations made by him
but he should not do any work
contrary to the plan in future
without permission

9/2

SD

Enc and Enc

By.

28th January 21

3-1

The Engineer (~~& Chief Officer~~)

Karachi Municipality

Dear Sir,

I am in receipt of your letter No.L.S.8179 of the 26th inst.

and in reply beg to state that the plan of my plot no.115 SheetA.
23 shows a sink on the first floor, and a W.C. on the second floor,but as I have been told by the Municipal ~~people~~ ^{Contractor} that the waterfor the flushing tank, can not be had to such a height, I have ~~the~~

therefore made the vice versa, and request your good self to kind

-ly ~~to~~ allow the same.

Thanking you in anticipation,

Yours faithfully

Tikandas Pritandas.

11/10
Landowner
for 7c a report.
H3

M. Pritas
7c report.
OK. 5/2

Submitted with the
and report. there seems
no objection to allow him
to proceed with the
work.

7/2/.

Wendell

No objection

8/2

[Signature]



Form No. 17-400-4-7-19.

No. L. S. 8177 OF 1921.

MUNICIPAL OFFICE,

Karachi, 24th Jan 1921.
23

Memo.

Mr. Trikando Pridandos
~~Messrs.~~~~is~~
~~are~~ informed that it is observed that in building~~his~~
~~their~~ Building on Plot No. 115
~~Nos.~~Survey Sheet A 23, rapio Quarter,~~he is~~
~~they are~~ deviating from the approved plan, He is erecting
W.C. on the 1st floor in place
of sink.

Instructions are therefore given to ~~him~~
~~them~~ to at once stop the work and
make the building in conformity to the approved plan, or steps will be taken
under the Act.

A.M. INST.C.E.

48 Engineer,
Karachi Municipality.



Heritage

KMR.CDD.NaQ.1920-1921.03

No. L. S. 5858 OF 1920

Form No. 6.

MUNICIPAL OFFICE,

Karachi 7/10 1919

12

MEMO :

Building Surveyor Section B is informed
that Mr. Likamdas Putamidas has been permitted
to make additions & alterations on
his house
on plot No. 115 A23 Lamoodalal Street
Napuri Quarter report should be made to the
Undersigned when the house is completed.

M. K. K. K.


A.M. INST., E.E.,

as Engineer,
Karachi Municipality.



SITE PLAN

SCALE 20' = 1" INCH.

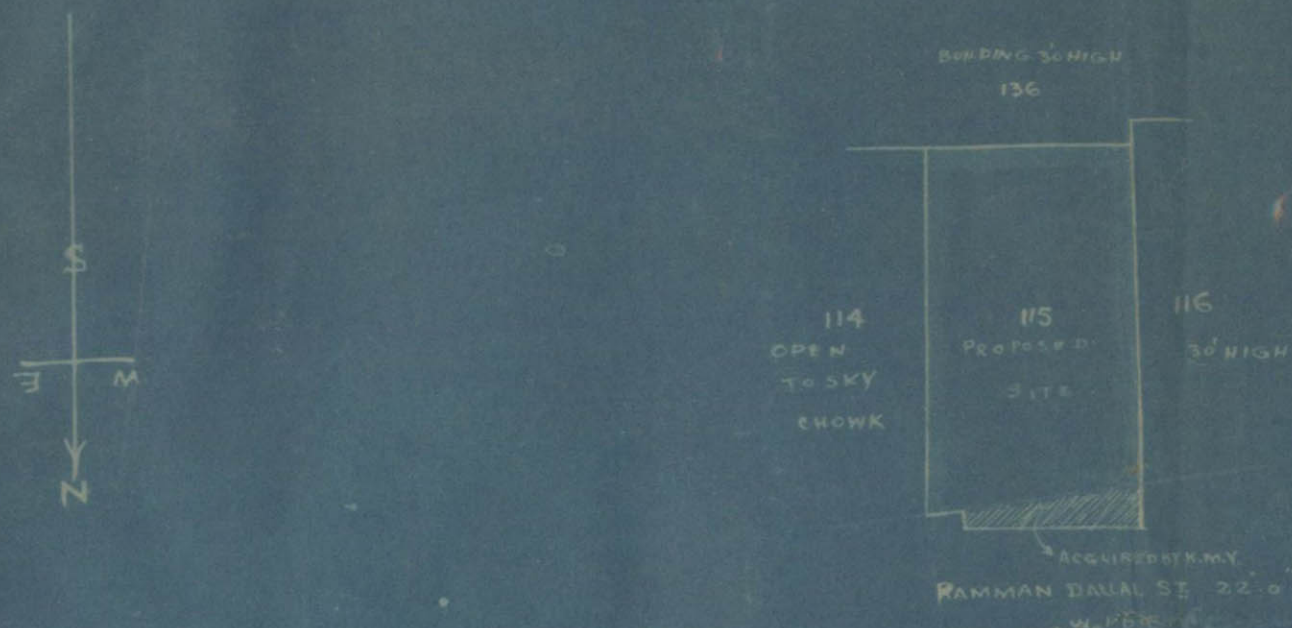

APPROVED


M. J. F. T.
Acting Engineer,
Karachi Municipality.

PLAN SHOWING ALTERATION ON EXISTING
BUILDING ON PLOT No 115 SHEET A-23

NAPIRE QUARTER


SCALE 8' = 1" INCH.

NO. 245

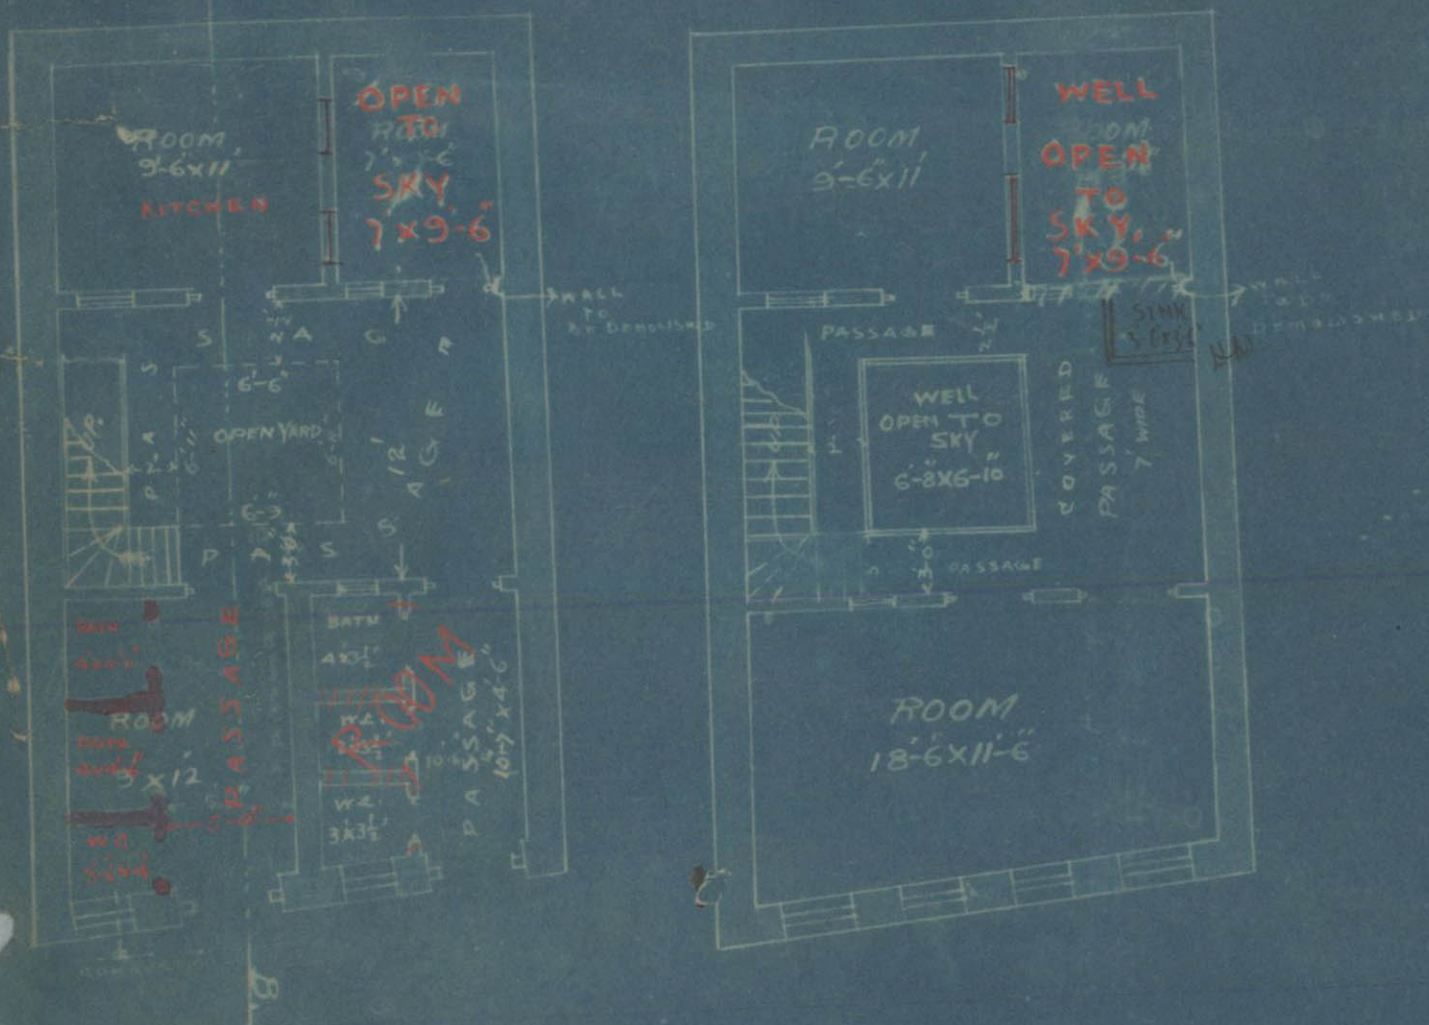


GROUND PLAN

1ST & 2ND FLOOR PLAN

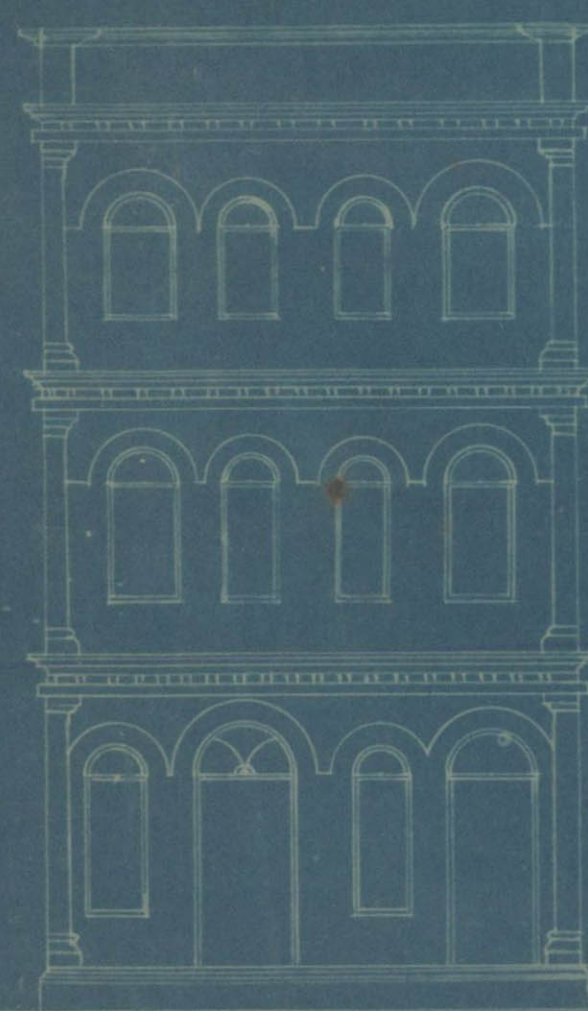

ELEVATION

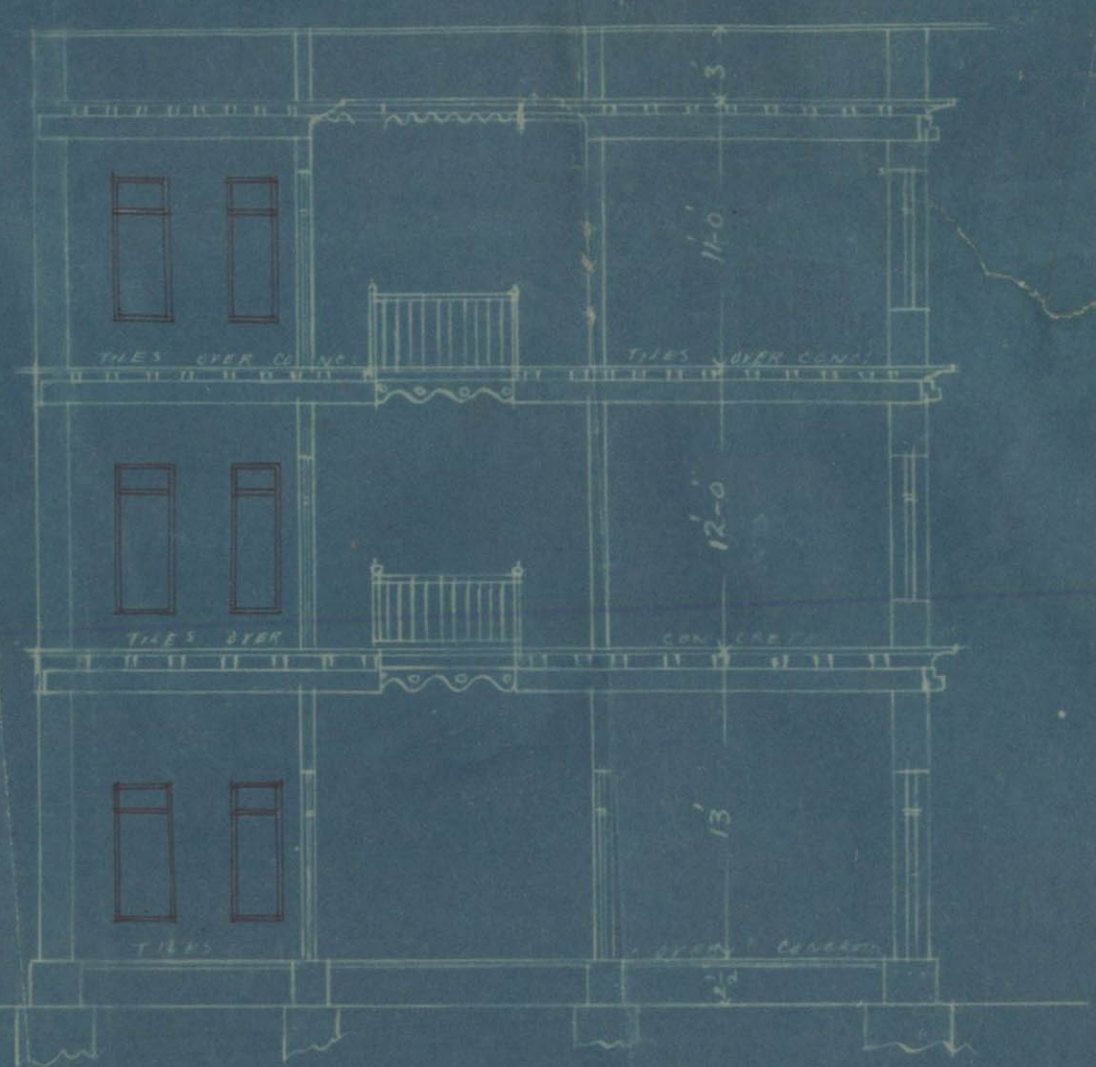

SECTION ON A-B.

PATILAK BCC
ARCHITECTS & SURVEYORS
KARACHI.