

No. 9.52 of 1917

H-1

GHULAMALI G. CHAGLA.

Karachi, 13th March 1917


To,

J. C. L. Verley, Esquire, A.M. I. C.E.,

Engineer,

Karachi Municipality,

Karachi.

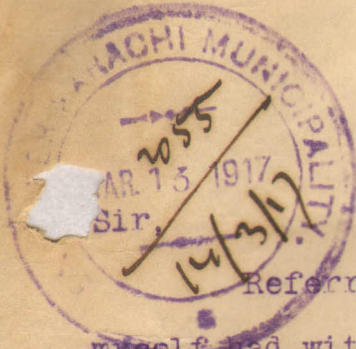

Referring to the interview my architect Mr. Somake and myself had with you the other day pointing out the architectural features of the mosque proposed to be built on Rampart Row, I beg to send herewith a set of three plans for the same with the application on the printed form, and shall be obliged if you will be good enough to grant permission to build same at an early date.

I beg to remain,

Sir,

Your most obedient servant,

Ghulam Ali Chagla

Mr. Beja  
Shoraka Ho.14<sup>3</sup>/<sub>17</sub>

DZ



H-1-2

Forwarded to the A.O.C.  
The tower to the north  
in Khoja Lane is  
more than double the  
width of the lane, but  
as this is merely  
for ornamental  
purposes to observe  
the symmetry of the  
building, there  
would appear to  
be no objection  
to approve the  
plan.

V. 25/8/17

MU  
25/8

The objection  
arise of plan  
Man - the

27  $\frac{3}{17}$

Inform owner & C.O.C  
no objection

V. 28/8/17



H-2

No. E 1463 of 1917.

Municipal Office.

Karachi. 22nd February 1917.

23rd

MEMO / -

Referring his application dated 13th February 1917 with plans for the proposed building on plot No. 116, G-6 Market Quarter Mr: Dedar Pragji is informed that the W.C. as shown on the plan is contrary to the bye laws and the space open to sky is inadequate for a three storied building.

The plans are herewith returned for amendment.

A. M. Inst. C. E.,

E n g i n e e r

Karachi Municipality.

L

2/4/17

Memo

Referring to appl. of 13/4/17  
with plans for the proposed bldg.  
on plot No 116 C-6 Market St. M.  
Dedar Praggi is informed that the  
V.C. <sup>as shown on the plan</sup> is contrary to the Byelaws  
& the space of ~~the~~ <sup>the</sup> ~~is~~ <sup>is</sup> ~~contrary~~  
~~to the Byelaws~~ is inadequate for  
a three storied bldg.  
The plans are returned herewith for  
amendment.

J. A. H. Kerley

A.M.Inst., C.E.,  
Engineer  
Karachi Municipality



200-12-7-16

Form No. 1.

Karachi, 13/2 1917.

## NOTICE UNDER SECTION 96 OF ACT III OF 1901.

To

THE CHIEF OFFICER AND CHIEF ENGINEER,  
KARACHI MUNICIPALITY.


Sir,

I beg to inform you that I intend building a structure  
on plot No. 116Survey Sheet No. C 6 situate in Kutchi wada  
lane Street, market Quarter.As required by the rules of the Municipality, I beg to submit herewith a  
plan of the same for your approval.


I beg to remain,

Sir,

Your most obedient servant,

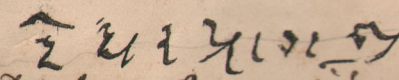  
Signature of the applicant.No. G. 1618 of 191MUNICIPAL CHIEF OFFICER AND  
CHIEF ENGINEER'S OFFICE,Karachi, 13 - 2 - 1917.


Forwarded to the Municipal Engineer for favour of disposal.

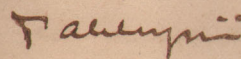

M. INST. C. E.,

Chief Officer and Chief Engineer,

Karachi Municipality.

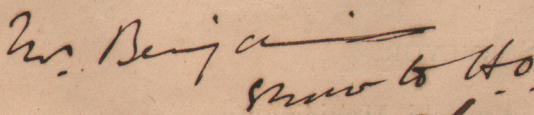  
13/2

H-4-2



KMR.CDD.MiQ.1917.01(2-3)(h)

2

No. E. 1192 of 1917

MUNICIPAL ENGINEER'S OFFICE.

Karachi, 13<sup>th</sup> February 1917

MEMO.

The above application is forwarded to the Municipal Health Officer for favour of report.

*W. G. E.*

Engineer,  
Karachi Municipality.

MUNICIPAL HEALTH OFFICER'S REPORT.

Returned to the Engineer, Karachi Municipality, with the following remarks:—

*No objection*

*D. P. H.*

D. P. H. (London),  
Health Officer,  
Karachi Municipality.

Date 17-2-1917

No. E. 1192 of 1917

MUNICIPAL ENGINEER'S OFFICE.

Date 19/2/17 1917

Forwarded to the Building Surveyor for report

*Clarice*

A. M. I. C. E.,

for Engineer,  
Karachi Municipality.

Through

THE LAND SURVEYOR,

Karachi Municipality.



Heritage

KMR.CDD.MiQ.1917.01(2-3)(h)

## BUILDING SURVEYOR'S REPORT.

Applicant's name

Sachin Ray

Whether he is the owner of the plot on which it is proposed to build

Yes

Plot under whose control

Government

Whether it is permanent or temporary

Permanent

The work proposed

B.C. addition

Building Surveyor's report

Sir,

I beg to report that the work is not in accordance with the bylaws.

Request order

Date 14/2/1917.

Yours ably  
S.R. Khanna  
Building Surveyor.

Submitted through the Land Surveyor

## LAND SURVEYOR'S REPORT.

Does the plot come under Alignment

No

Area of plot

Area under Alignment

Remarks

Sir, With reference to this I beg to report that the work is not in accordance with the bylaws and when the drain is laid out it should be cemented.

Yours ably  
S.R. Khanna  
Land Surveyor.

Date 17/2/1917.

## ORDERS OF THE ENGINEER.

The W.C. is contrary to the bylaws.

The space open to sky is inadequate for a three storied building.

No objection

11/2/17

17/2/17  
A. M. I. C. E.,  
Engineer,  
Karachi Municipality.

33

H-4-4



Heritage

KMR.CDD.MiQ.1917.01(2-3)(h)

No. E. 3785<sup>4</sup> of 1917.

MUNICIPAL ENGINEER'S OFFICE,



Karachi 8<sup>th</sup> May

Submitted to the Managing Committee with a recommendation that the plan be approved,

Forwarded

*Speckham*

*J. G. L. Verley*

A. M. I. C. E.,

Engineer,

Karachi Municipality.

Through Chief Officer & Chief Engineer,  
Karachi Municipality.

*ml*

The CHIEF OFFICER & CHIEF ENGINEER.

KARACHI MUNICIPALITY.

RESOLUTION OF THE MANAGING COMMITTEE.

Resolution No. \_\_\_\_\_ dated \_\_\_\_\_

Area of plot  
Area under alignment  
Remarks

Date

ORDERS OF THE ENGINEER

Copy to the Surveying Department


PLAN OF PROPOSED MOSQUE  
TO BE ERECTED ON PLOTS NO 1 & 2, SHEET A.I. OFFICE OF KARACHI  
SCALE 8 FEET TO ONE INCH

*M. S. A. Samake*  
27.2.1917.  
M. S. A.  
(LONDON)  
ARCHITECT  
KARACHI

APPROVED.

*L. A. H. Kirby*

Engineer,  
Karachi Municipality.

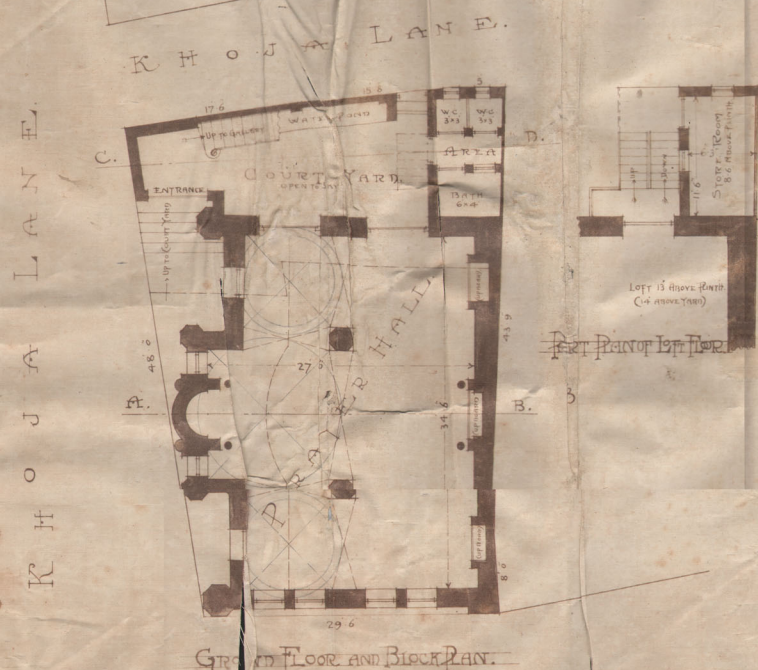


GROUND FLOOR AND BLOCK PLAN.


SITE PLAN.  
SCALE 20 FEET TO ONE INCH.



MART ROW.

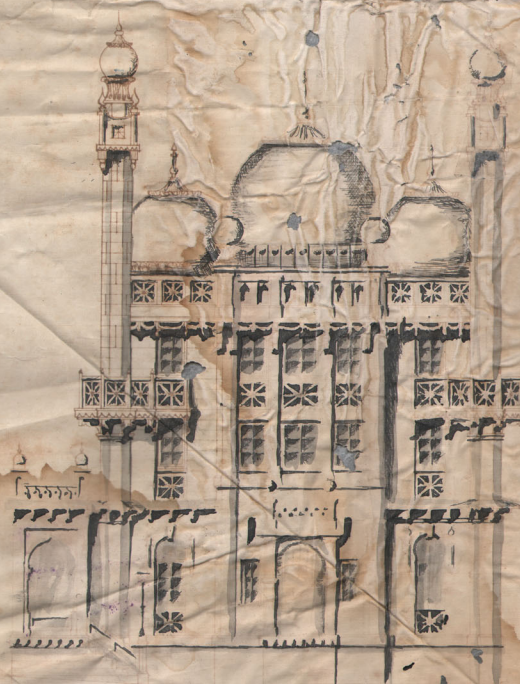


ELEVATION TO KHANJA LANE.

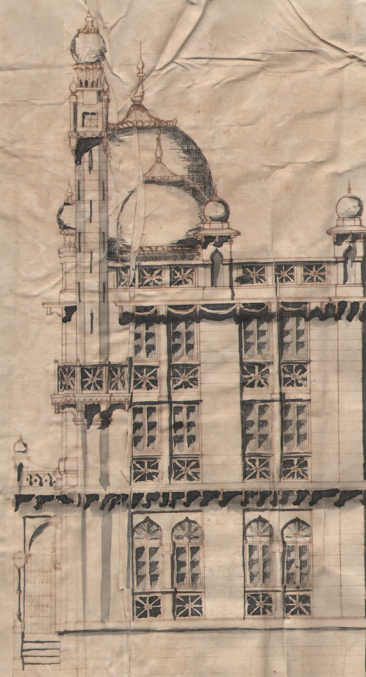

ELEVATION TO RAMPART ROW.



SECTION ON LINE A.B.

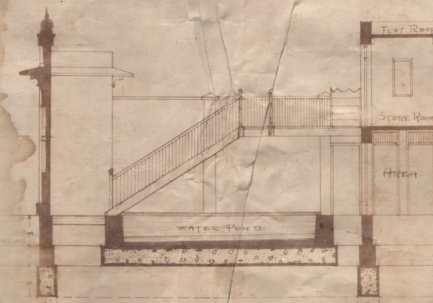

SECTION ON LINE C.D.

*Amir ul Uloom  
19th March 1917*