



200-12-7-16

Form No. 1.

Karachi,

6 October 1916

NOTICE UNDER SECTION 36 OF ACT III OF 1901.

To

THE CHIEF OFFICER AND CHIEF ENGINEER,

KARACHI MUNICIPALITY.

SIR,

I beg to inform you that I intend building

stone

additional

on plot No. 4A

Survey Sheet No. K-2 situate in

Street, Lyar Quarter.

As required by the rules of the Municipality, I beg to submit herewith a plan of the same for your approval.

I beg to remain,

Sir,

Your most obedient servant,

Narayandas Mohandas

Signature of the applicant.

P. P. P. & Co.

Architects & Surveyors.

Near Khodigarden

Karachi

No. G.//383 of 1916

MUNICIPAL CHIEF OFFICER AND

CHIEF ENGINEER'S OFFICE,

Karachi,

7/10 1916

Forwarded to the Municipal Engineer for favour of disposal.

2504
7-10-16
In Karachi
Plow 5th

7/10/16
T.

Ganesh

M. INST. C. E.

Chief Officer and Chief Engineer,

Karachi Municipality.

N-1-2

No. E.

²
8669 of 1916


MUNICIPAL ENGINEER'S OFFICE.

Karachi,

9th October 1916

MEMO.

The above application is forwarded to the Municipal Health Officer for
favour of report.

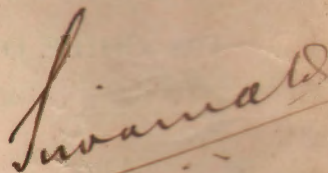


A. M. I. C. E.,

Engineer,

Karachi Municipality.

MUNICIPAL HEALTH OFFICER'S REPORT.

Returned to the Engineer, Karachi Municipality, with the following
remarks:—

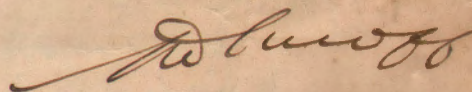No objection

D. P. H. (London),

Health Officer,

Karachi Municipality.

Date 12-10-1916.

No. E.


8669 of 1916

MUNICIPAL ENGINEER'S OFFICE.

Date

12th Oct 1916

Forwarded to the Building Surveyor for report

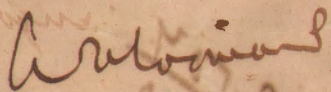

A. M. I. C. E.,

Engineer,

Karachi Municipality.

Through

THE LAND SURVEYOR,

Karachi Municipality.

N-1-3

3

BUILDING SURVEYOR'S REPORT.

Applicant's name Narayana Mohandas Kakani's
Whether he is the owner of the plot on which it is proposed to build Yes
Plot under whose control Government
Whether it is permanent or temporary Permanent
The work proposed Build a house.

Building Surveyor's report They report that now
there appears no objection, the applicant
has amended the plan according to the
instructions. The plan can be approved.
Respectfully,
Yr. Servant
J. J. [Signature]

Date 7/12 1916.

Building Surveyor.

Submitted through the Land Surveyor

LAND SURVEYOR'S REPORT.

Does the plot come under Alignment *No*

Area of plot

Area under Alignment

Remarks Sir. With reference to this I beg to report
that there is ~~no~~ objection by me to the pass.
with its ~~copy~~ answer

Yours truly
Nadir

Date 8-12-1916.

Land Surveyor.

ORDERS OF THE ENGINEER.

Inform C & C Towne no objection.

J. A. L. Kelly
12/17/6

N-1-4

237

No. E. 380⁵⁴ of 1917.

MUNICIPAL ENGINEER'S OFFICE

Karachi

8th May 1917



Submitted to the Managing Committee with a recommendation that the plan be approved.

For approval

Measham
M. Inst. C. E.
Chief Officer & Chief Engineer,
Karachi Municipality.

Through

ml

Verley
A.M.I.C.E.

Engineer,

Karachi Municipality.

The CHIEF OFFICER & CHIEF ENGINEER.

KARACHI MUNICIPALITY.

RESOLUTION OF THE MANAGING COMMITTEE.

Resolution No. _____ dated _____

Sir,

With reference to the attached plans
I beg to report that Plot No. 4 A K2
Lyari Qu. in the Land Register stands
in the name of 6 co-owners - The
applicant wants to bid on a portion
of this plot & thereby subdivide.
This should not be allowed.
Respectfully

Yrs. Obedt
S. N. S. and Co
13/10/16

Submitted to the Engineer for order.
Permission will be granted if the
applicant gets the plot subdivided
officially -

A. S. S. S.
18/10/16

Copy according to

B.S.
14/10

18/10/16

N-3-1

for
L. J. J. J.
6/12/16

Karachi Dated 6th Dec. 16

To,

The Engineer
Karachi Municipality
Karachi,

Sir,

With reference to your letter No E. 10269 of 1916 Dated 23rd ultimo. I beg to send herewith the plans of 4A K-2 Lyaree quarter amended in accordance with your instructions which your honour will kindly approve at your earliest convenience.

I beg to remain
Sir,

your most obedient servant

in some of the out
is Harayandas Mohandas
in some of the out
is Kallansing. J.

C/o Pathak & Co

Architect & Surveyors
near Khow Garden
Karachi



67072
6/12/16

6/12

Кавказская

9021

54

The answer

They to report that

now there seems no

objectum logice per se

with the COT course

Miss Ellis

the plan of A

Alnus incana in

various other things

18

10. 11. 1894

12. 10. 1880

8 404 21 1000 11

Handwritten text, likely bleed-through from the reverse side of the page, including the words "Handwritten" and "Notes".


100




Heritage

KMR.CDD.MiQ.1917.01(2-3)(n)


PLAN OF PROPOSED ADDITIONAL STORIES TO BE CONSTRUCTED
ON PORTION OF PLOT NO. 4A, K-2 LYAREE QUARTER
— SCALE 1/8" = 1" —

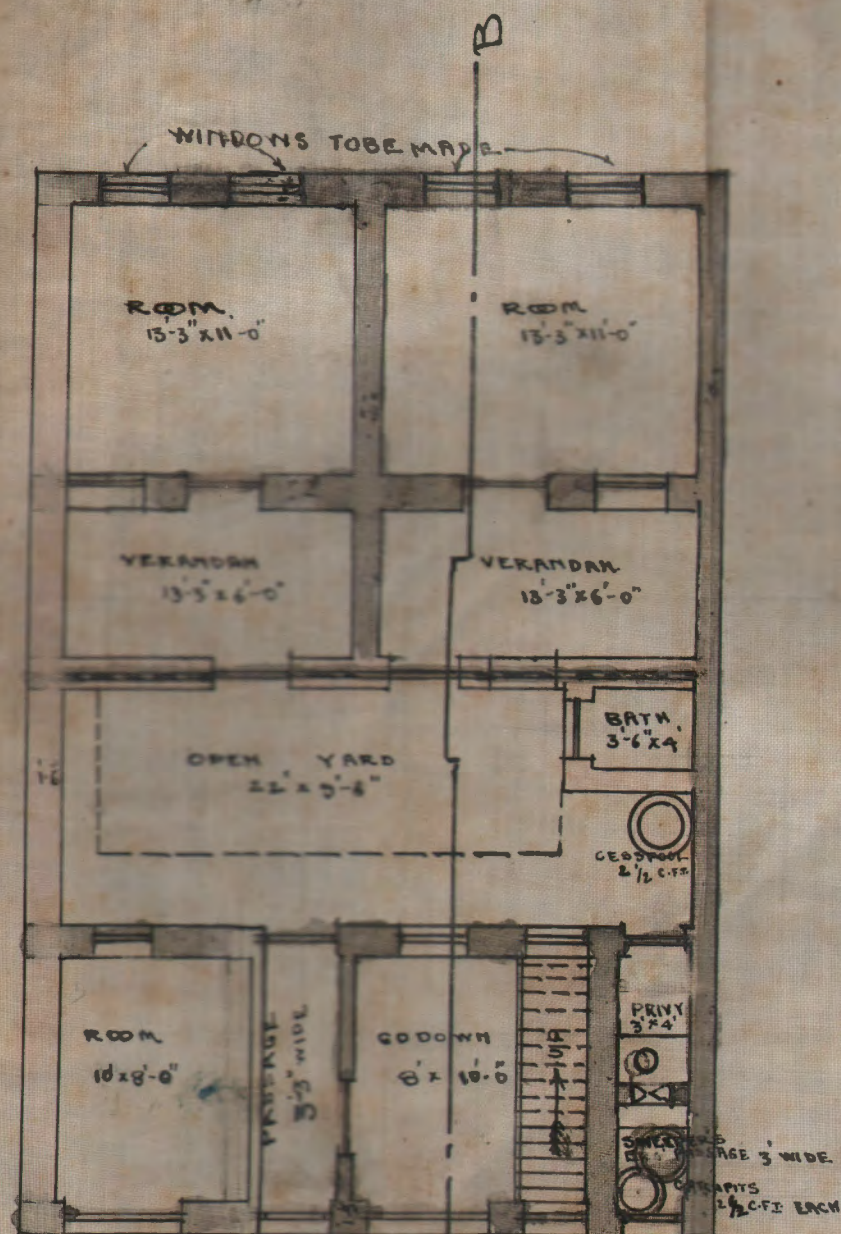

— GROUND PLAN —

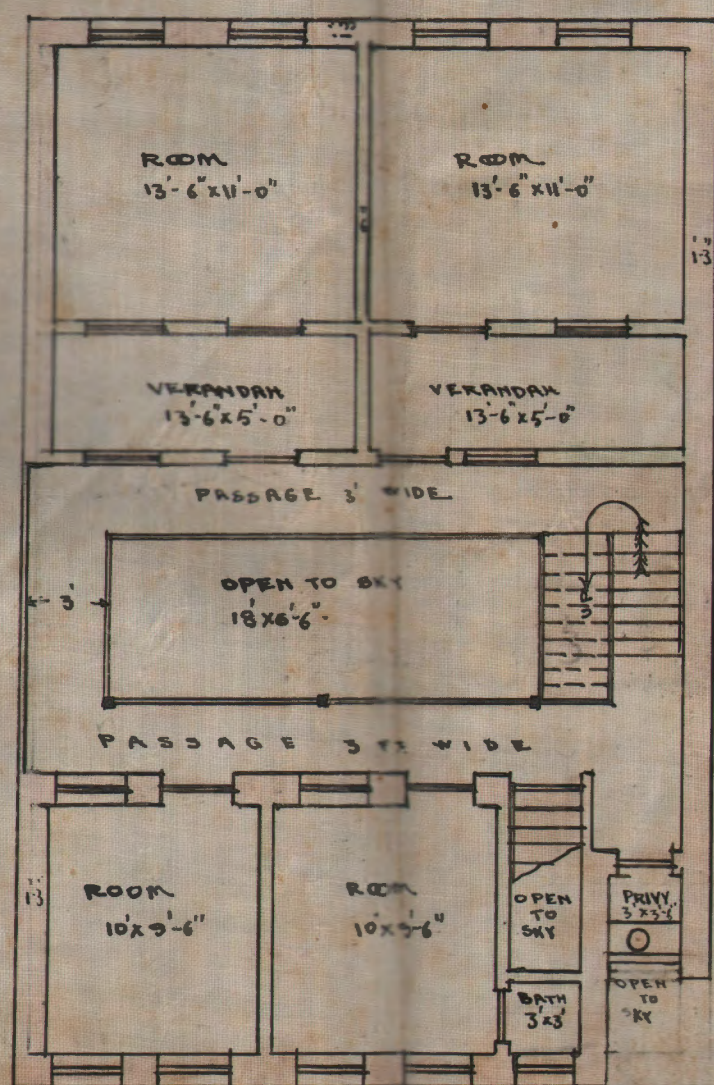

— FIRST FLOOR PLAN —

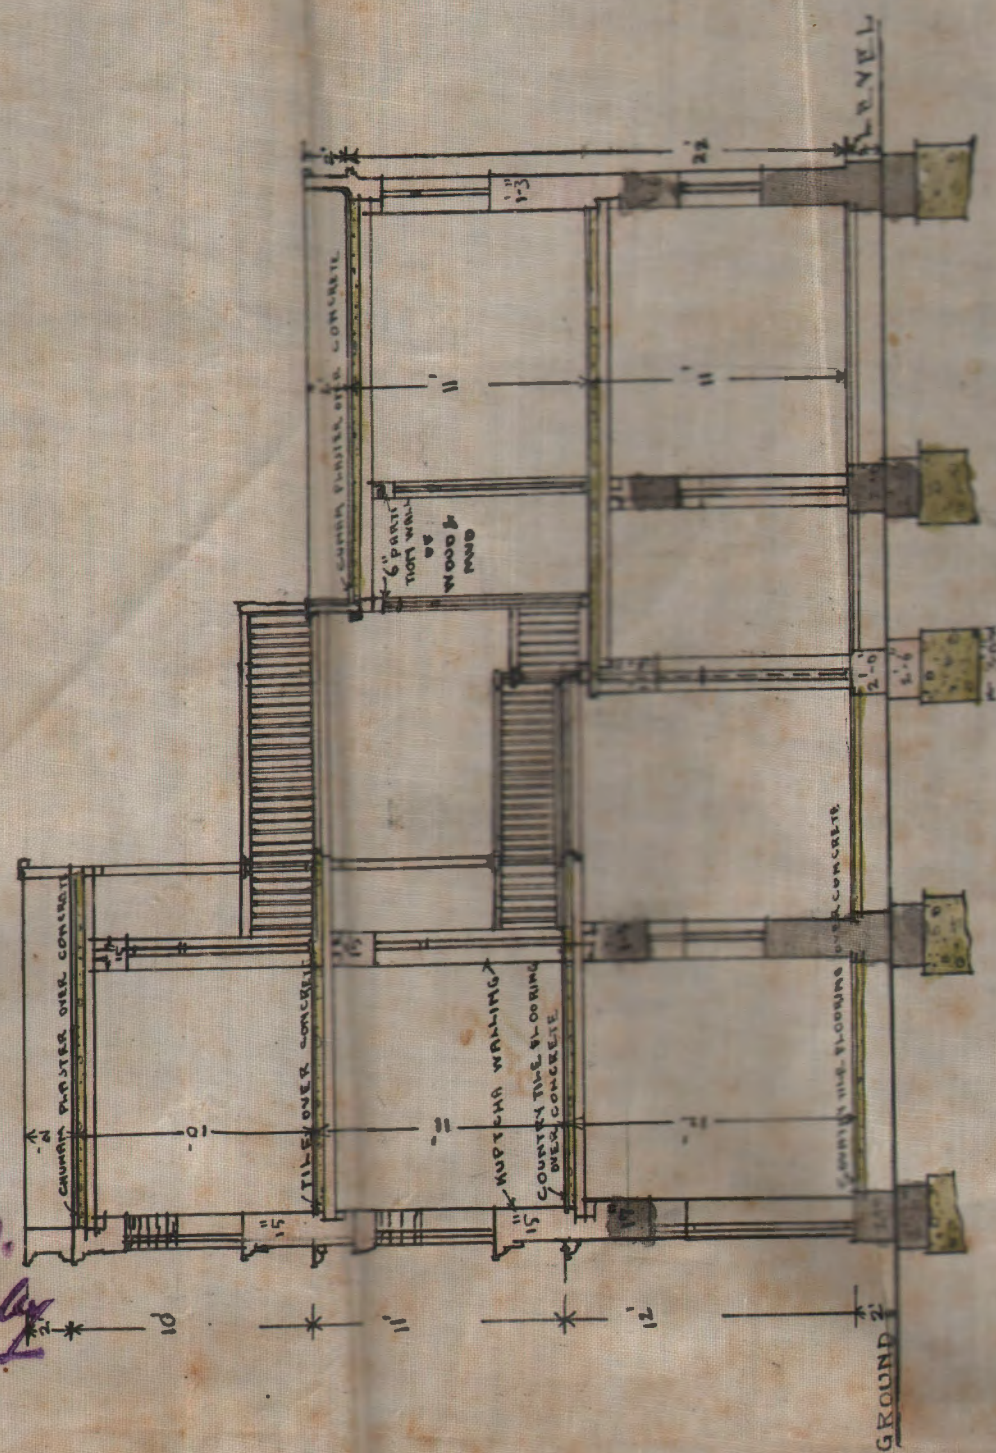

— SECTION ON A.B. —


APPROVED.

J. A. H. K. Kalyan


J. A. H. K. Kalyan,

Engineer,

Karachi Municipality.

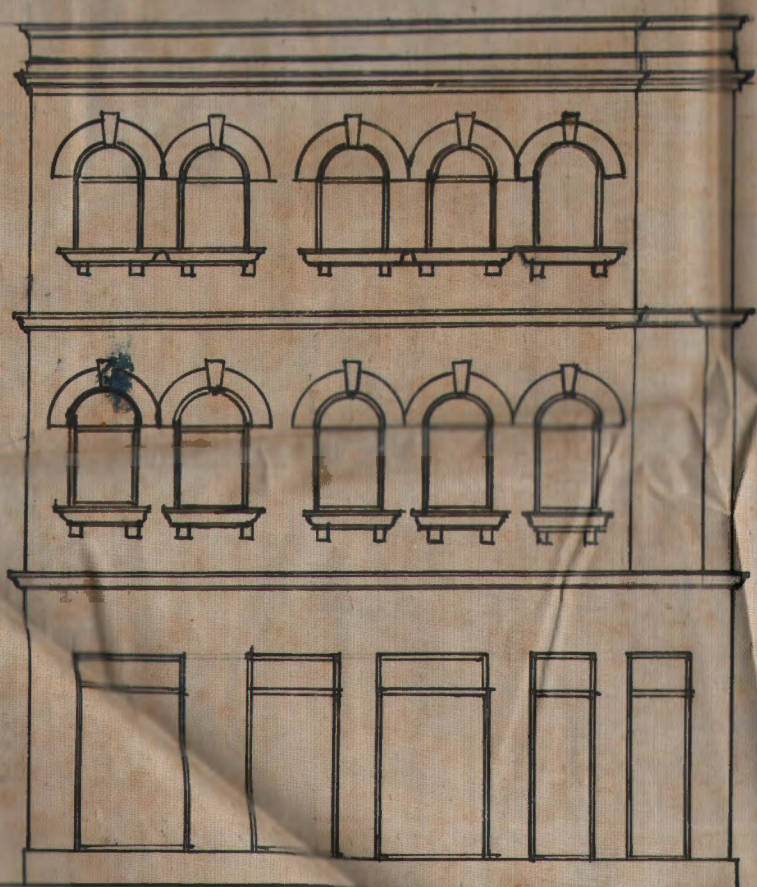


— FRONT ELEVATION —

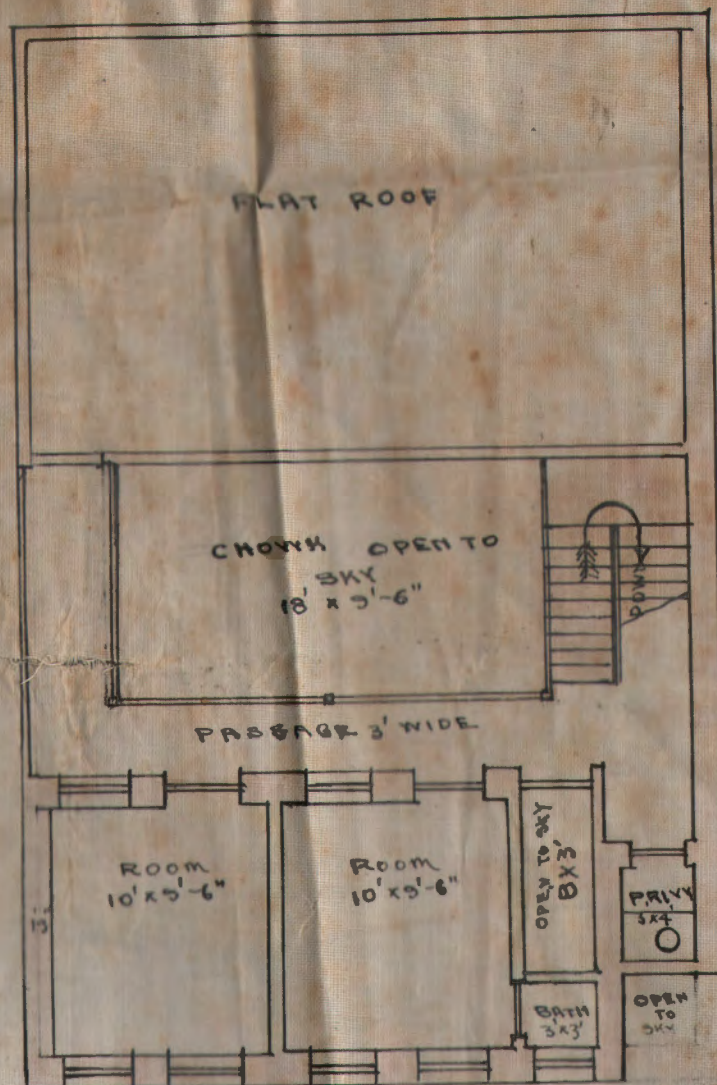

— SECOND FLOOR PLAN —

SITE PLAN

— SCALE 20 FT = 1" —

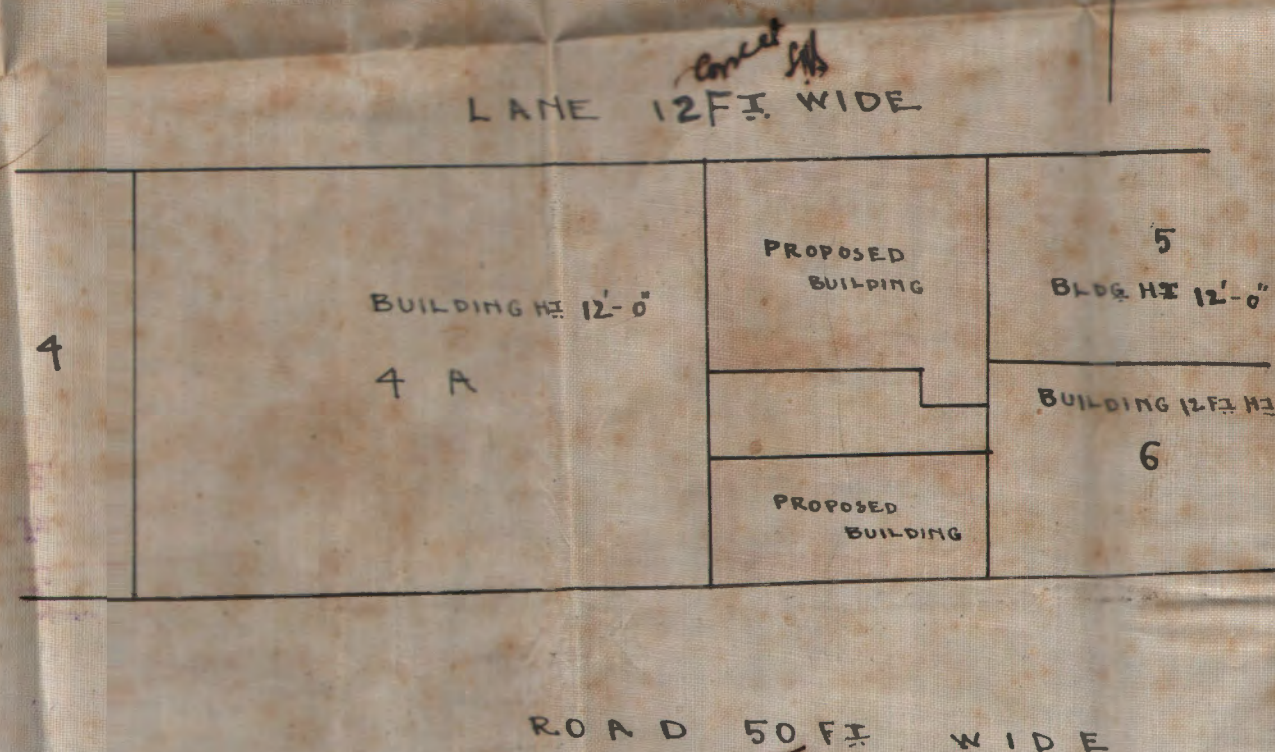

Hirashanker P. Pothak

PATMAK & CO.
ARCHITECTS & SURVEYORS.
KARACHI 30th SEPT. 1916.

ie Navayand...

N-5



Heritage

KMR.CDD.MiQ.1917.01(2-3)(n)

No. E 102 69 of 1916.

Municipal Office.

Karachi. 23rd November 1916.

The Engineer 24th

Karachi Municipality

MEMO / -

their

With reference to ~~my~~ application dated 10th November 1916 with plans for building on plot No. 4A, K-2 Lyari Quarter Messrs Narayandas Mohandas and Wakansing. J. are informed that the windows of the rooms to the North of the plot must be increased in size or extra windows put in.

The plans are herewith returned for amendment.

S. A. M. Inst. C. E.,

Engineer

Karachi Municipality.

which you will kindly approve at your earliest convenience

We beg to
Yours most obediently,
Sd/-



N-6

H. for
repor
13/11/16

Karachi 10 November 1916

To,

The Engineer

Karachi Municipality
Karachi.

8472

13/11/16

Sir,

With reference to your memo no E9485 Dated 2nd inst I beg to state that I have submitted application for the subdivision of plot no 4 A K.2 Lyaree quarter to the city deputy Collector and it will be duly passed. In the meantime I send my plan for the proposed additions on the portion of plot no 4 A K.2 Lyaree quarter amended in accordance with your instruction which you will kindly approve at your earliest convenience.

Sir

He is attached herewith.

Yours obediently
B. Khan

13/11/16

c/o Pathak & Co
architectsWe beg to remain
Sir,

Your most obedient servant

Narayandas Mohan Das

Kalka Singh

No. E 9485 of 1916.

Municipal Office.

Karachi. 1st November 1916.

MEMO / -

With reference to his application dated 6th Oct. with plans Mr: Narayendas Mohandas is informed that the plot No. 4A, K-2 is registered in the name of many occupants and unless the portion proposed to be built upon is officially sub-divided his request can not be considered. The external walls of the building must be made pukka.

The plans are returned herewith for amendment.

A. V. Inst. C. E.,

Engineer

Karachi Municipality.

Dr. S.

