



SHEET No E1 G-1
Tail Dr

Form No. 1-30-201-2

Karachi, 10th March 1928.

1928.

Note New numbers are shown in brackets

NOTICE UNDER SECTION 98 OF ACT III OF 1901.

To

THE CHIEF OFFICER,

KARACHI MUNICIPALITY.

Sir,

I beg to inform you that I intend building

DRAIN

on plot No. 260

JAMES TERRACEBA MBRIDGE ROAD

263

262

261

DRAIN

259

Your most obedient Servant,

260

(14)

216

(15)

218

217

No. 6

OF 1901

Municipal Chief Officer's Office

Karachi

STREETPRINCESS

James
Chief Officer
Karachi Municipality

MB
15/3



Form No. 1—500-20-1-27.

Karachi, ^{8th} ~~1st~~ March 1928.

NOTICE UNDER SECTION 96 OF ACT III OF 1901.

To,

THE CHIEF OFFICER,

KARACHI MUNICIPALITY.

SIR,

I beg to inform you that I intend building House
on plot No. 260

Survey Sheet No. E-1, Situate in PrincessStreet, Jail Quarter.

As required by the Rules of the Municipality I beg to submit herewith a plan of the same for your approval. ~~I also submit herewith a certificate from the Electric Inspector to Government as required under rule 62 (3) of the Indian Electric Rules.~~

Address:—

C/o,

Hassanji Hussain
Hathmal Zorach
Hassanji H. Advani,
Architect & Surveyor,
Nicol Road,
Karachi.

I beg to remain,
Sir,

Your most obedient Servant,

Signature of the Applicant

*This line to be struck off if there is no electric aerial line passing by the plot.

No. G.

OF 192 .

MUNICIPAL CHIEF OFFICER'S OFFICE,

Karachi, _____ 192 .

Forwarded to the Health Officer for favour of passing on to the Land Manager and Architect after putting his remarks.

Jagant Lal H.
For Chief Officer, 12/3/28
Karachi Municipality.




FRONT ELEVATION




PLAN OF PROPOSED BUILDING ON PLOT No. 260
SHEET E-1 JAIL QUARTER.
SCALE 8'-1"


LONGITUDINAL SECTION OF
T.BEAM AT (A) SCALE 4'-1"

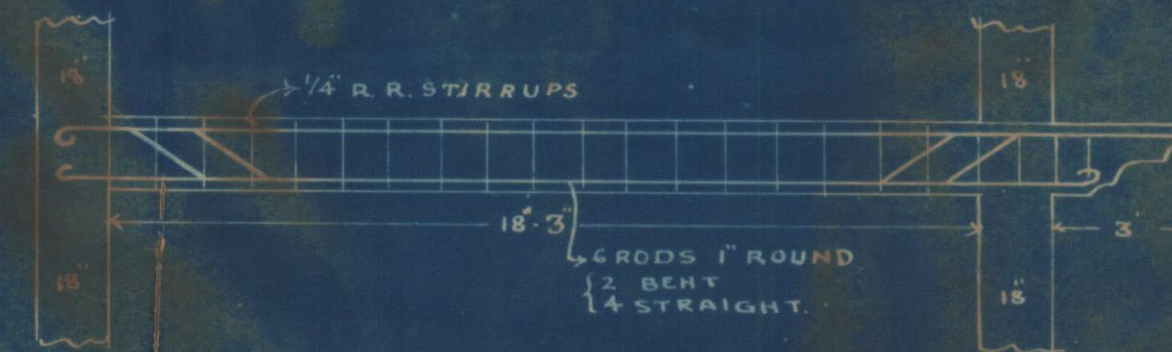

SECTION
SCALE 2'-1"

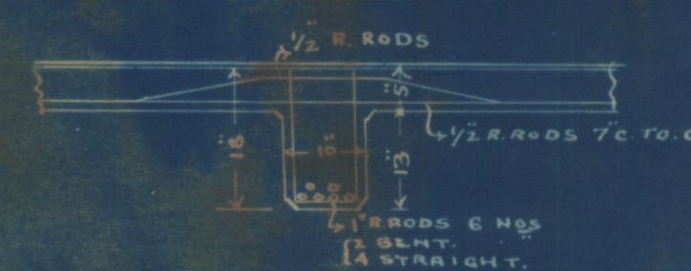

BLOCK PLAN
SCALE 20'-1"

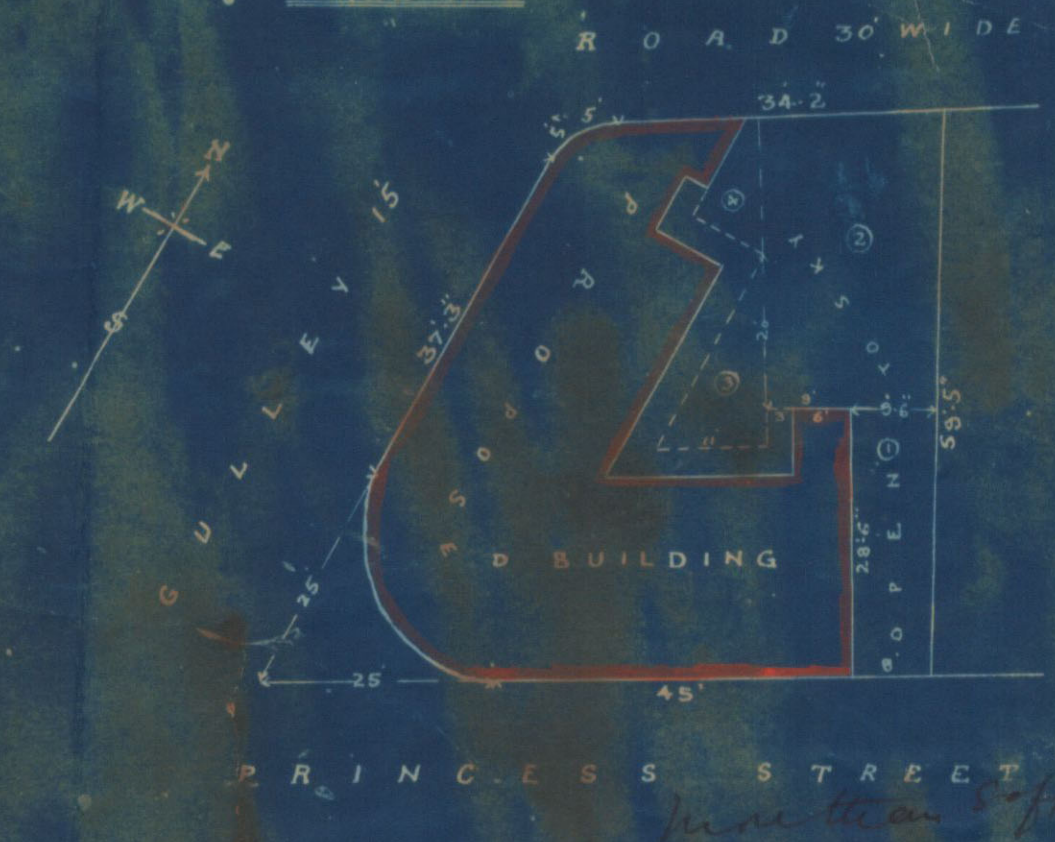


NOTE:-
TOTAL AREA OF THE PLOT 328.5 Yds.
AREA TO BE LEFT OPEN 1/3 = 109.3 "
PROPOSED OPEN SPACES
(1) 1 x 28.5 x 8.75 = 249.37
(2) 1 x 18.5 x 30.75 = 568.87
(3) 1 x 20 x 11 = 220.00
(4) 1 x 14 x 6 x 2 = 168.00
TOTAL 984.24 S.FT =
109.3 S. Yds.

APPROVED
M. S. S. S.
Executive Engineer,
Karachi Municipality.


GROUND FLOOR



1st & 2nd FLOOR

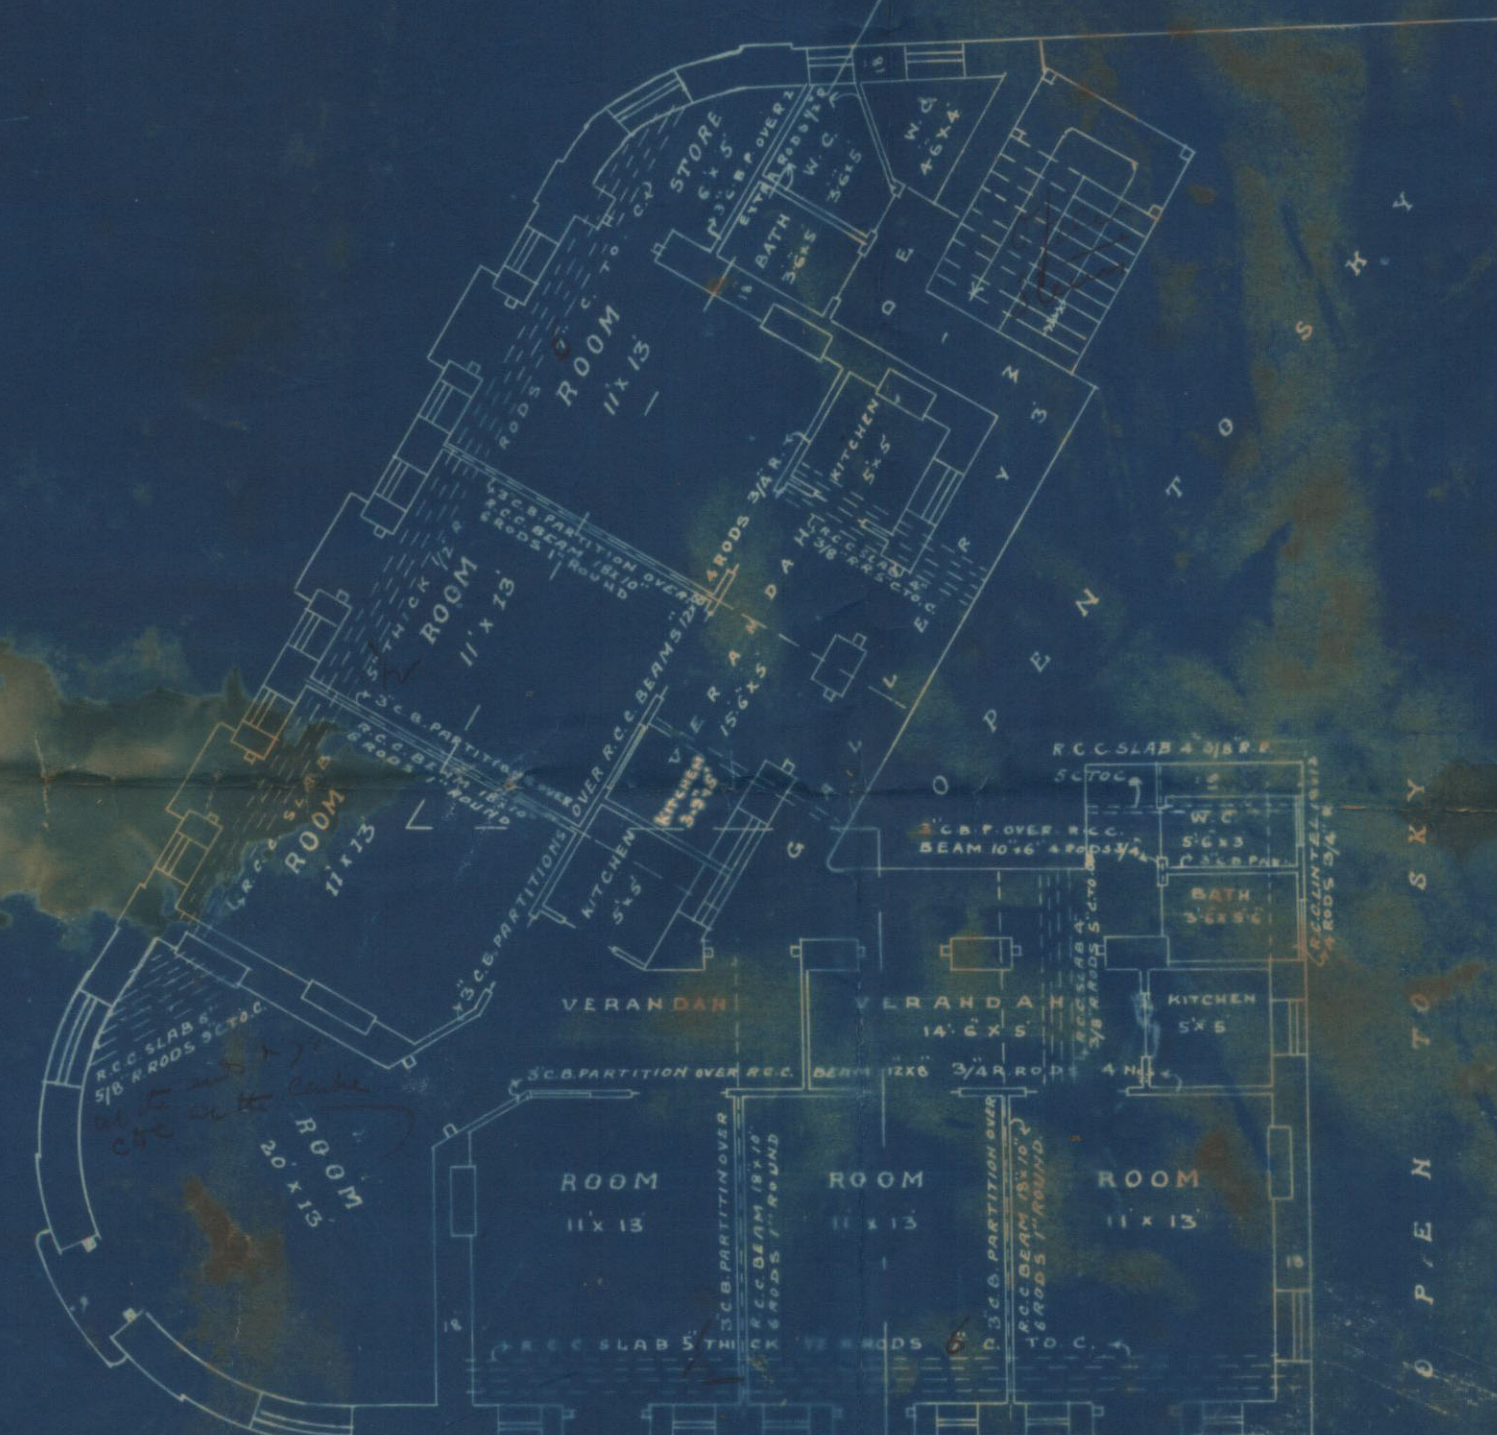

SECTION ON A.B.

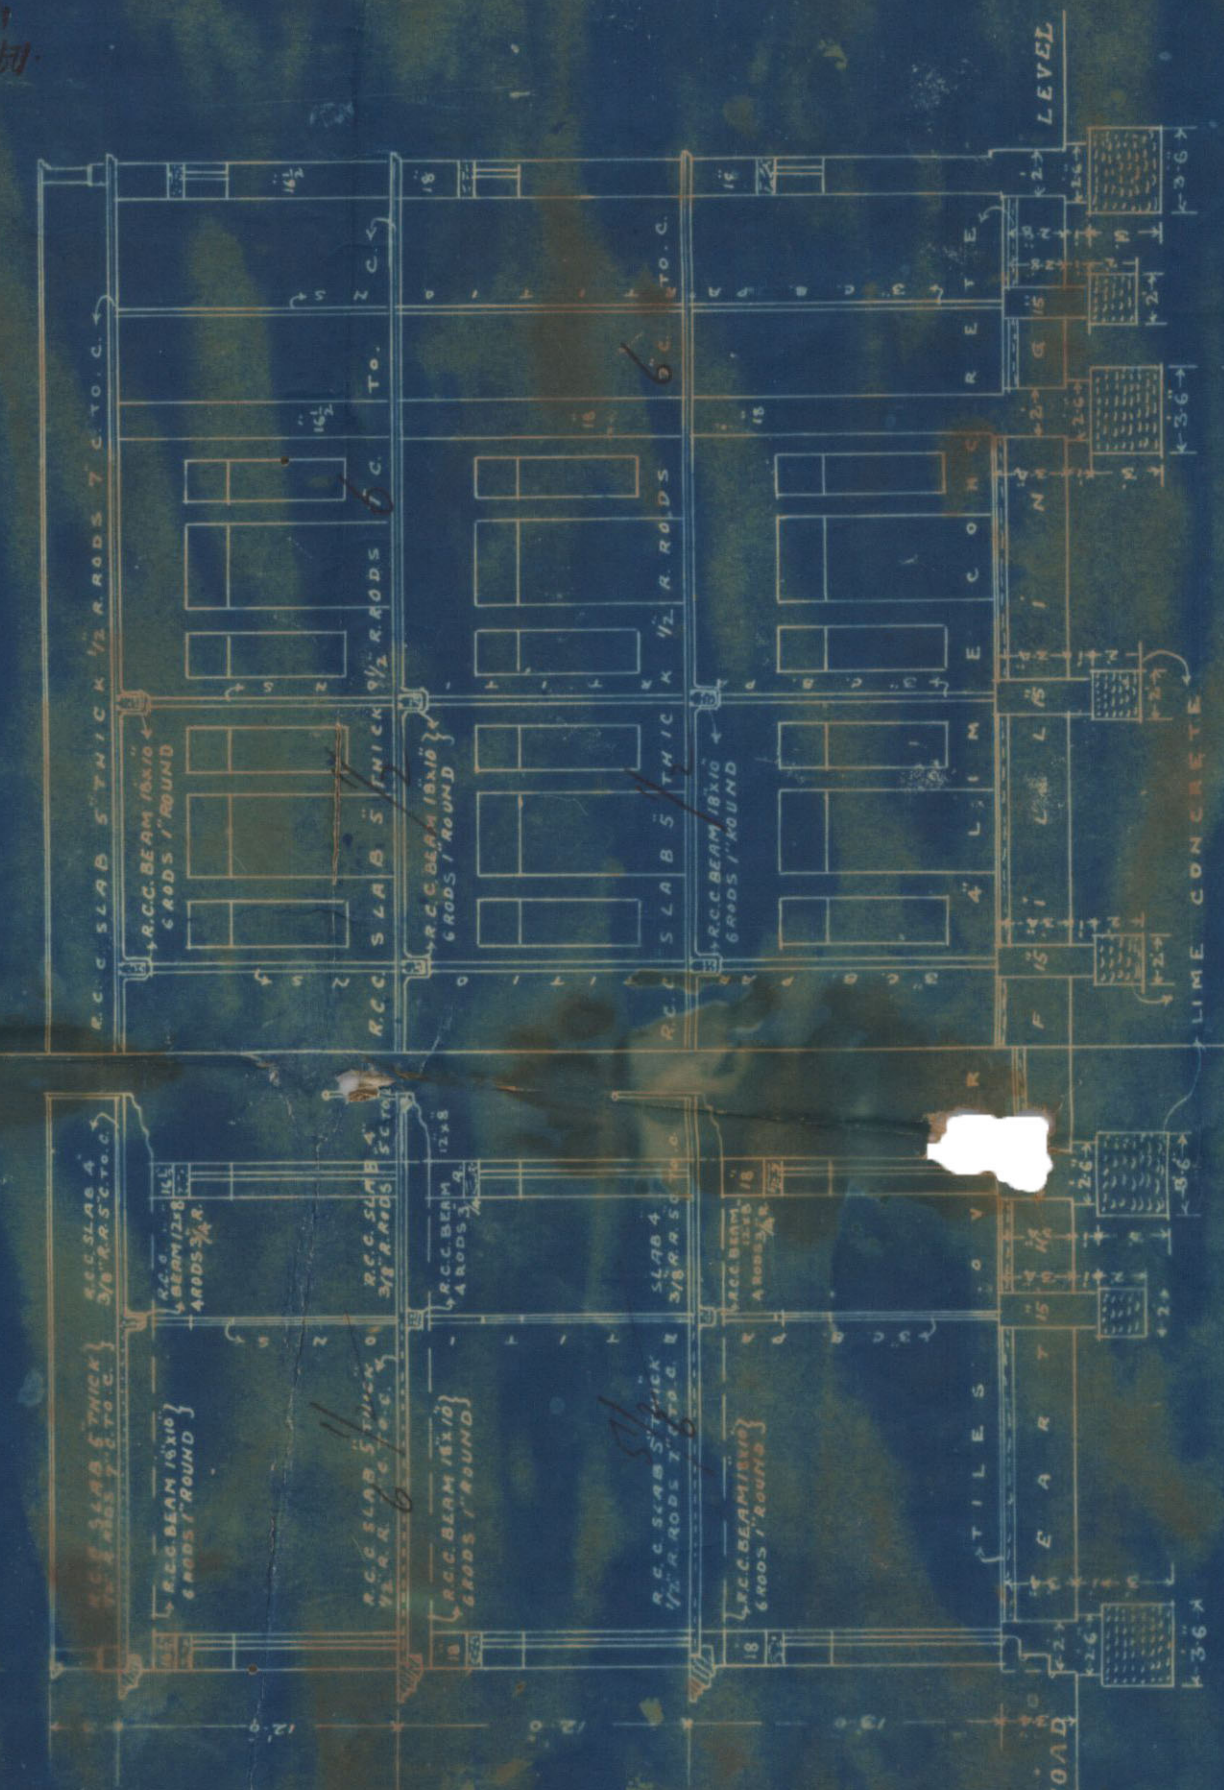

OWNER

HASSAN HADANI
ARCHITECT & SURVEYOR
NICOL ROAD, KARACHI