

Building Completion Report.

MUNICIPAL OFFICE,

Karachi, 6th May 1921.
10

To

THE ENGINEER,

KARACHI MUNICIPALITY.

SIR,

K.S. 1236
1921/22

I beg to report, the building work on plot No. 7A+Z Sheet I/2
Garden Quarter owned by Messrs. Mathradas + Sohanmal
is completed according to the plan approved by the Municipality. Orders are
requested to file the correspondence.

Yours obediently,

Prasanna
Building Surveyor "A" Section,
Karachi Municipality.

*Copy forwarded to the Assessor
& Collector for information*
M. C. A. A. J.

*Engineer,
Karachi Municipality*



Heritage
FOUNDATION

KMR.CDD.GaQ.1920-1921.05

No.1

PLAN OF PROPOSED BUNGALOW ON

PLOT NO. 7A+7, SHEET NO. 12, GARDEN Qr.

FOR Messrs. MUTHURADAS & SOBHANMAL AMRACHI.


NOTE.

AREA OF PLOT. 1260. Sq Yds. 1/4 equals 315 Sq Yards.
AREA OF BUNGALOW. 270.0 Sq Yds.
AREA OF OUT BUILDINGS. 44.5 Sq Yds.
Including Stairs. 234.5 Sq Yds.

-JOB N° 4-S-
DATE 1st APRIL 1920

Mathradas Hoondamal. Raha
S. Mahanmal Bahendal. Raha


No. 134

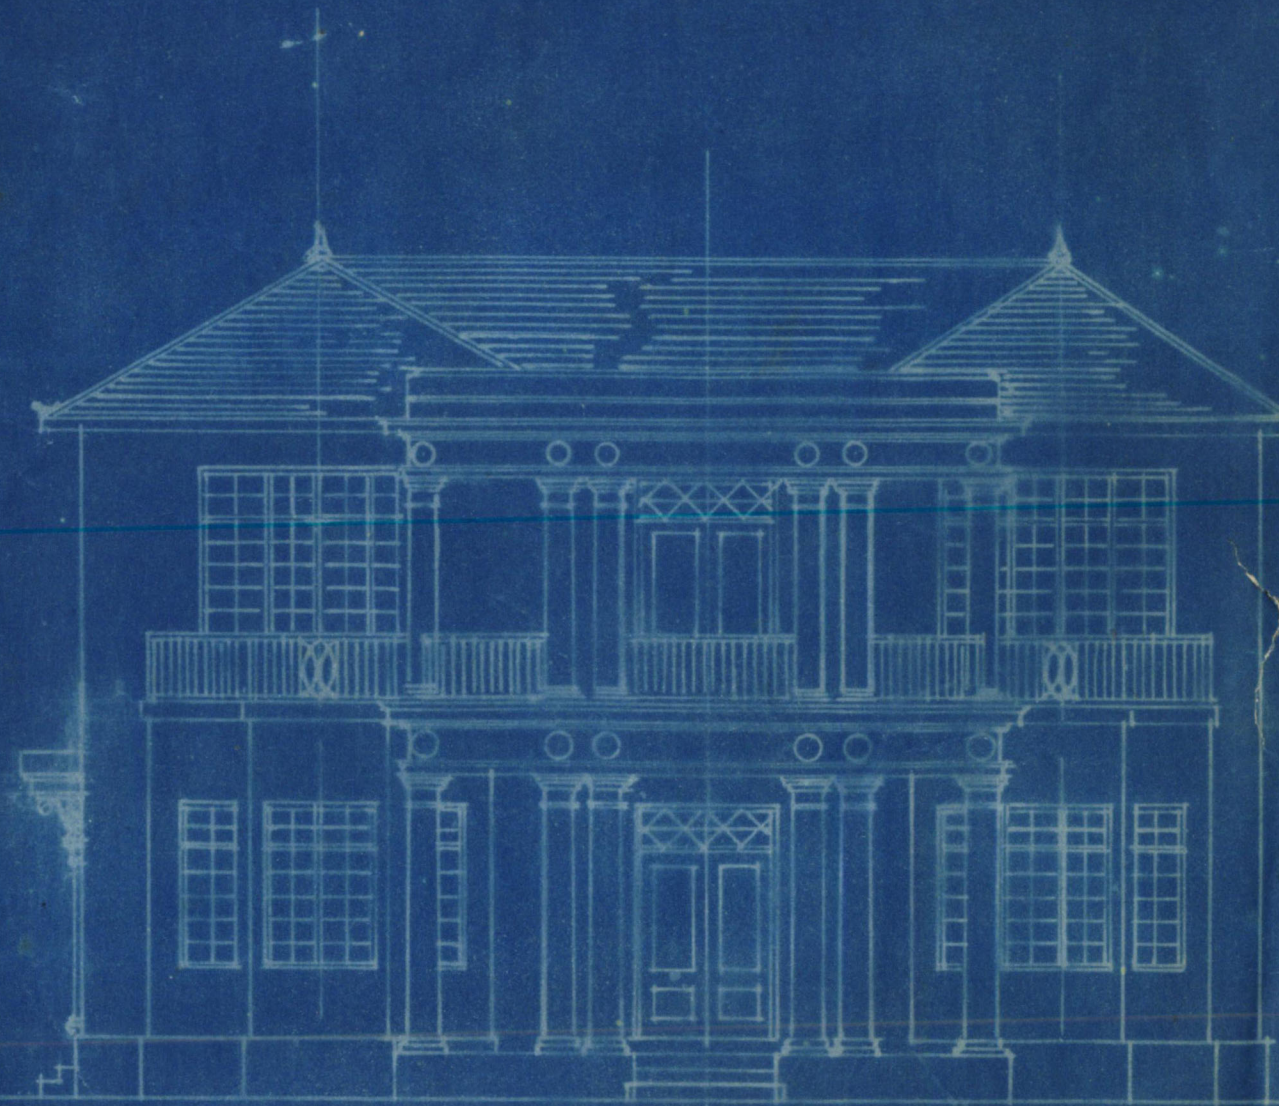


FRONT ELEVATION



SIDE ELEVATION

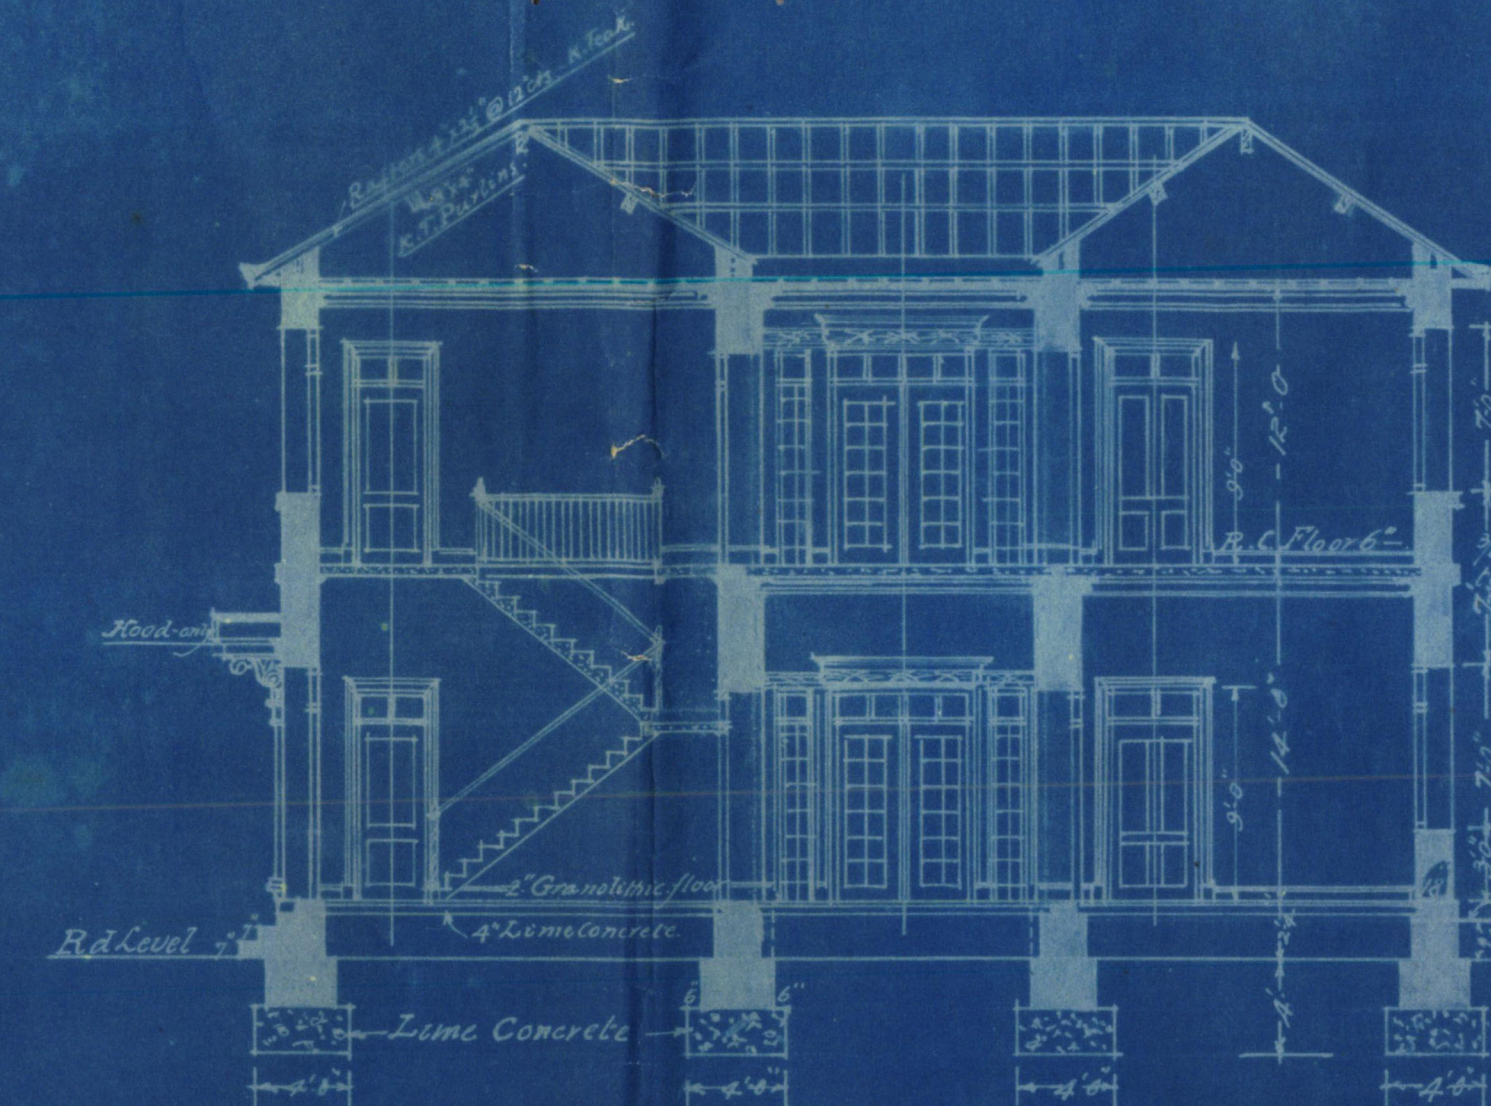



Section Thru. A. A.

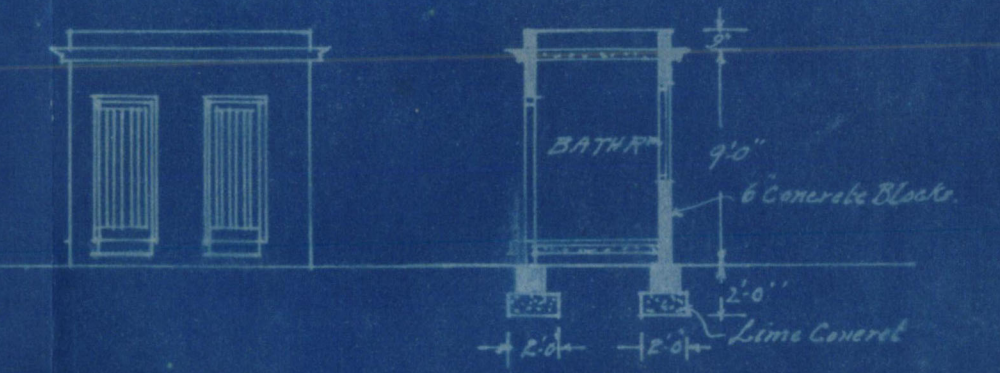


ELEVATION

Section Thru B. B.


APPROVED.
M. I. M. P.
J. J. J. J.
J. J. J. J.

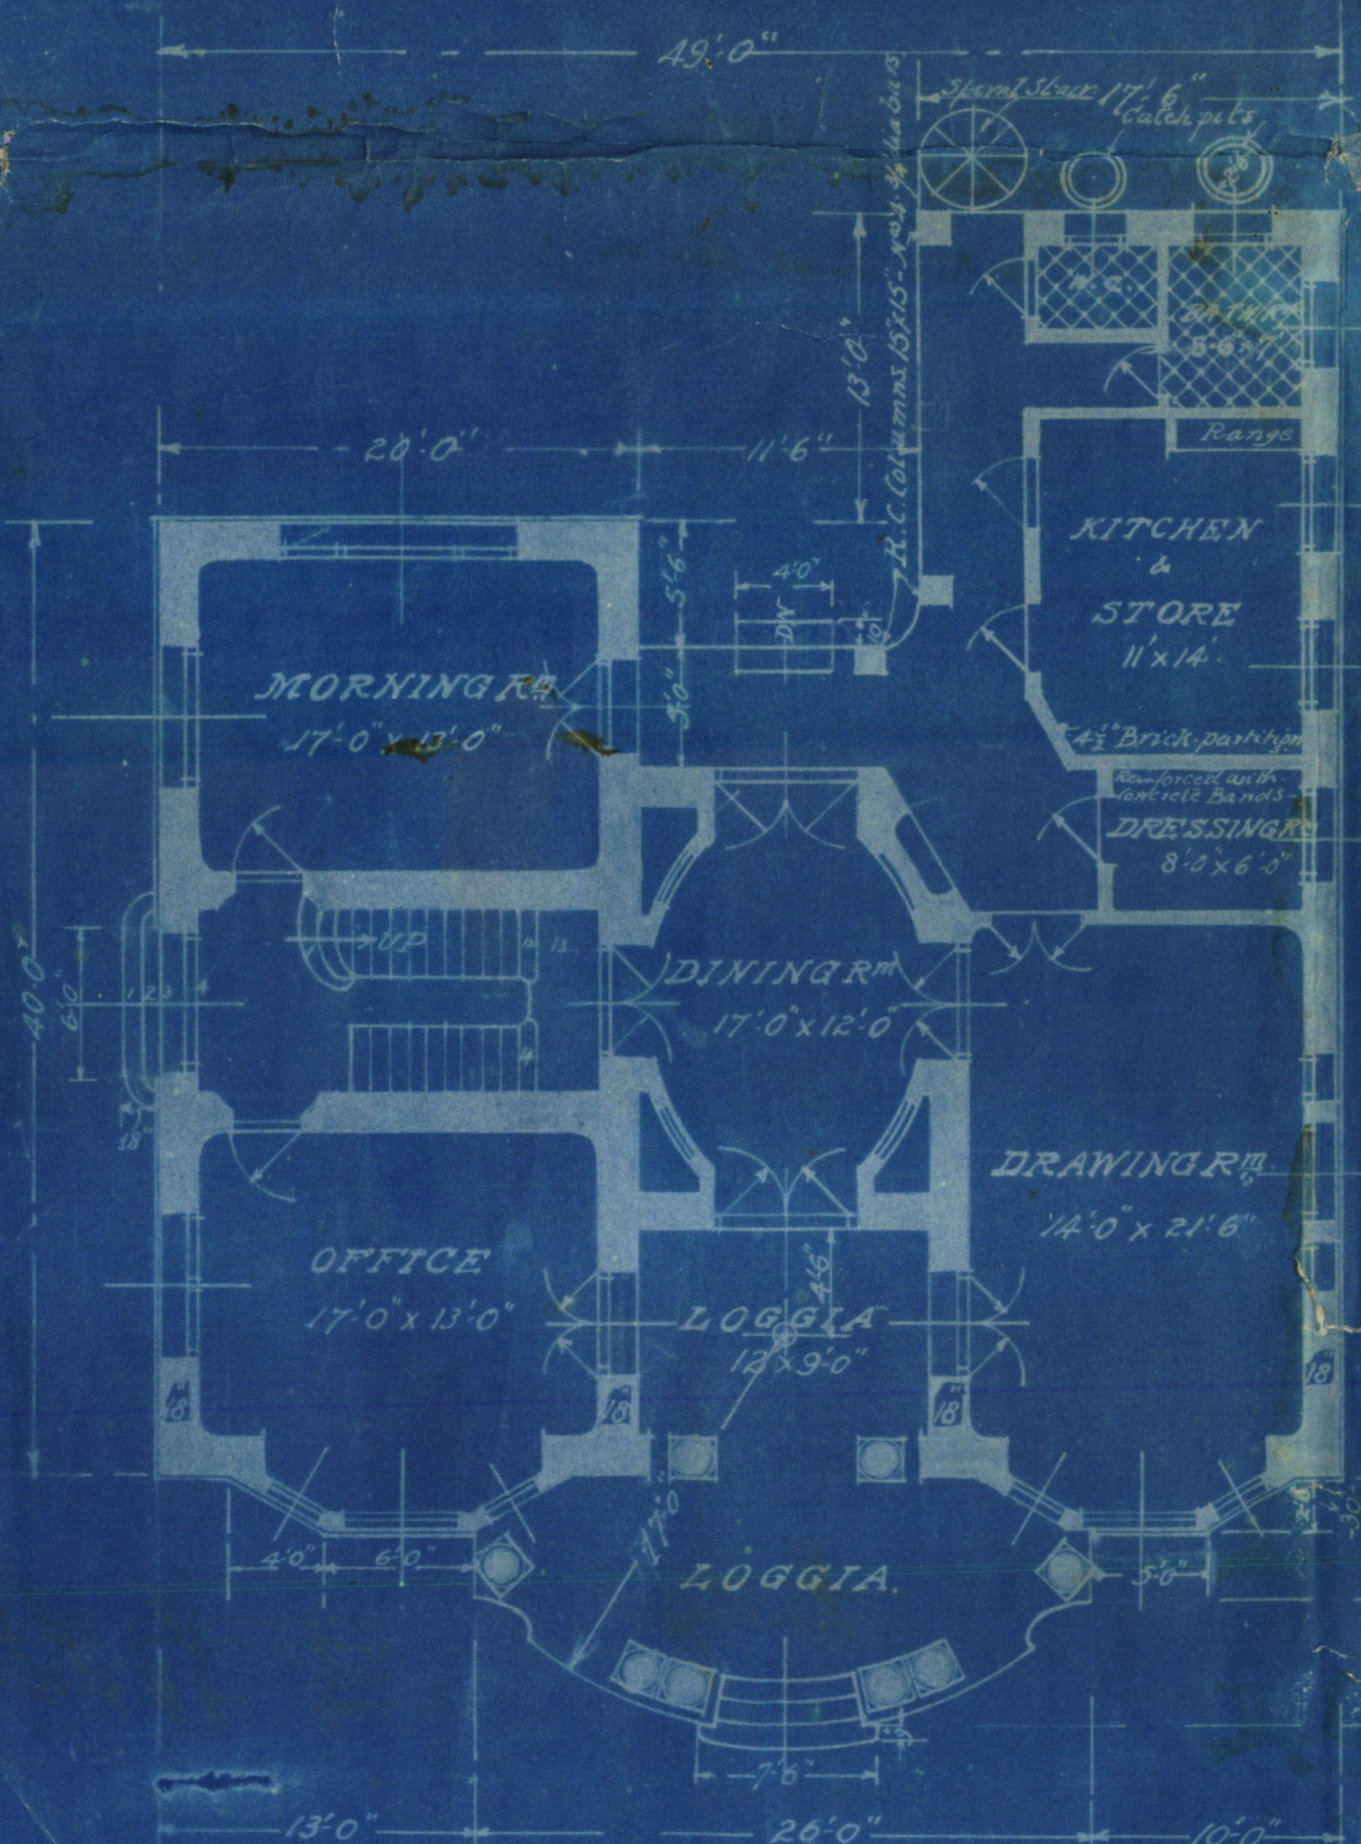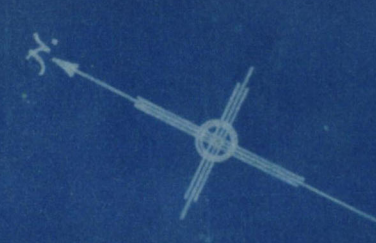

GROUND FLOOR PLAN

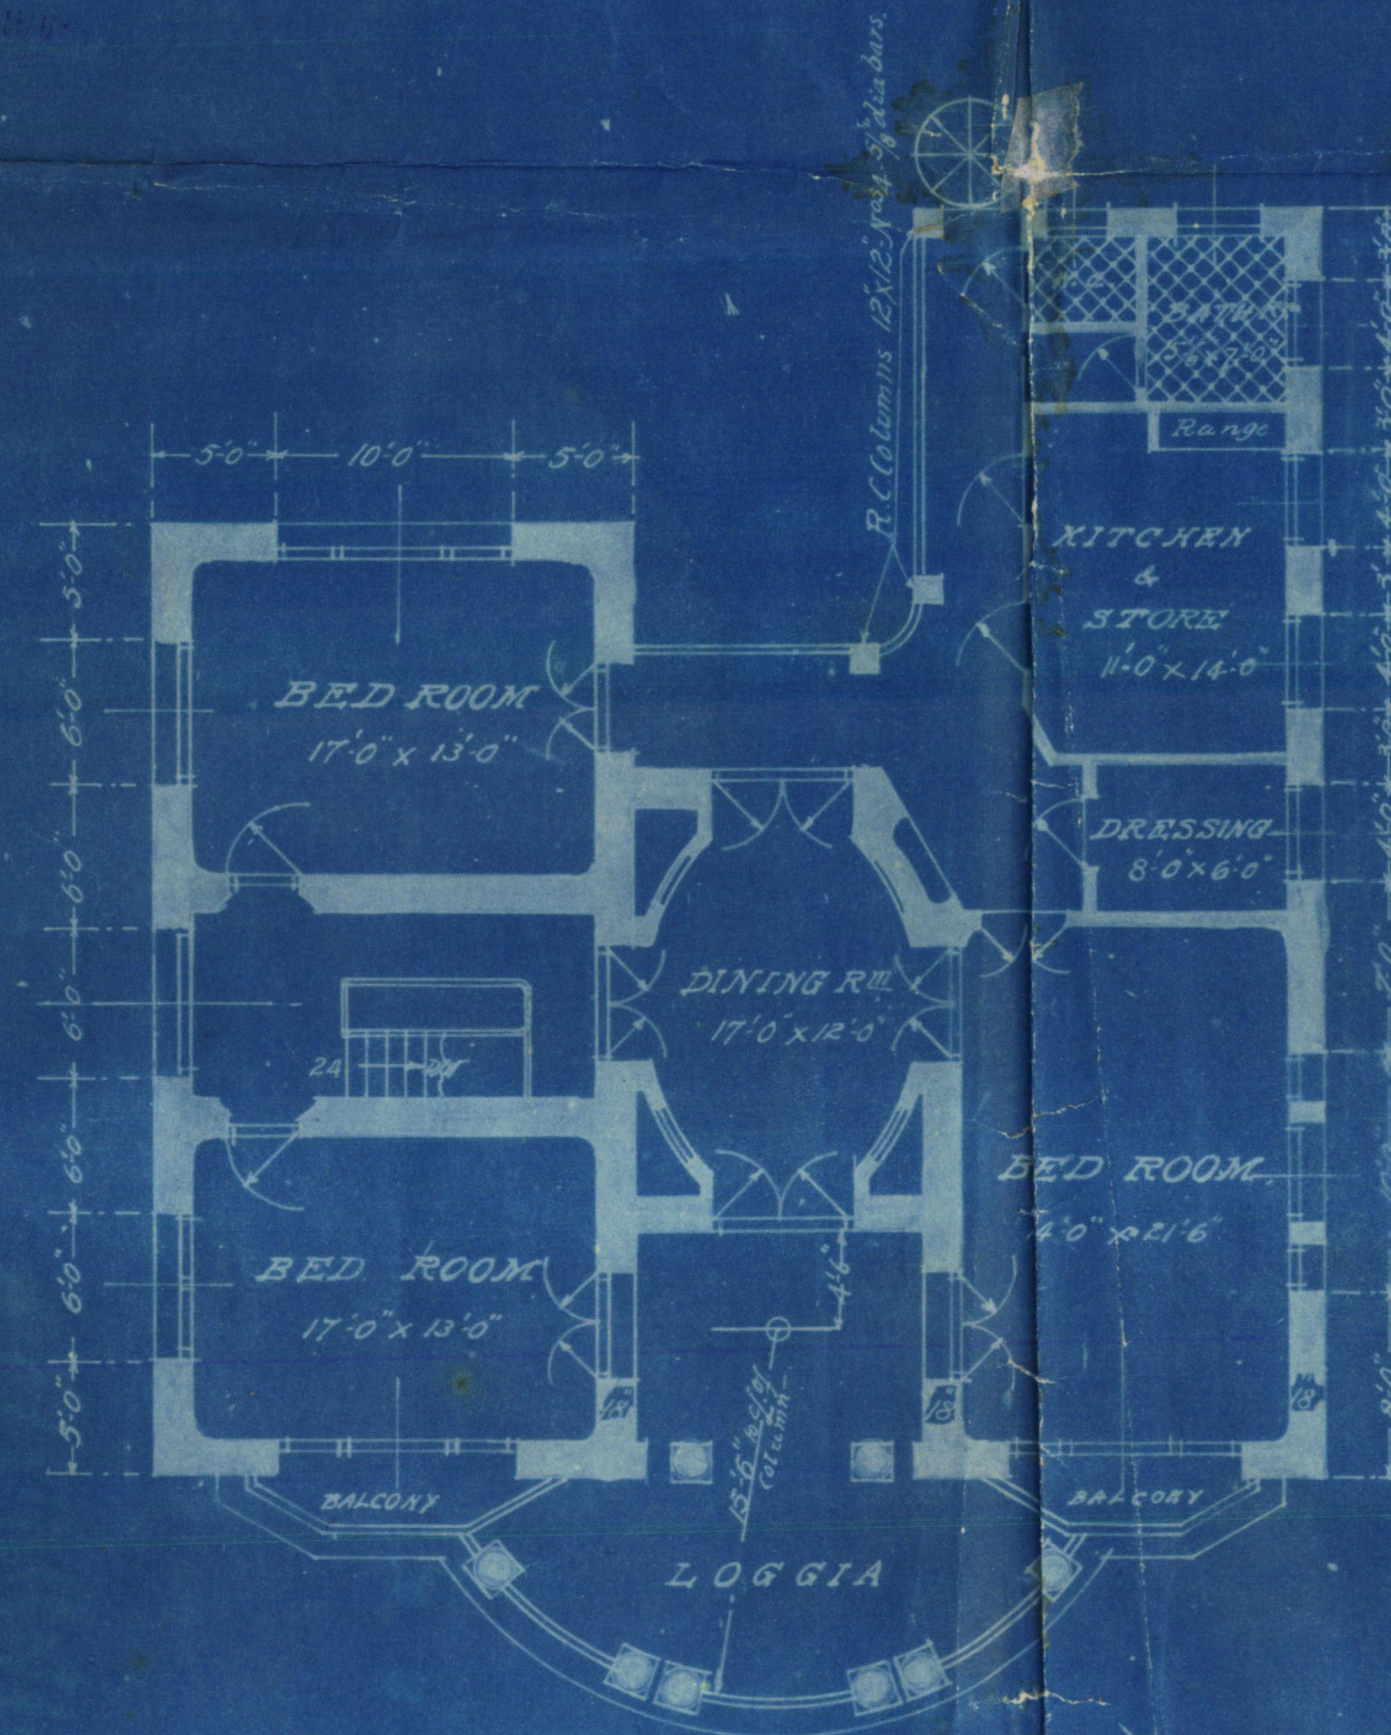


FIRST FLOOR PLAN

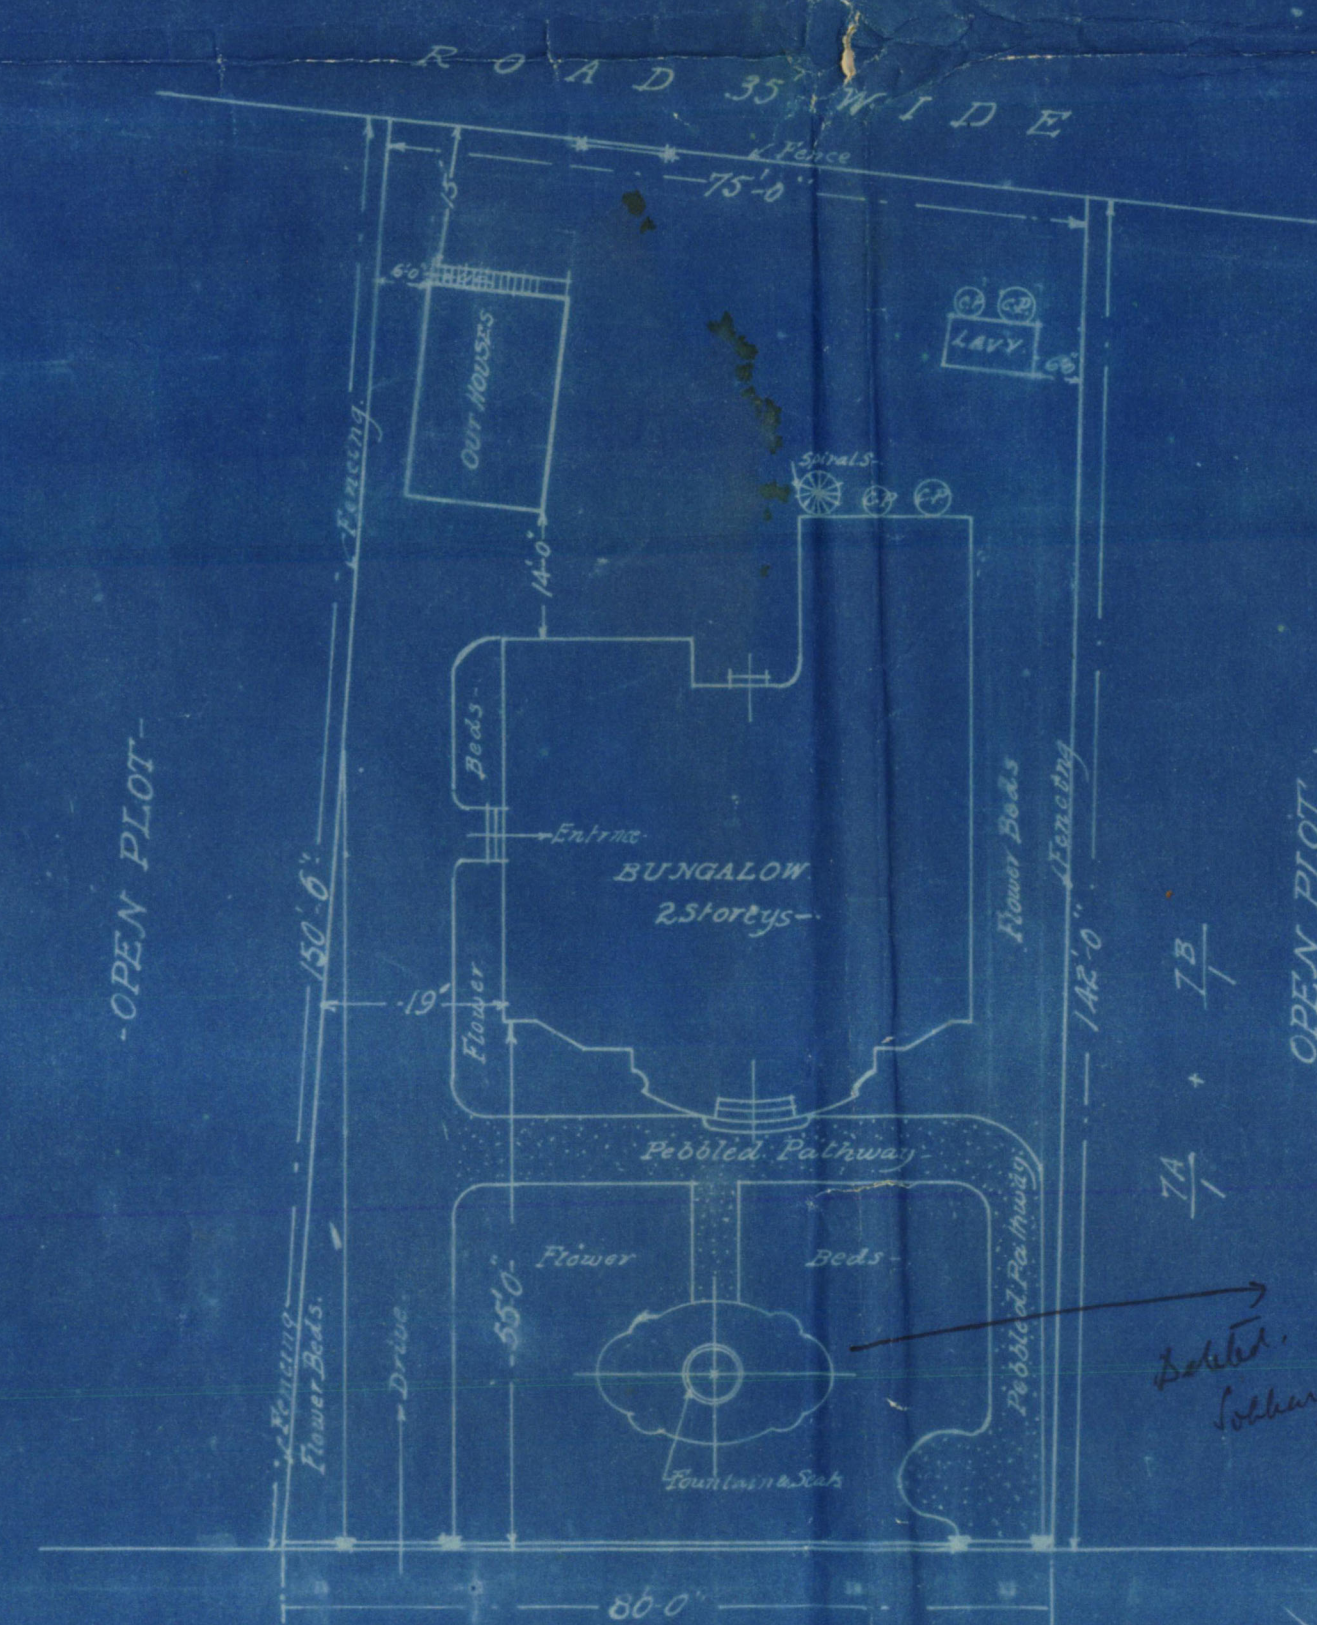


SITE PLAN


Scale 1/4" = 1'

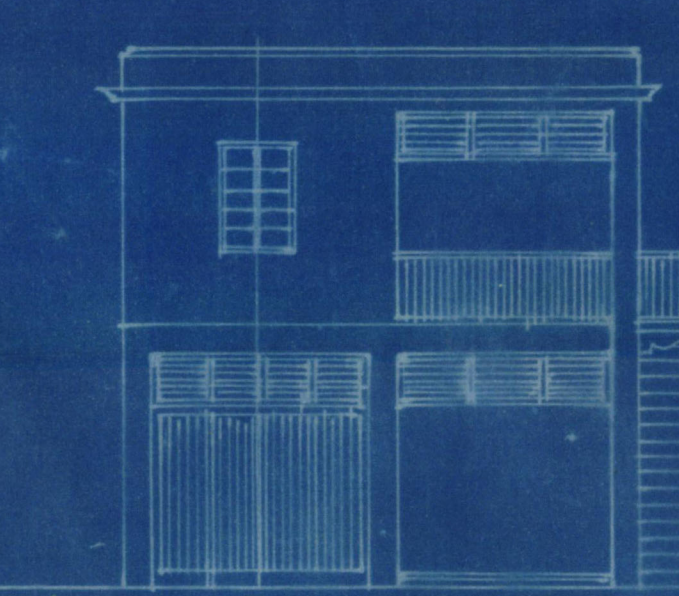


FRONT ELEVATION

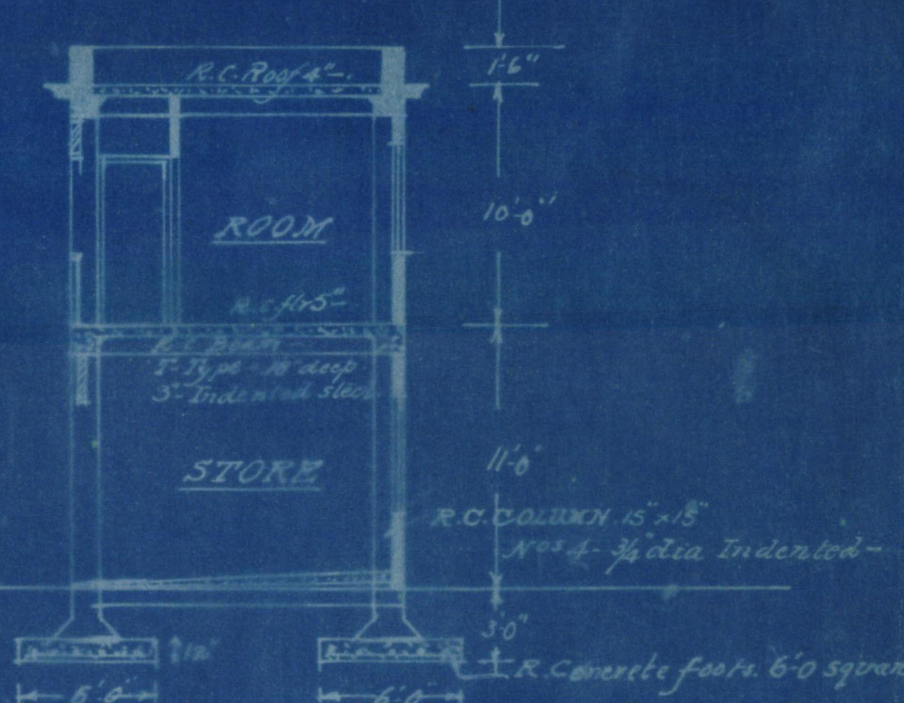

Section Thru A. A.

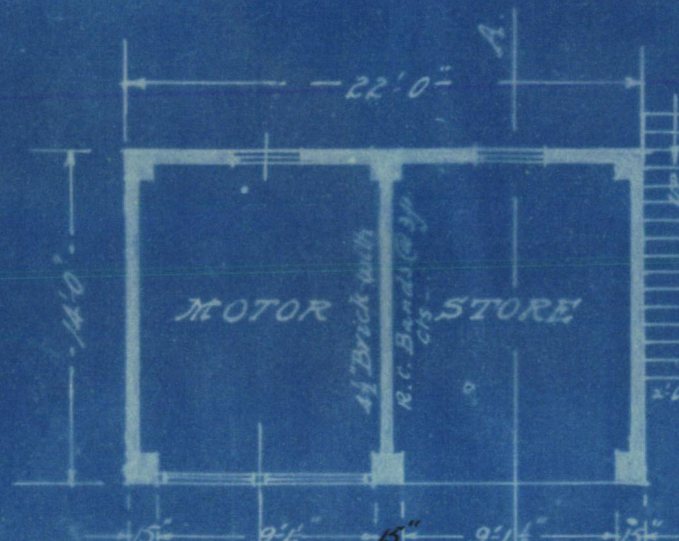

GROUND FLOOR PLAN

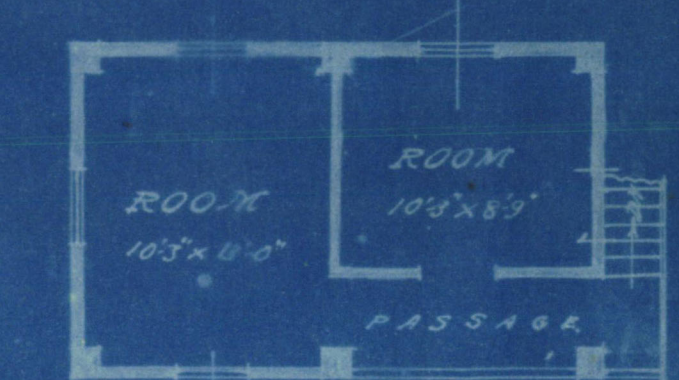

FIRST FLOOR PLAN

SCALE OF FEET
0 10 20 30 40 50 60

Grasapoli
20.4.20
ARCHITECT & SURVEYOR
R. CONCRETE ENGINEER
KARACHI