



Heritage

KMR.CDD.CiQ.1921.02

Building Completion Report.

MUNICIPAL OFFICE,

Karachi, 20th May 1921..

To

THE ENGINEER,

KARACHI MUNICIPALITY.

SIR,

I beg to report, the building work on plot No. 30 Sheet 7/11
Civildars Quarter owned by Mr. Tilumal Seemal,
is completed according to the plan approved by the Municipality. Orders are
requested to file the correspondence.

Copy to the A/c for information

[Signature]

M. C., A. M. I. C. E.,

Engineer,

Karachi Municipality

Yours obediently,

[Signature]


Building Surveyor "A" Section,

Karachi Municipality.




No. 117

PLAN OF PLOT No. 30. SHEET No. F. 10.
FOR
SETH TILUMAL SEVAN DASS.
SHOWING PROPOSED STORE ROOM & COWSHED IN RED

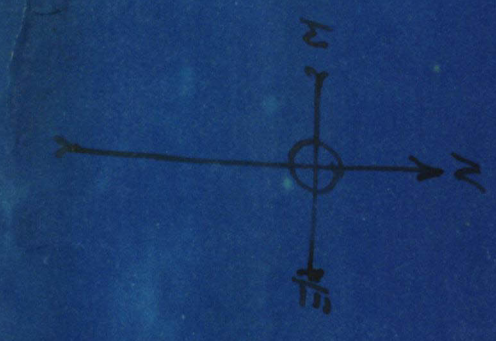


SITE PLAN SCALE 1" = 16 FT.

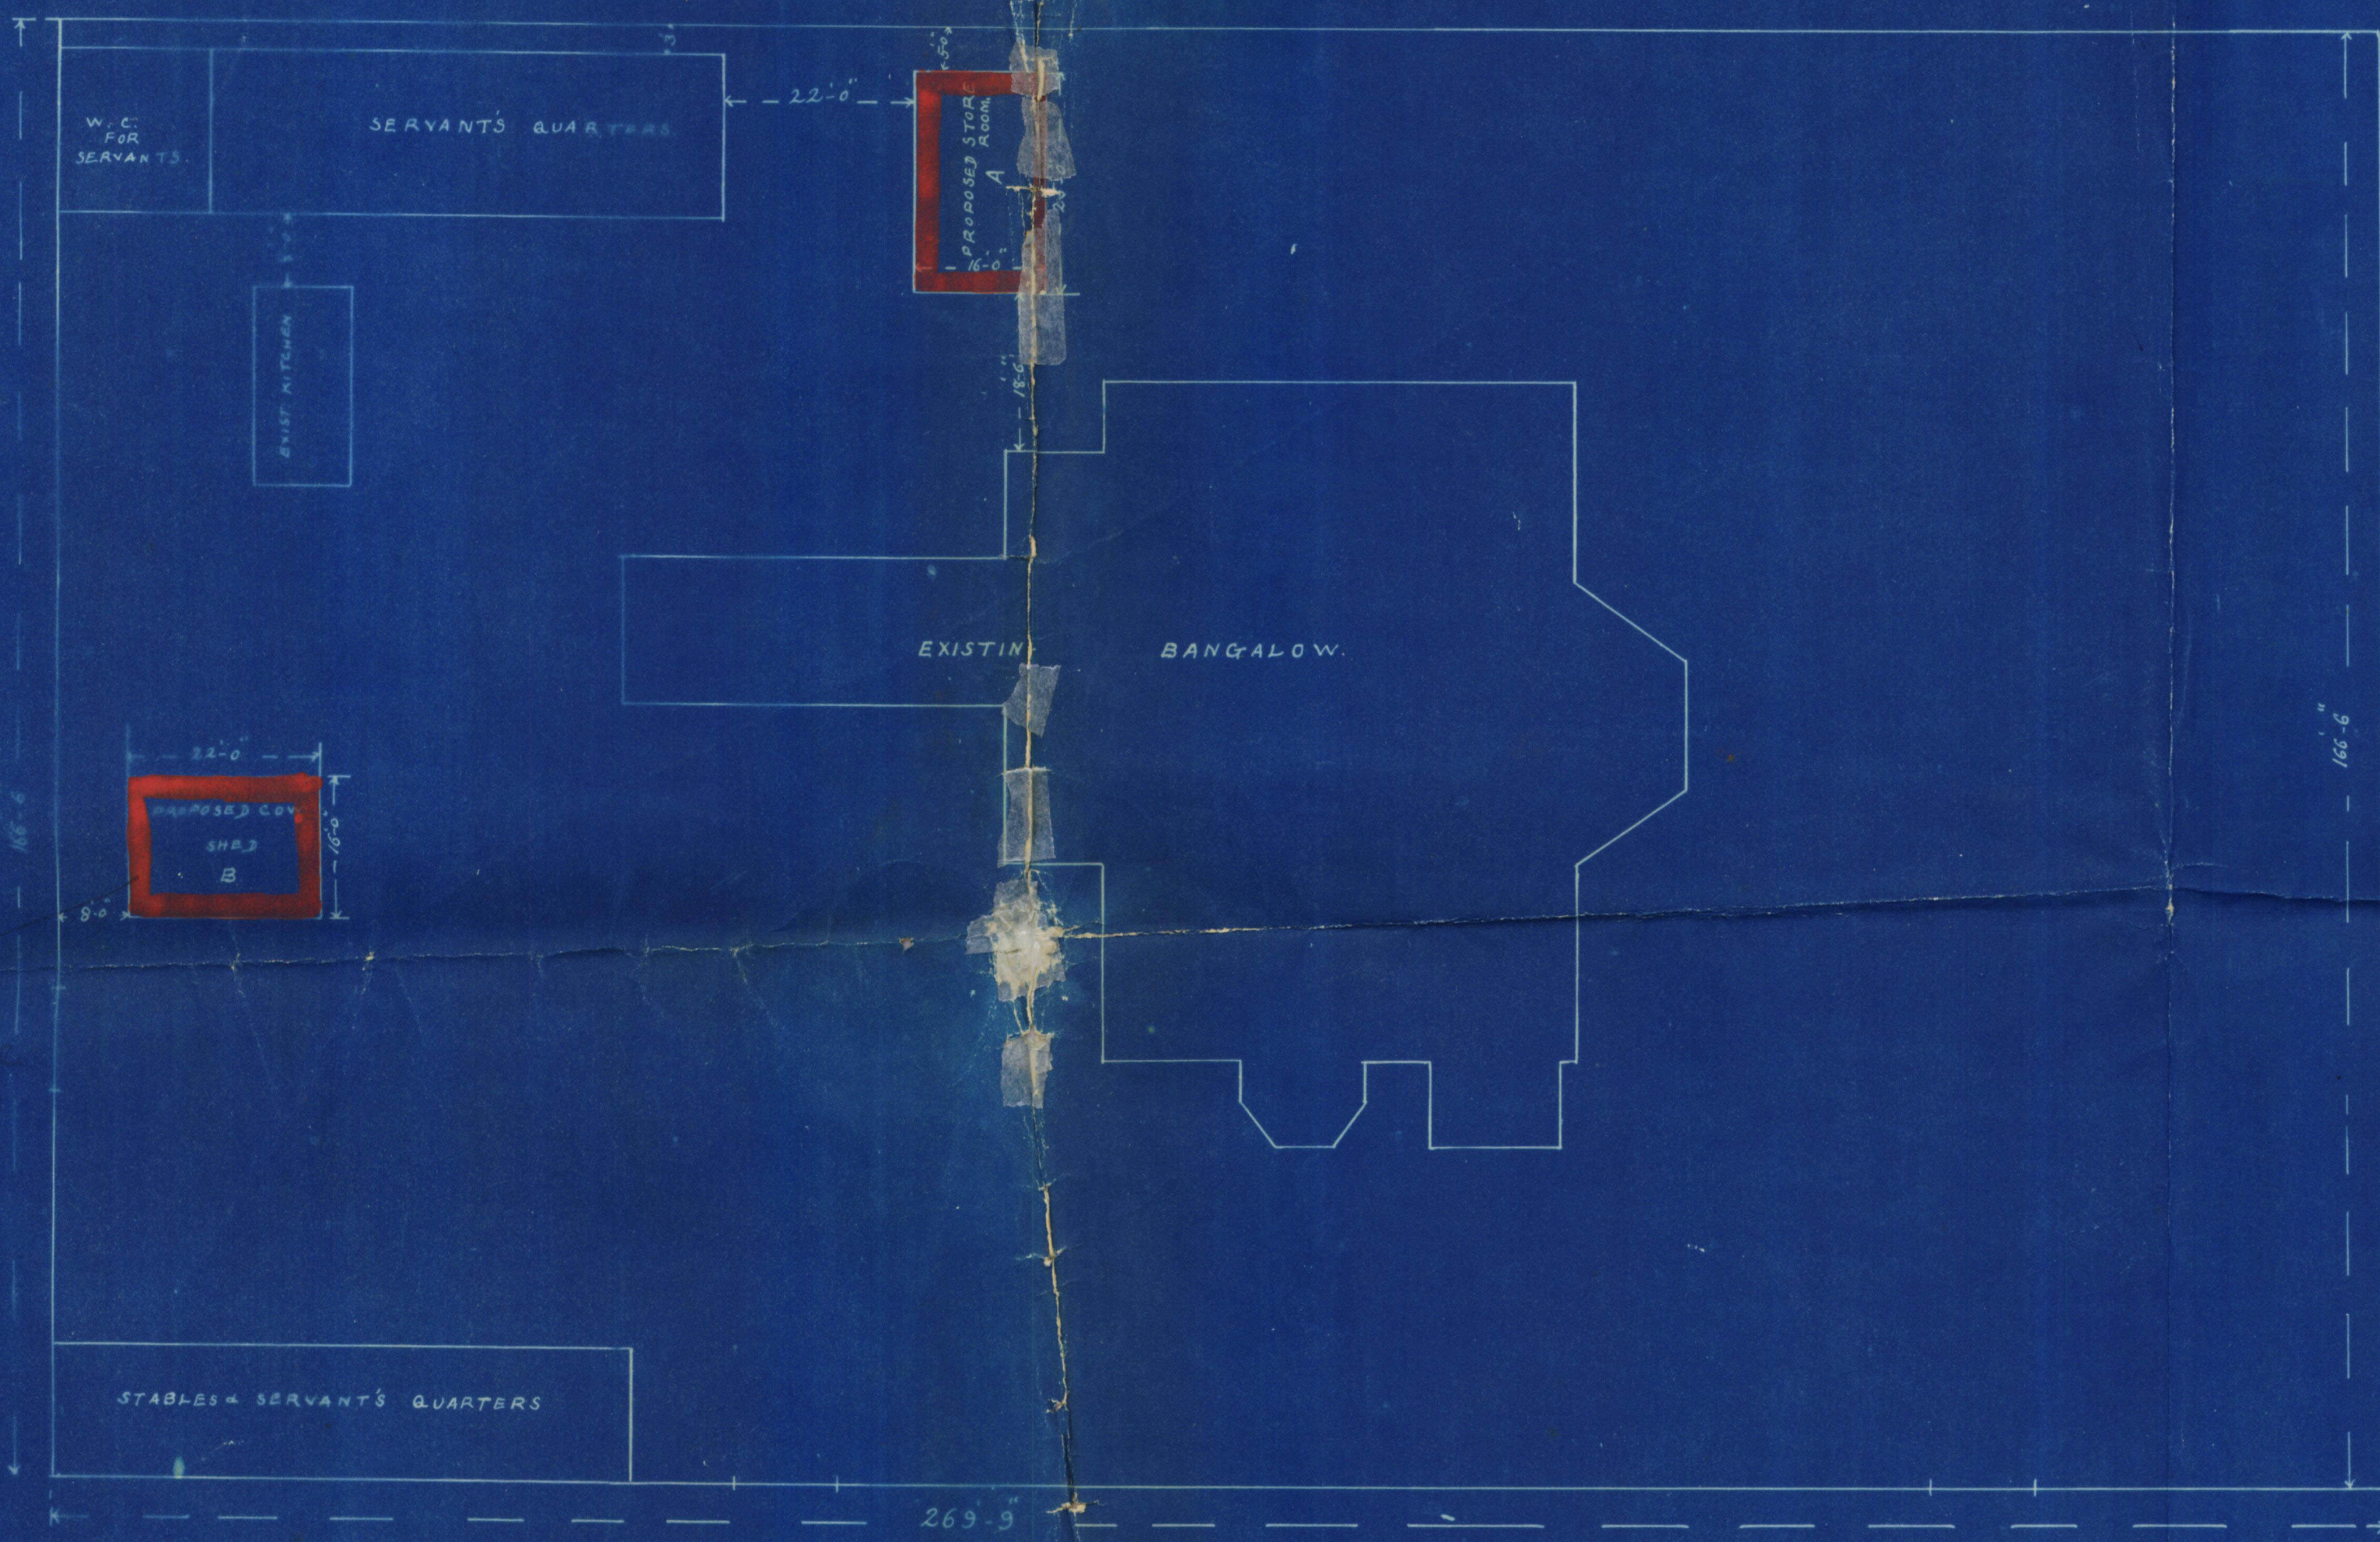


APPROVE


Dr. J. S. ...
M. O. S. ...
Karachi Municipality

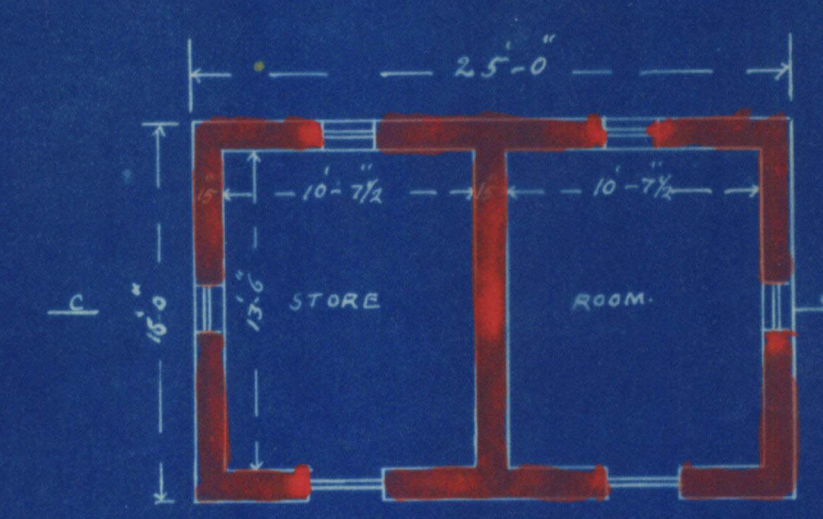


A. PLAN.

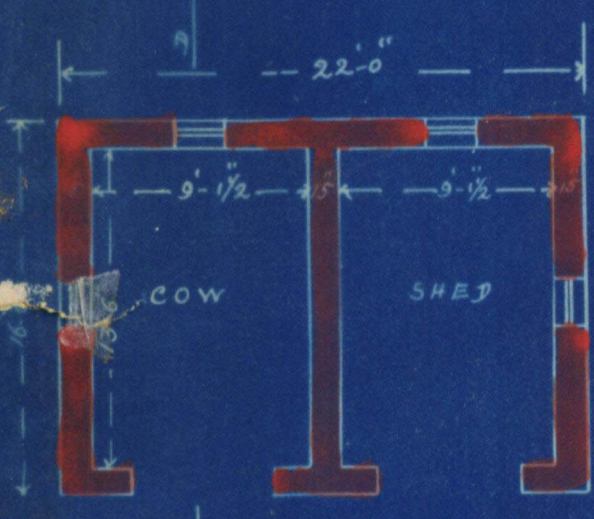


B. PLAN.

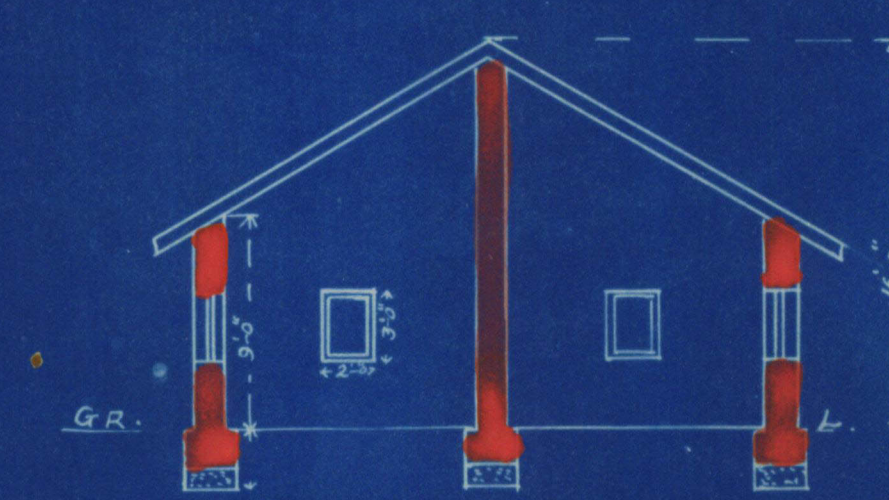


SECTION ON C.C.

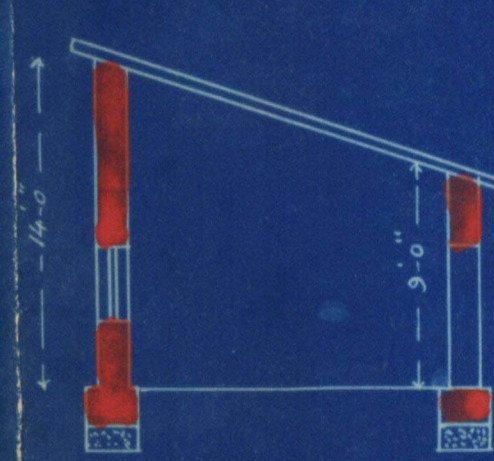

SECTION ON D.D.

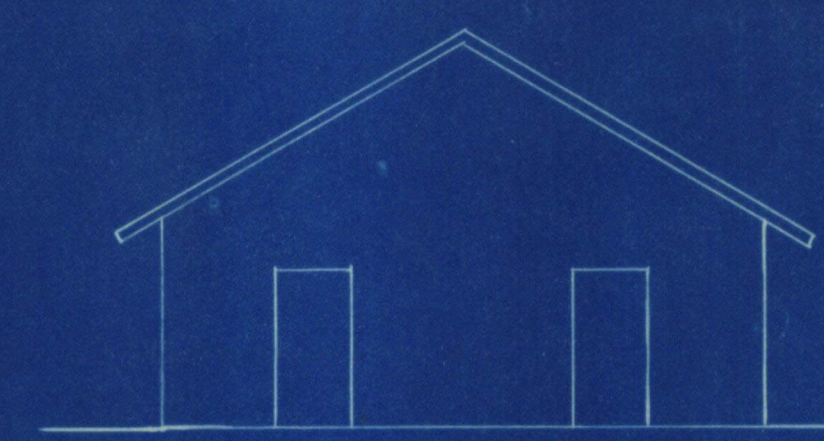

FRONT ELEVATION OF A PLAN.

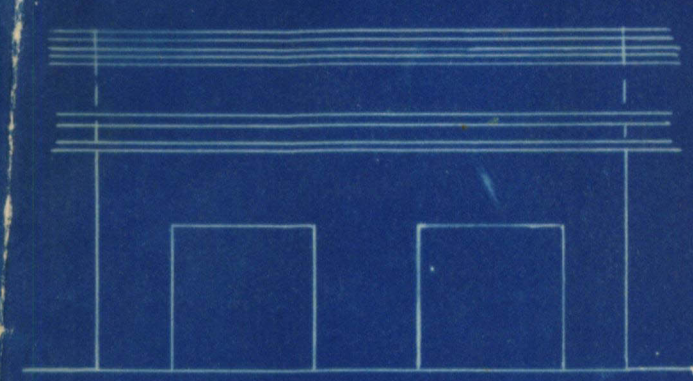

FRONT ELEVATION OF B PLAN.

SCALE 1" = 8 FT.

Boad. Sunyide

Total ...
...
...

Road.

in Tilloomal Shevander

Dr. J. S. ...
ARCHITECT & SURVEYOR
KARACHI
17/2/21