



For m No: 23—250—7-6-21.

No. L. S. 1195 of 1922

Municipal Office,

KARACHI 1st March 1922
2nd

MEMO :—

With reference to ^{his}~~their~~ application dated 23rd Feb 1922
amended
with plans for the proposed Bungalow
on plot No. 39 Sheet, 91. Free Town Quarter,
~~Nos.~~

Mr. Homi W. R. Nichte is informed that the
~~Messrs.~~ ~~are~~

plan, having been approved by the undersigned, has been forwarded to the Chief Officer and Chief Engineer for the approval of the Managing Committee, as the plot is under Municipal Control.

He ~~They~~ must not start any building operations until ~~he hears~~ ~~they hear~~ further from this Office.

M.C., A.M.I.C.E.,

Engineer,
Karachi Municipality.

Plot m 39 g1. Free T. 92 ²

Submitted with Hc and report
there appears no objection.

2812

Vol
DeuB

No objection

1/3

SS

MISTRI & BHEDWAR,
B. A.'s, L.C.E.'s,
ARCHITECTS, ETC.,
D. H. Daruvala, B. E.,
Representative.
Bombay Office, 18 Churchgate Street.

1933

2880WPP1533



Heritage

KMR.CDD.FrQ.1922.01

NEW CLOTH MARKET, BUNDER ROAD.

Karachi, 23 rd February 1928

Plot no. 39 sheet no. J.1.
25-2-28

To,

D. Barington Brow Esq. M.C.A.M.I.C.E.
Engineer,

Karachi Municipality.

Dear sir,

Re: Buildings on plot no. 39 sheet no. J.1.
Frere town quarters.

With reference to the plans for the buildings on the above plot we beg to send you here-with amended plans. Instead of a semi-detached house it is proposed to have only a detached bungalow. Also one block of out-houses on the south has been omitted.

*W. B. B. for
22-2-28*

Yours faithfully

D. H. Daruvala

MISTRI AND BHEDWAR
Architects.


No. 89

AMENDED PLAN FOR PROPOSED BUNGALOW


ON PLOT NO 38 SHEET NO J-1-B

FRERE TOWN QUARTERS


SCALE 8 FT. TO AN INCH

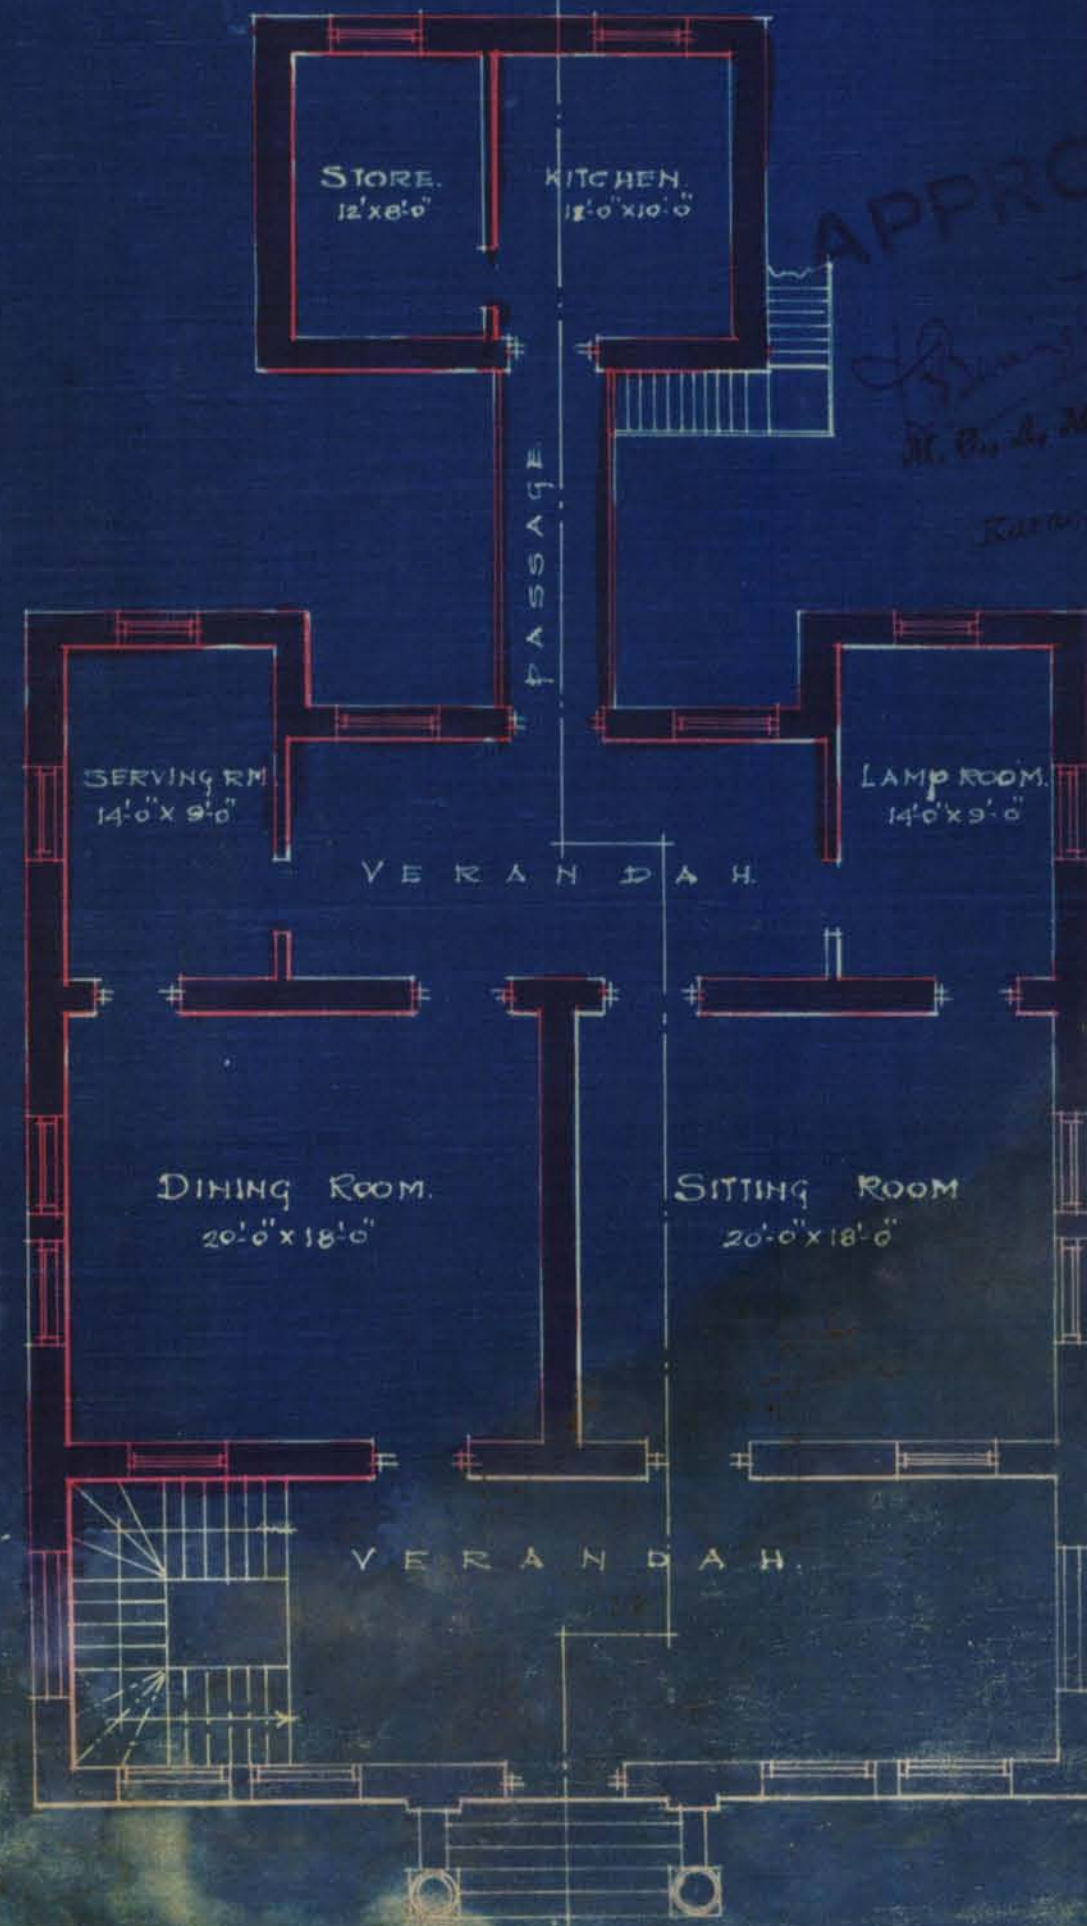


GROUND PLAN

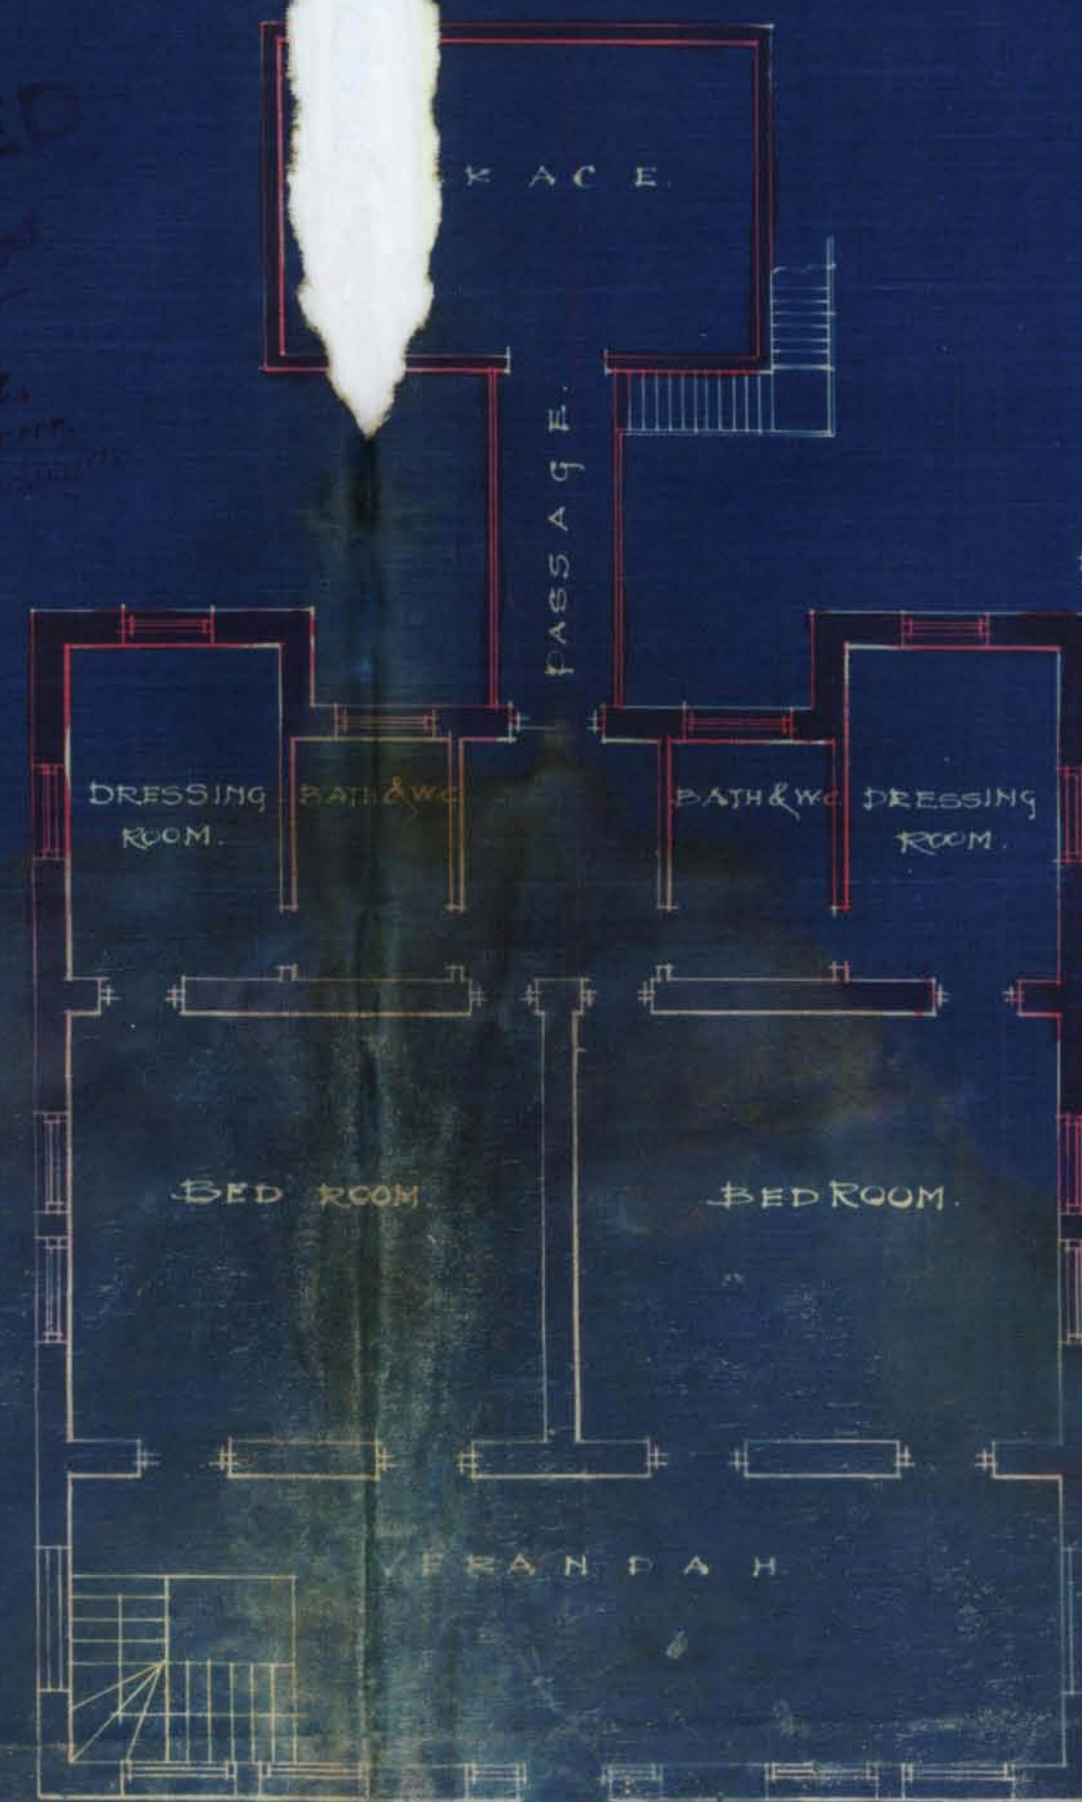


FIRST FLOOR

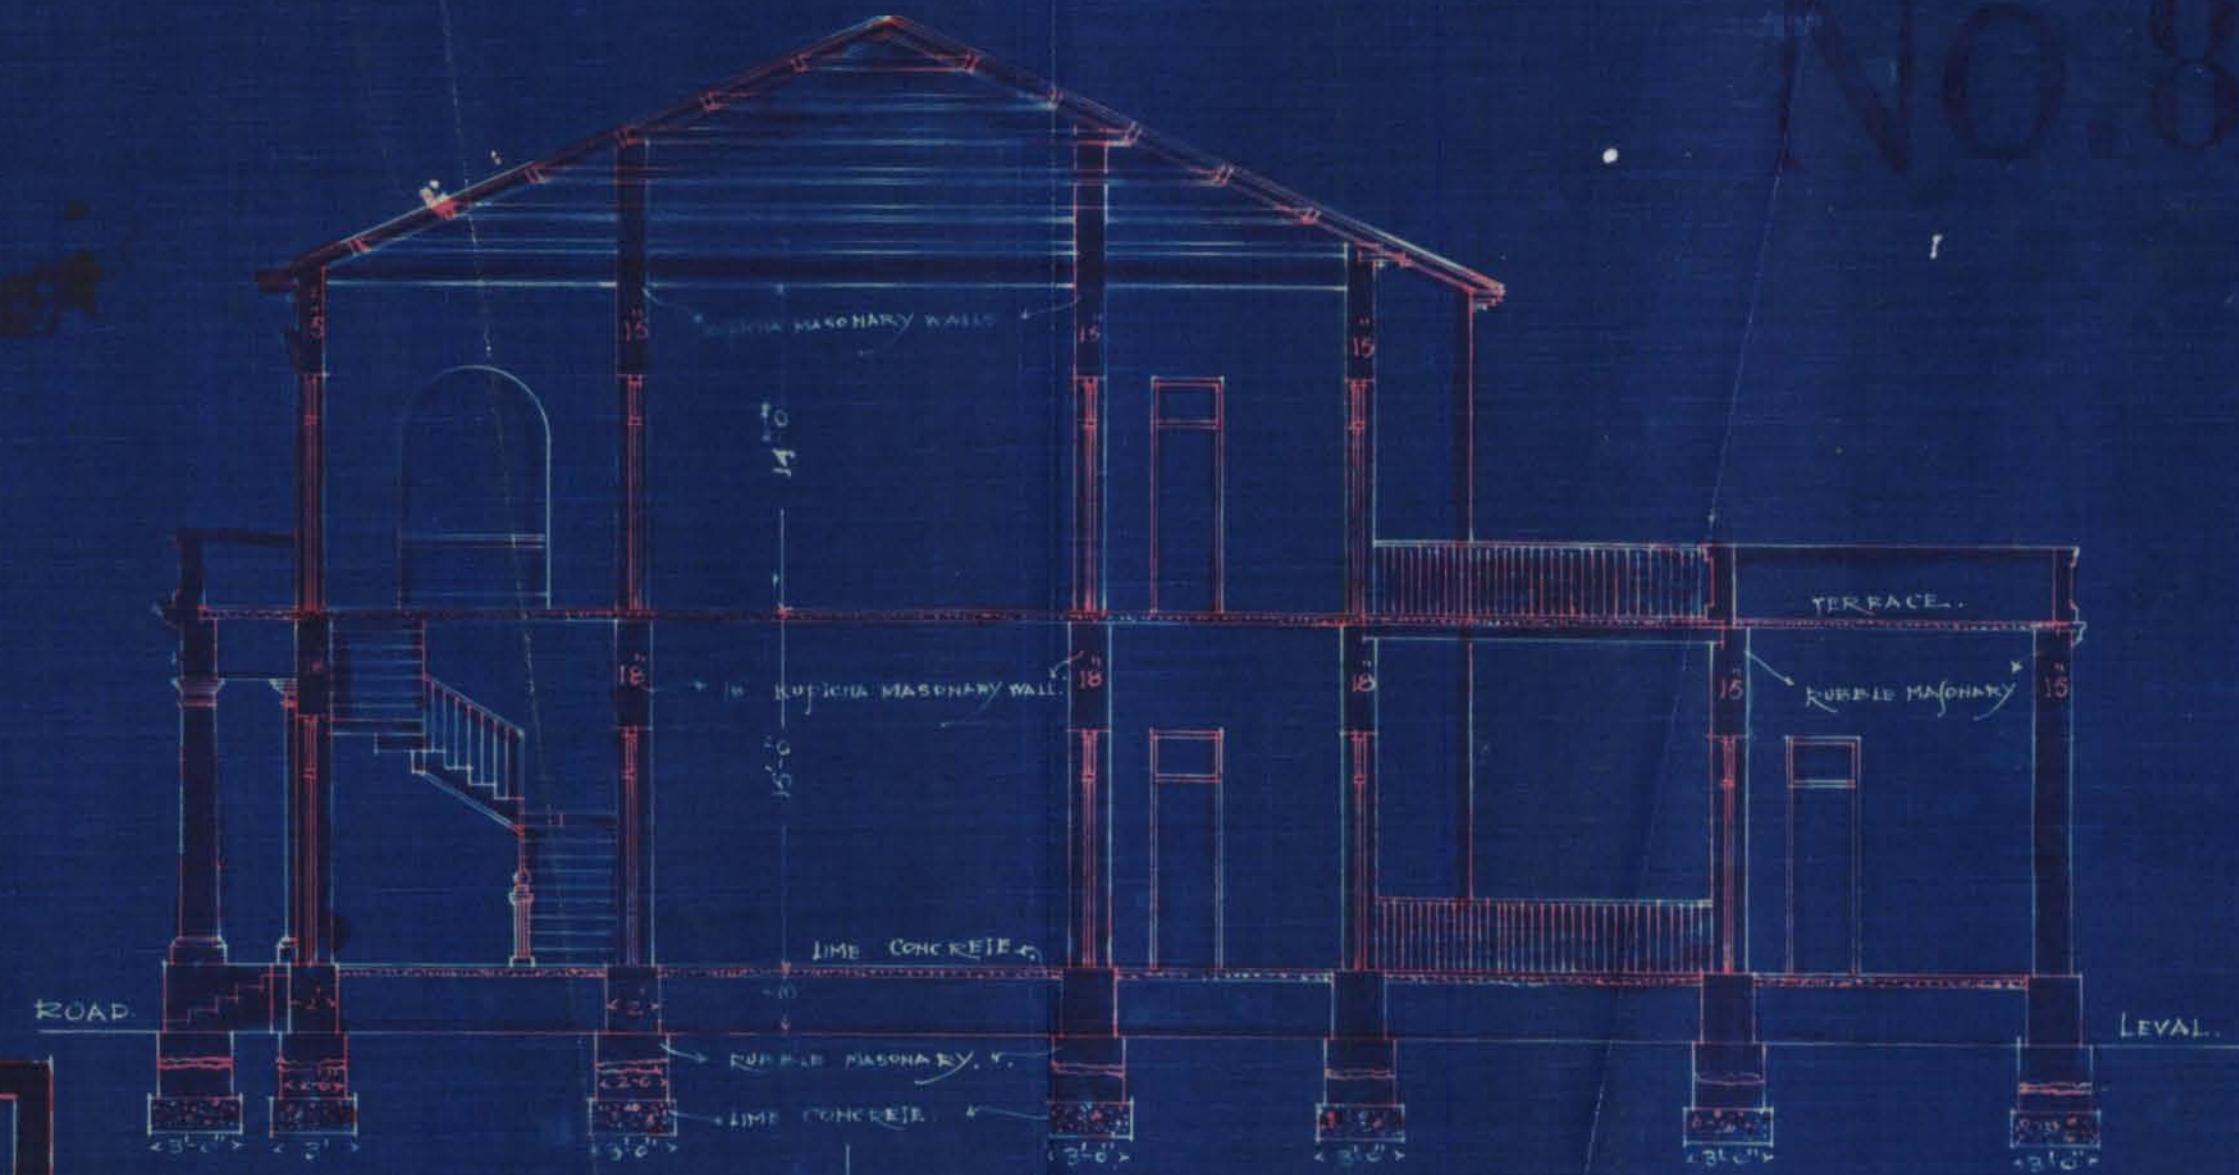

SECTION ON A-B.

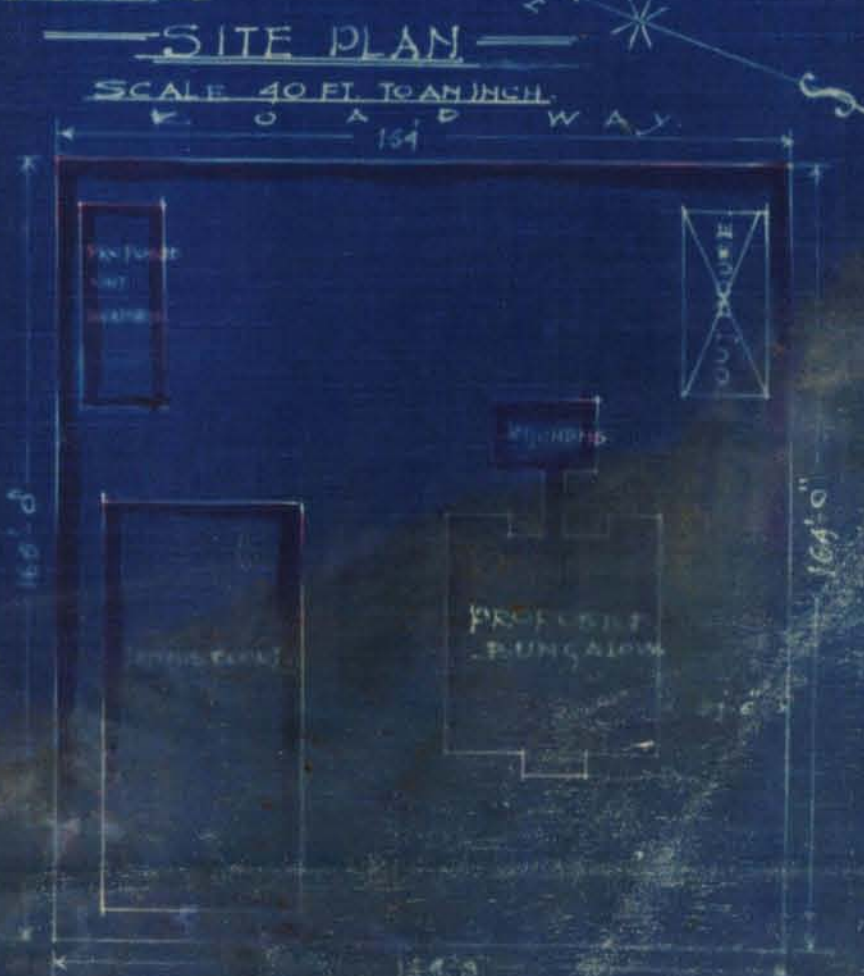

SITE PLAN
SCALE 40 FT. TO AN INCH

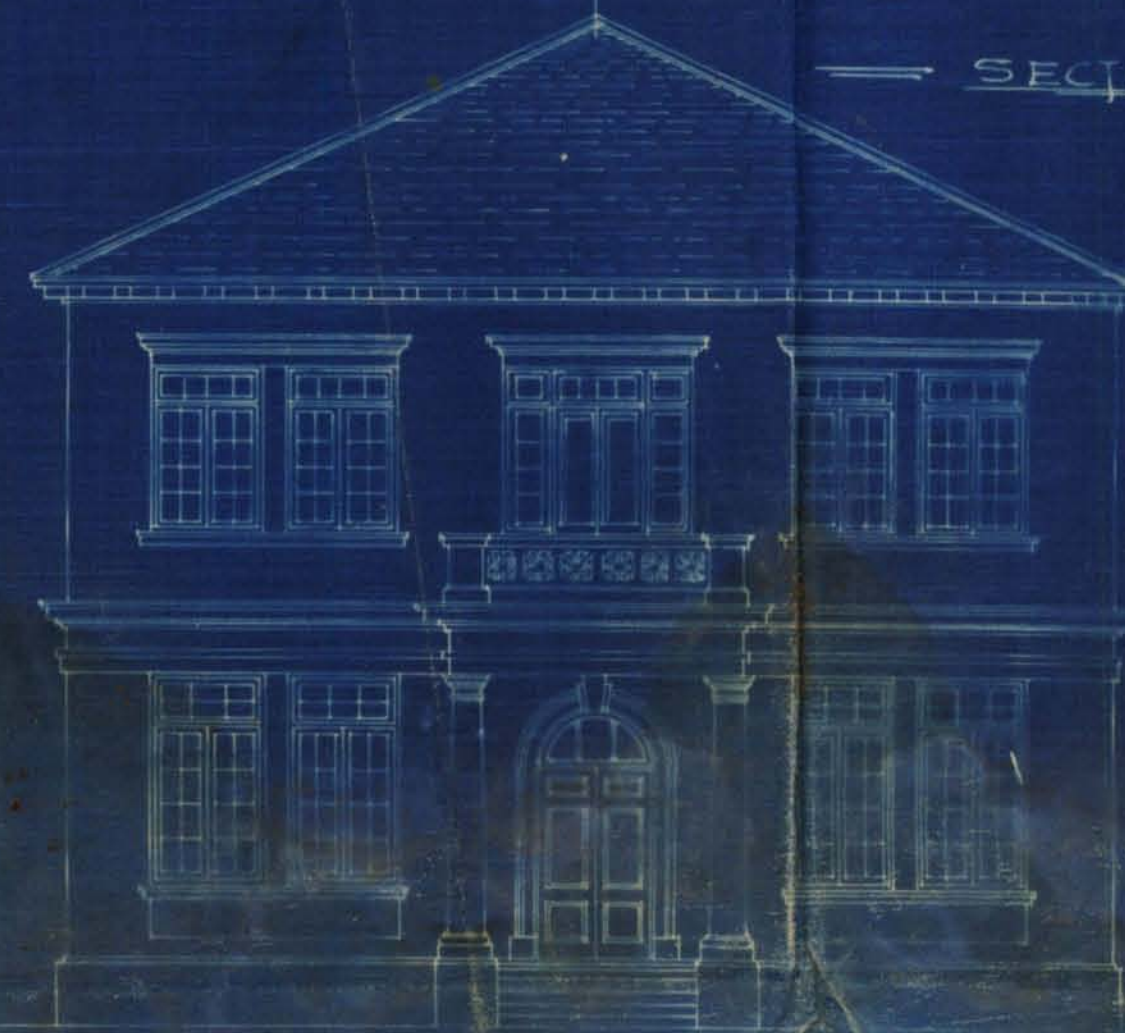

FRONT ELEVATION

HERITAGE FOUNDATION
CONSULTANTS & ARCHITECTS

Form No. 6-300-25-9-20.

No. L. S. **6943** OF 1921.

MUNICIPAL OFFICE,

Karachi, 26 10 1921.
28

MEMO:

Building Surveyor Section A is informed
that Mr. Hami K. R. Mehta has been permitted
to build a bungalow
his house
on plot No. 39 St. Street
Frere Town Quarter report should be made to the
Engineer in Charge when the house is completed.

M. I. MECH. E.,
Ag. Engineer,
Karachi Municipality.



No. L. S. 1196 of 1920.

Municipal Office,

Karachi, 10 March 1922.

2nd Feb

MEMO:

Undersigned has the honour to forward to the Chief Officer and Chief Engineer the accompanying plan for the proposed building on plot No. 39 Sheet 91. Free Town Quarter submitted by Mr. Monsi D. D. Luckha the registered occupant of the plot.

There being no objection from either a Municipal or Sanitary point of view, undersigned recommends permission to build may be accorded, with the sanction of the Managing Committee, under the *Land Sale Rules*, the plot being under the control of the Municipality.

For m.c.
4/3/22
3/3
173

Damington Drow
M. T. MEDH. E.
M. O., Acting Engineer,
Karachi Municipality
Karachi Municipality



100-14-5-211

No. E 46 of 1922.MUNICIPAL ENGINEER'S OFFICE,
Karachi, 8th February 1922.

MEMO:

The above application is forwarded to the Municipal Health Officer
for favour of report.

Inspector Attop
Show to H.O.
8/2

S. Chaudhary
Engineer,
Karachi Municipality.

MUNICIPAL HEALTH OFFICER'S REPORT.

Returned to the Engineer, Karachi Municipality, with the following

Remarks:—

No objection

4066
8/2/22

to report that the foundation is strong & only slight cracks in concrete.
The width of the foundation is given only 3' 6" & should be 4' 6" which is a minimum.
Nothing is shown as in the plan for the foundation. It is suggested that the foundation be widened to 4' 6" & the cracks be filled with concrete.

D. P. H. (London),
Health Officer,
Karachi Municipality.

Date 9-2-1922

No. E. 46 of 1922

MUNICIPAL ENGINEER'S OFFICE,

Karachi, 10th February 1922.

Forwarded to the Building Surveyor and Land Surveyor for report.

[Signature]
M. E. S. E.,
Engineer,
Karachi Municipality.

BUILDING SURVEYOR'S REPORT.

Applicant's Name Ismahax Haji Chaudh.Whether he is the owner of the plot on which it is proposed to build yesPlot under whose control municipalWhether it is permanent or temporary permanentThe work proposed Building.Building Surveyor's Report See,

I beg to report that the ~~depth~~ ^{depth}
of the foundation is shown ~~somewhere~~ ^{somewhere}
3'-6" somewhere 3' only which should
be corrected

The width of the foundation is given
only 3' for 3 storied building which
appears insufficient

Nothing is shown as in the registered
book. for the ownership. D.S. is requested
to give all information about this.

The $\frac{1}{2}$ area open to sky include staircases & balconies

Date 13/2/22

[Signature]
Building Surveyor.



LAND SURVEYOR'S REPORT.

Does the plot come under Alignment no
Area of plot —
Area under Alignment —
Remarks See

The applicant must strengthen the foundation especially to carry a stoneid blf. or proposed & he must provide clear open space equal to $\frac{1}{3}$ of the total area of the plot as contemplated by the conditions of Sale.

Date 14/2 192 2 SMA. Kachra
Land Surveyor.

ORDER OF THE ENGINEER.

Lfor

14/2

M. C., A. M. INST. C. E.,

Engineer,
Karachi Municipality.



No. L. S. of 192

MUNICIPAL ENGINEER'S OFFICE,

Karachi, 192

Submitted to the Managing Committee for information,

M. C., A. M. I. C. E.,

Engineer,

Karachi Municipality

Through

THE CHIEF OFFICER & CHIEF ENGINEER,

Karachi Municipality.

RESOLUTION OF THE MANAGING COMMITTEE.




Resolution No. dated

PROPOSED BUNGALOW
ON PLOT No 39 SHEET No.
FRERE TOWN QUARTERS
SCALE 8 FT TO AN INCH.


AREA OF THE BUNGALOW 513.5 SQ YDS.
" " " OUT HOUSES 166.5 SQ YDS.
TOTAL BUILDING AREA = 679.5 SQ YDS.
PLOT AREA 2848.5 SQ YDS.

SITE PLAN


SCALE 40 FT TO AN INCH

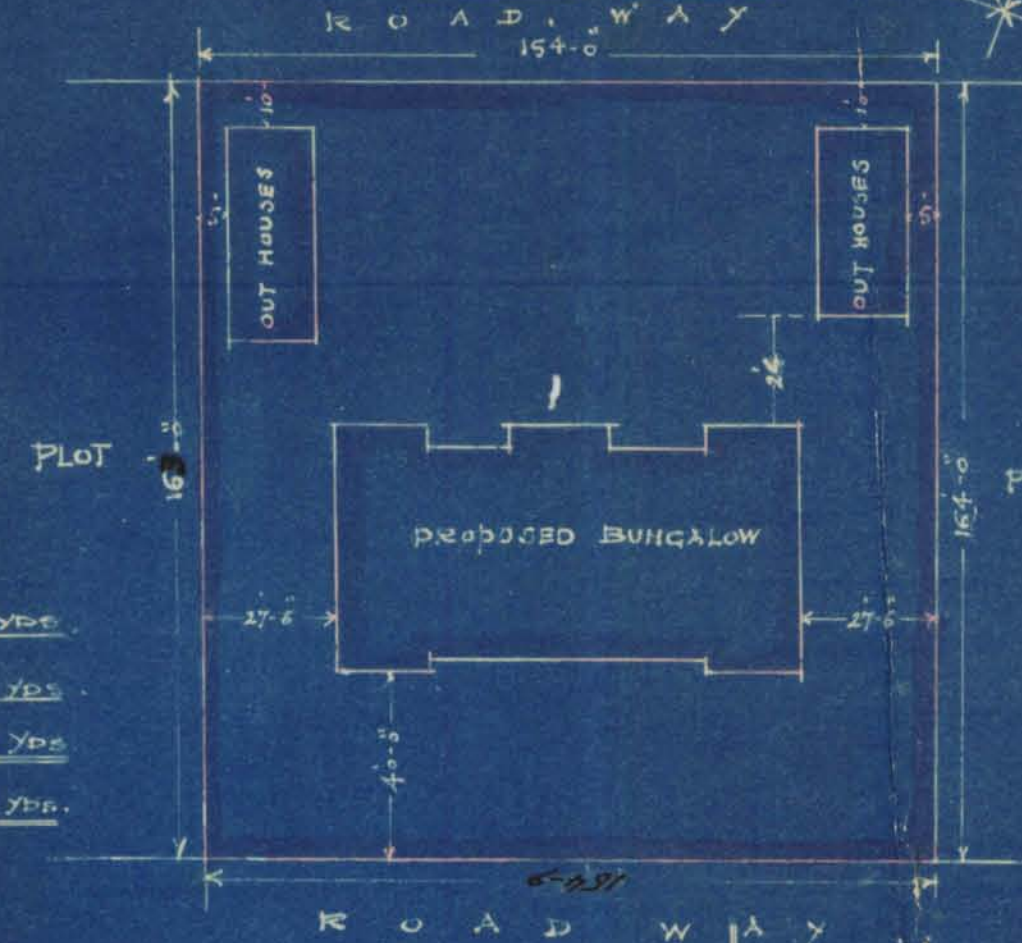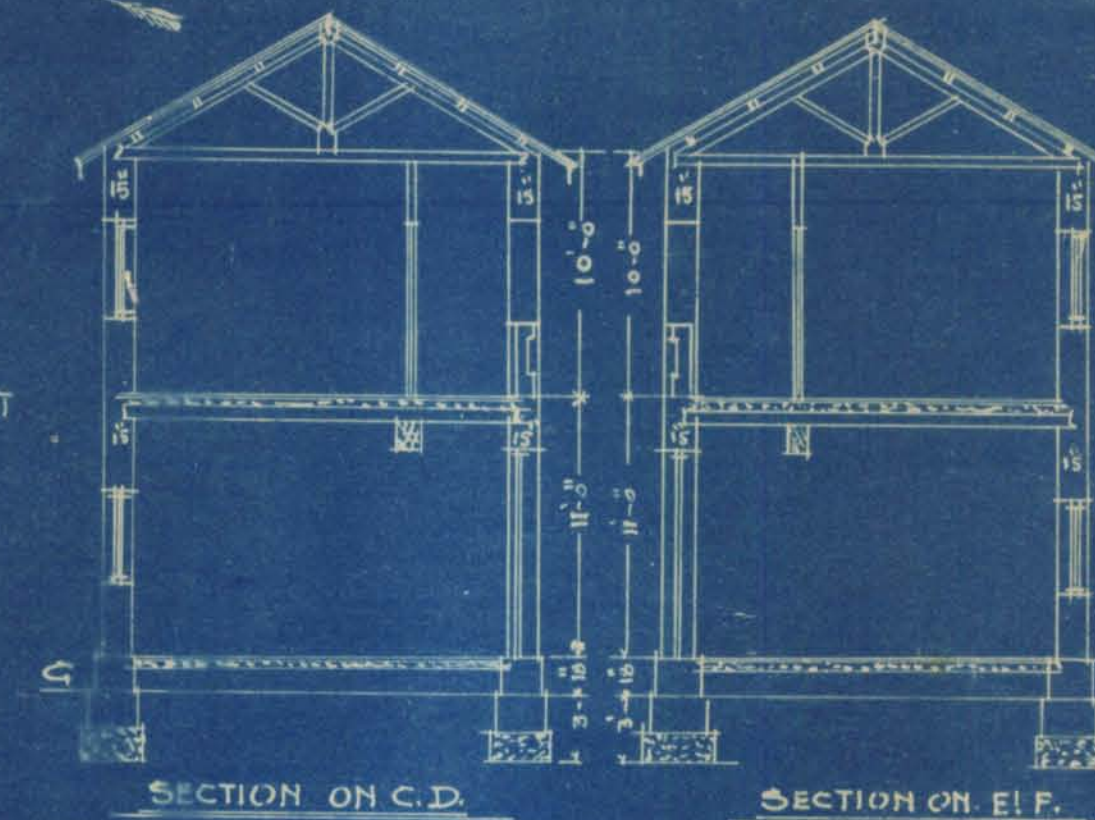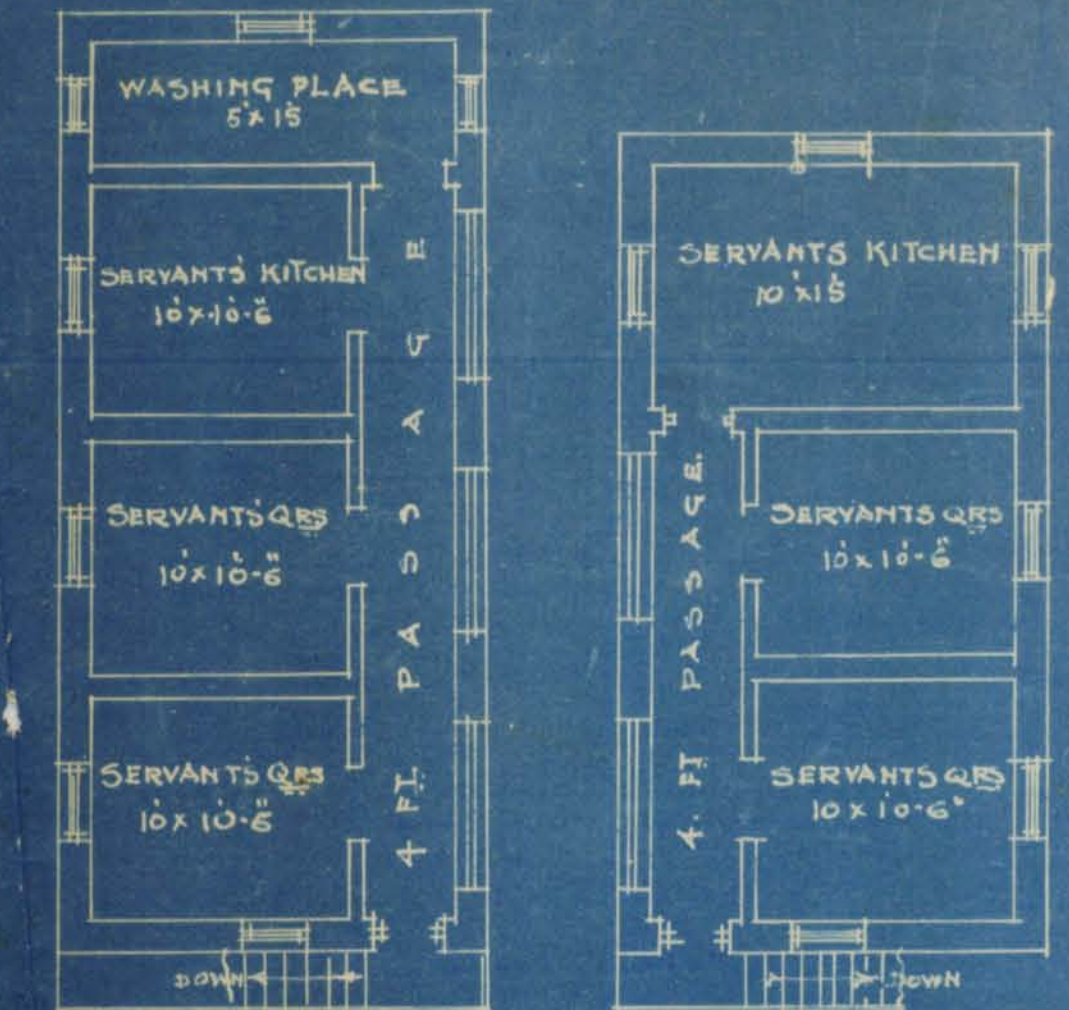


PLAN OF FIRST FLOORS

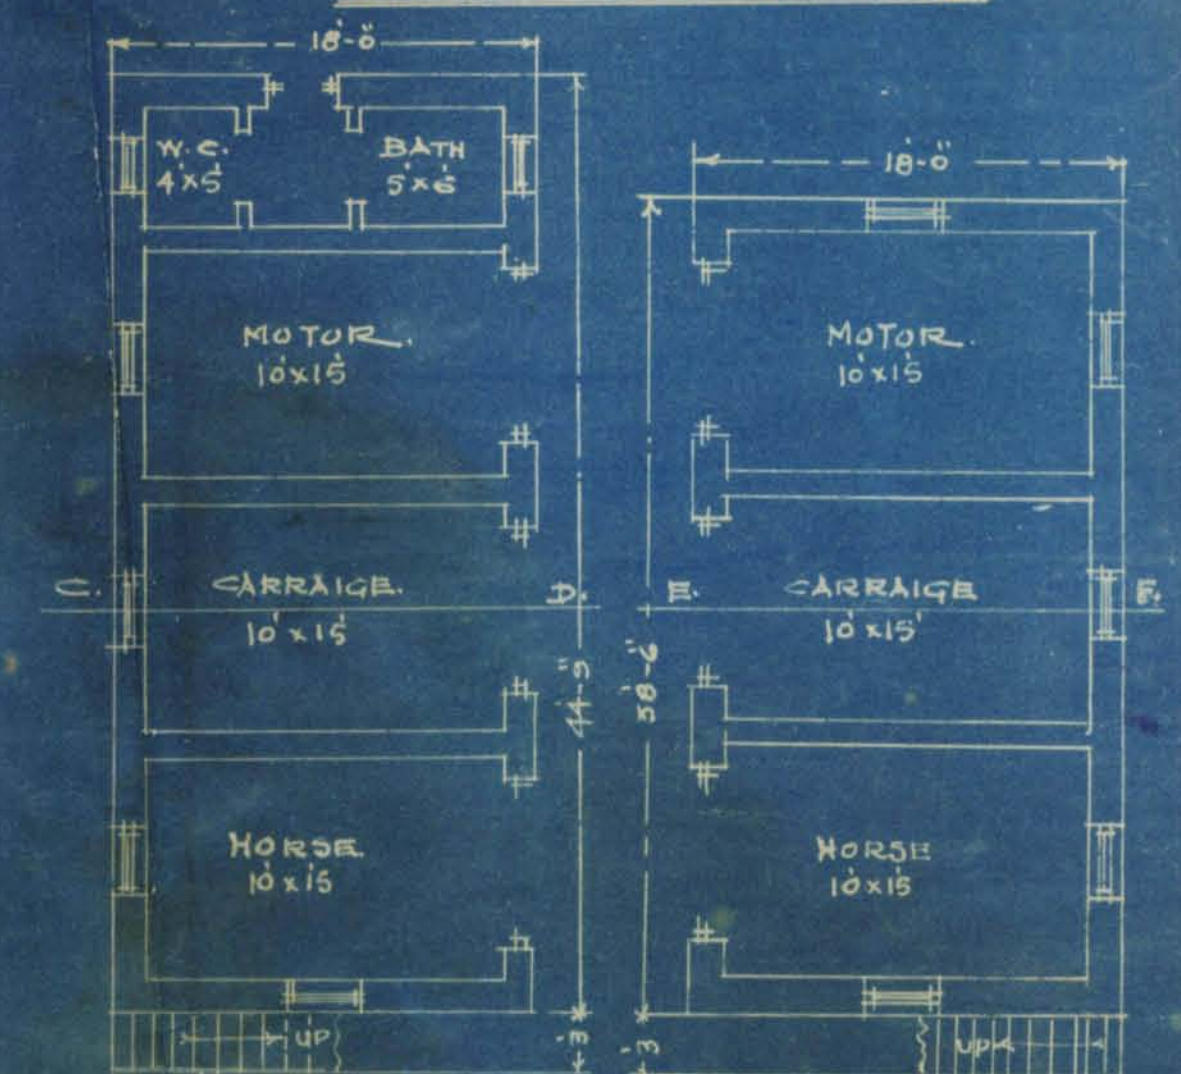


PLAN OF GROUND FLOORS

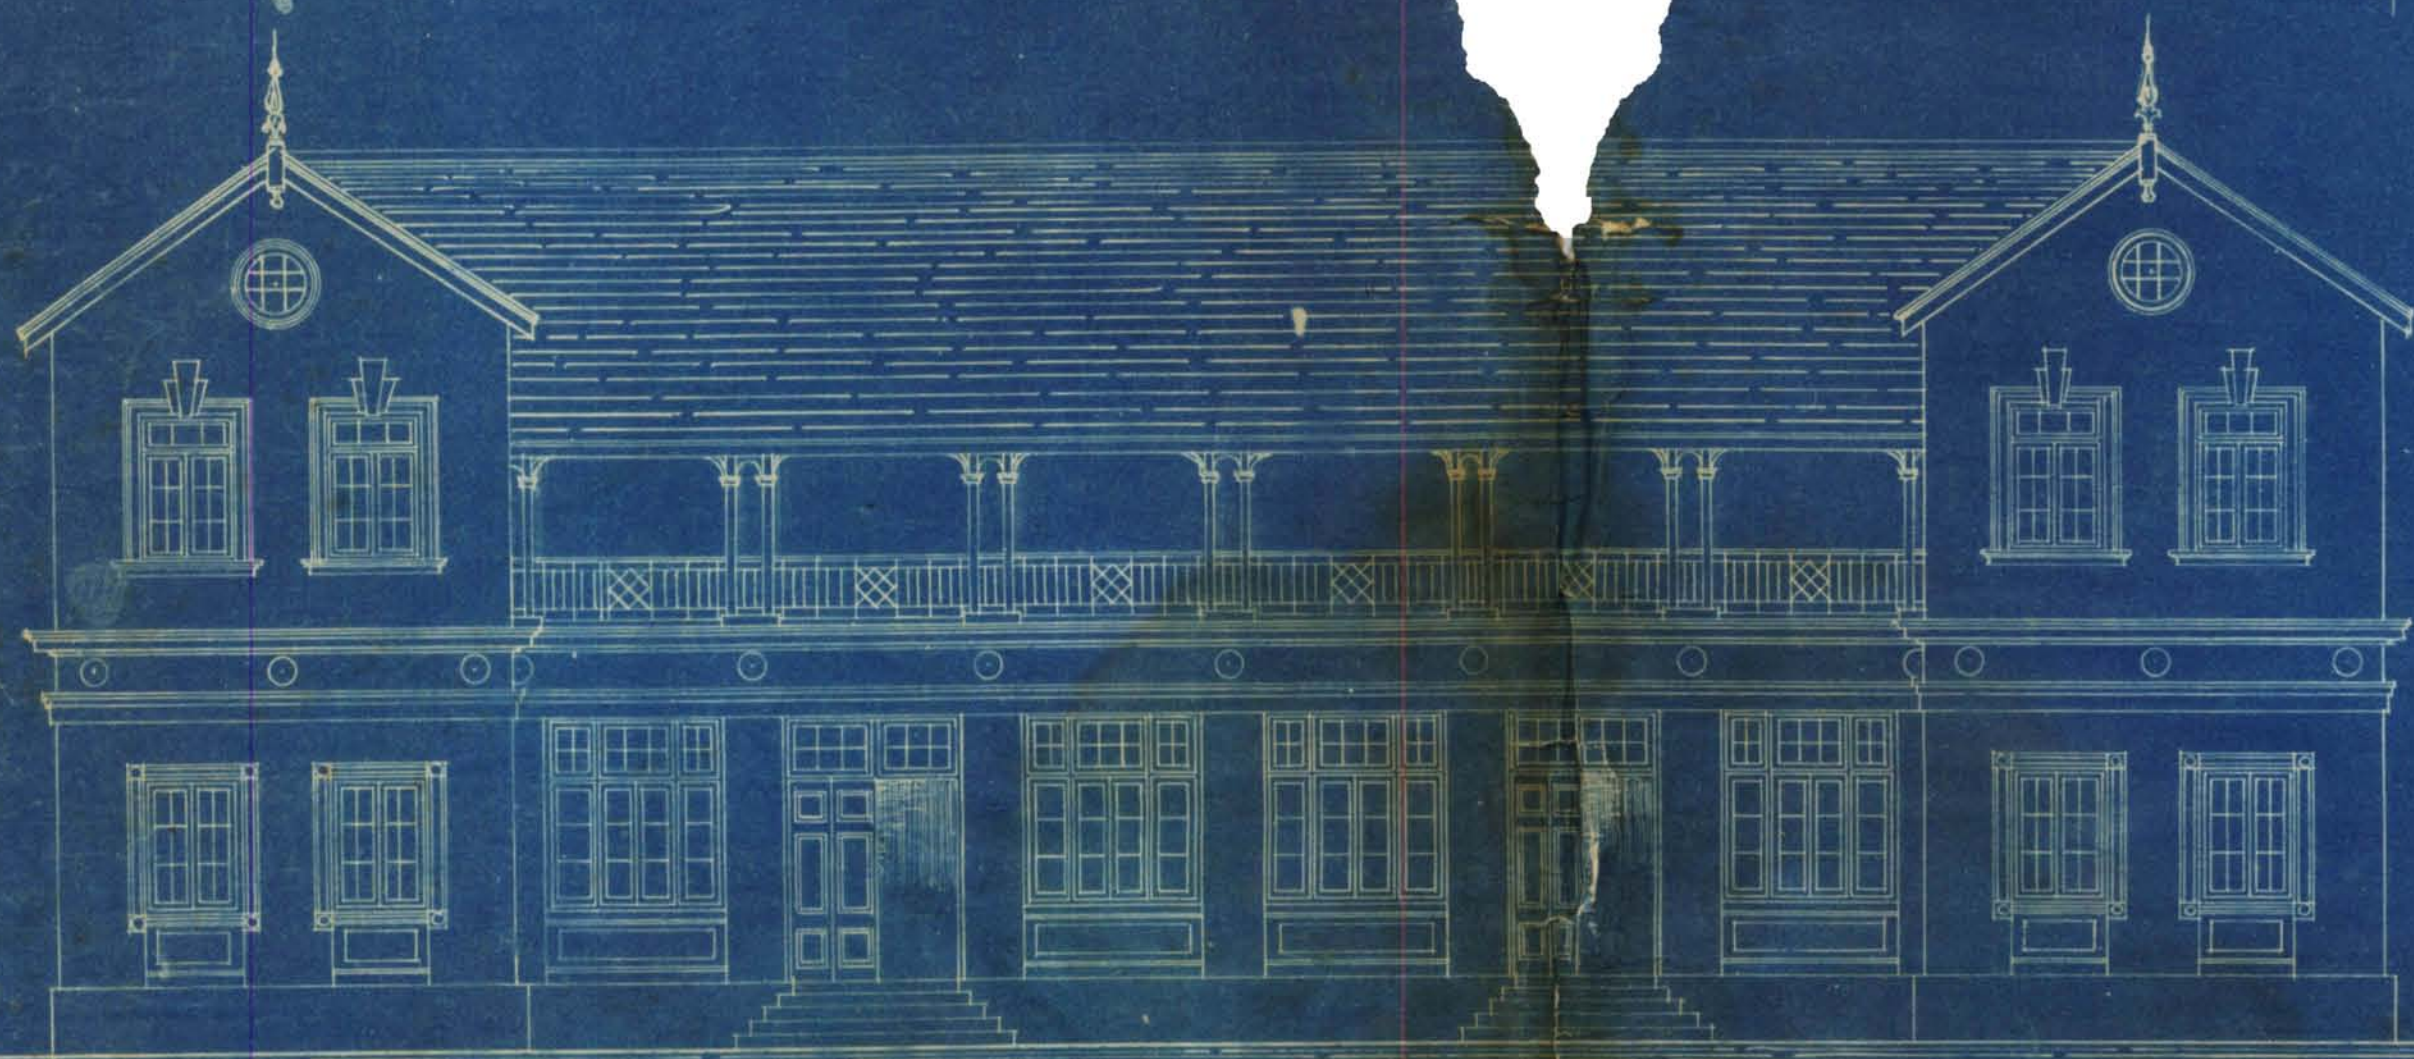


FRONT ELEVATION

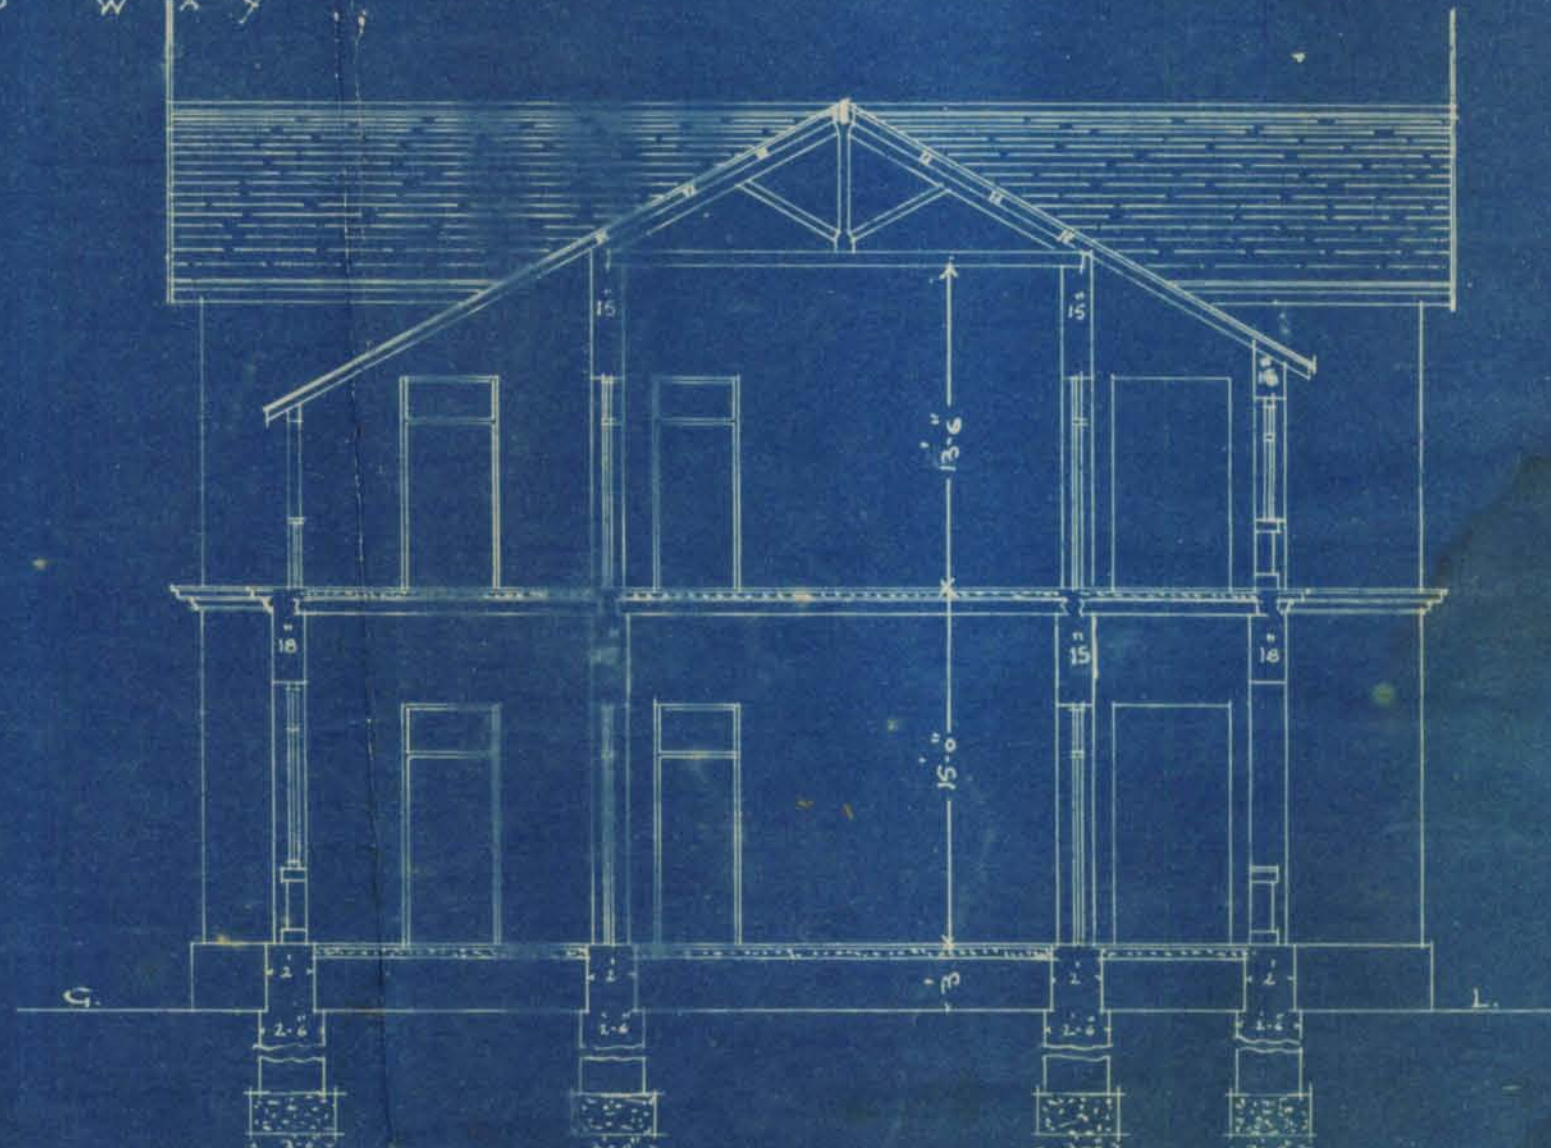

SECTION ON A.B.

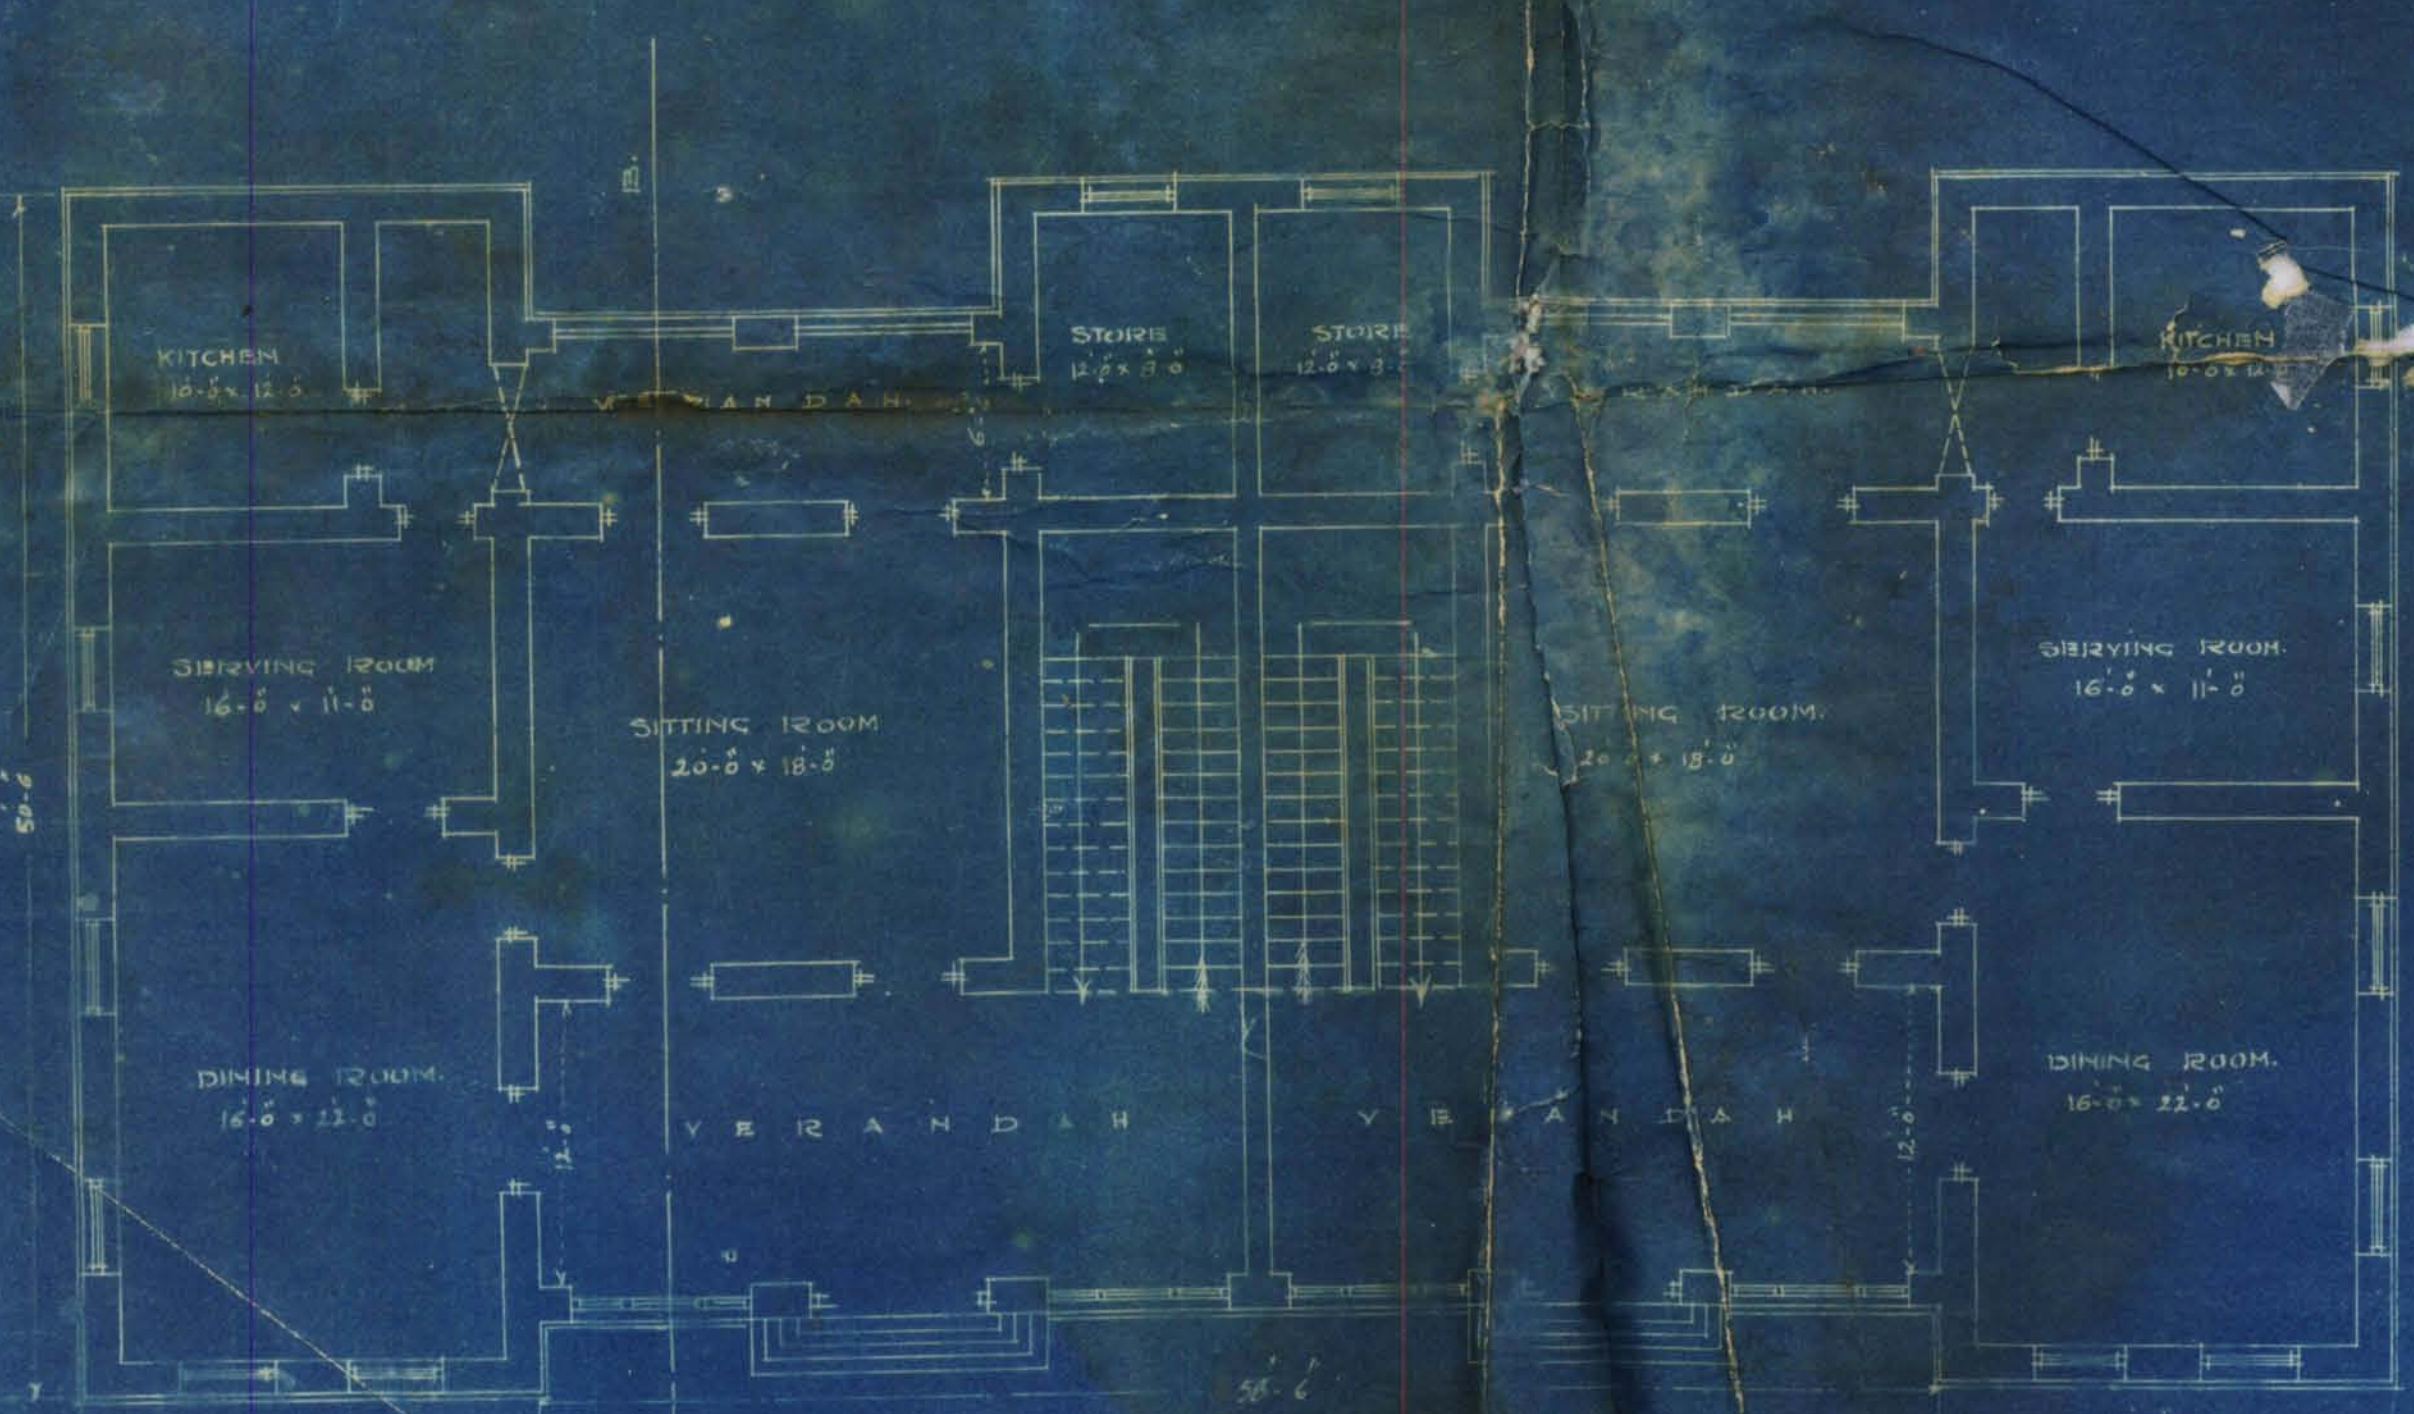

PLAN OF GROUND FLOOR

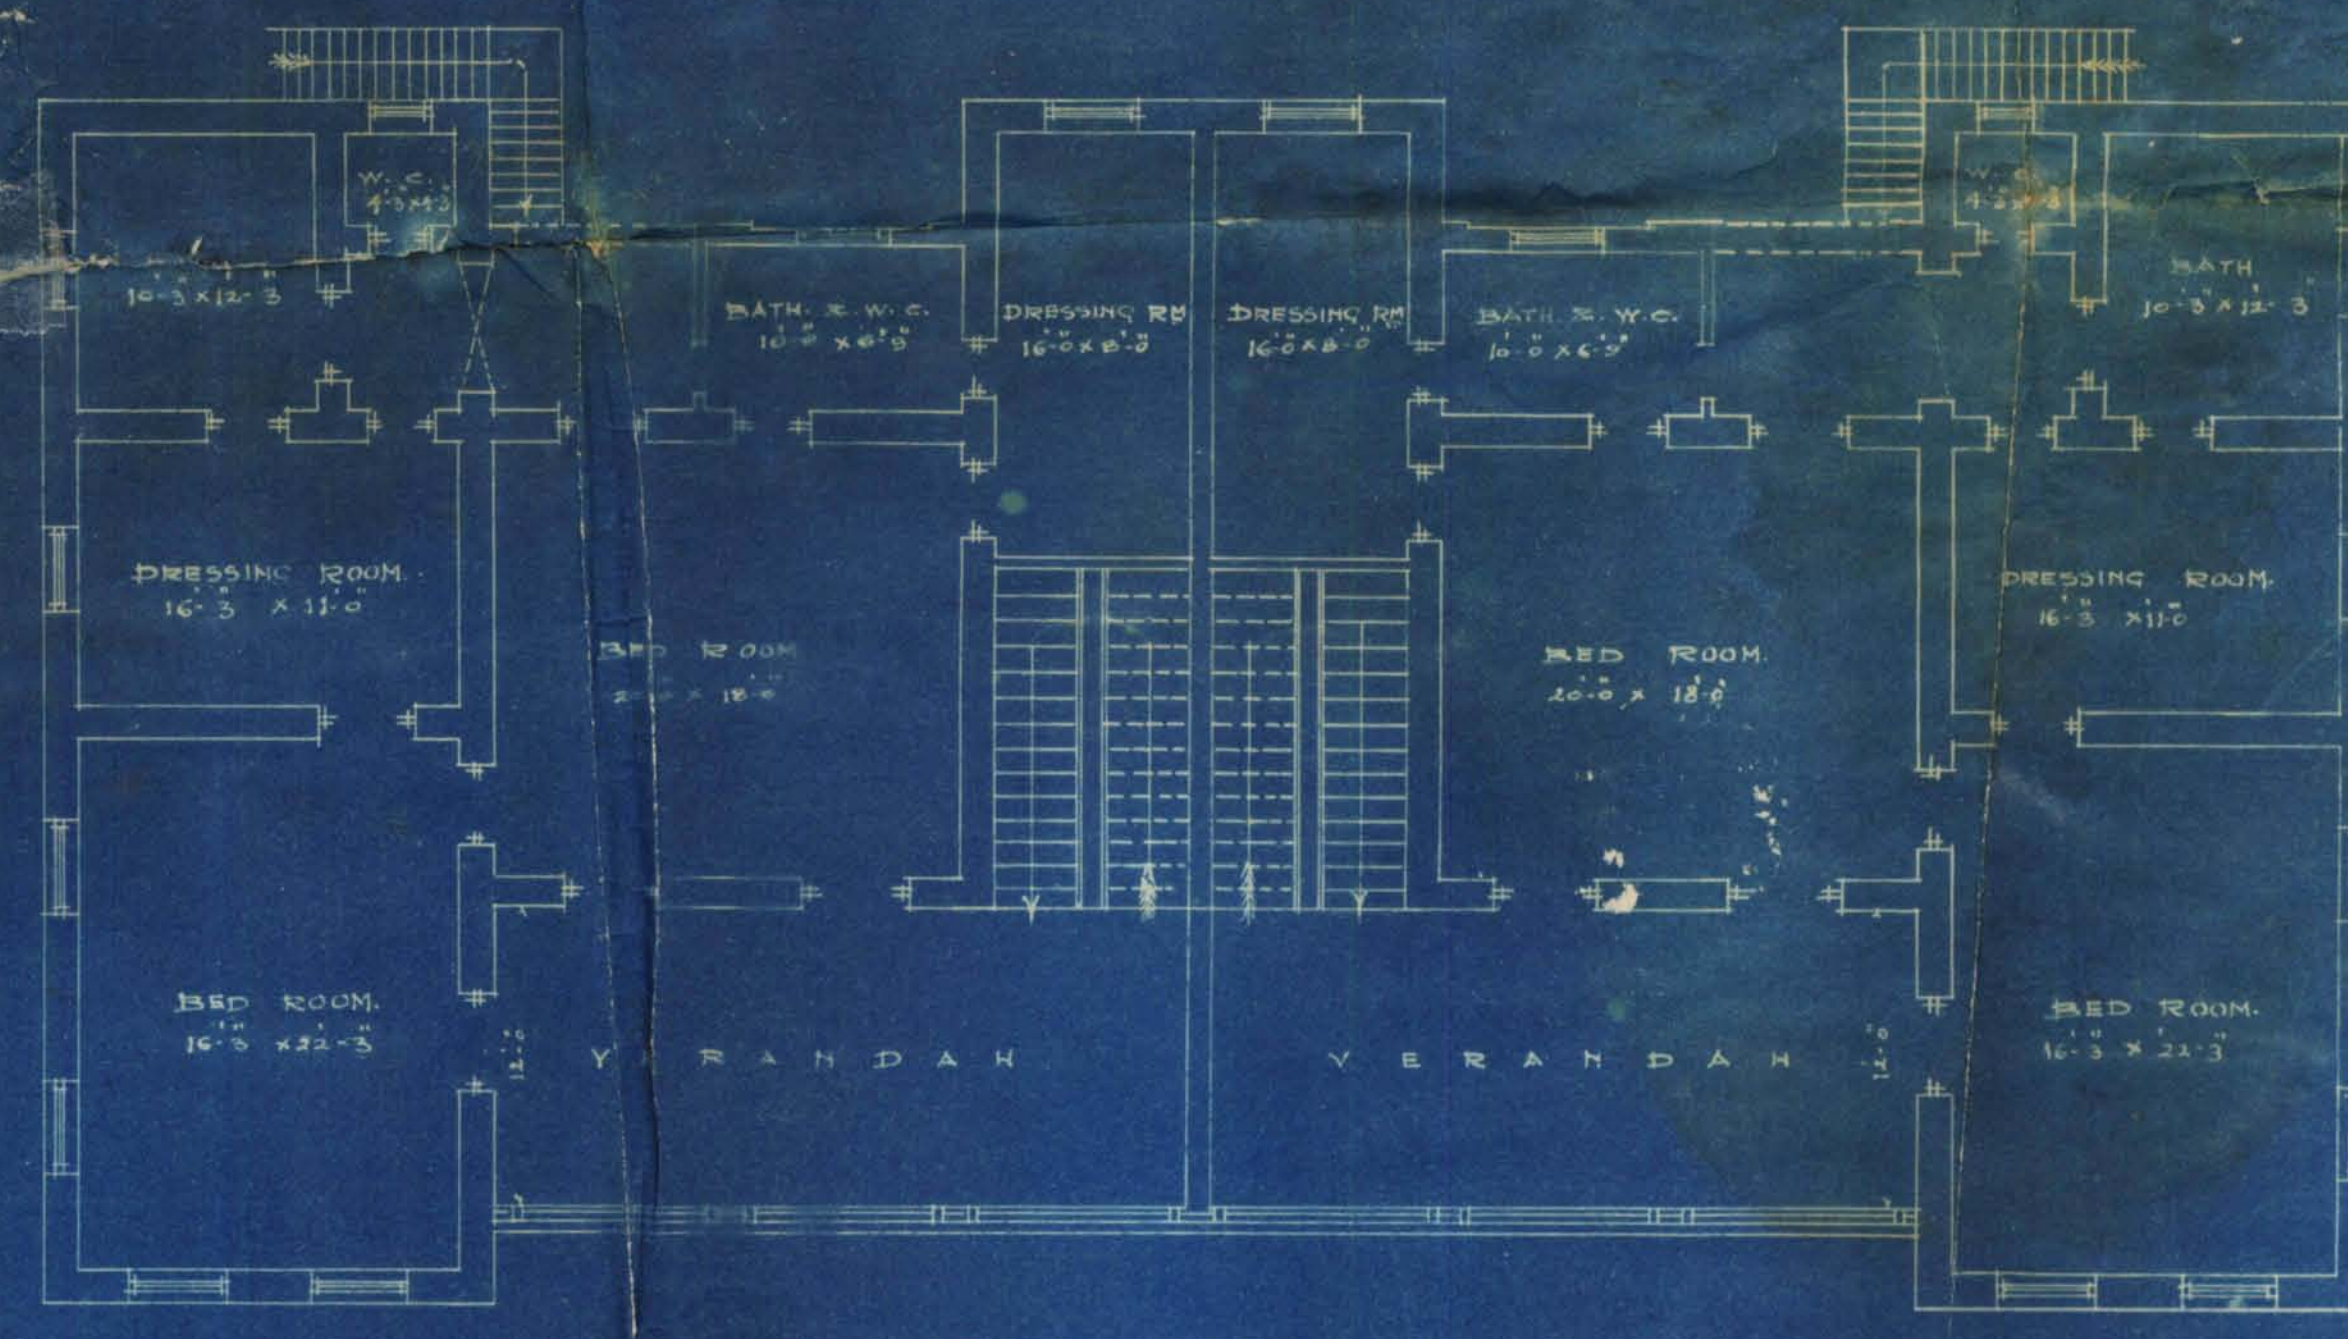

PLAN OF FIRST FLOOR

No. 341

APPROVED

M. I. A. L.
S. A. S. L. E. B. S.
ARCHITECTS & CIVIL ENGINEERS