



No. L. S.

OF 192

NO. 143

Form No. 6—100—25.9.20.

1100

MUNICIPAL OFFICE,

Karachi,

28

4

1927

4.5.21

MEMO:

Building Surveyor Section

A

is informed

that Mr.

R. Camarj

has been permitted

to

make additions on

his house

on plot No.

9^A

Macmill

Street

Free Town

Quarter report should be made to the

Undersigned when the house is completed.

LB

m e. A

M. I. MECH. E.,

Ag. Engineer,

Karachi Municipality.

Building Completion Report.

MUNICIPAL OFFICE,

Karachi, 20th May 192 /
23

To

THE ENGINEER,

KARACHI MUNICIPALITY.


SIR,

S. P. 1482 / 23.5.22
I beg to report, the building work on plot No. 9A Sheet II
Free Tower. Quarter owned by Mr. R. Cowaji

is completed according to the plan approved by the Municipality. Orders are requested to file the correspondence.

Copy to the A/c for information

Yours obediently,

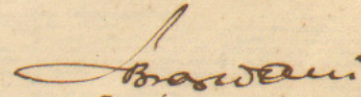Building Surveyor "A" Section,
Karachi Municipality.




Heritage

KMR.CDD.FrQ.1921.01

No. 148

SITE PLAN SCALE 40 FT TO AN INCH

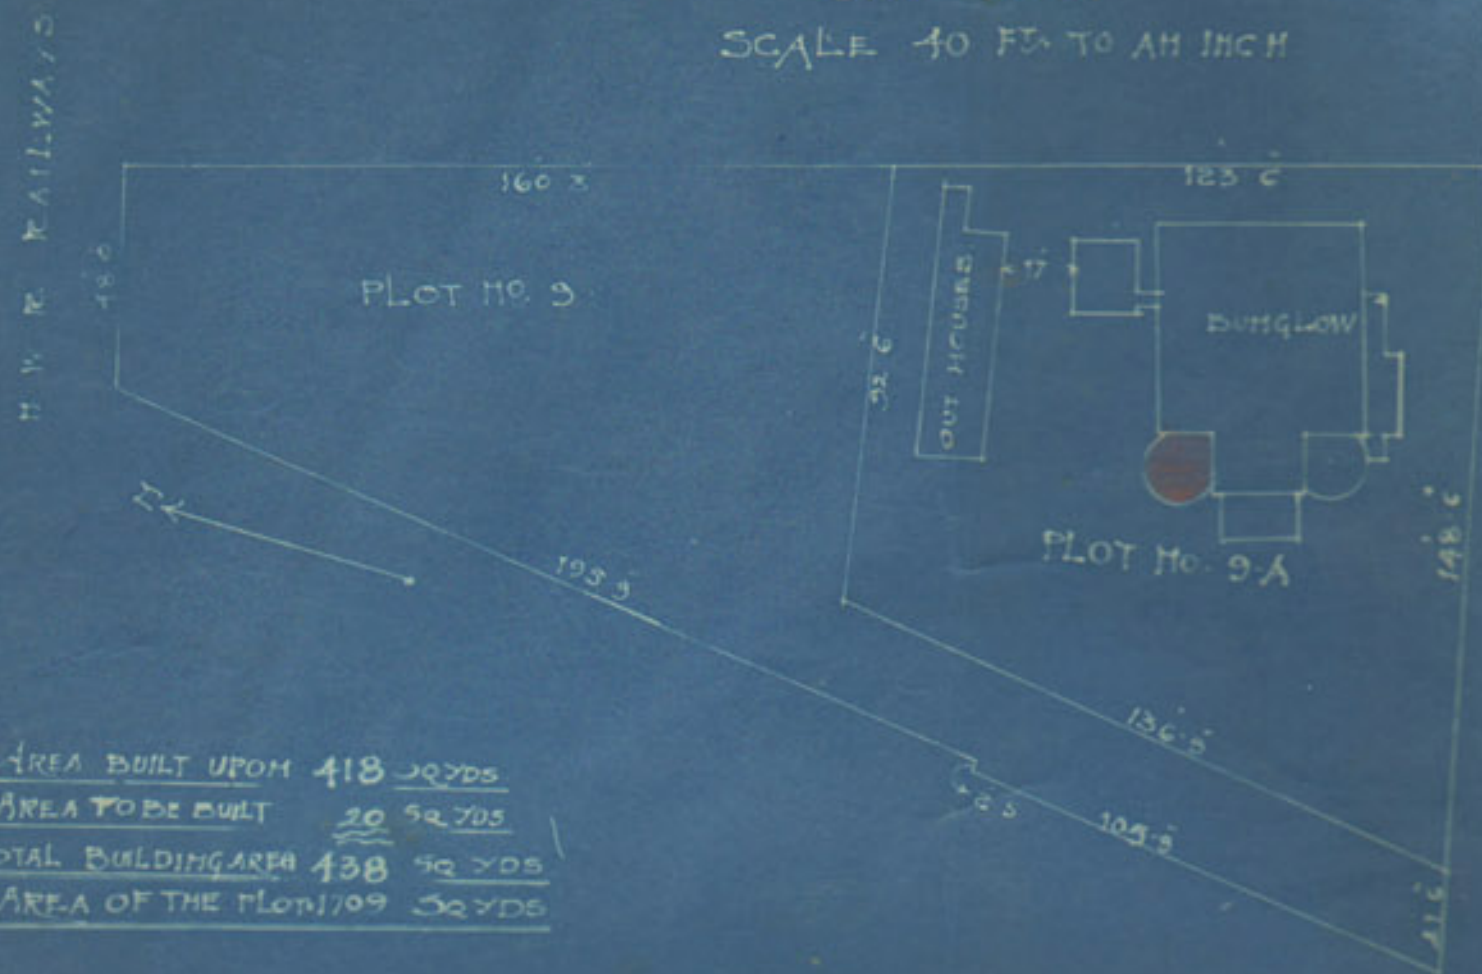

NOTE

AREA BUILT UPON 418 SQYDS
AREA TO BE BUILT 20 SQYDS
TOTAL BUILDING AREA 438 SQYDS
AREA OF THE PLOT 1709 SQYDS

APPROVED

PROPOSED ADDITIONS

ON


PLOT NO. 9A SHEET NO. J-1

FREE TOWN QRS


SCALE 8 FT TO AN INCH

NOTE

NEW WORK SHOWN IN RED

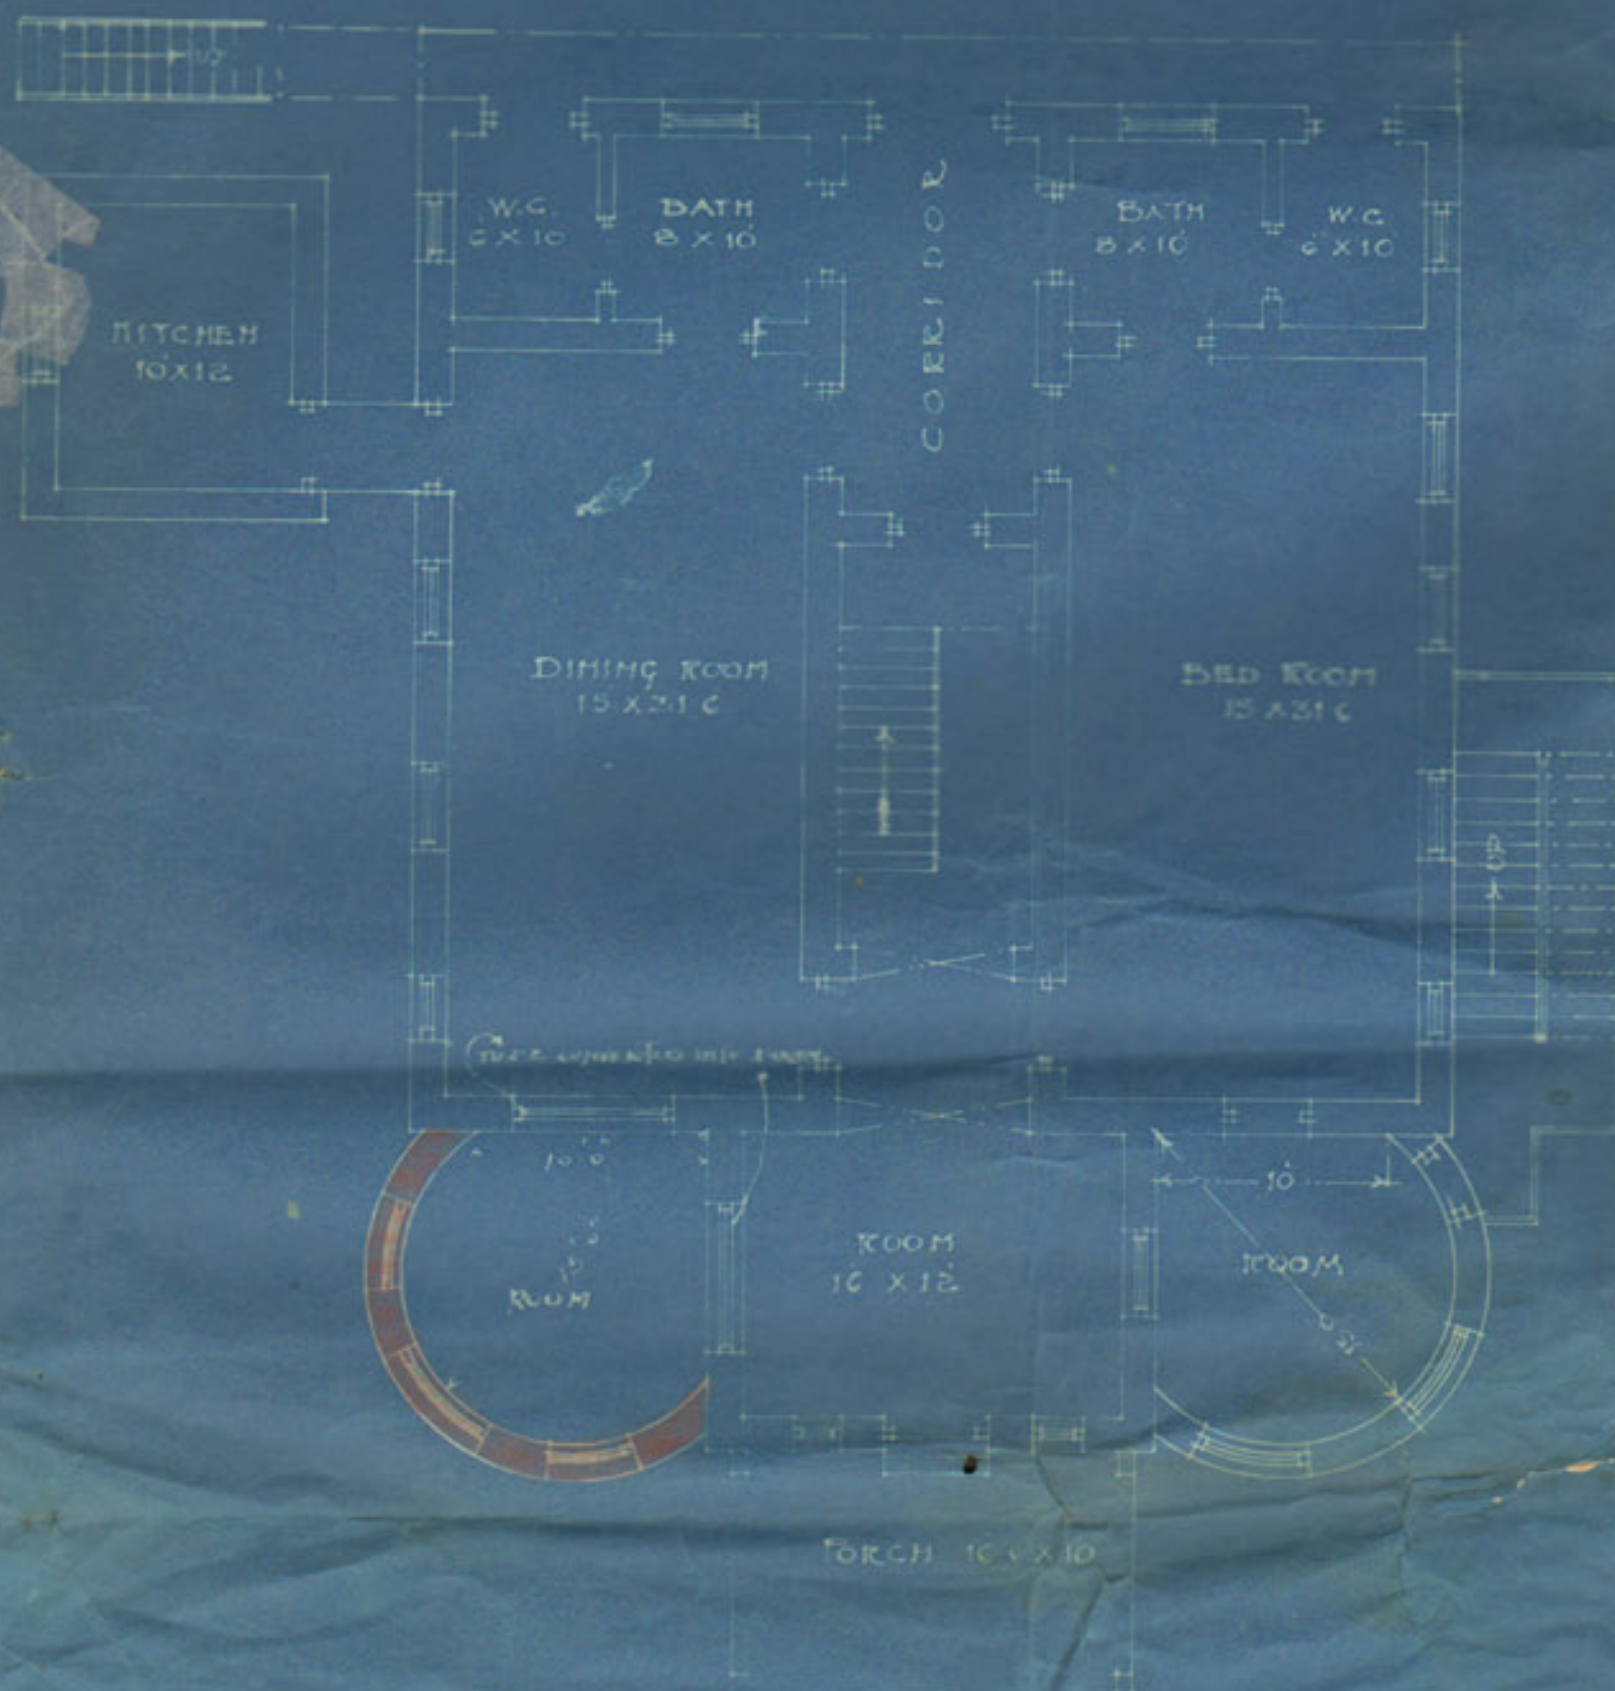

PLAN OF GROUND FLOOR

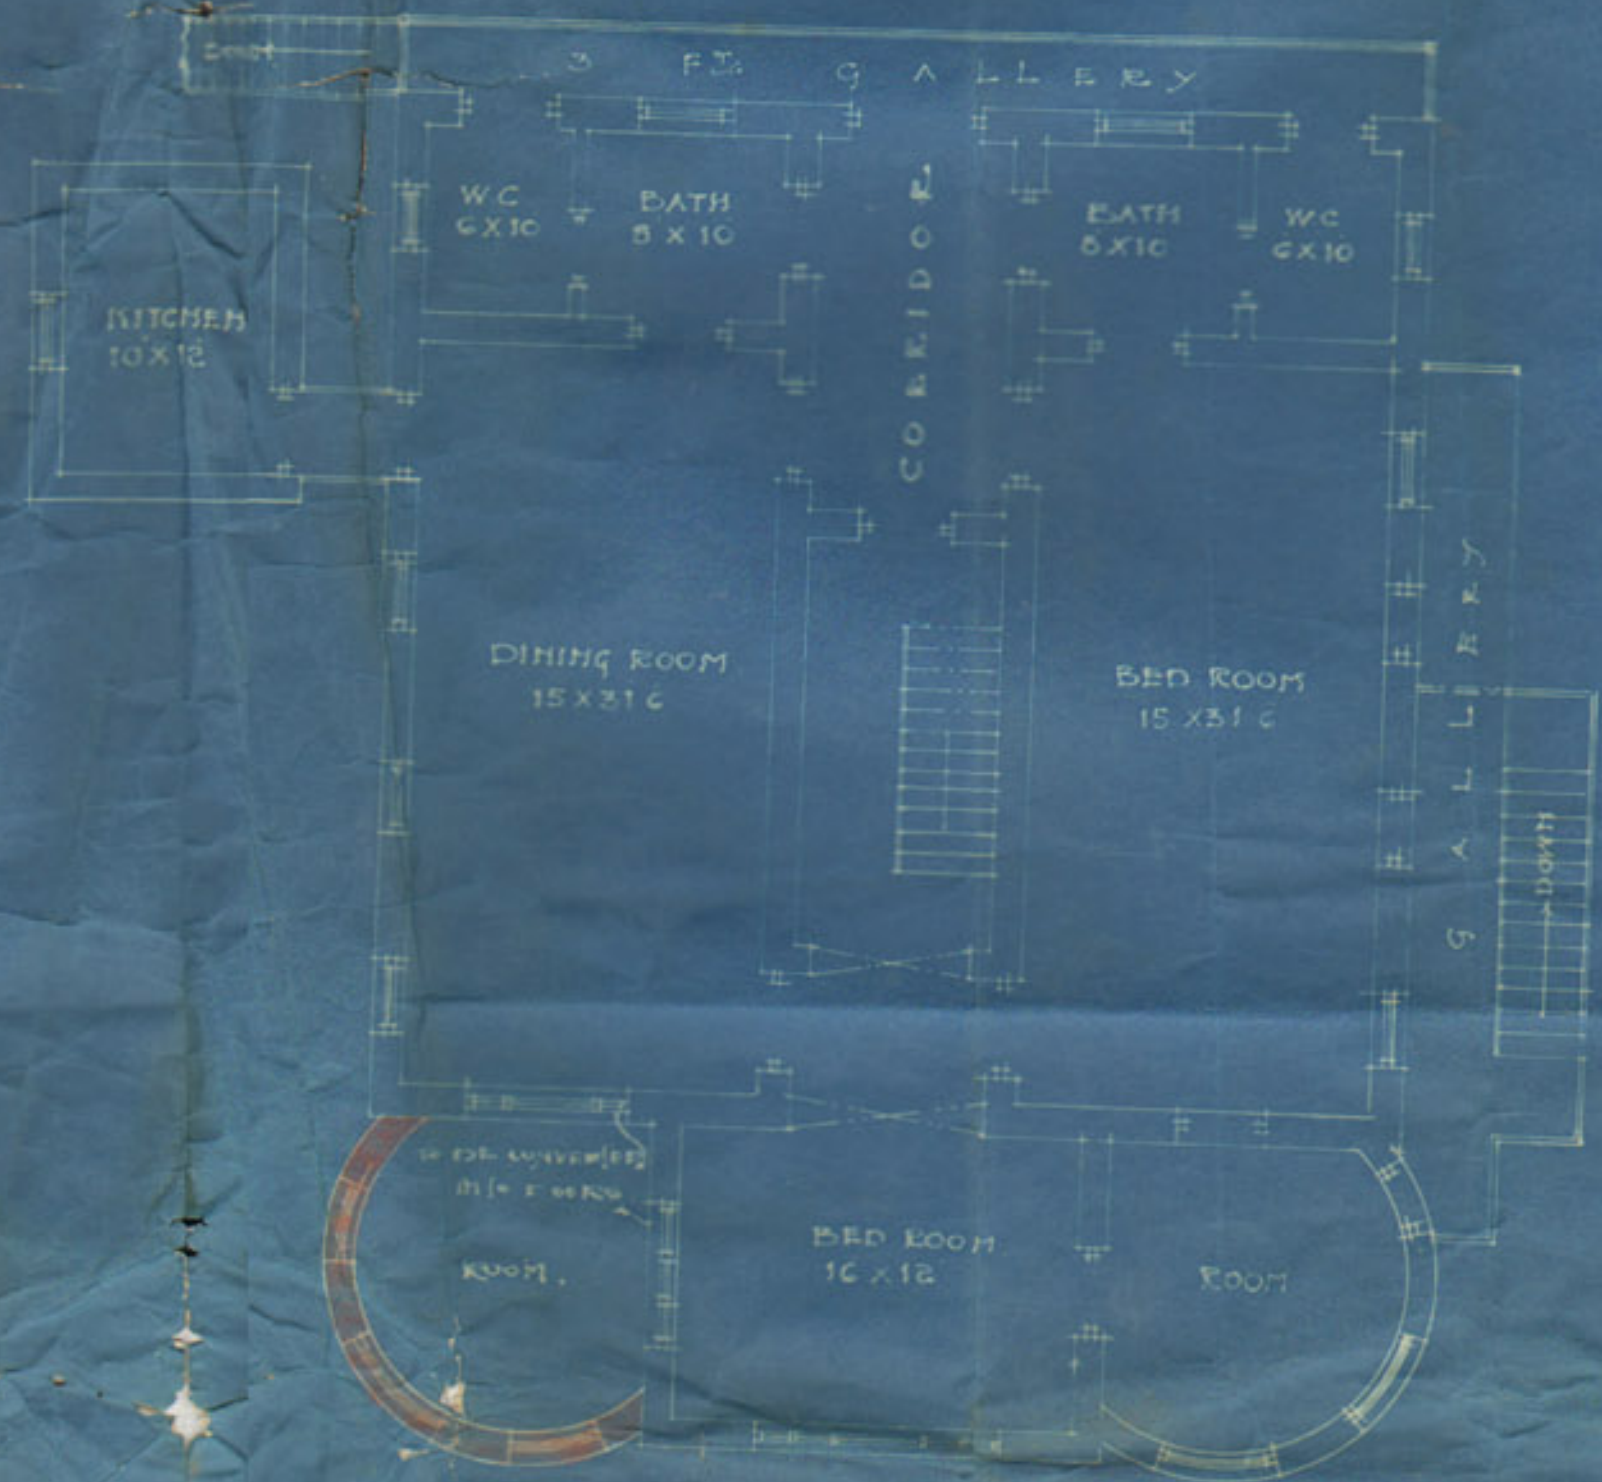

PLAN OF FIRST FLOOR

Handwritten signature