

BUILDING COMPLETION REPORT.

MUNICIPAL OFFICE,

Karachi, 30th June 1921
H.R.V.

To,

THE ENGINEER,

KARACHI MUNICIPALITY.

SIR,

H.G. 4097
1.7.21

I beg to report that the building work on plot No. 8/3
sheet 210 Garden Quarter owned by
Mr. Saleh Mahmud Khuria is completed
according to the plan approved by this office.

Copy to the A.C. for information

P. B. Shivdasan

30/6 *M. C. A. M. I. C. E.*
hw

Engineer,

Karachi Municipality

Yours obediently,

Brown
Building Surveyor, "A" Section,
Karachi Municipality.


No. L. S. 7696 OF 1921.

MUNICIPAL OFFICE,

Karachi, 6 / 1 1921.

MEMO:

Building Surveyor Section A is informed
that Mr. Salah md. K. Suma has been permitted
to build motor & servant room etc
his house
on plot No. 8/13 Dio Street
Garden Quarter report should be made to the
Undersigned when the house is completed.

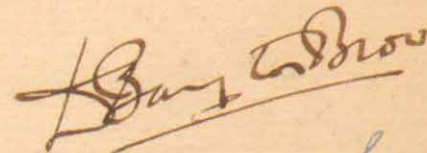

M. I. MECH. E.,

Ag. Engineer,

Karachi Municipality.

DRAWING No 46

PLAN OF PROPOSED ADDITIONAL MOTOR AND


SERVANT ROOM TO BE BUILT ON 5 No 8

SHEET I- 10 GARDEN QUARTER


SCALE 8'-1

NOTE


AREA OF PLOT 1091 53 102
ALLOWABLE AREA 273 77 77
AREA OF EXISTING BUILDING 248 59
AREA OF PROPOSED TO BE BUILT 22 92
271 44

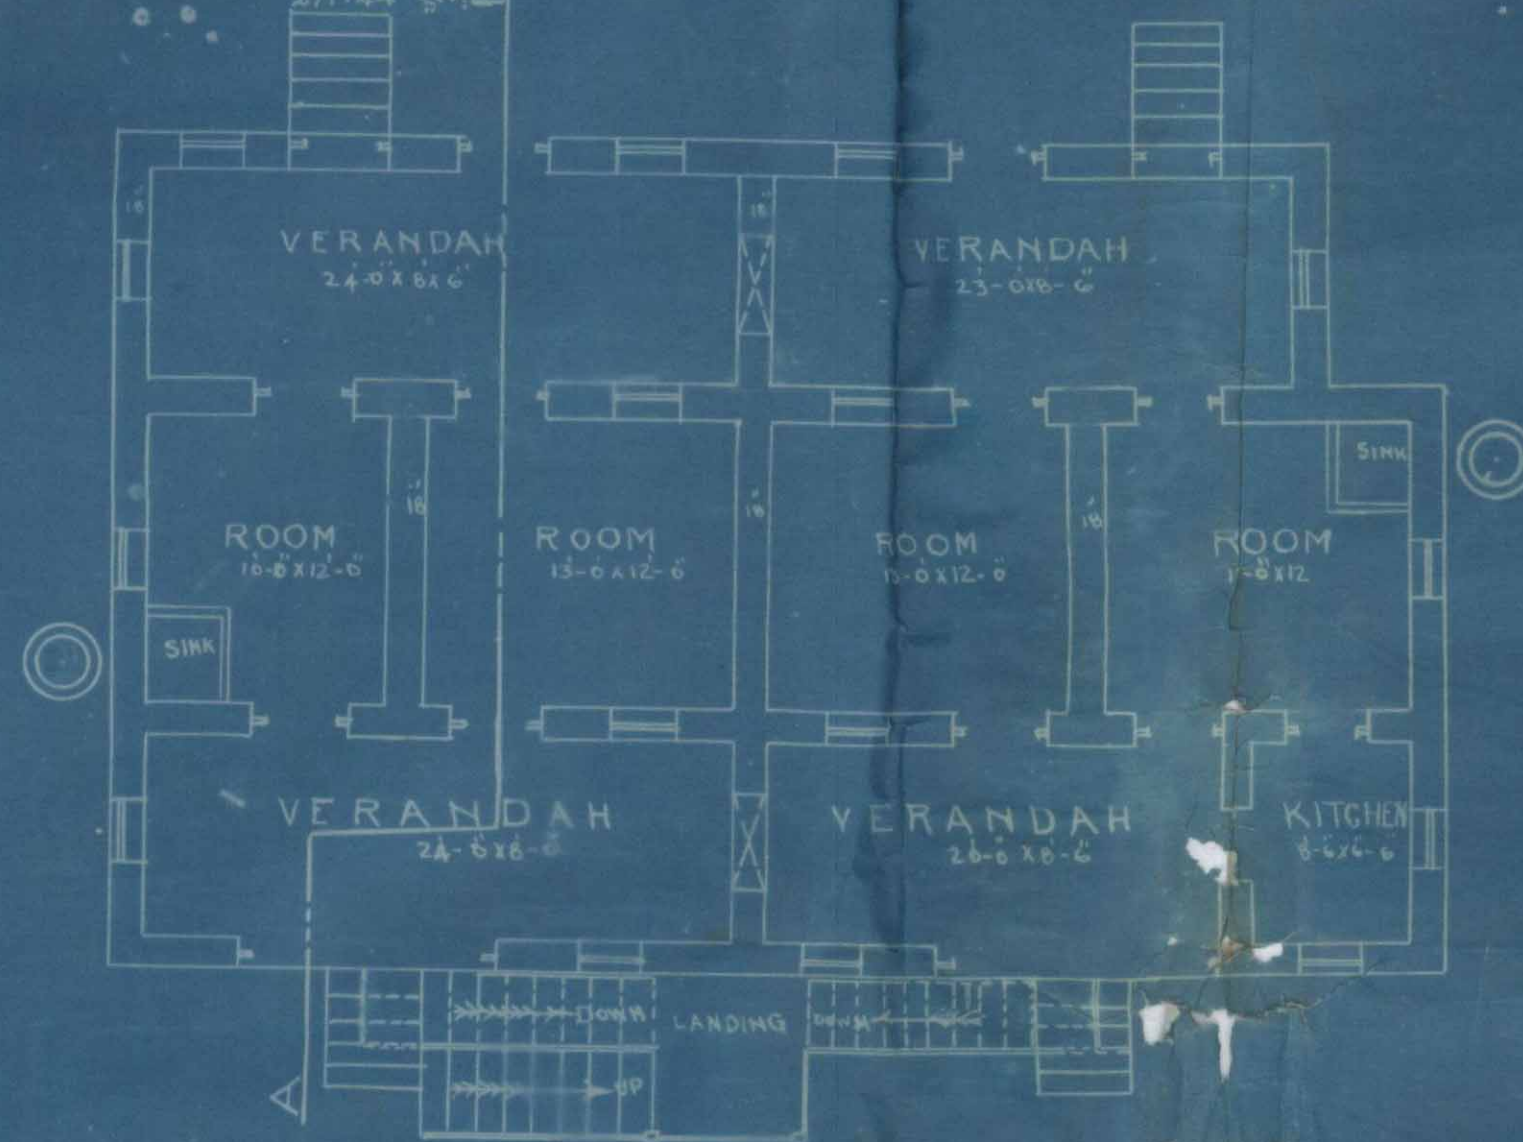

GROUND PLAN

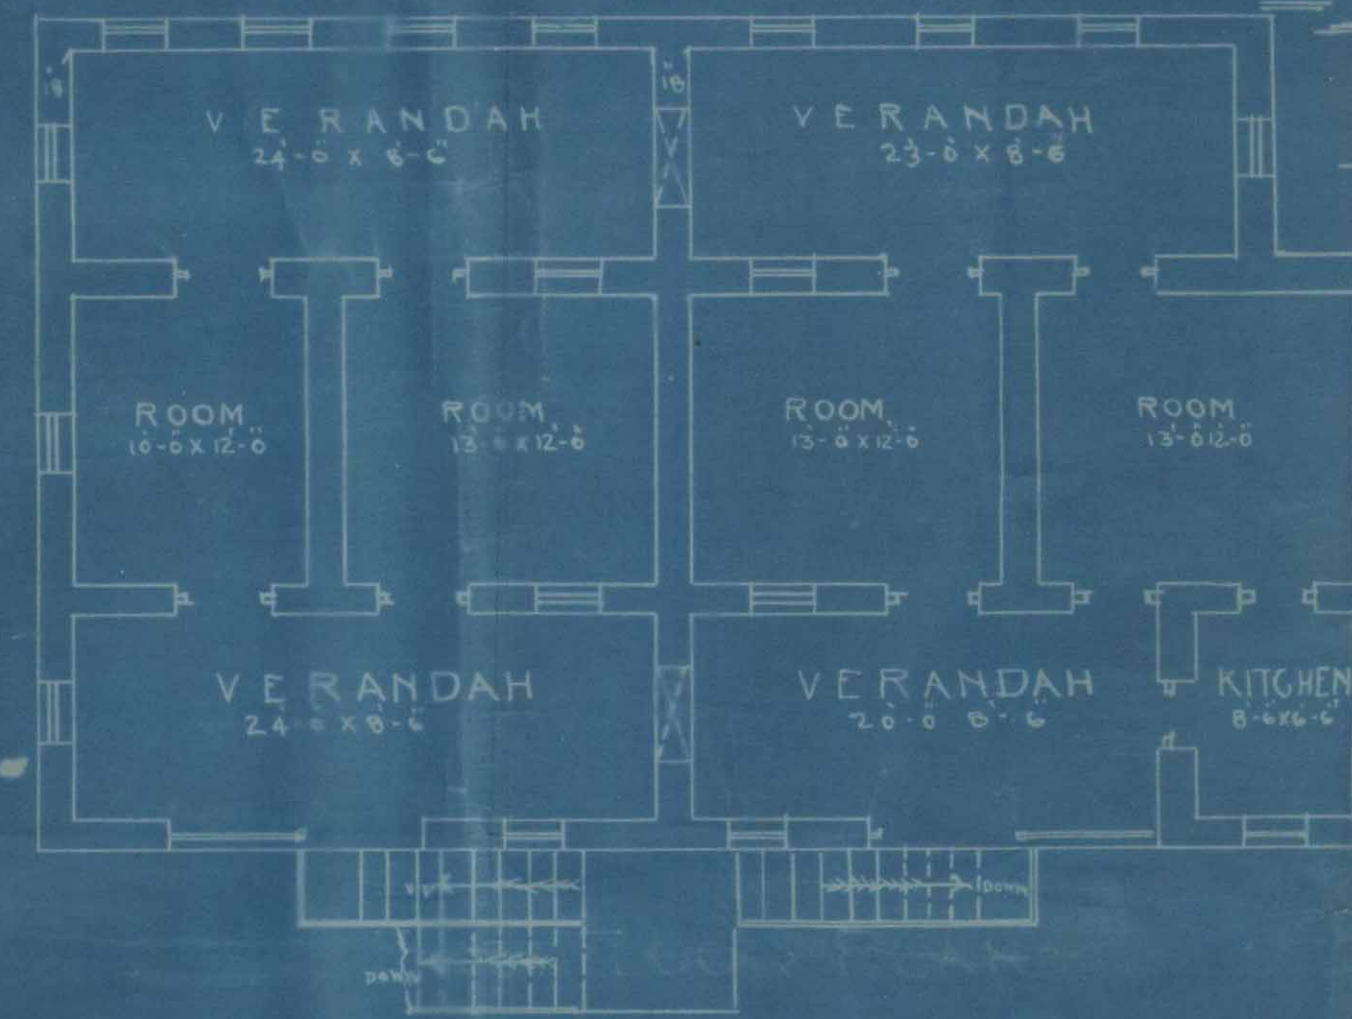


UPPER FLOOR PLAN

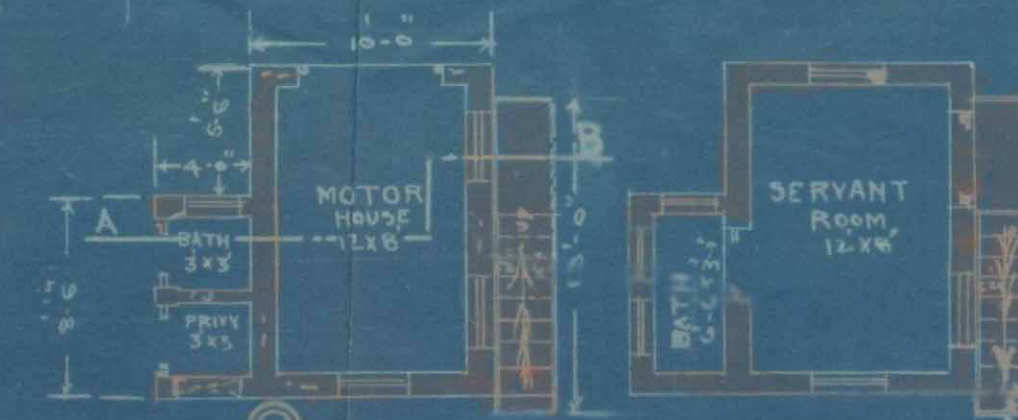

GROUND PLAN, UPPER FLOOR PLAN

BLOCK PLAN

SCALE 20'-1

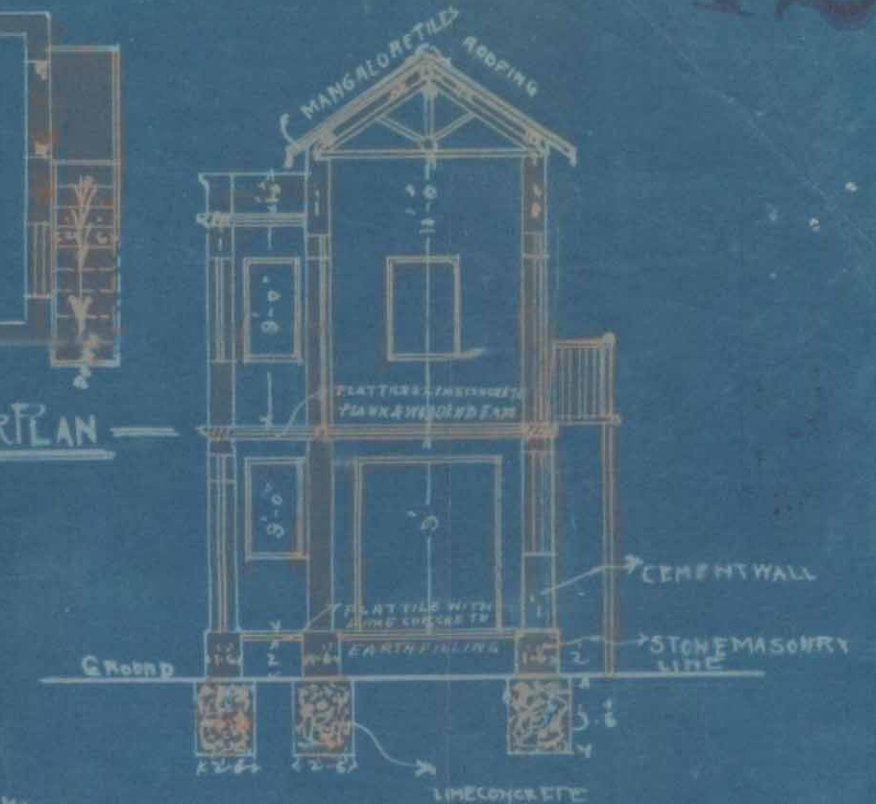

SECTION A-B



ROAD 30' WIDE

ROAD 30' WIDE



EXISTING BUILDING

8/4

APPROVE

Signature

Engineer

Karachi

1921


i.e. Saley Khima

T. A. Shivechan Khundalia

ARCHITECT & SURVEYOR



FRONT ELEVATION

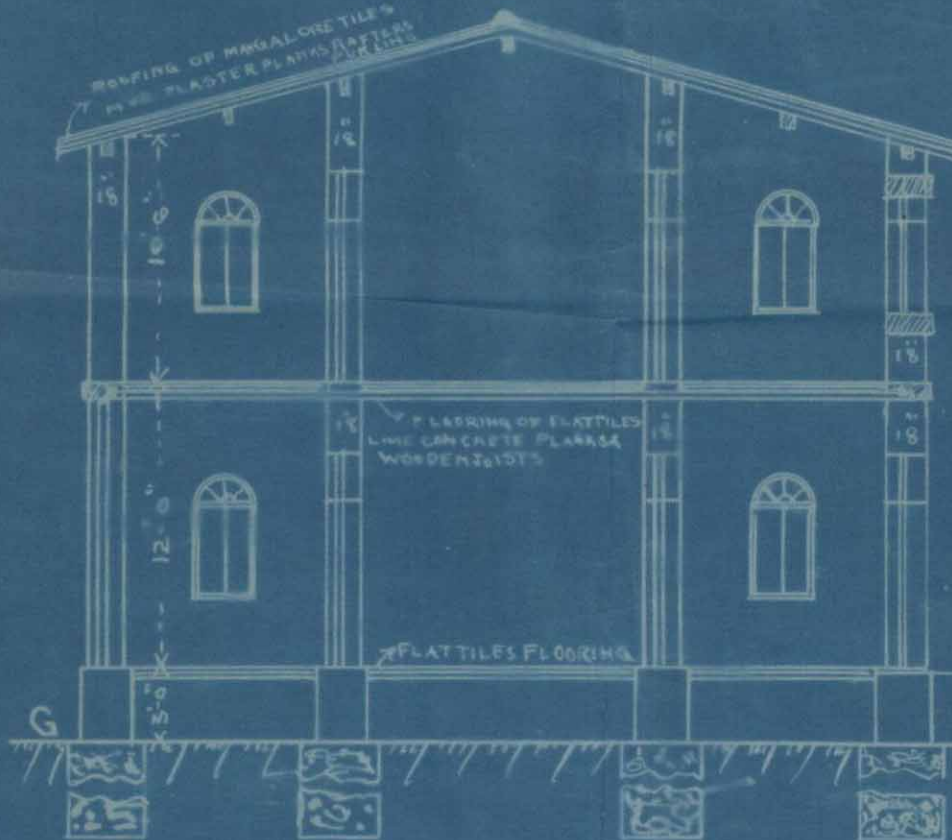

CROSS SECTION ON LINE A-B