

Building Completion Report.

MUNICIPAL OFFICE,

Karachi, 26th May 1921.
31

To


THE ENGINEER,

KARACHI MUNICIPALITY.

SIR,

I beg to report, the building work on plot No. 74-C6 Sheet
Marku Quarter owned by Mr. Joram Karsan
is completed according to the plan approved by the Municipality. Orders are
requested to file the correspondence.

Yours obediently,

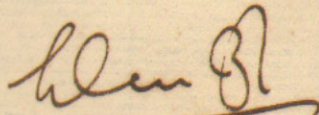
Building Surveyor " " Section,
Karachi Municipality.

copy to etc.
File.

M. C. A. M. I. C.

Karachi Municipality



NO. L. S. 53 of 1921.

Municipal Office. 2

Karachi 1st March 1921.

M E M O : -

Re: Plot No. 74-C, C-6 Market Quarter.

With reference to his application dated the 14th Ultimo: Mr. Passasing. H. Advani on behalf of Seth Jeram Kerson is informed, there is no objection to the Additions & alterations proposed in accordance with the plan submitted by him. The plans are returned herewith approved & duly signed.

M. C., A. M. I. C. E.

ENGINEER.

KARACHI MUNICIPALITY.

P.L.V.



plan
Submitted with ~~the~~ and report
Clerk W.C. on the ~~the~~ floor is
Contrary to Byelaws 289+240
& there seems no other objection
for other alterations & addition.

R.O.

19/2

Kere Bhatt

Submitted to the Engineer for
favour of order.

H. M. Khan
24/2

No objection

25/2 D

Mr. Bhatt

28/2

Memo. _____

Re. plot no 74 C. C 6 Market gr.

With ref to your app dated the 24th ¹¹/₁₁
inst. Mr. Hossain & Advani on
behalf of Sheth Jeraun Harsan is
informed, there seems no objection
to the additions & alterations ^{proposed} to be
in accordance with ^{made} as per plan submitted by him.
The plan are returned herewith
approved & duly signed

2022

M. C. A. M. I. C. E.

Engineer

Karachi Municipal Corp.

RUPCHAND BILARAM

Pleader.

B.A., LL.B.

BURNS ROAD.

Karachi, 9th February 1921.

To,

The Chief Officer & Chief Engineer
Karachi Municipality.

Dear Sir,

I & late Mr. Hirdaram were appointed Receivers and Commissioners to suggest certain alterations in the building belonging to late Seth, Jesaram Kerson on plot No. 74-C Sheet C-6 market quarter in terms of the partition decree passed in suit No. 260 of 1910 to provide for separate residence for the two widows of Jeram Kerson. We have got plans drawn up by Mr. Hassasing ~~Katti~~ *Architet* and as the alteration work is to be carried out by the two representatives of the two widows jointly by Shivji Thakurdas and Jadhawji Govindji,

I am herewith submitting an application signed by them for sanction as also the plans in ^{*Tri*} duplicate showing the proposed alterations. I shall thank you to grant the necessary sanction and communicate the same to me or to my clients.

Yours Faithfully.

Rupchand Bilaram

Pleader.

C.W.S

1528
Land drawings
for report.
16/2

B.S. B.
for Report phase.
16/2

63

800.—15-4-20.

FORM No. 1.

Karachi, 9th Feb 1921.

NOTICE UNDER SECTION 96 OF ACT III OF 1901.

To

THE CHIEF OFFICER AND CHIEF ENGINEER,

KARACHI MUNICIPALITY.

Sir,

to make some alterations in the
I beg to inform you that I intend building 74-E as per
we
plan herewith attached on plot No. 74-E
Survey Sheet No. C-6 situate in Market
Street. Quarter.

As required by the rules of the Municipality, I beg to submit herewith a
plan of the same for your approval.

I beg to remain,

Sir,

Address:—

Your most obedient Servant,

*Shirji Thakursi**Shirji Thakursi*

Signature of the applicant.

No. G. of 192 .

MUNICIPAL CHIEF OFFICER AND

CHIEF ENGINEER'S OFFICE,

Karachi, 192

Forwarded to the Municipal Engineer for favour of disposal.


M. INST. C. E.,

Chief Officer and Chief Engineer,

Karachi Municipality.

AND ALTERATIONS
PLAN OF PROPOSED ADDITIONS ON PLOT No 74C-C 6
MARKET QUARTER
Scale 8"=1


* GROUND FLOOR *

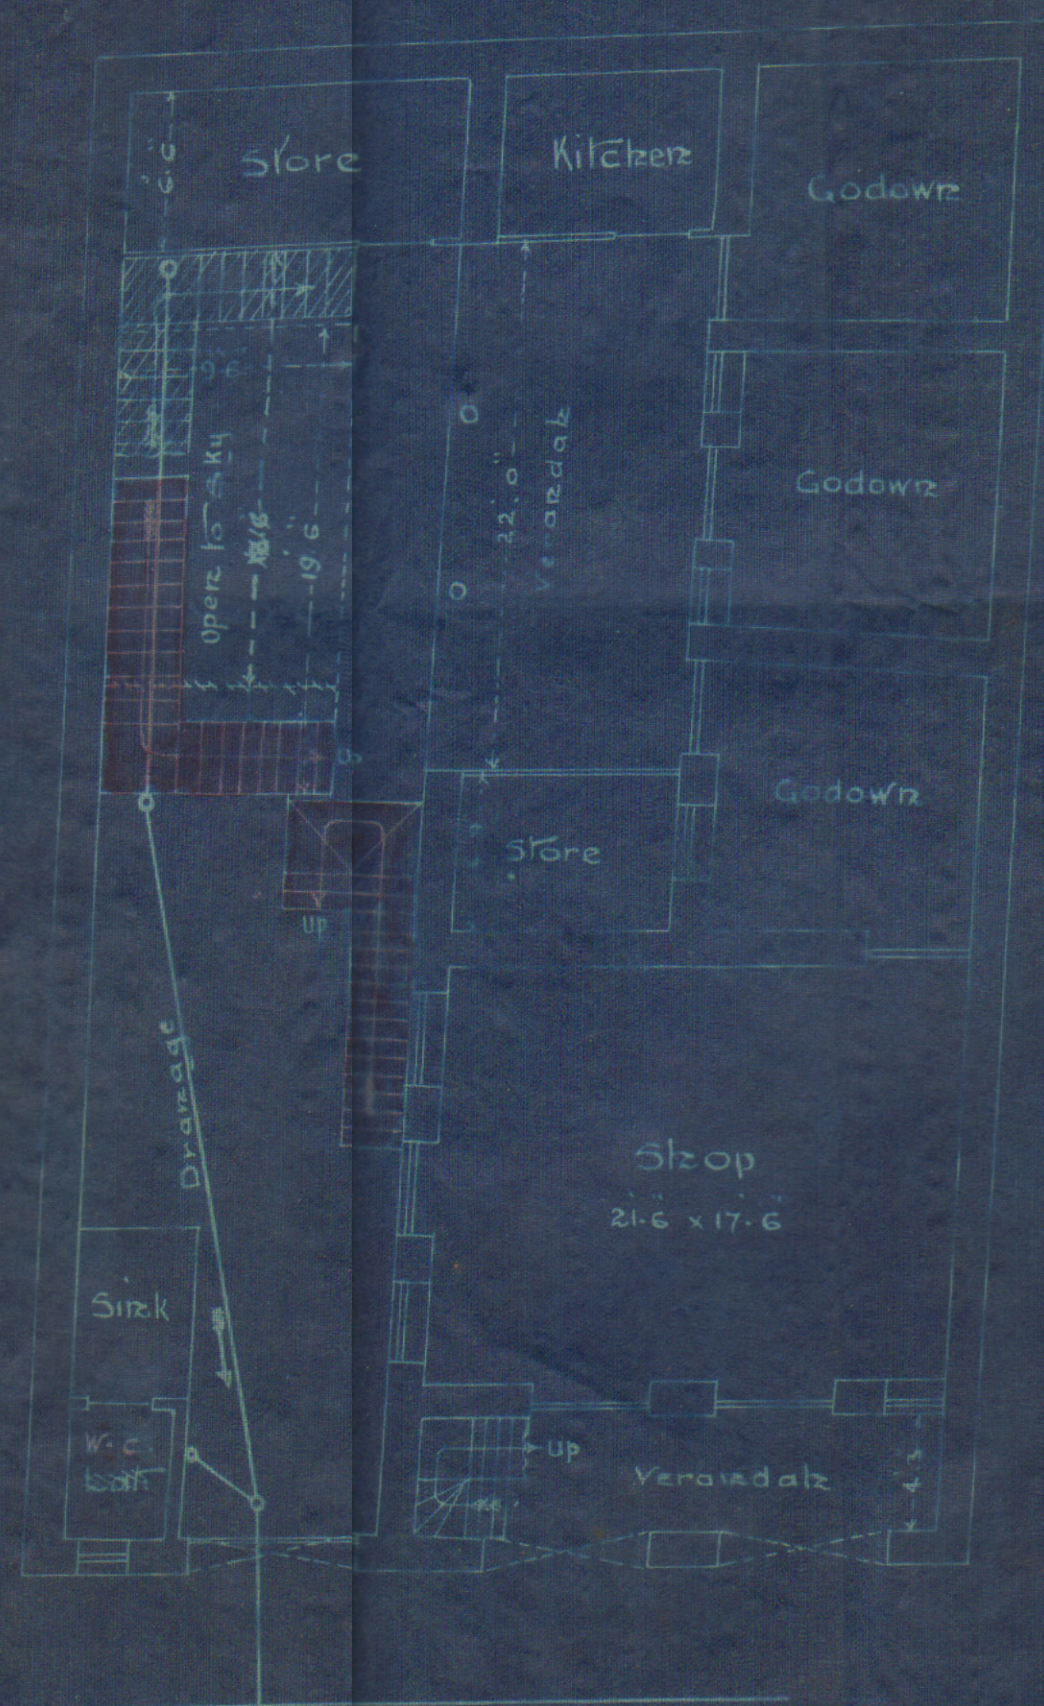

* FIRST FLOOR *



* SECOND FLOOR *

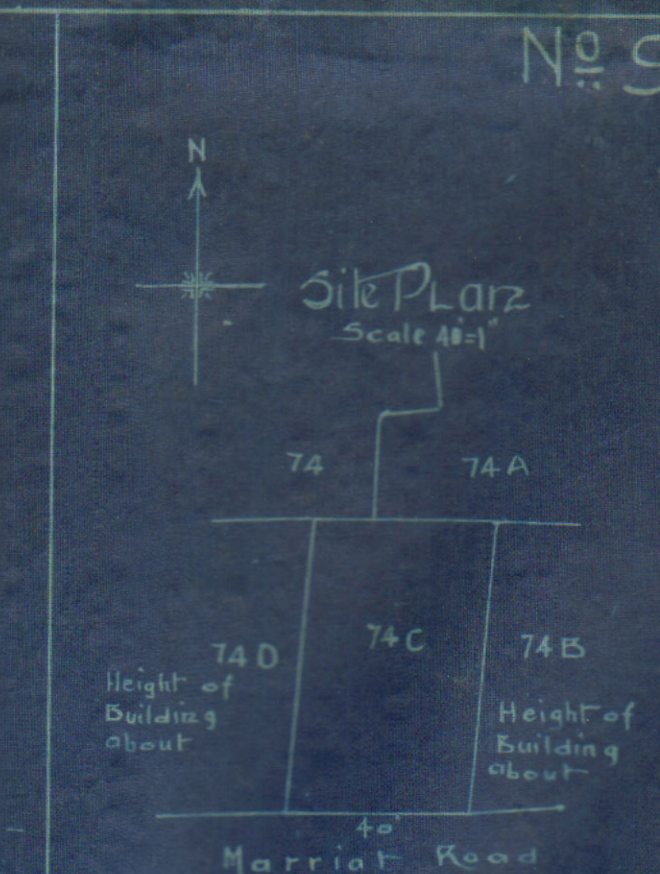

Hassan H. Adnan
Architect



The Chief Officer of Chief Engineer
Karachi Municipality

Sir,

I beg to report that the
building has been inspected
by you this morning. Request
answers.

Yours obediently
Thurman
L.S. 21/4

The C.O. + C.E.
being satisfied that
the building was not
instructing no further
action need be taken.

22/4 LD

Mr. Blunt to please
note & file.
L.S. 22/4