



LAND DEPARTMENT.

FILE No.

I

of 19 29

Plans passed but work not carried out.

Compilation No.

19

Subject _____

NOTE:—For mer Correspondence filed in

file

Compilation No.

Subsequent Correspondence filed in

file

Compilation No



Form No. 6-200-31-1-25

No. L. S. **576** OF 192

MUNICIPAL ENGINEER'S OFFICE:

Karachi **7-2** 192 **4**

MEMO:

Building Surveyor Section **B** is informed
that Mr. **Alidunia Karim** has been permitted
to **build godowns**
his house
on plot No. **455 8456 K-7** Street
Cyrene Quarter, report should be made to the
undersigned when the house is completed.

*Att. attach
inspector sketch*

*new house on
the plot is not
yet built.*

25/11

*Mr. Jatechankar (106)
P.H.
25/11*

to 6/2/29

Executive Engineer,
Karachi Municipality.

*H.D.
17/10/29*



*Sliding doors
along the shorter side of all - a*

DRAWING N^o 93

PLAN OF PROPOSED GODOWNS
ON PLOT N^o 455 & 456 SHEET N^o K.7

LYAREE QUARTER

SCALE 1" = 10'

BLOCK PLAN

SCALE 1" = 10'

ROAD ABOUT 40'

13'-1" 12'-0"

457

10'-HIGH

456

APPROVED

32'-6"

ROAD ABOUT

GODOWN
25'-6" X 10'-9"

GODOWN
25'-6" X 10'-9"

GODOWN
25'-6" X 10'-9"

GODOWN
25'-6" X 10'-9"


A.

GROUND PLAN

FRONT ELEVATION

SECTION

ARCHITECT & SURVEYOR 8/6/1925

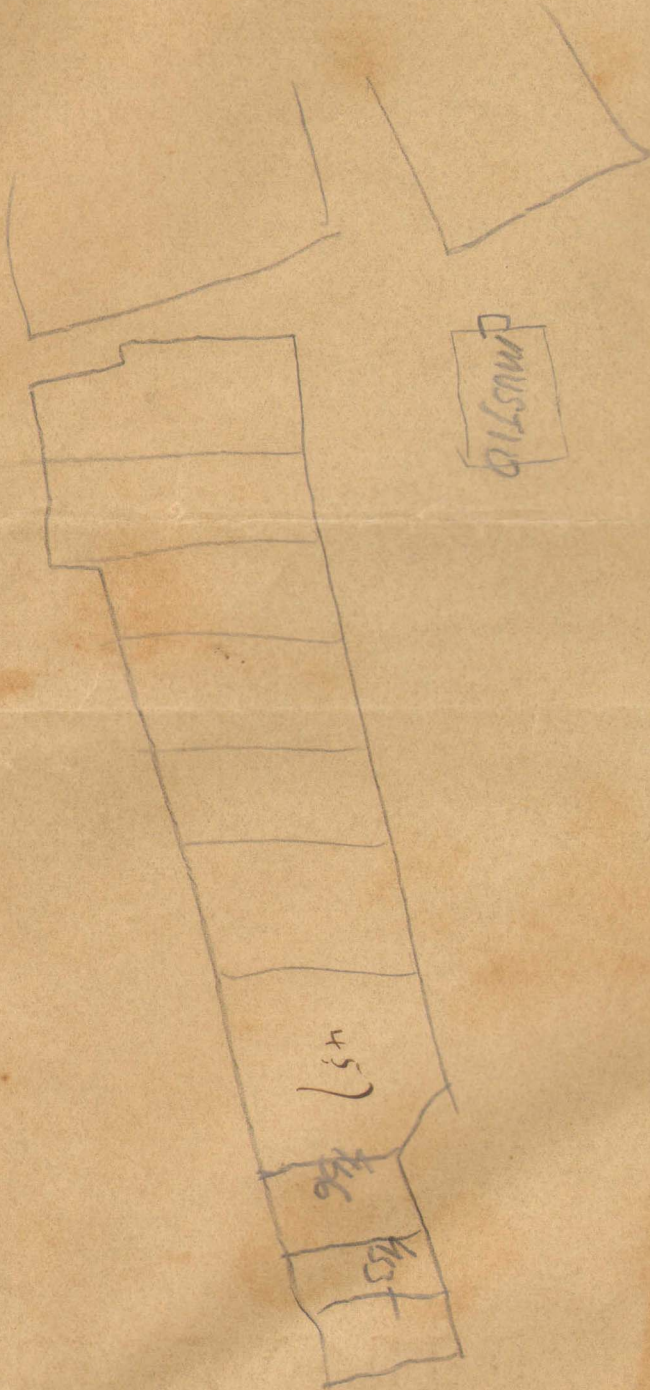

K-7
455 + 466