



Re: plot no. 60, R.S. 4

The owner proposes to erect upper floors over the ground floor, which had an excess built up area of 1.2 sq. yds. Though this was recommended to the Co. to be condoned, I find there are no orders re. the same in the file. Your orders are now requested before plans ^{finally} can be approved.
(File put up).

h
23/5

(Comp. B.F. 91934. Part 6.)
Comp. no. 16

I have cancelled the approval. Please show the site tomorrow at 8/30 am. meeting me at Empress market.

h
23/5

Submitted

The site was seen by you to-day.

h
23/5

Plans approved

h
23/5

Re-submitted with reference to the question of 1.2 sq yds excess area lest it might have escaped your attention.

wrote to Co. reporting fact. giving copy to the owner. Do not approve the plans till we hear from the Co.

h
25/5

h
27/5

C-82/25



Heritage

KMR.CDD.RaQ.1935.01

3

Plot No. 60

Sheet No. R.S.4 Narasimham Qr.

BUILDING SURVEYOR'S REPORT.

No objection

30/4

Date _____

Building Surveyor

Remarks of LAND MANAGER AND ARCHITECT

Submitted

1st floor is already
existing without the
pillars as the main R.C.
beams are adequate to
carry the load without any
pillars

1/5

Don't you think pillars

at x x are necessary

h

30/4

Not approved
23/5

Date _____

Land Manager and Architect,



Mr. Channalal.

I want the following information
re the museum.

Cost of work that remains to be done


" of extra hours

" of filling

" back stair

de

9/11/25.

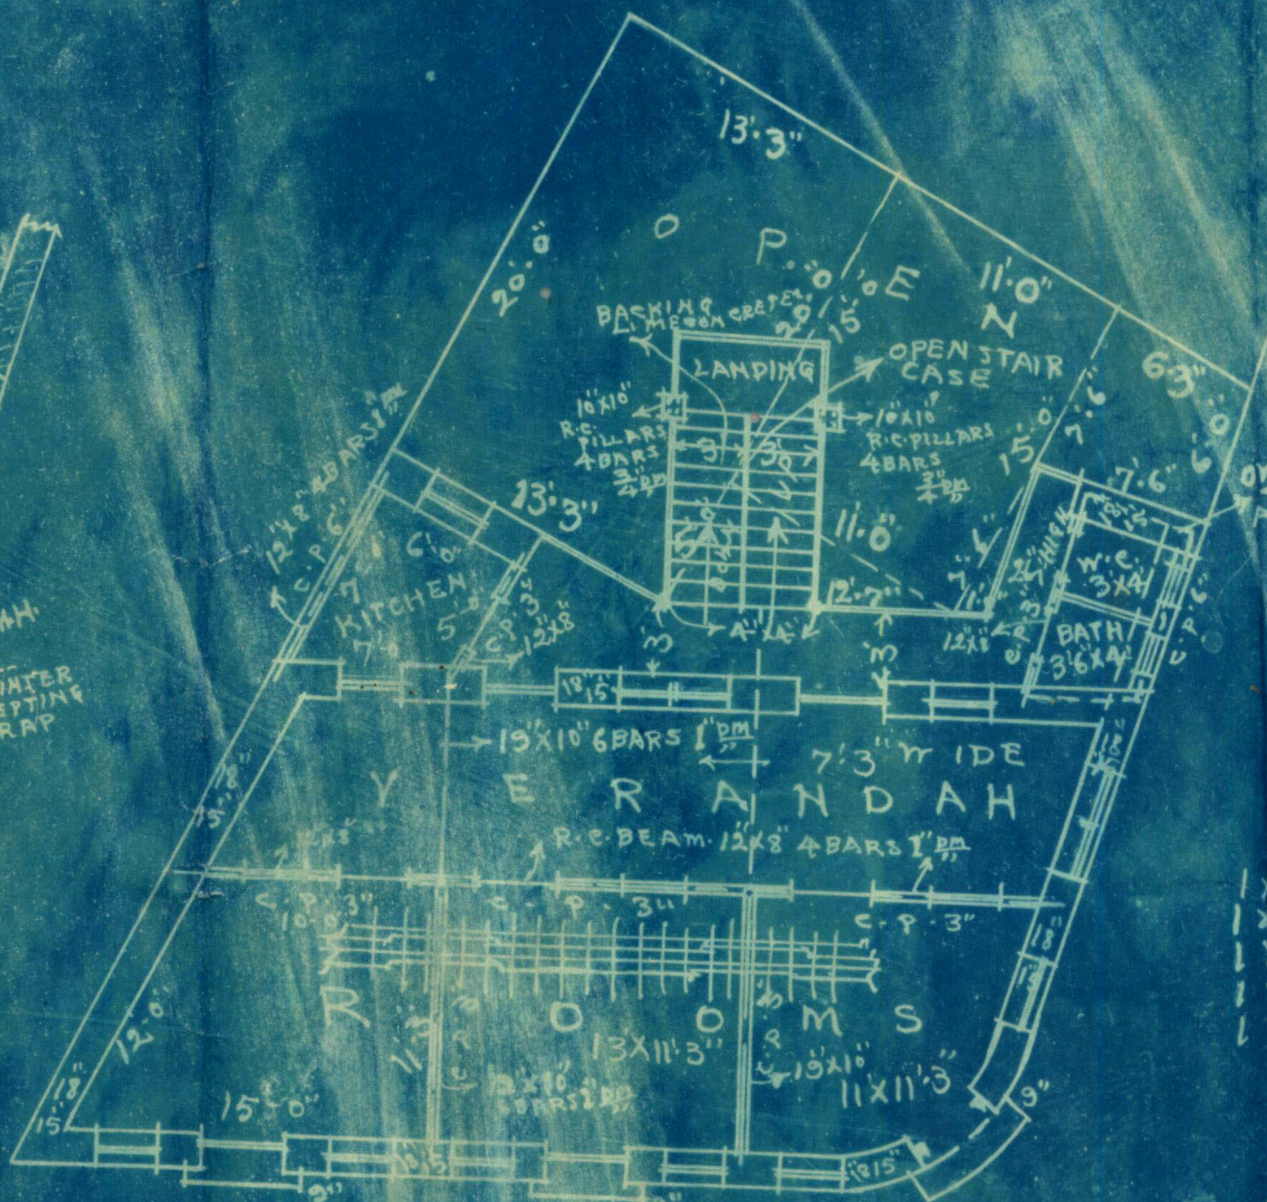

$1 \times 20.6 \times 13.3 = 265.00$
 $1 \times 15.0 \times 11.0 = 165.00$
 $1 \times 12.7 \times 2.6 = 31.45$
 $1 \times 7.6 \times 6 = 3.75$
 $1 \times 6.9 \times 6.10 = 46.37$
511.57

} 564.5 SQ. YDS
 115.9. EXCESS AREA
 CONDENSED

1ST & 2ND FLOOR PLAN

BLOCK PLAN

SCALE 20' = 1" INCH.



FRONT ELEVATION



SECTION ON A. B.



Shastri Vishwanath Harjiram Joshi
Dankeshindas
Mithilav
15.4.35