



Submitted to L. M. A
Mr. Boukoleung -

for his signature as he has seen

$\frac{117}{38 \frac{1}{2}}$

cl. issue U.A construction notice as ^{two} wooden wall
cabins have been put up on this plot un-authorisedly.

$3 \frac{8}{29}$.

notice is being
issued. by.
 $\frac{618}{618}$

BUILDING COMPLETION REPORT.

LAND MANAGER AND ARCHITECT'S OFFICE,

Karachi, 22.7 1929.

To
THE LAND MANAGER AND ARCHITECT,
KARACHI MUNICIPALITY.

SIR,

I beg to report that the building work on plot No. 2. Sheet R.B.8,
Ramraugh Quarter owned by Mrs Edulji Dinsan
has been completed according to plans approved by the Municipality. Orders
are requested to file the correspondence.

Yours obediently,

M. P. Fatilqumani

Building Surveyor "A" Section,
Karachi Municipality.

No. L. M. A/BS 4486 of 1929
Karachi, 5/8 1929.

Copy to the Assessor & Collector for information,

3/8

B. SC. A. M. Ints. C. E.
Land Manager and Architect,
Karachi Municipality.

R B. 8

BUNDER ROAD

BLUMS ROAD

ROBSON ROAD

2

1

FORM B.



Heritage
FOUNDATION

400-6/
KMR.CDD.RbQ.1929.01

4-1

[Vide Rule 238/A (3) (a)]

UNDER BY-LAW NO. 47 (1) UNDER
SECTION 48 (N)

Completion Certificate.

TO BE SUBMITTED BY LICENSED SURVEYOR
BUILDING AND DRAINAGE COMPLETION CERTIFICATE.

I do hereby certify that the following building and drainage work (insert
full particulars of the work) extension of rooms in plot
no 2 R.B. 8 Rumburgh Quarter

has been supervised by me and has been completed to my satisfaction; that
the workmanship and the materials used are good; and that no provision of the
Act or the Bye-laws and no requisition made, condition prescribed, or order
issued thereunder has been transgressed in the course of the work.

Signed

S. J. Durrant

Dated 4.7.29

Recd
on 19/7/29
S. J. Durrant
Surveyor



C
P. pt. same form of Compreh
of building types will
You pt. Pointed and

MS. 617

The building is complete
as per plan. MS 67.

June 24th

6-7-59



Heritage

KMR.CDD.RbQ.1929.01

173

B. S. 29-100-4-29.

No. L. M. A. / 3218 of 1929.

MUNICIPAL OFFICE,

Karachi, 31/5 1929

MEMO :

Building Surveyor Section 'A' is informed
that Mr. Adulji Jinhaw has been permitted
to make additions & alterations
his house
on plot No. 2, RB-8 Street
Handloph Quarter, report should be made to the
undersigned when house is completed.

G. J. Modi
Executive Engineer,

Karachi Municipality.



Form No. 6-300-28.6-27

No. L. M. A. / 88 7815 of 1929.

MUNICIPAL OFFICE,

Karachi, 15/5 1929.


MEMO:

Building Surveyor Section 'A' is informed
that Mr. Nadishah Daulti Dinslow has been permitted
to make additions & alterations to
_____ his house
on plot No. 2 RB-8 Street
'Lambagh' Quarter, report should be made to the
undersigned when house is completed.


A. J. Puri 18/5

Executive Engineer,
Karachi Municipality.

18/5

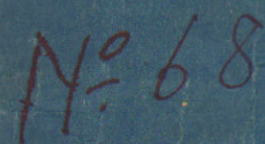

AMENDED PLAN OF
PROPOSED ADDITIONS IN BUNGALOW
ON PLOT No 2 SHEET No R.B.8.
RAMBAUGH QUARTER
SCALE 8 FT TO AN INCH

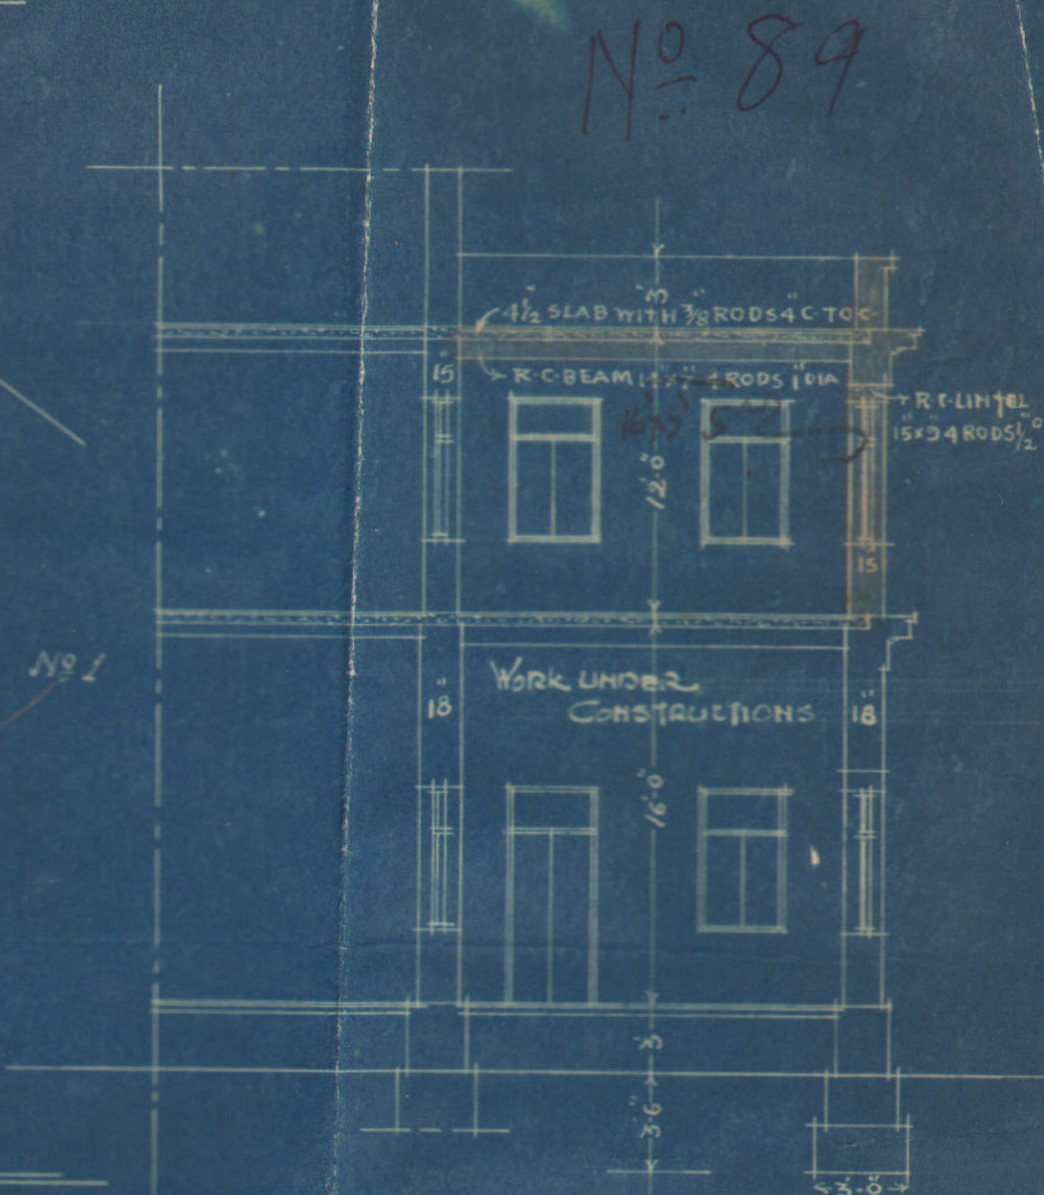


SECTION ON A-B.

APPROVED

[Signature] 9/5/29


B. Sc., A. M. Inst. C. E.
Land Manager & Architect.

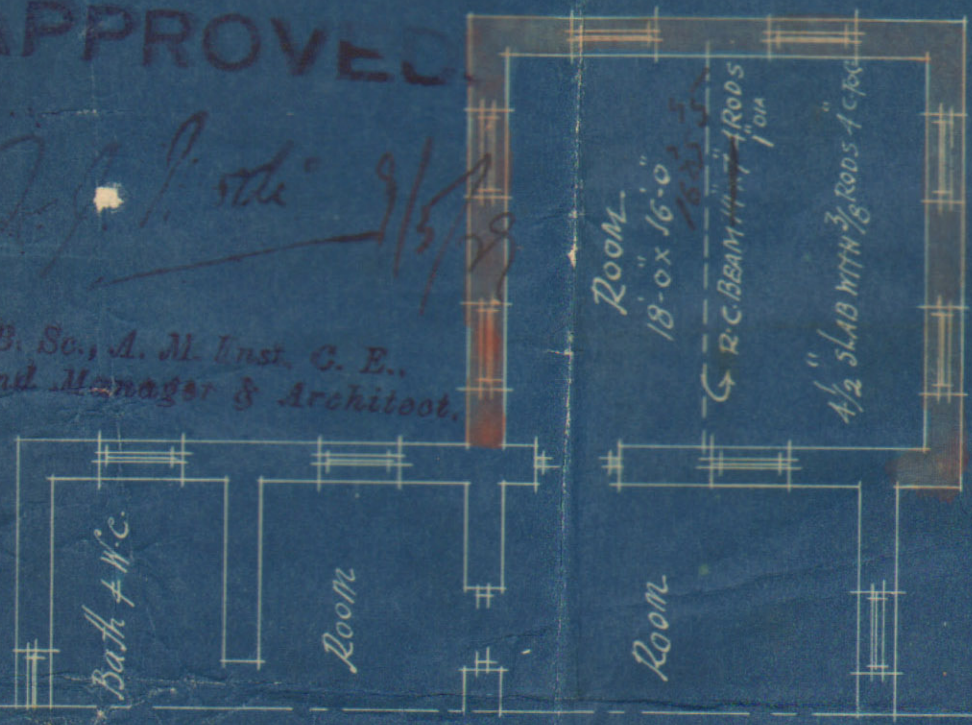

FIRST FLOOR PLAN

[Signature]

MISTRI & BHEDWAR
B.A.S. L.C.E.S.
ARCHITECTS & CIVIL ENGINEERS

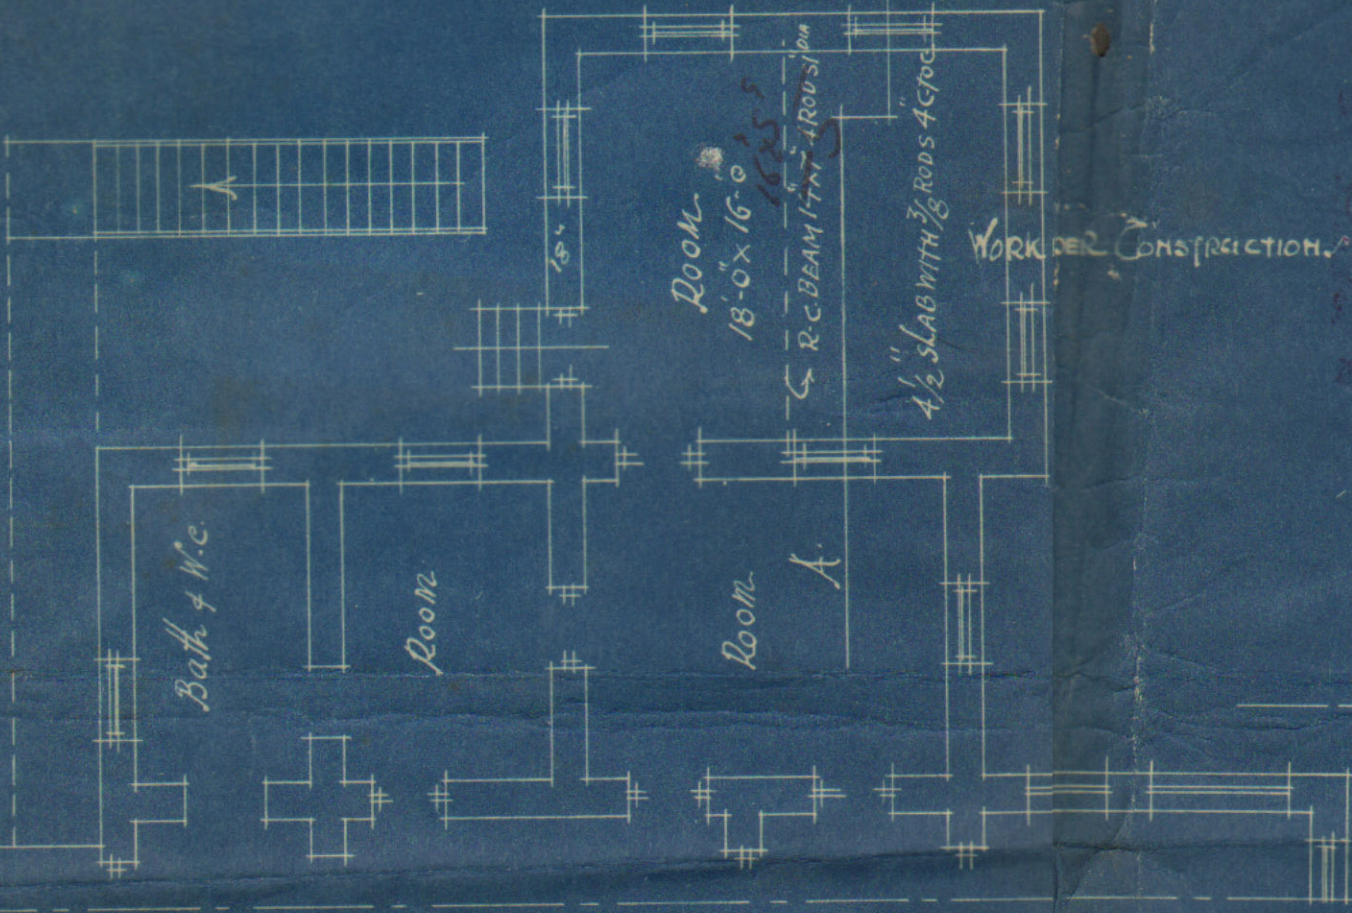

GROUND FLOOR PLAN