



LAND DEPARTMENT.

FILE No.

of 192

Not built

Compilation No.

Subject

NOTE:—Former Correspondence filed in

file

Compilation No.

Subsequent Correspondence filed in

file

Compilation No.



Heritage

KMR.CDD.GaQ.1926.01

Form No. 6—500—1-4-26.

No L. M. A. 7157 of 192 6

MUNICIPAL OFFICE,
Karachi, 16/7/1926

MEMO:

Building Surveyor Section B is informed
that Mr. Pragji Daji has been permitted
to build 2nd floor
on his house
on plot No. IV Street
E 11 Garden Quarter, report should be made to the
undersigned when house is completed.

N.A. build
P.T. - 8

25/1

Executive Engineer,
Karachi Municipality.

sh
9/7

Be
10/7

24

L-R-8
23

NICHOLAS ST.

1-V


23

LAWRENCE ROAD

PLAN SHOWING PROPOSED 2ND FLOOR

PLOT №1V E 11 GARDEN Q^E₁₁


-SCALE 8-1 INCH-

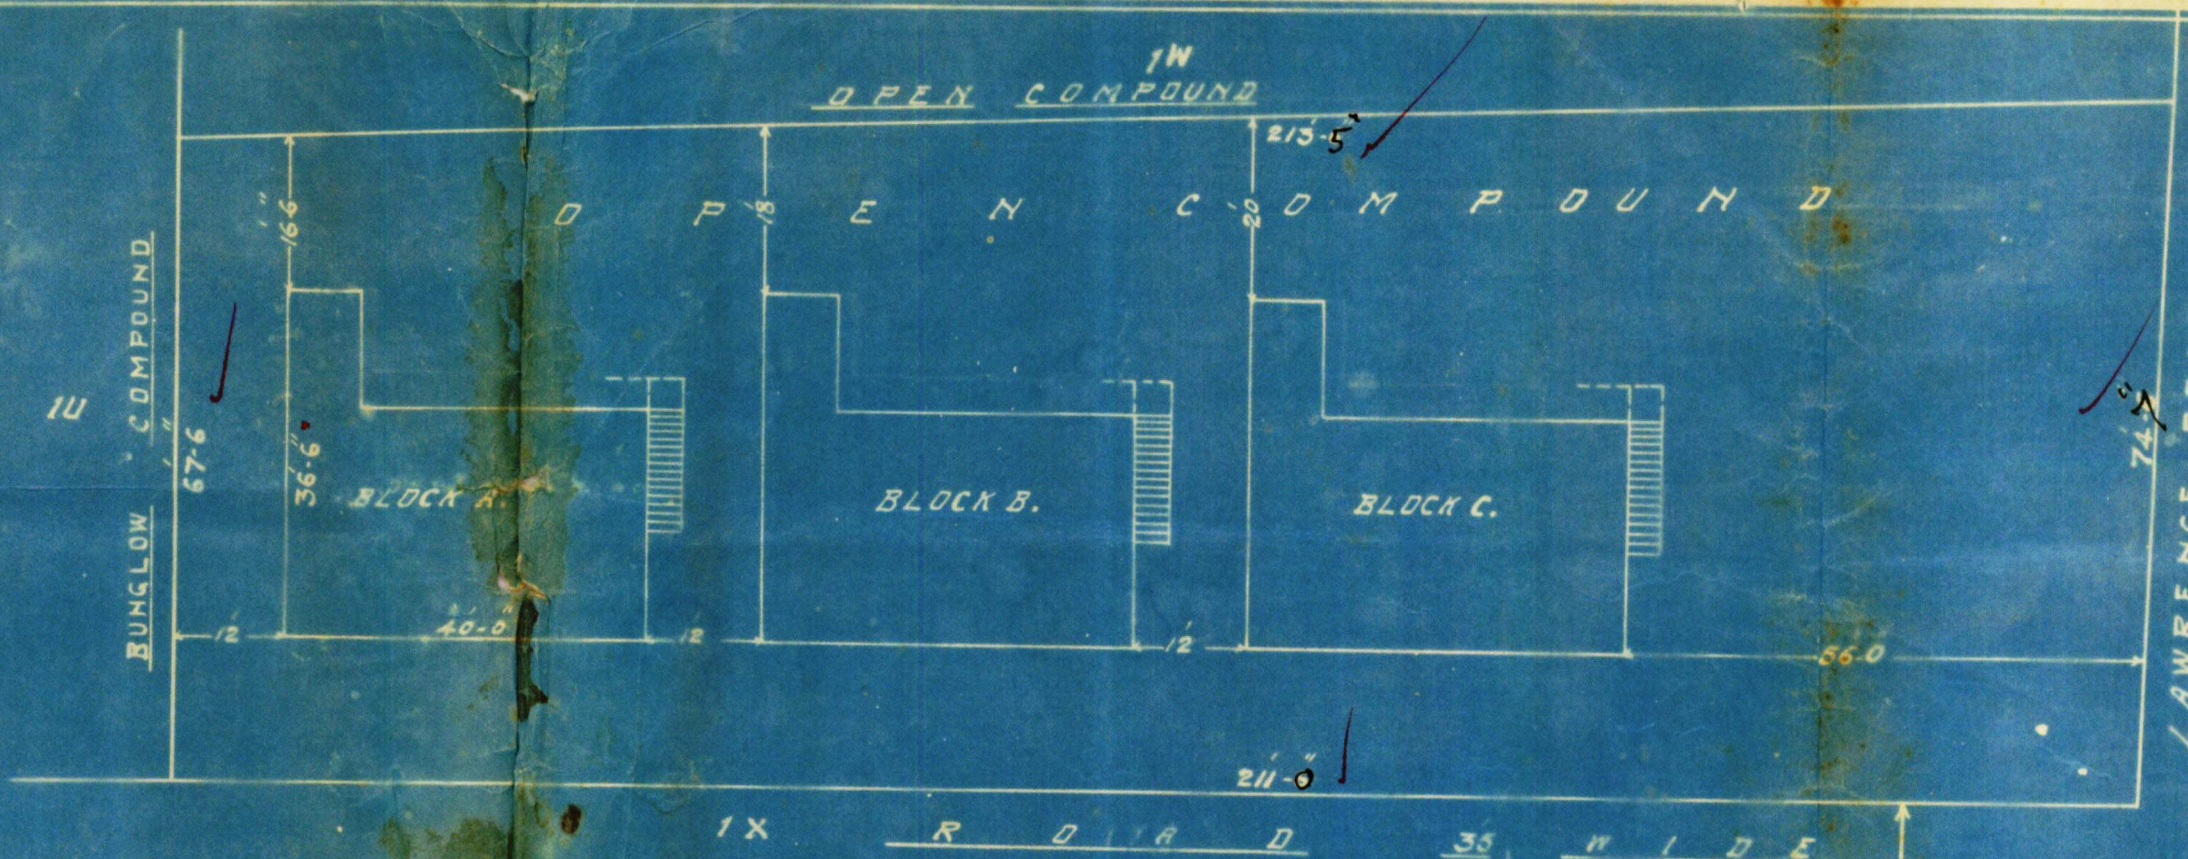


LAWRENCE ROAD



ELEVATION

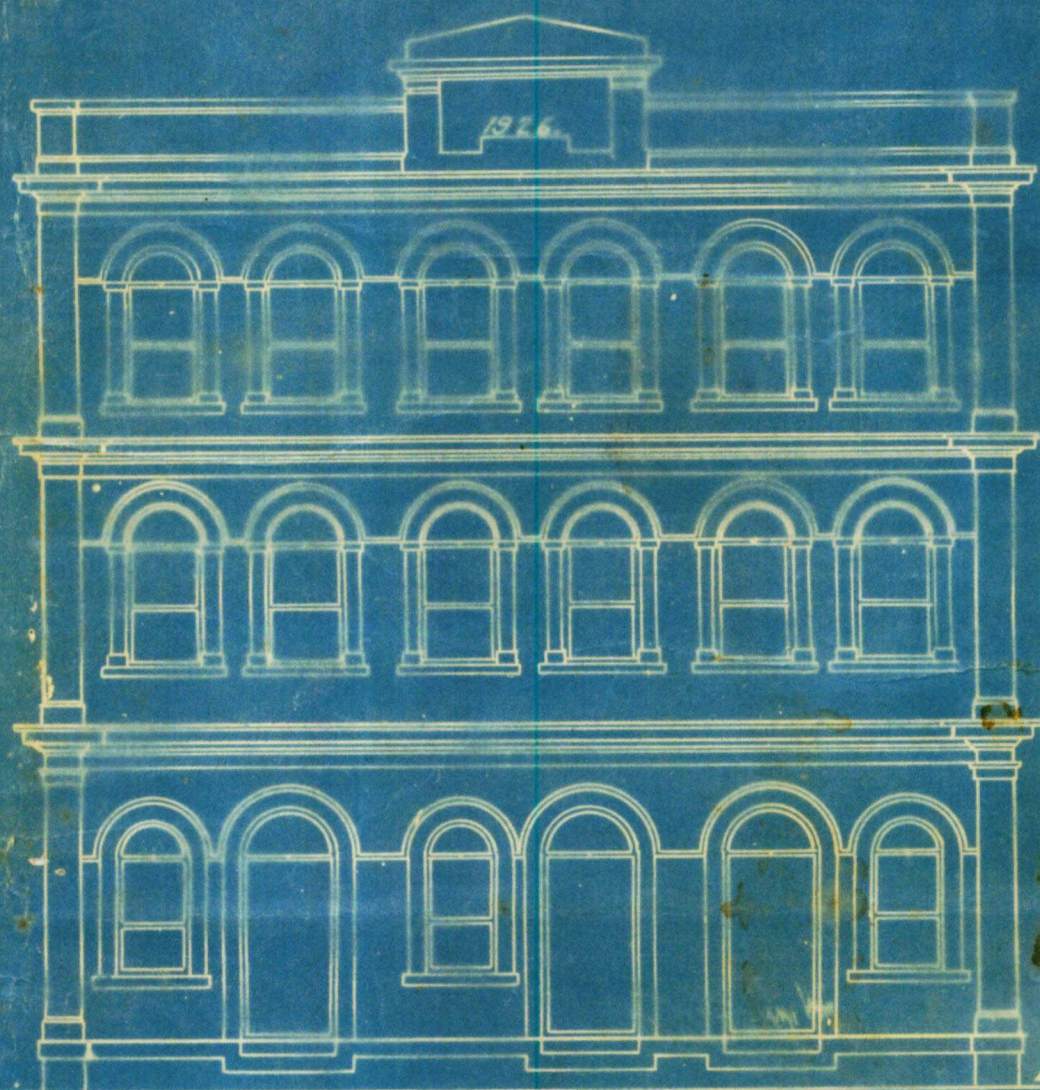

SECTION ON A B. =

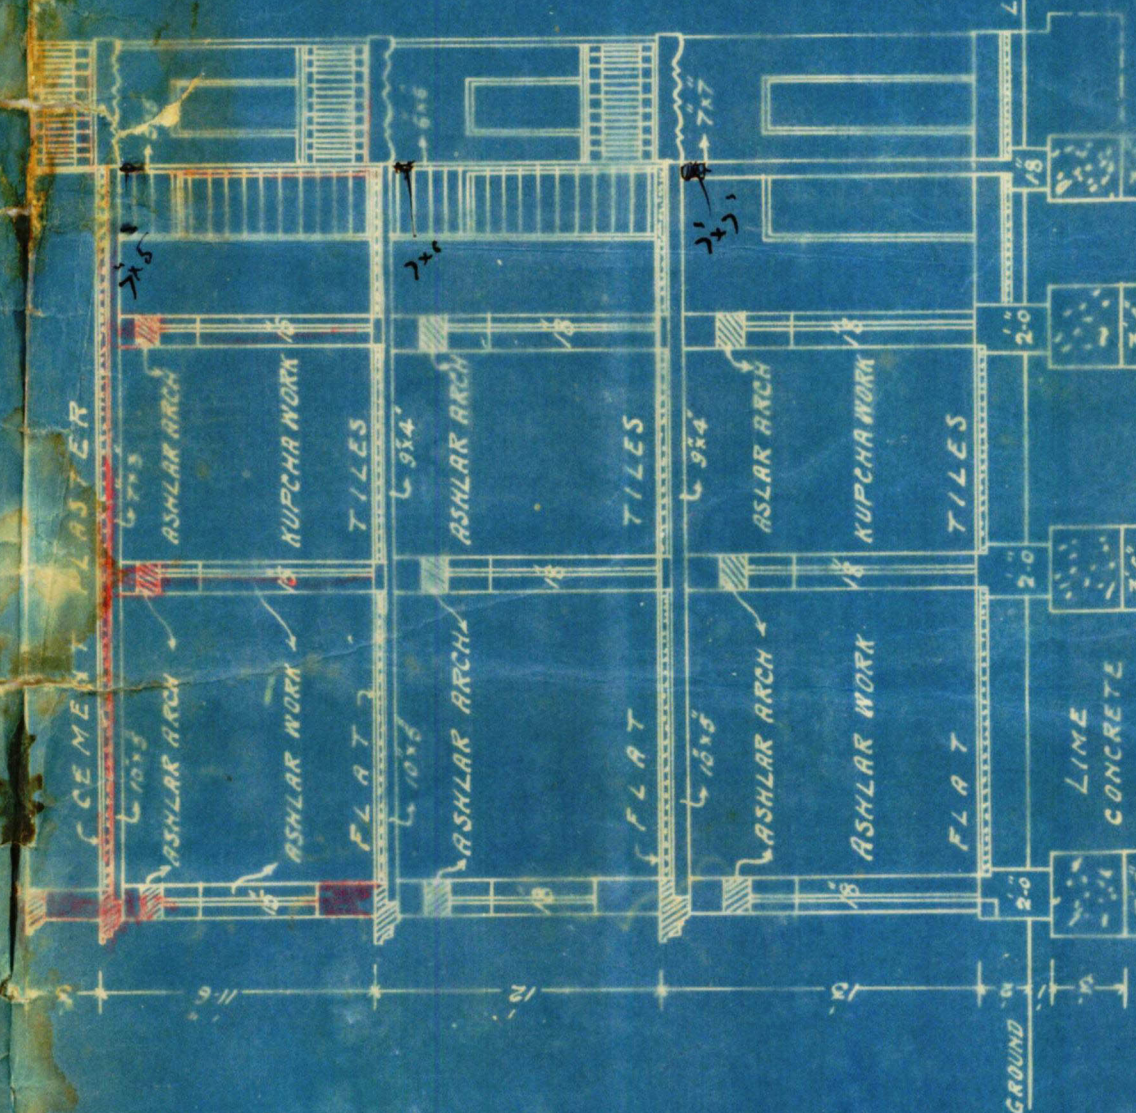

BLOCK PLAN

SCALE 20-1

NOTE
AREA OF PLOT = 1676-S.Y.
BUILDING AREA
BLOCK NO. A.B.C. = 430-S.Y.

Истор. 349


OWNER

No 87



APPROVED

Executive Engineer,
Karachi Municipality

-GROUND PLAN-

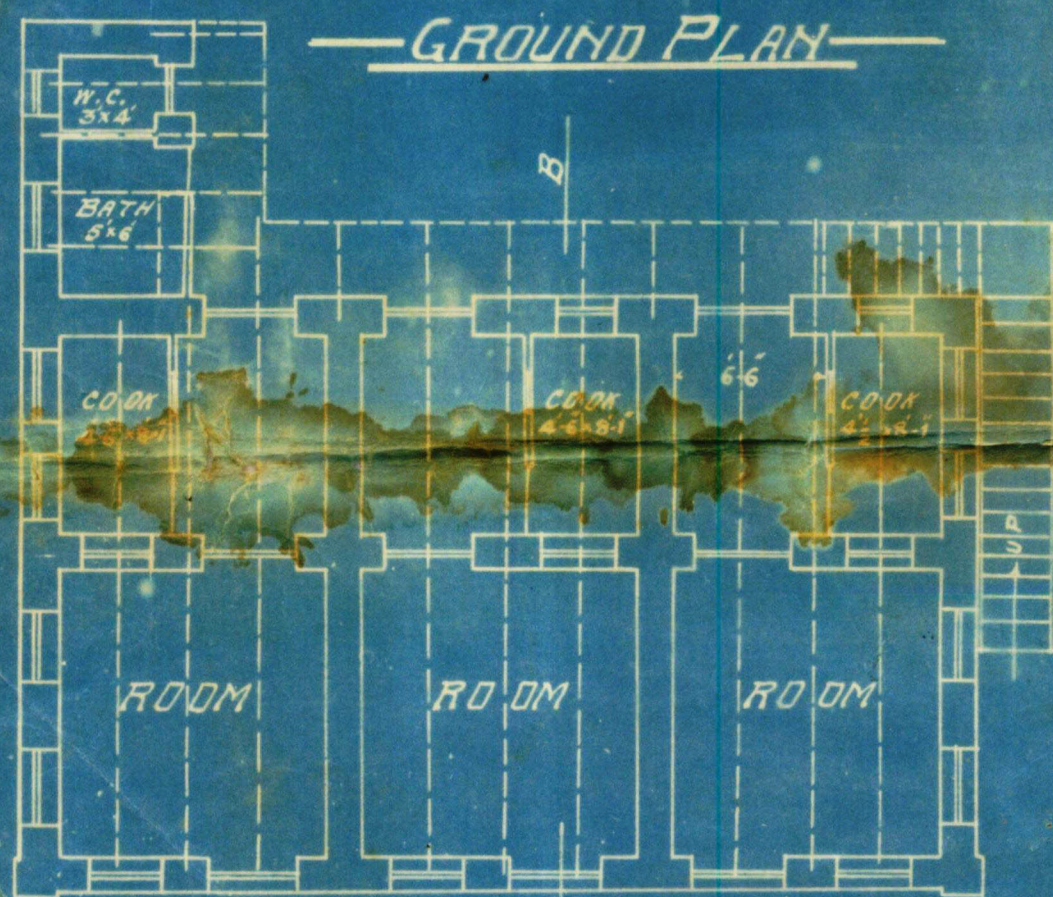

-1ST FLOOR PLAN

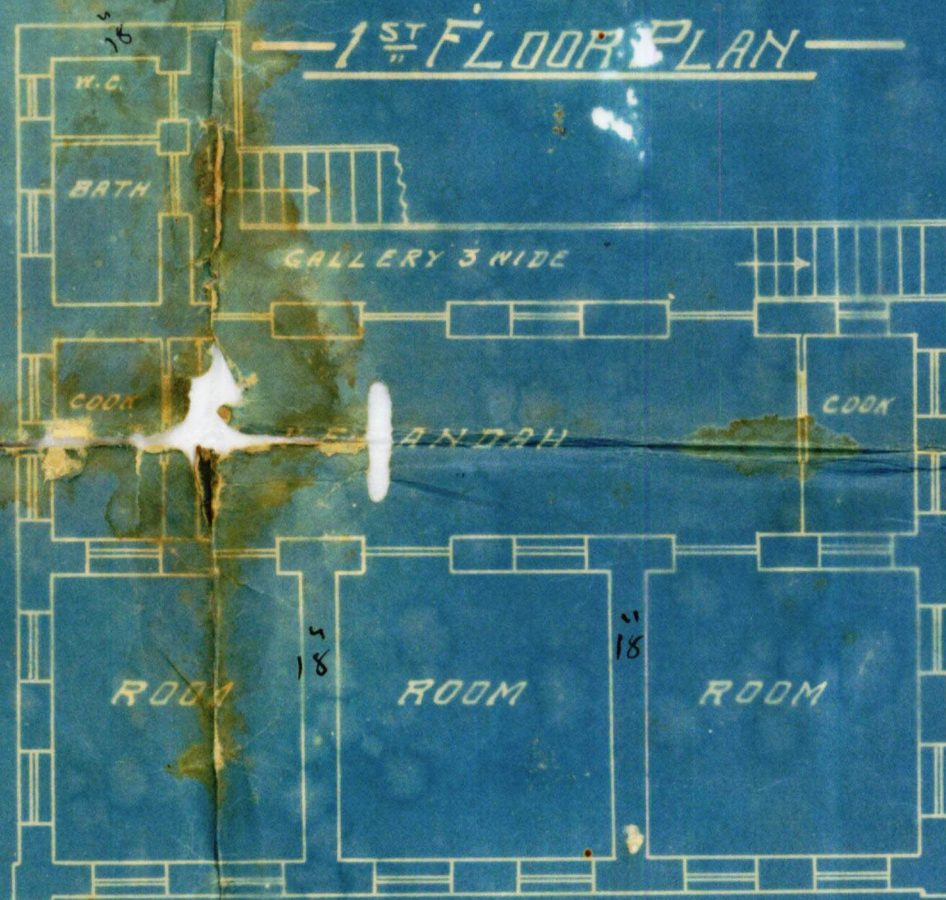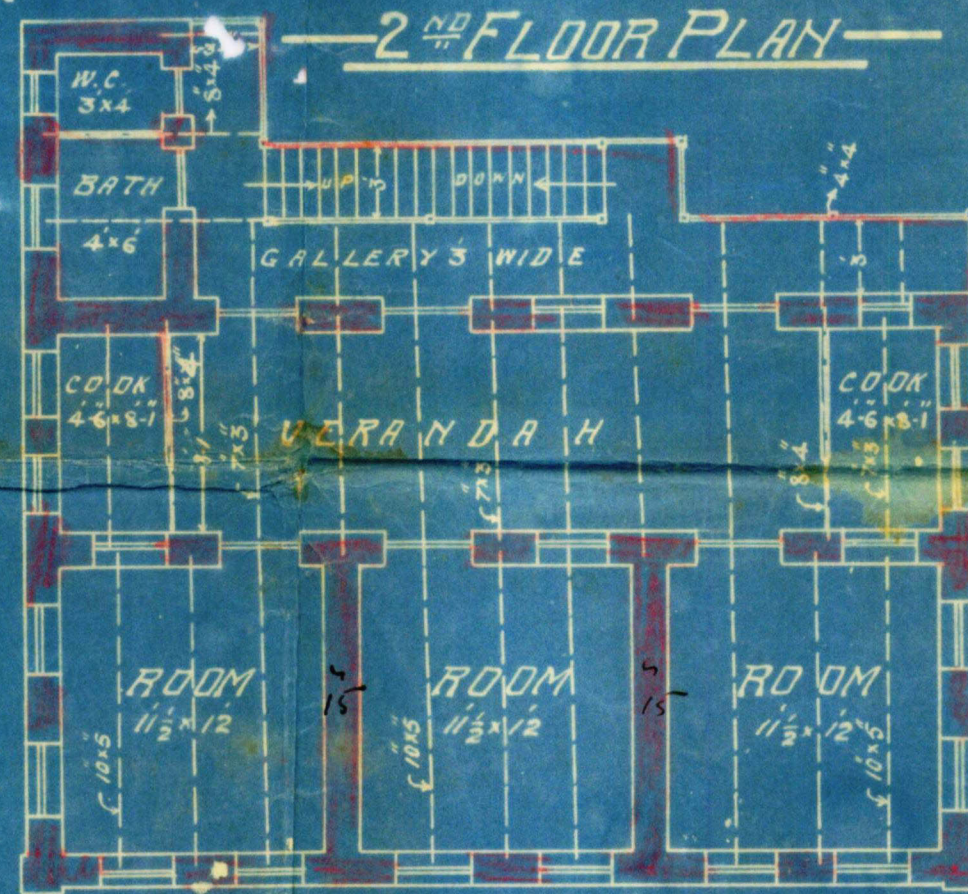-2ND FLOOR PLAN

A. H. Agler

—ARCHITECT & SURVEYOR

KMR.CDD-GaQ.1926.01

3-1 → Front Side
3-2 → Back Side.



KMR.CDD.GaQ.1926.01

SANCTIONED.
Qureshi
CITY DEPUTY COLLECTOR.
1/5/26
KARACHI.