

Building Completion Report.

MUNICIPAL OFFICE,

Karachi, 7th April 1921.

To

THE ENGINEER,

KARACHI MUNICIPALITY.

SIR,

M. L. S. 595
I beg to report, the building work on plot No. 21A Sheet 74
Ramkauri Quarter owned by Mr. Sahyian Moolchand
is completed according to the plan approved by the Municipality. Orders are
requested to file the correspondence.

Yours obediently,

M. L. S.

Building Surveyor "A" Section,
Karachi Municipality.

*Copy forwarded to the M.C.
for information.*

M. C. A. M. L. C. E.

Engineer,

Karachi Municipality

No. L. S. 8732 of 1921

Municipal Office

Karachi 17th. February 1921

Memo.

With reference to his letter dated 12th. Instant
Mr. Sahijram Moolchand owner of plot No. 21 A F 14 Rambaugh
quarter is informed, there is no objection to the amended plan
One copy of the plan is returned ~~with~~ herewith duly approved.



M. C., A. M. I. C. E.,

Engineer,

Karachi Municipality.



Memo.

n/2

With ref. to his letter dated 12th ult. Mr. Sahyram Moolchand owner of Plot No 21A 1st Rawbough Dr is informed. There is no objection to the amended plan. One copy of the plan is returned herewith duly approved.

M. C., A. M. I. C. E.,

Engineer,

Karachi Municipality

Type
n/2

21A JH Rambough D

Submitted with report the
is no objection

16/2

JH Rambough

88

Submitted to the Exr -

There appears to be no objection
the plan is submitted -


JH Rambough

16/2

No objection

17/2 D

5

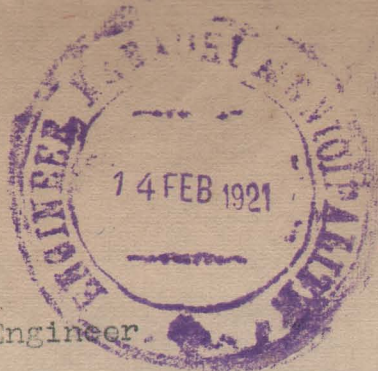

K A R A C H I

12. 2. 21

To
The Engineer.

Karachi Municipality

Sir,

I have the honour to submit herewith amended plan in duplicate for third floor on plot No: 21/A sheet F 14 Rambaugh Quarter showing a small prayer room for favour of approval.

I have the honour to be

Sir

Your most obedient servant



1550
Landamwaya
for ref. 2.
14/2

Mr. Vossai
for ref. 2.
14/2


AMENDED PLAN

OF THIRD FLOOR OF BUILDING ON PLOT NO 21A


SHEET F 14 RAMBAUGH QUARTER

SCALE 8' = 1"

THIRD FLOOR

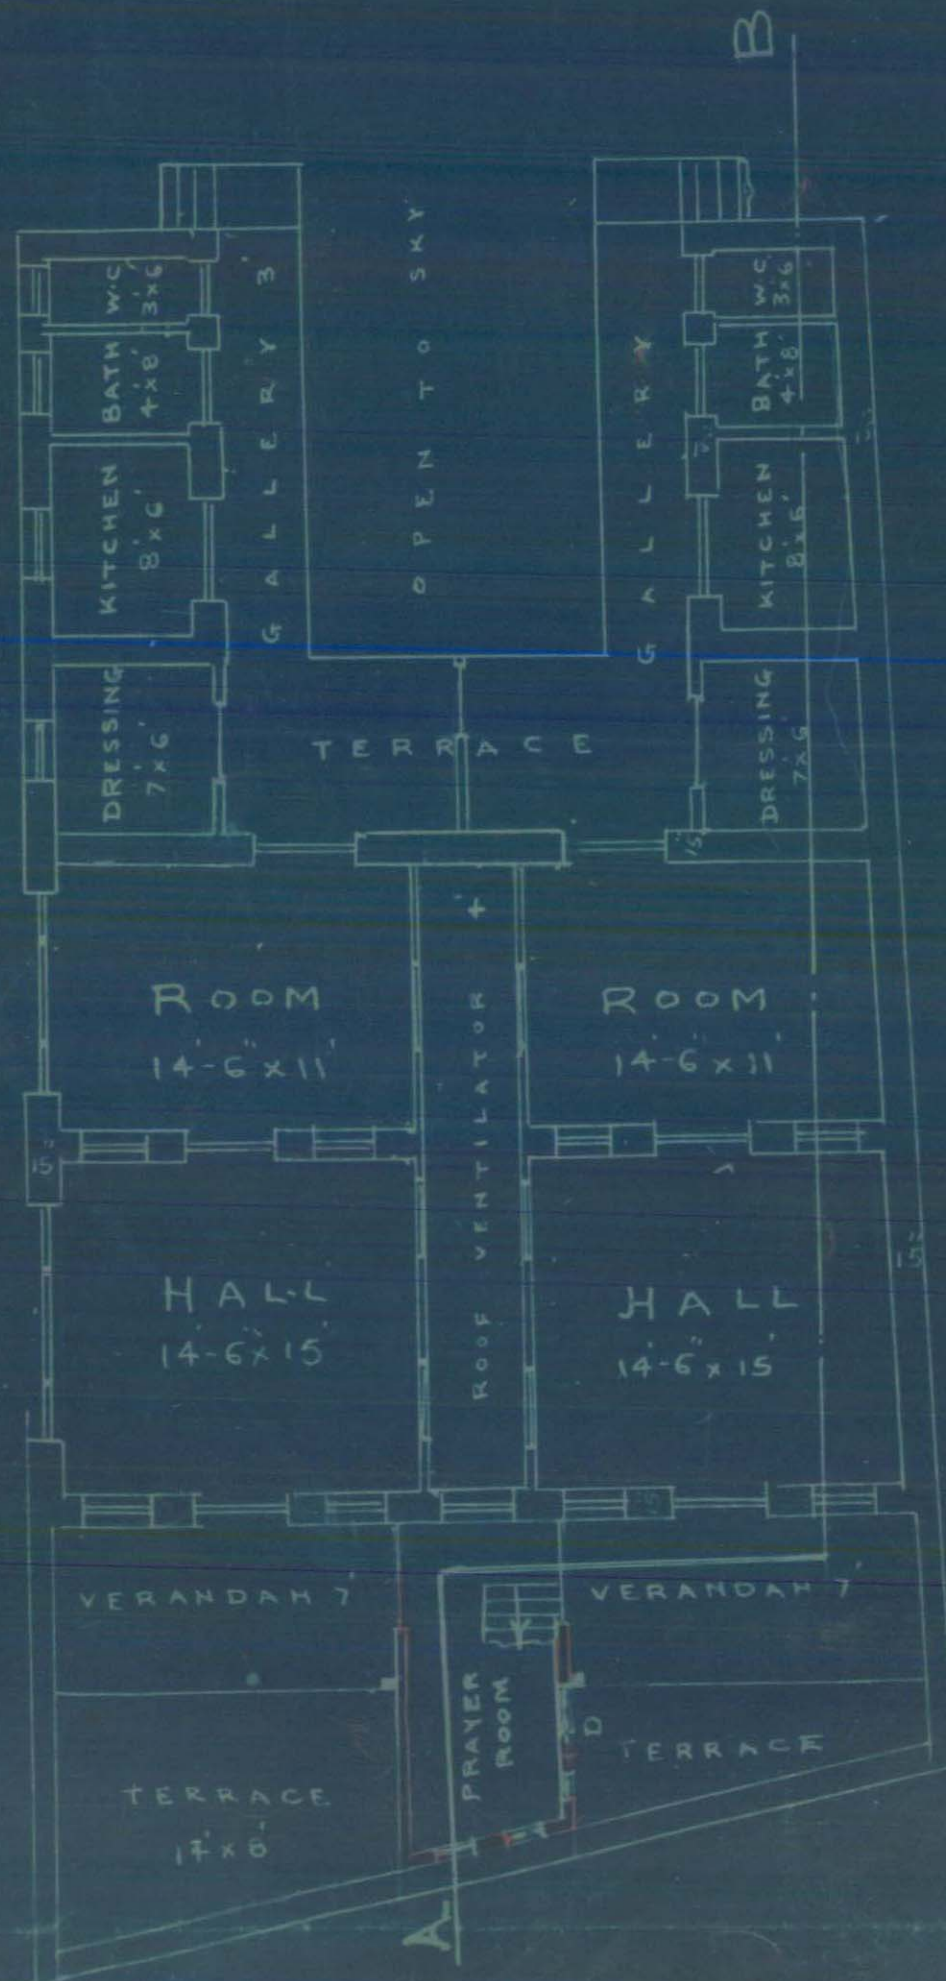

SECTION ON A.B

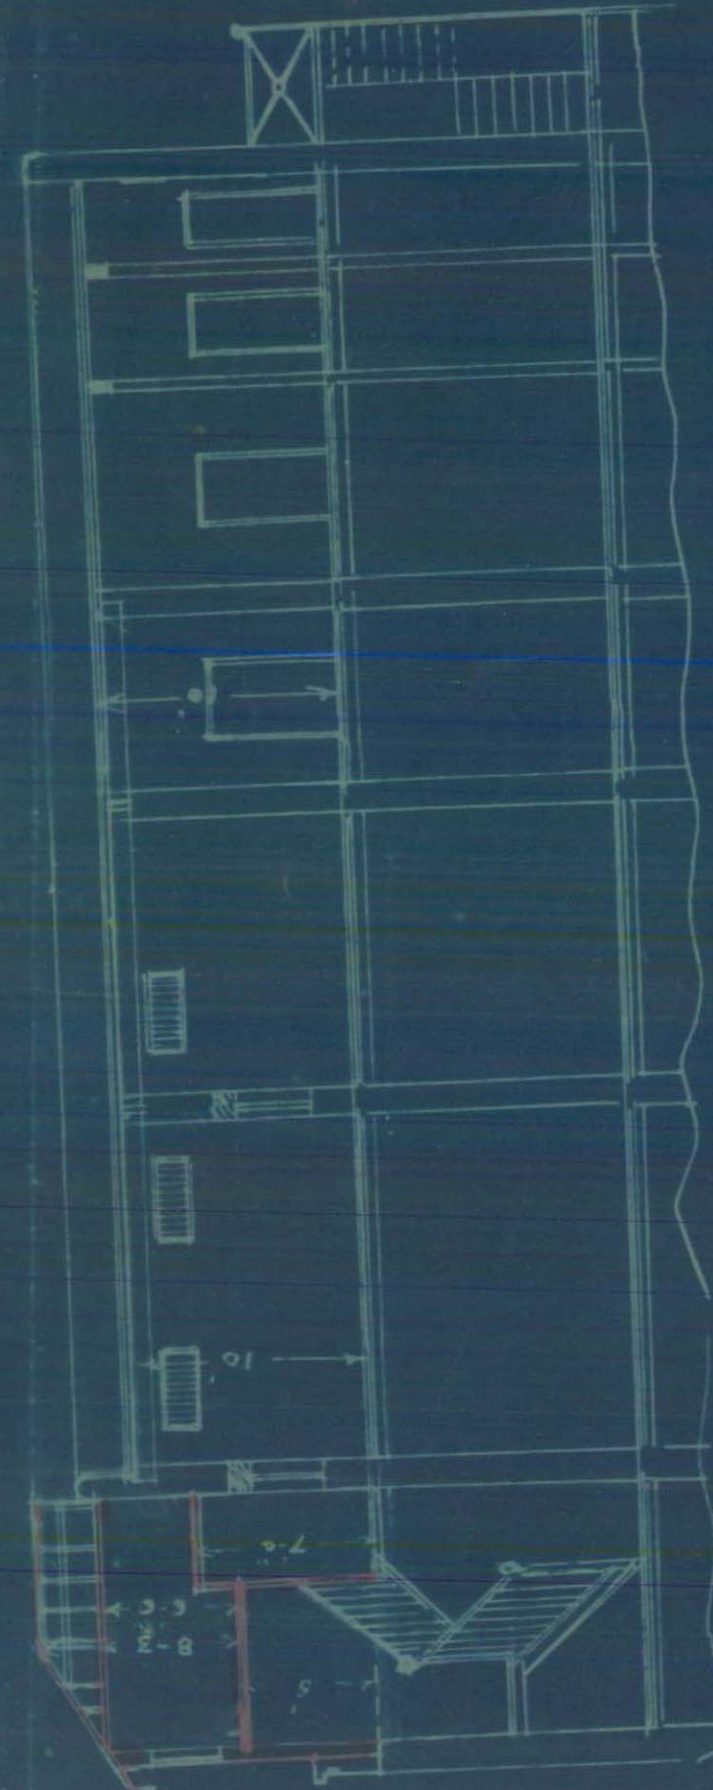

SITE PLAN


SCALE 80' FT = 1 INCH



ARCHITECT

AMENDED
OF THIRD FLOOR OF B
SHEET F 14 SAME
SCALE 8


THIRD FLOOR

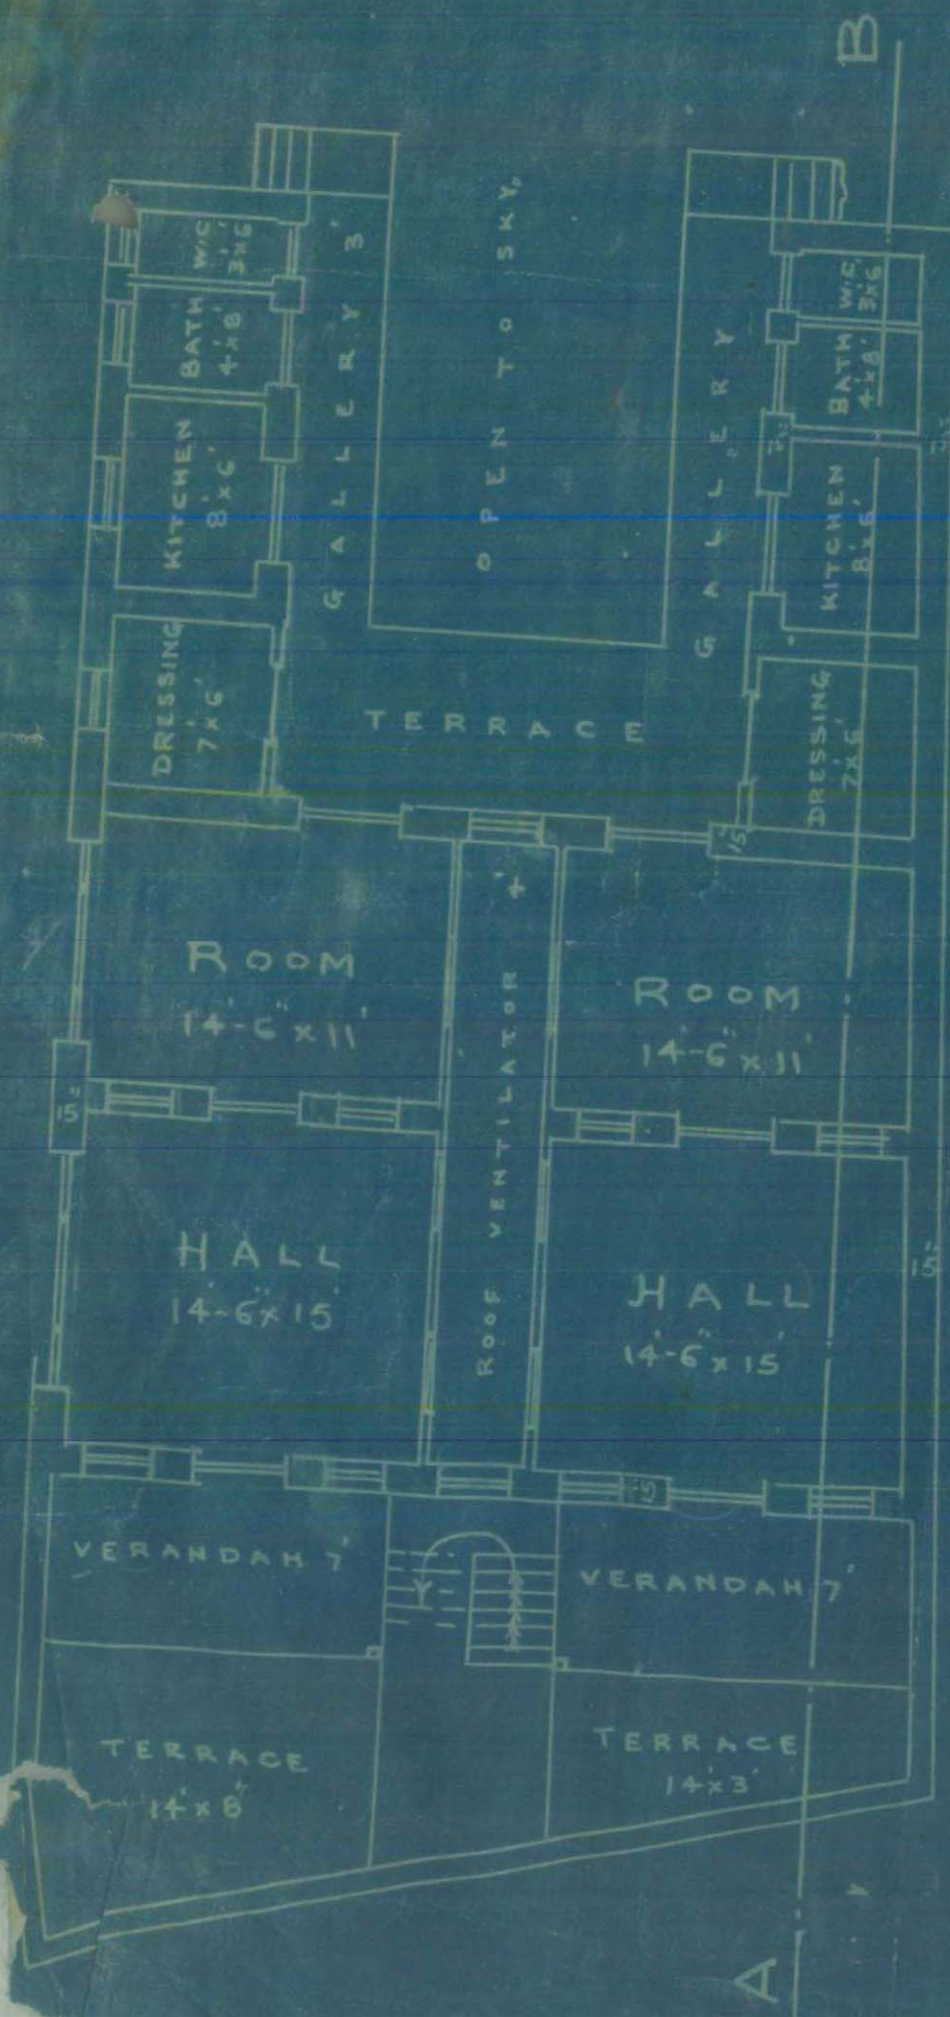

SECTION ON A.B

SITE PLAN

SCALE 80 FT = 1 INCH

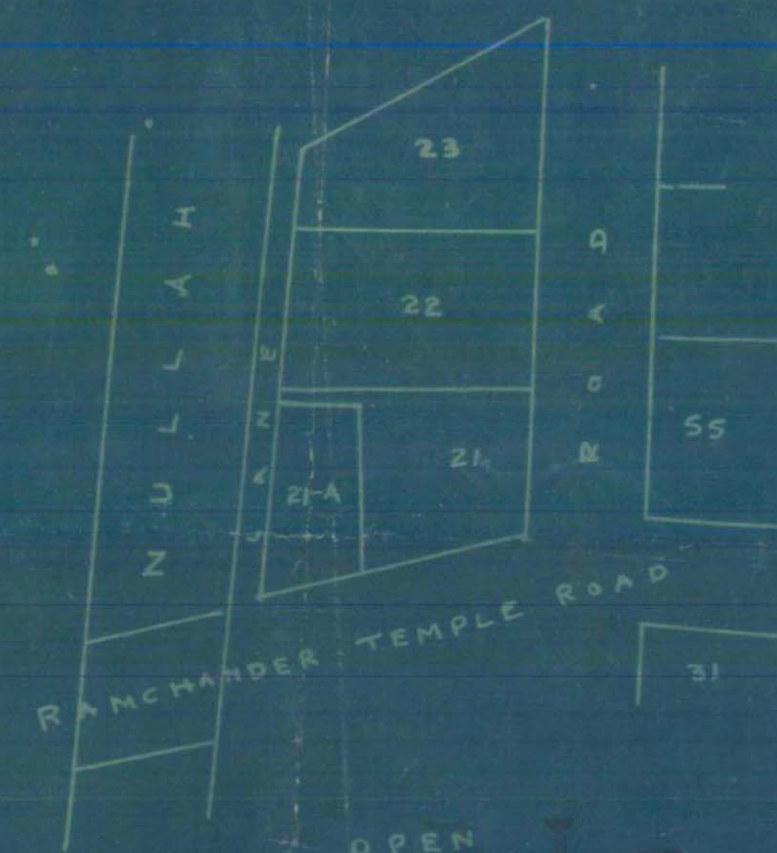

10.313

Handwritten notes in red ink, possibly indicating a date or reference number.

Handwritten signature or name in the bottom right corner.