

# Building Completion Report.

MUNICIPAL OFFICE,

Karachi, 7th April 1921.

To

THE ENGINEER,

KARACHI MUNICIPALITY.

SIR,

*No. K.S. 594*

I beg to report, the building work on plot No. 3 Sheet B15  
Ram bough Quarter owned by Mr. R. S. Advani  
*excepting slight deviations in staircase*  
is completed according to the plan approved by the Municipality, Orders are  
requested to file the correspondence.

Yours obediently,

*Bradman*

Building Surveyor "1" Section,  
Karachi Municipality.

*Copy forwarded to A/c.  
for information*

*Bennington Brown,*  
*M. C. A., M. I. C. E.,*

*Engineer,  
Karachi Municipality*

NO. L. S. 8577 of 1921. 2

Municipal Office.

Karachi 10th February 1921.  
"

M E M O : -

With reference to his letter dated 5th Instant  
Mr. R. S. Advani owner of plot No. 3, B-15 Rambaugh Quarter is  
informed, there is no objection to increase the rear Verandah  
on the top floor from 5 to 8 Feet .



M. G. A. M. I. C. E.

ENGINEER.

KARACHI MUNICIPALITY.

P:L.V.



Memo,

8/2

with ref to his letter dated 5th inst

Mr. R.S. Advani owner of plot No. 3 B 15  
Rambhadr D. is informed, there is no  
objection to increase the rear boundary  
on the top from 5 to 6 ft.

SD

M. C., A., M. I. C. E.,  
Engineer,  
Karachi Municipality.

4

3 B/5 Rambough

Submitted with report  
there is no objection in  
allowing to increase the  
ceiling height on the  
top floor from 5 to 8 feet

7/24/24  
Lawson

No objection  
8/2/24

Mr. Kassam please  
refer to 5/2

5-1

To The Engineer

Karachi Municipality  
Karachi

Dear Sir.

With Reference to  
Building Under Construction  
on Plot No 1815 Nambagar

I have the honor to inform you  
that I want to increase Verandah  
on the back of the cabins on the  
Top floor from 5' to 8' to which  
I hope there will be no objection

Karachi

Yours Truly  
J. S. D. D. D.



1286

Landsman  
to the greyside.  
103

No. L. S.

7157

OF 1920.

Form No. 6-300-25.0.20.

MUNICIPAL OFFICE,

Karachi, 16. 12. 1920.


## MEMO:

Building Surveyor Section A is informed  
that Mr. R. S. Adam has been permitted  
to make additions & alterations in  
his house  
on plot No. 3 B.15 Kemball Street  
Gambagh Quarter report should be made to the  
Undersigned when the house is completed.


M. I. MECH. E.,  
Ag. Engineer,  
Karachi Municipality.

— PLAN SHOWING PROPOSED ADDITIONS —  
— TO BUILDING —  
— ON PLOT N° 3-B-15- RAMBAUG Q<sup>E</sup> —  
— SCALE 2:1 —

NO. 318  
1920  
N. S. Aram

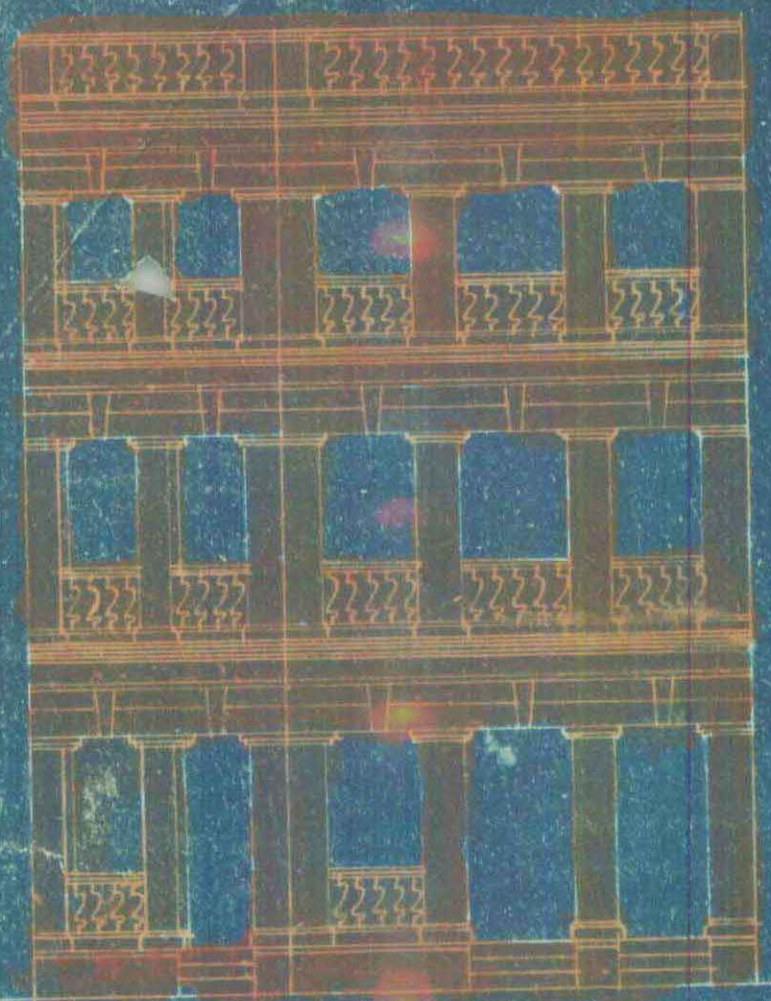

— ELEVATION ON RAMBALL ROAD —

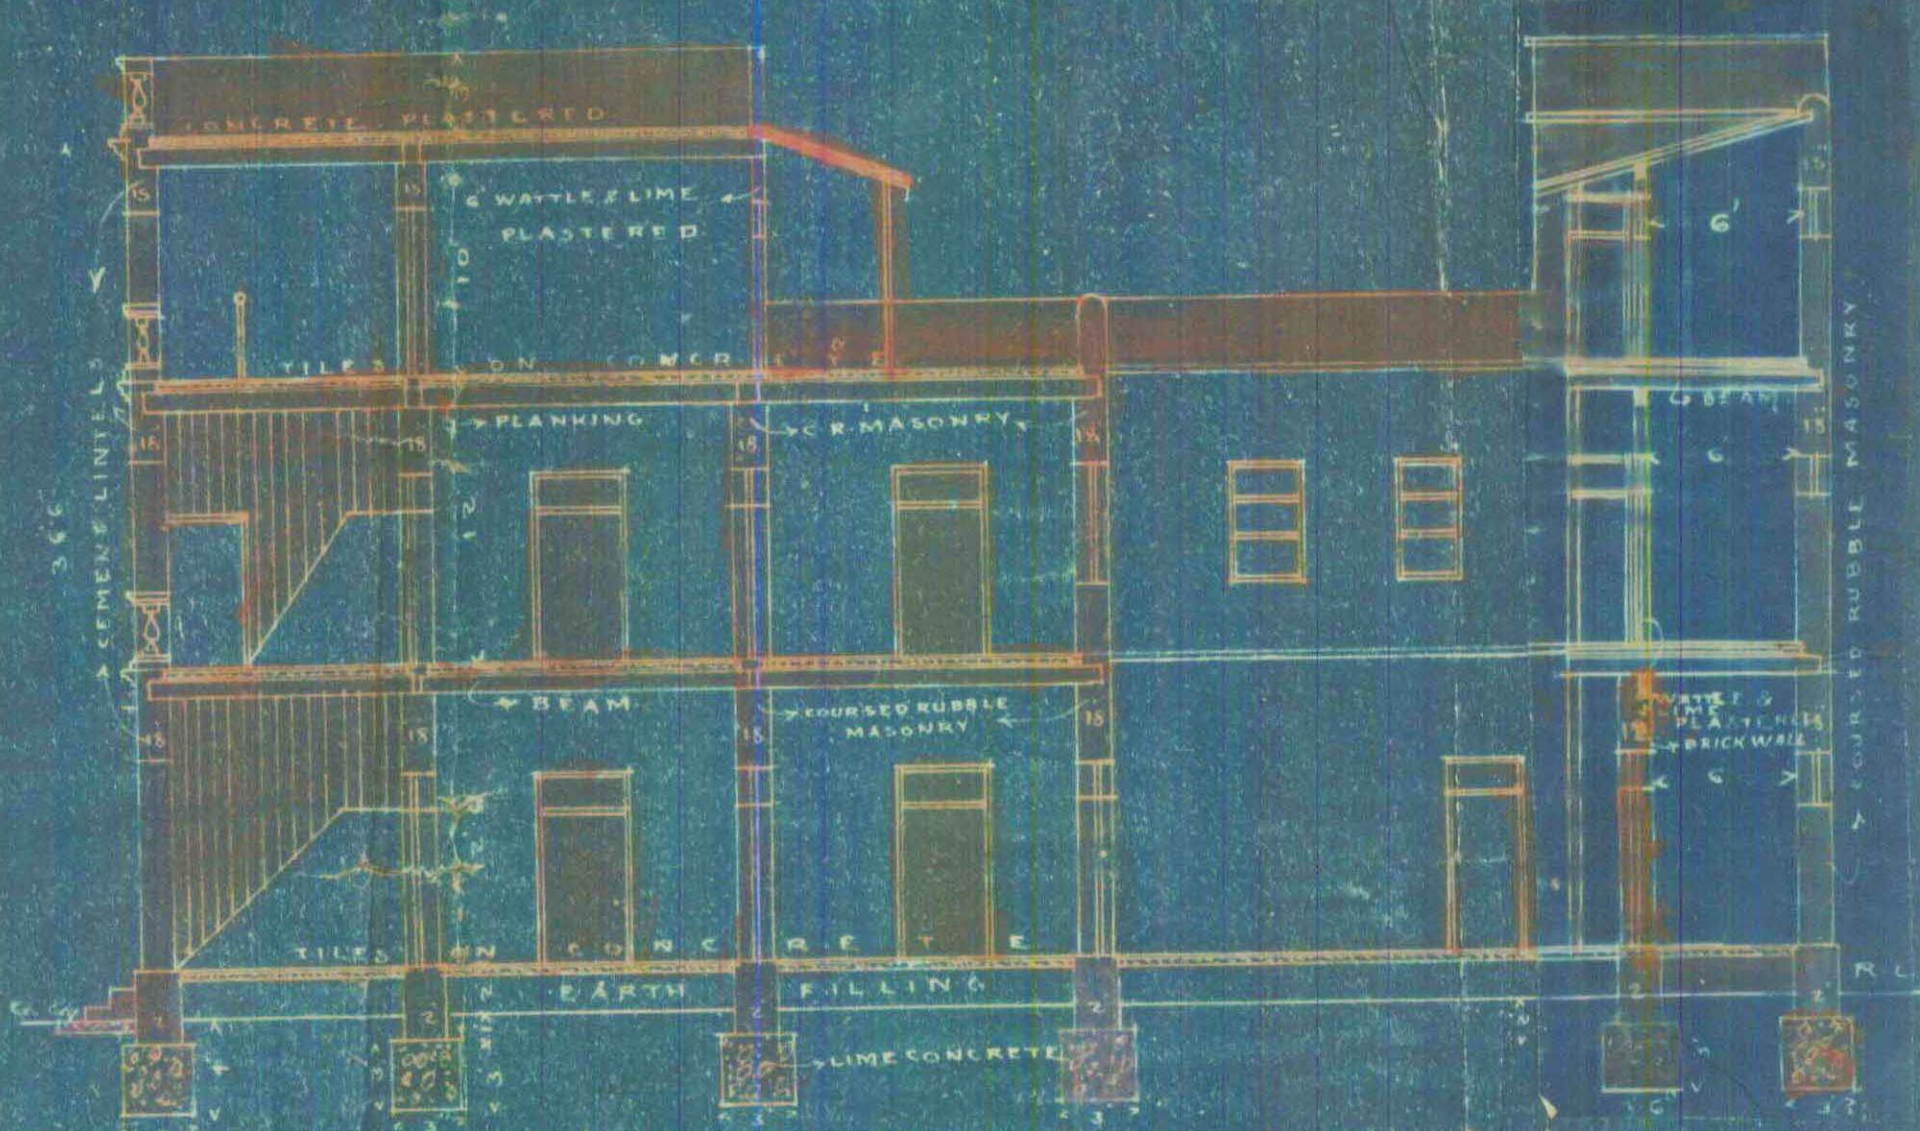


— SECTION ON A-B —


APPROVED

*N. S. Aram*

20 OCT 20  
NAZARETH & KHIMJI  
Engineers & Architects

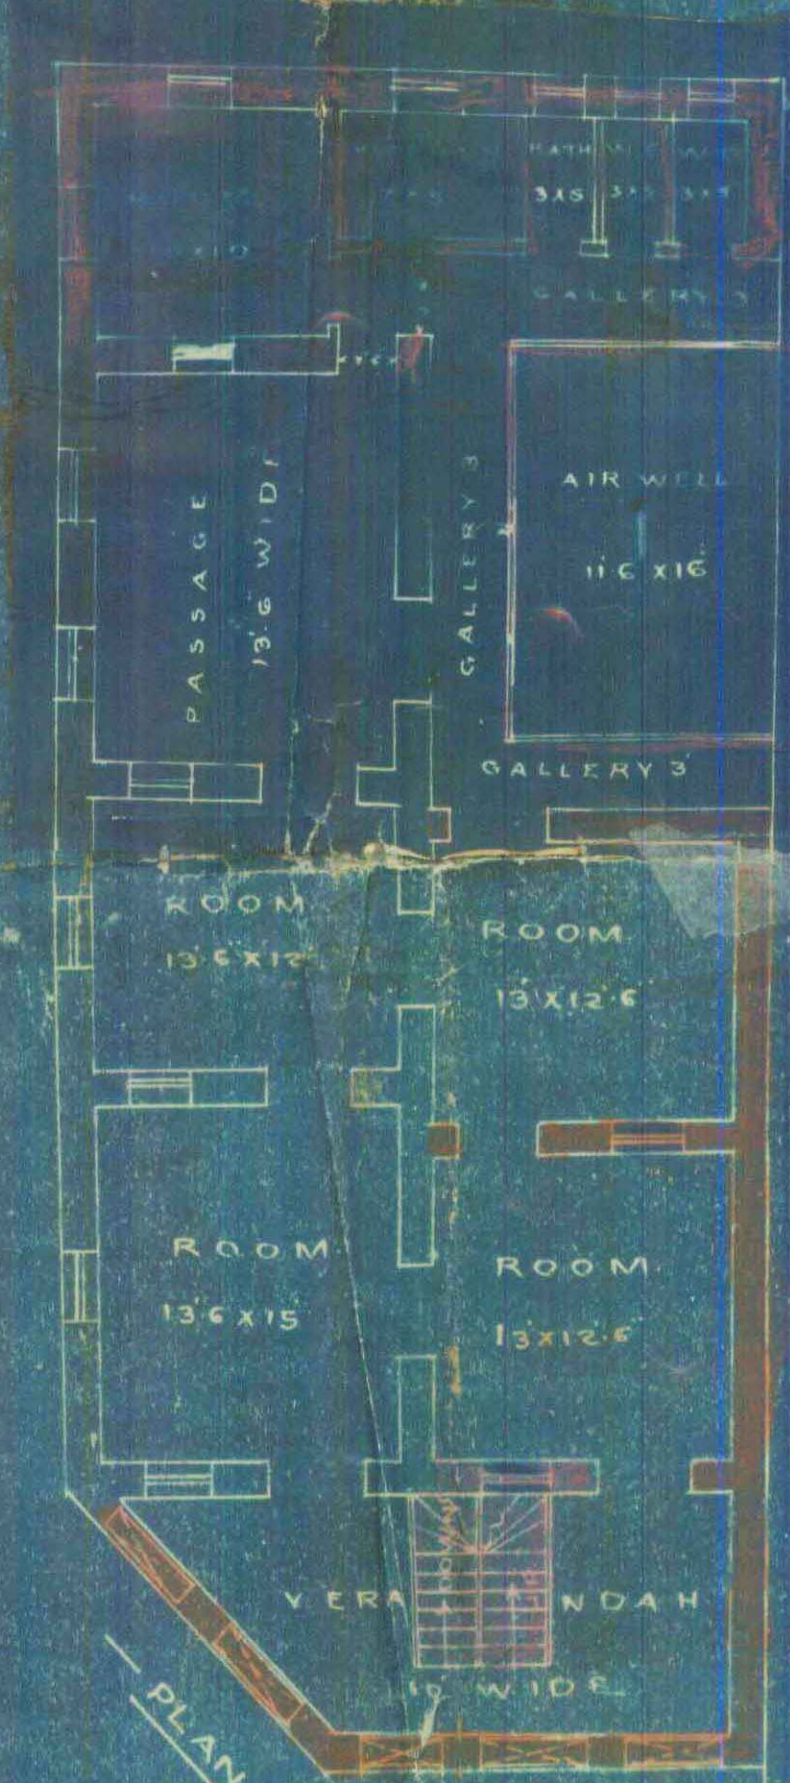

PLAN OF 1ST FLOOR

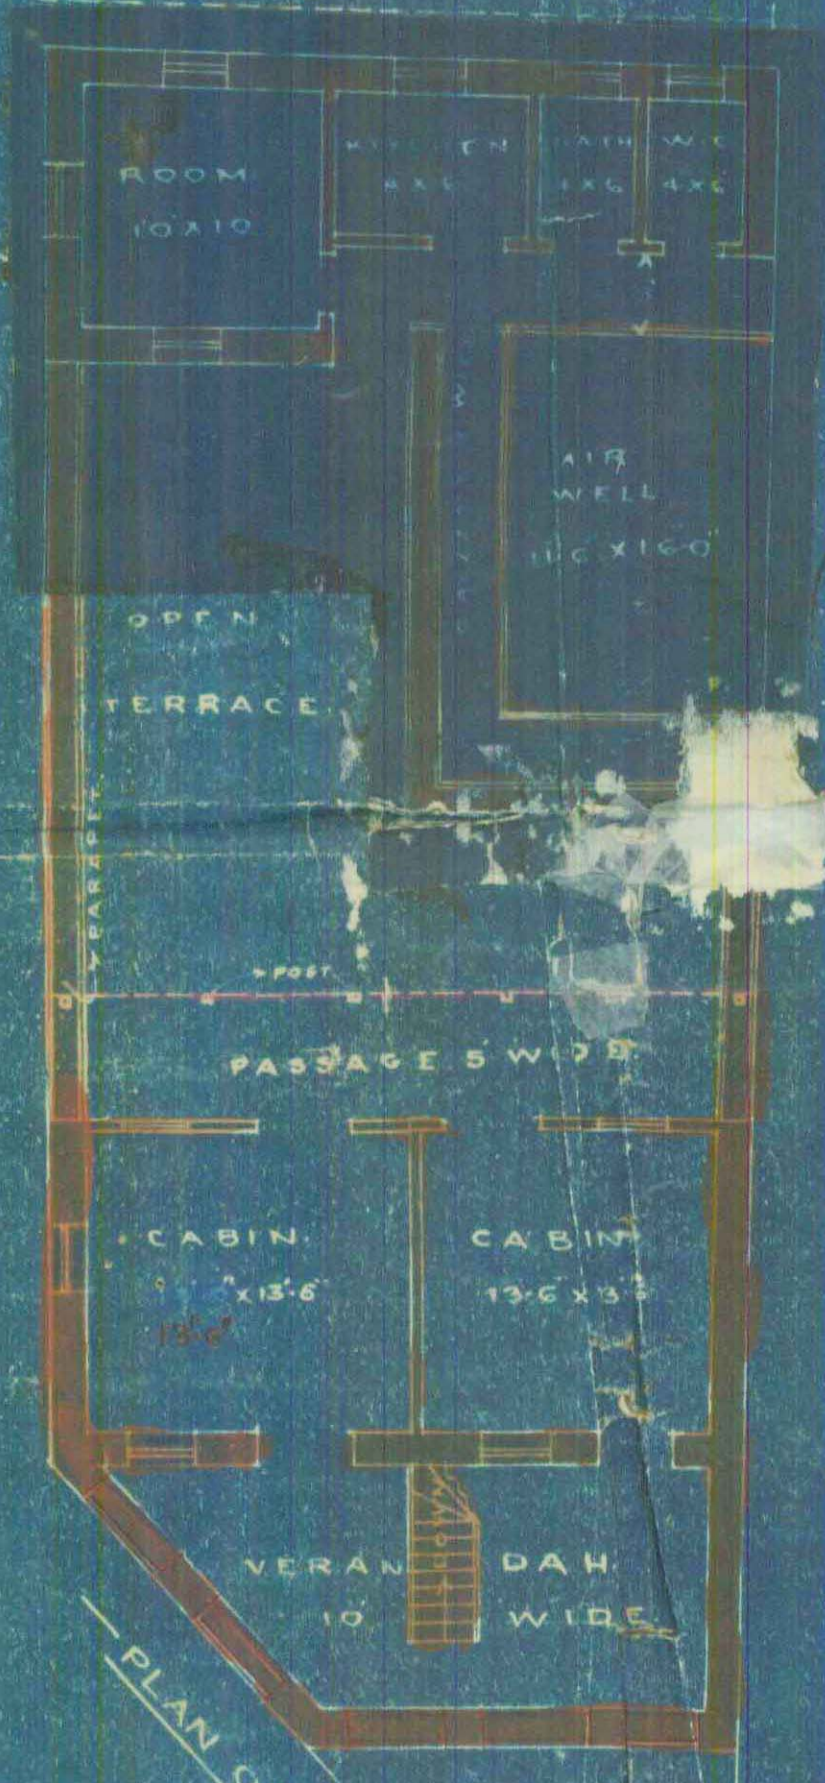

PLAN OF 2ND FLOOR



*N. S. Aram*  
20 OCT 20  
NAZARETH & KHIMJI  
Engineers & Architects