

Building Completion Report.

MUNICIPAL OFFICE,

Karachi, 18 Feb. 1921.
2

To

THE ENGINEER,

KARACHI MUNICIPALITY.

SIR,

I beg to report, the building work on plot No 8383, 84 Sheet 93
Sadar Baza Quarter owned by Mr. Hassanali Noorbhoy
is completed according to the plan approved by the Municipality. Orders are
requested to file the correspondence.

Yours obediently,

B. Barrington Brown

Building Surveyor "A" Section,
Karachi Municipality.

Copy to the A/c for information
(23) *B. Barrington Brown*
M. C., A. M. I. C. E.,
Engineer,
Karachi Municipality.

Form No. 6.

No. L. S.

1398 OF 1920

MUNICIPAL OFFICE,

Karachi

3.

3.

1920

MEMO :

Building Surveyor Section

A

is informed

that Mr.

Hasanali D. Karlibay.

has been permitted

to

build a motor garage rooms

his house

on plot No

82, 83 & 84

43

Green

Street

Lader Br.

Quarter report should be made to the

Undersigned when the house is completed.

E. A. H. Kerby

A.M. INST., C.E.,

Engineer,


Karachi Municipality.

PLAN SHOWING PROPOSED BUILDING ON
PLOT NOS 82, 83, & 84 SHEET G.3.
SUDDER BAZAR QUARTER.
SCALE 8"=1".

NO. 55



FRONT ELEVATION.

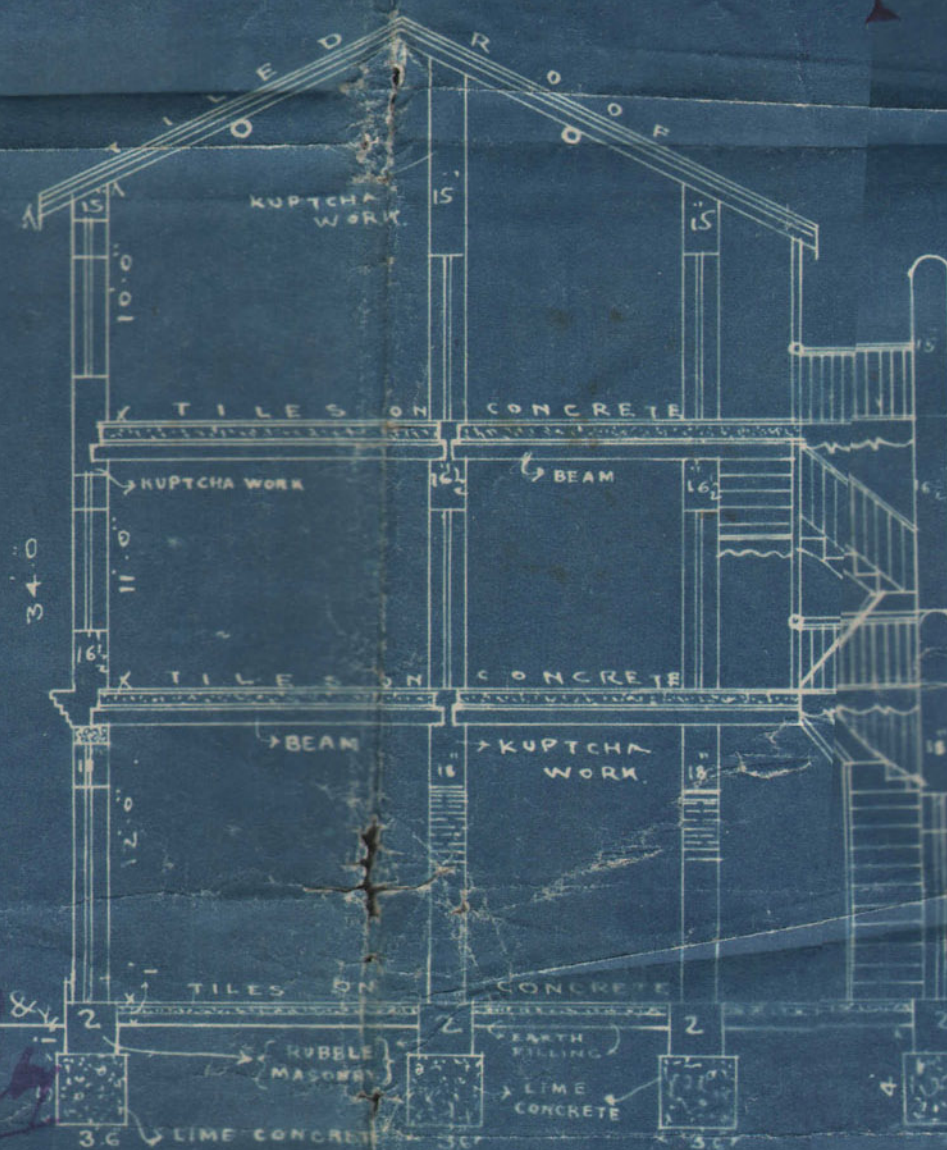



SECTION ON A. B.

Hassanali Noorhai

Khimji Mania

SURVEYOR.
NAZARETH & KHIMJI DOY
ENGINEERS & ARCHITECTS

APPROVED
A.M. Inst. C.B.
Engineer
Suruchi Municipality

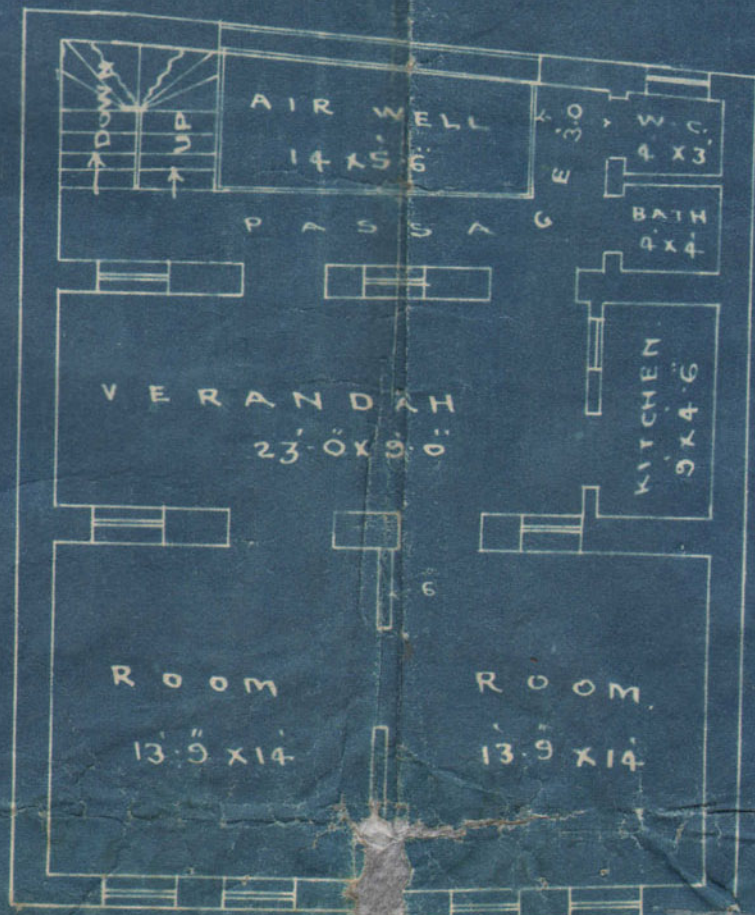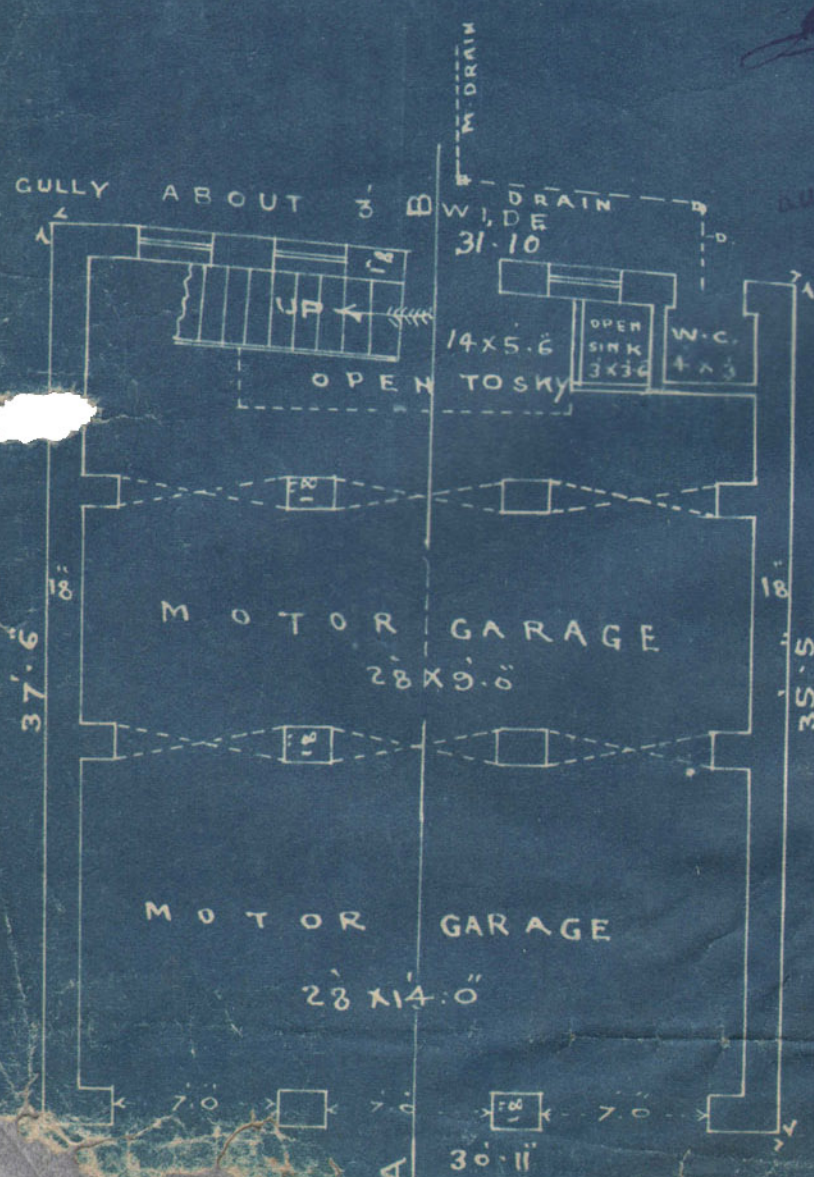

BLOCK PLAN W
SCALE 20"=1"

