

68

2

# BUILDING COMPLETION REPORT.

MUNICIPAL OFFICE,

Karachi, 30th June 1921  
2.9.21

To,

THE ENGINEER,

KARACHI MUNICIPALITY.

SIR,

R.S. 11118  
2.9.21

I beg to report that the building work on plot No. 136  
sheet G3 Sadar Bazar Quarter owned by  
Messrs A. M. Rasoolji & Co. is completed  
according to the plan approved by this office.

Copy to the A/c for information

P. B. Shivdasani

M. C. A. M. T. C. E.

Engineer,

Karachi Municipality

Yours obediently,

Building Surveyor, "A" Section,

Karachi Municipality.

No. L. S.

**No. 170**  
OF 1921  
MUNICIPAL OFFICE :  
1610

Form No. 8-40-30-1-21

Karachi, 26 5 1921  
28

MEMO :

Building Surveyor Section A is informed  
that Mr. M. R. Rasooli & Co has been permitted  
to make additions on  
his house  
on plot No. 136 43 man. field Street,  
Lader Ba. Quarter, report should be made to the  
undersigned when the house is completed.



M. C., A. M. I. C. E.,  
Chief Engineer,  
Karachi Municipality.

PLAN OF PROPOSED WALL BETWEEN STABLE

ON PLOT NO. 36 SHEET NO. G-3

SUDDER B. QR.

SCALE 30' = 1"


NOTE:- NEW WORK SHOWN IN RED




EXISTING  
ELEVATION ON OPEN SPACE



SECTION ON AB

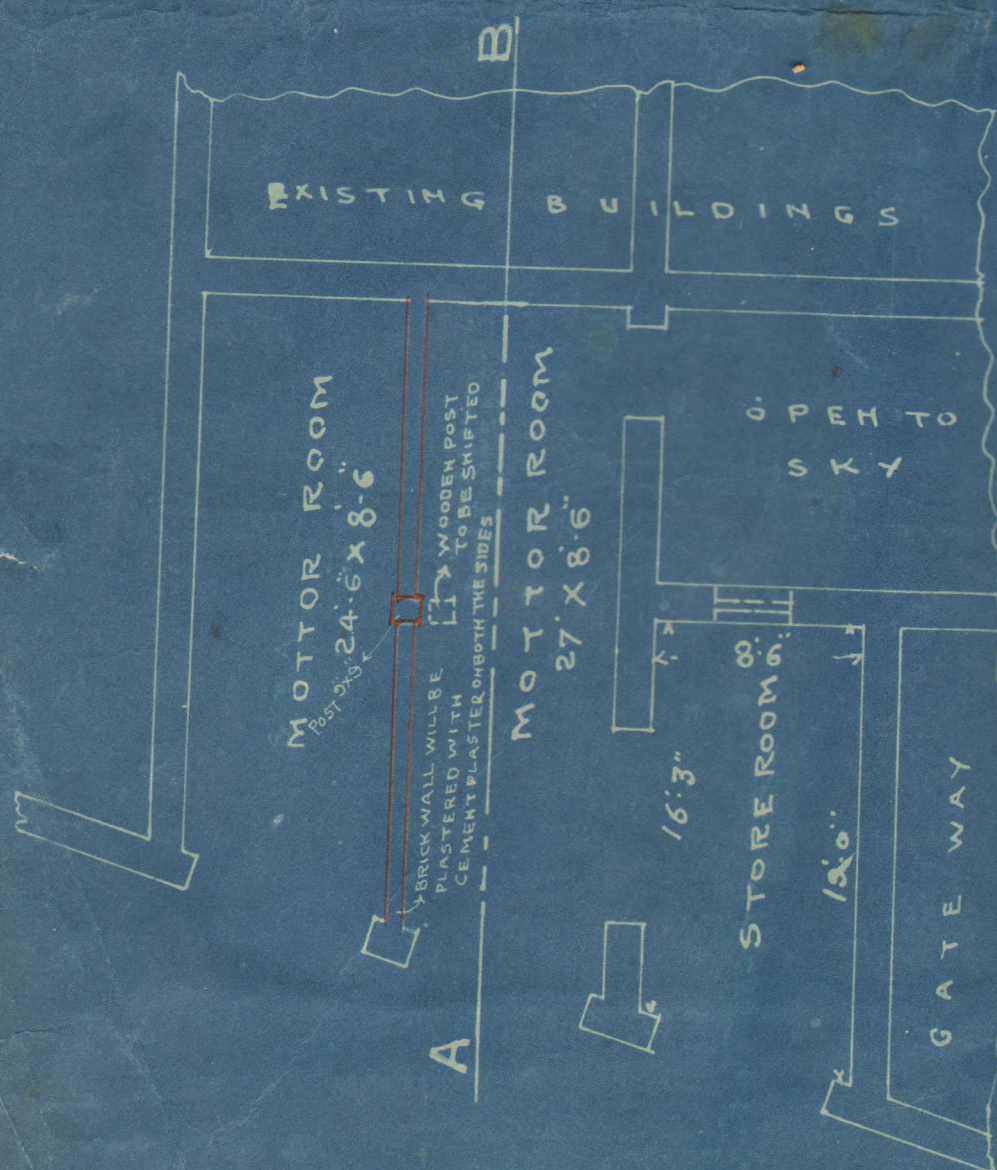

GROUND PLAN

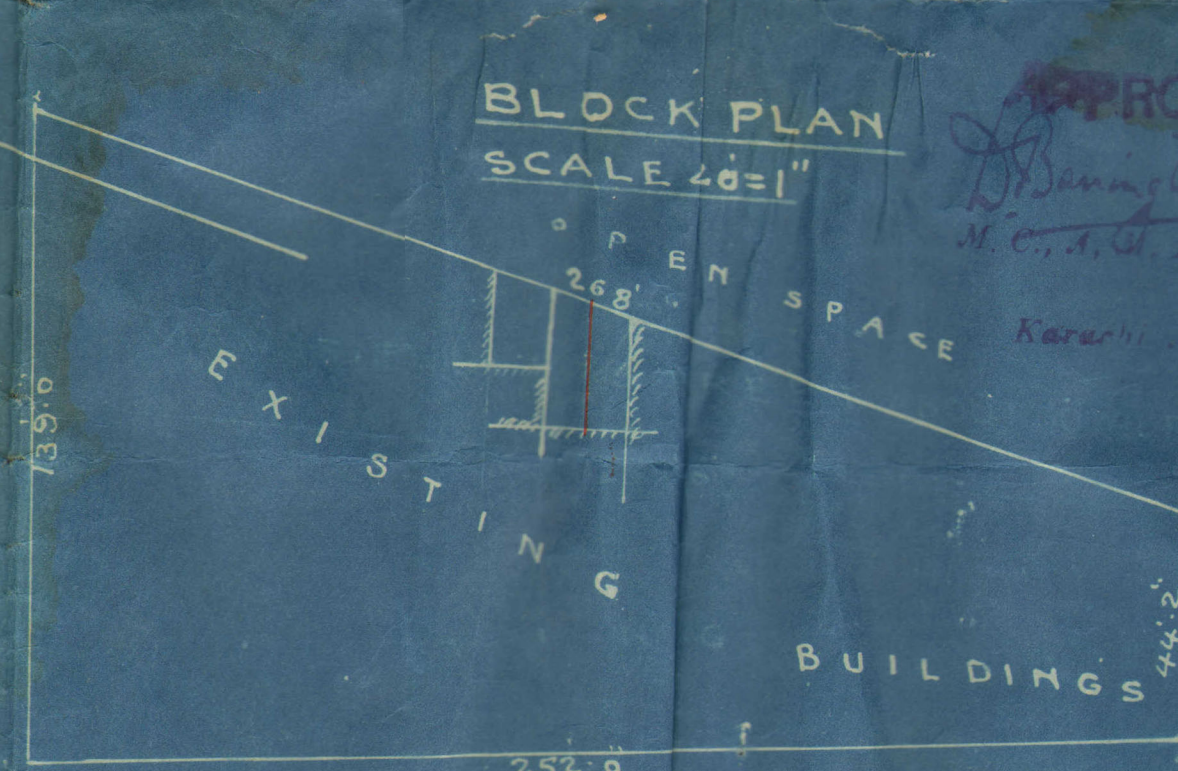

MANSFIELD STREET ABOUT 50' WIDE

*a.m. Rao G. Rao*

*G. Polson*  
M.R.S.A.

ARCHITECT & SURVEYOR.  
LAWRENCE ROAD KARACHI

NO. 170

APPROVED  
*D. Benington Shaw*  
M.C.S.A. (I.C.E.)  
Engineer  
Karachi Municipality