



200-14-2-18.

Form No. 1.

Karachi, 17-4 1918.

NOTICE UNDER SECTION 96 OF ACT III OF 1901.

To

THE CHIEF OFFICER AND CHIEF ENGINEER,
KARACHI MUNICIPALITY.

SIR,

I beg to inform you that I intend building Five two rooms & Bath
stoned on plot No. 11
Survey Sheet No. 4-D-32 situate in Sichay Village Gulamshah
Street, gail Quarter.

As required by the rules of the Municipality, I beg to submit herewith a
plan of the same for your approval.

I beg to remain,

Sir,

Your most obedient servant,

Address:—

c/o Messrs. Pathan Roy



Signature of the applicant.

No. G. 9176 of 191 .

MUNICIPAL CHIEF OFFICER AND

CHIEF ENGINEER'S OFFICE,

Karachi, 22-4- 1918.

Forwarded to the Municipal Engineer for favour of disposal.

Talwar

M. INST. C. E.,

Chief Officer and Chief Engineer,
Karachi Municipality.

2. B. J. a
23-4-18

Abdullah Hussain Tayebkhoy
Adanally Tayabkhoy

No. E 3533 of 1918.

MUNICIPAL ENGINEER'S OFFICE,

Karachi, 23rd April 1918.

Memo.

The above application is forwarded to the Municipal Health Officer for favour of report.

S. M. I. C. E.
S. M. I. C. E.

A.M.I.C.E.,

Engineer,
Karachi Municipality.

MUNICIPAL HEALTH OFFICER'S REPORT.

Returned to the Engineer, Karachi Municipality, with the following remarks :— *Permission to build additional rooms cannot be granted, as it will render the building unfit for human habitation.*

S. M. I. C. E.
D.P.H. (London),

Health Officer,
Karachi Municipality.Date 27-4-1918.No. E 3533 of 1918.

MUNICIPAL ENGINEER'S OFFICE,

Karachi, 29th April 1918.

Forwarded to the Building Surveyor for report.

S. M. I. C. E.
S. M. I. C. E.

A.M.I.C.E.,

Engineer,
Karachi Municipality.

Through

THE LAND SURVEYOR,
Karachi Municipality.

BUILDING SURVEYOR'S REPORT.

Applicant's name Abdul Hussein adaudally 870 Dyebally

Whether he is the owner of the plot on which it is proposed to build 1/2

Plot under whose control Government

Whether it is permanent or temporary Permanent

The work proposed Bio addition and alkylation

Building Surveyor's report 84

They report that the proposed additional rooms
will render ^{existing} building unnecessary as the
same blocks up light ^{as} the building

Date 29 1918.

Building Surveyor.

Submitted through the Land Surveyor.

LAND SURVEYOR'S REPORT.

Does the plot come under Alignment no

Area of plot

Area under Alignment _____

Remarks Sir, With reference to the they to report
that the additional room will render the
existing building insufficient. permission asked
for cannot be granted. approved

Date 1-5-1918

Land Surveyor.

ORDER OF THE ENGINEER.

M. INST. C. E.,

Engineer,
Karachi Municipality.

1-4 100



Heritage

KMR.CDD.JaQ.1918.01

4

No. E. of 191 .

MUNICIPAL ENGINEER'S OFFICE,

Karachi, _____ 191 .

Submitted to the Managing Committee for information.

DISAP

A.M.I.C.E.,

Engineer,

Karachi Municipality.

Through

THE CHIEF OFFICER & CHIEF ENGINEER,

KARACHI MUNICIPALITY.

RESOLUTION OF THE MANAGING COMMITTEE.

Resolution No. _____ dated _____

33




DISAPPROVED



GROUND PLAN




FIRST FLOOR PLAN

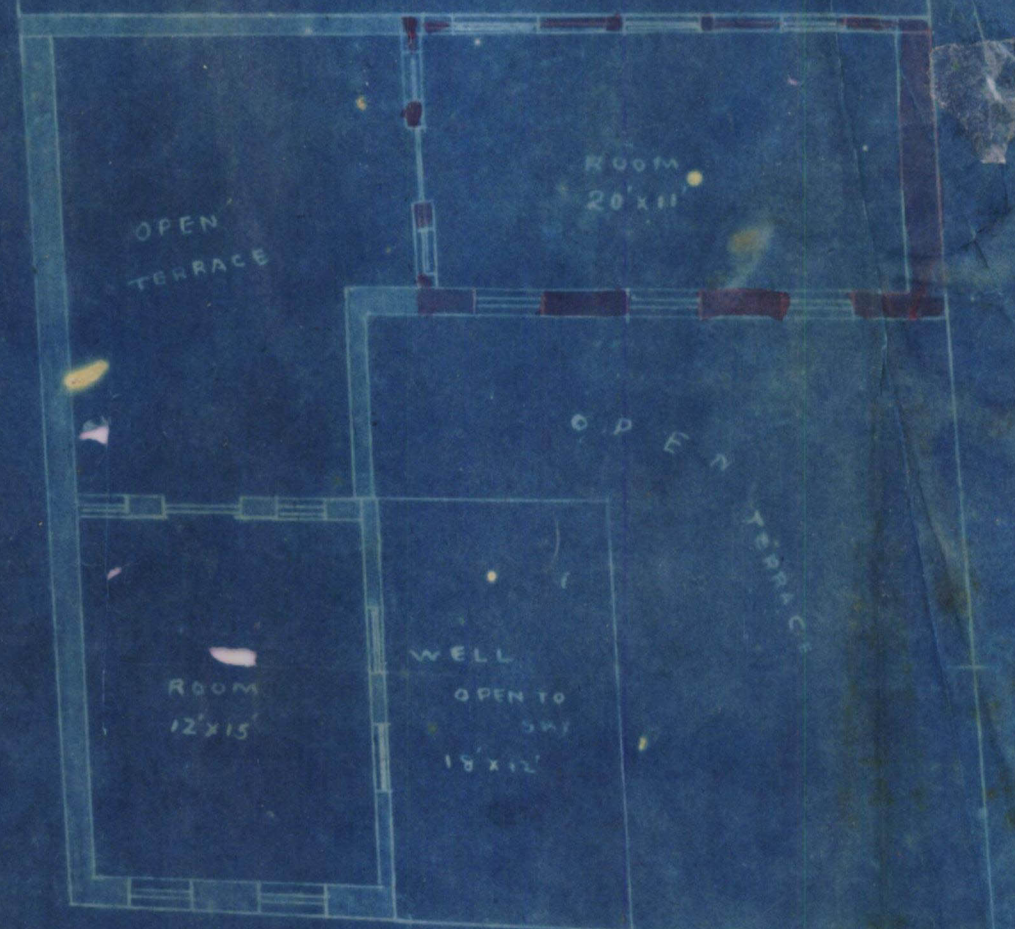

SECOND FLOOR PLAN

Plan Showing Proposed
Additions & Alterations on Plot No II Sheet D-2
Jail Quarter
Scale 1/8"

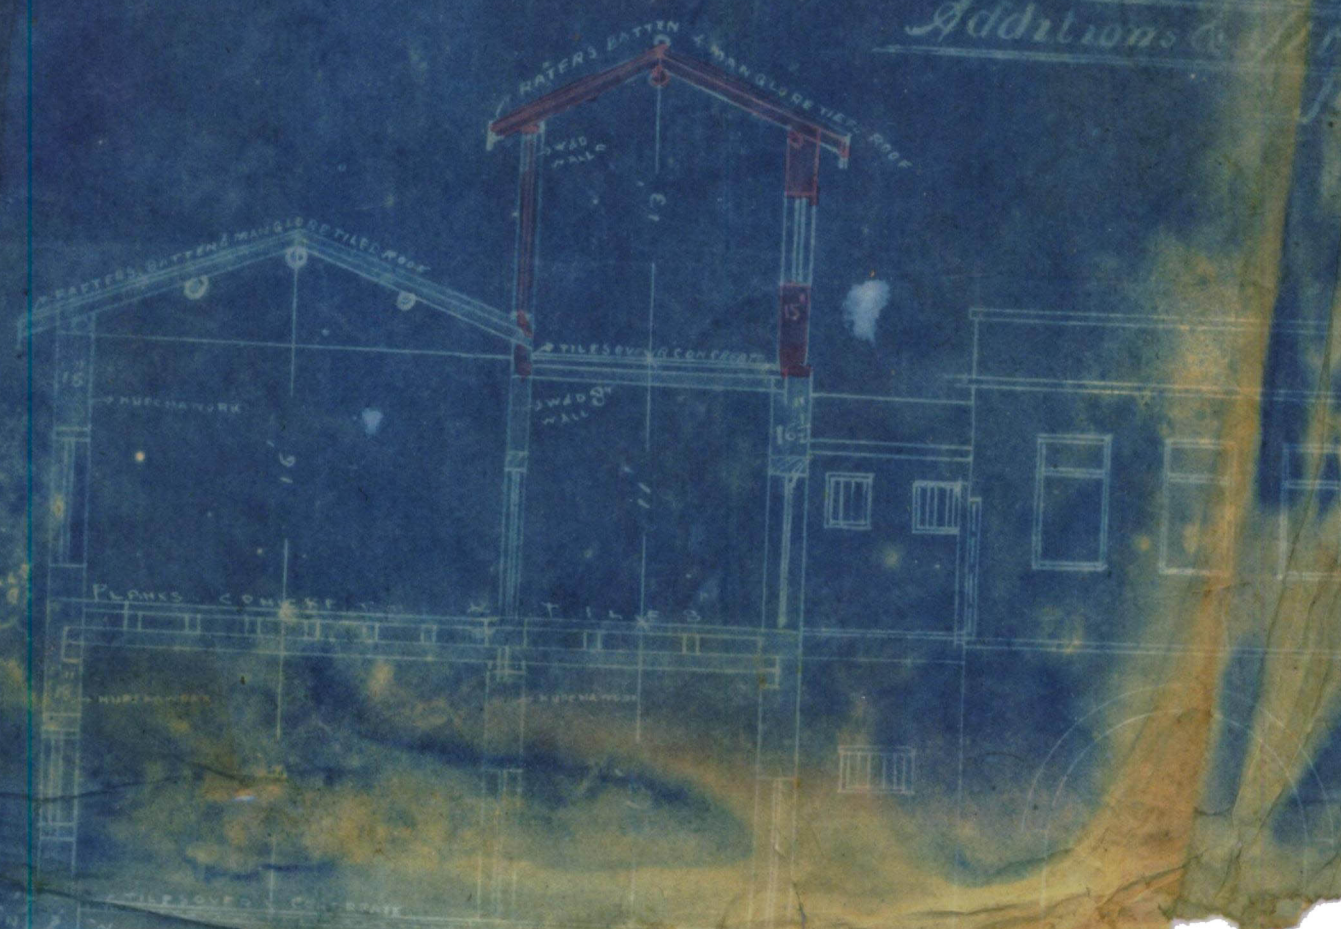

BLOCK PLAN

Scale 20 Feet to an inch

Lane 12'6" wide

Goatunghomed Street 20' wide



No.E

4088

of 1918.

Municipal Office,

Karachi, 6th May 1918.

MEMO / -

With reference to their application dated 17th April 1918 received on 22nd April 1918 with plan of the proposed additional rooms and the bath rooms to be erected on plot No.11, D-2, Jail Quarter, Messrs Abdulhusain Tyabbhai & Adamali Tyabbhai are informed that the proposed rooms will render the existing building insanitary. The plan therefore cannot be approved and it is returned herewith.

A.M. INST. C.E.,

ENGINEER?

Karachi Municipality.