



No 139

Form No. 2-490-4-5-21.

ORDER UNDER SECTION 96 (2) OF ACT, III OF 1901.

No. L. S. 4327 OF 1922.

MUNICIPAL ENGINEER'S OFFICE:

Karachi, 23.5.1922
25

MEMO:

With reference to his application, dated 30th March 1922

Mr. Mohammad Ali Modir Anjwala is informed

that the plan submitted by him for building additions &
alterations to his building

on plot No. 6 Survey Sheet 81

situate in Municipal Street, Jail

Quarter, is approved, and permission to build in accordance therewith is granted. The building to be erected subject to the By-laws and Rules of the Municipality.


M. C., A. M. I. C. E.,
ENGINEER,
Karachi Municipality.

NOTICE 1.—This pass does not give permission to occupy Municipal land with building materials. This can only be allowed when the street is wide enough to permit building materials being deposited on it without it being a source of danger to the public, and only then on a hoarding being placed round the land to be occupied and on payment, in advance, of fees for occupation of Municipal land at the following rates:—

	Ks. A. P.
(1) For the first three months, per square yard, per diem	.. 0 0 1
(2) For the next three months	.. 0 0 1
(3) For any subsequent time	.. 0 0 2

NOTICE 2.—Windows, steps and doors of the building will not be permitted to project on or overhang any public street or Municipal land.

NOTICE 3.—Paints will not be allowed to project more than 2 inches on any public street for ornamental purposes.

4327 copy to B. J. A.

4327

4327



No. CDC 902 of 1922.

Revenue Department,
City Deputy Collector's Office.
Karachi, 19th May 1922.

Memorandum,

4447

With reference to his application dated 8th May 1922, requesting permission to make certain additions and alterations on plot No. 6 (Sheet D-1) Jail Quarter, in accordance with amended plan No. 106 approved by the Engineer Karachi Municipality, Seth Mohamedali Moosaji is informed that the permission applied for is granted provided he obtains permission of the Karachi Municipality before commencing the work.

2. Amended plan No. 106 is returned herewith duly sanctioned.

Remunung
City Deputy Collector, Karachi.

- m. bonani*
8/5/22
If attached
Pam may be missed
20/5/22
- (1) Seth Mohamedali Moosaji, C/O Khimji J. Karia, Karachi.
 - (2) The Engineer Karachi Municipality for information, with reference to his endorsement No. L. S. 1908 dated the 10th April 1922.
 - (3) The Income Tax Collector, Karachi for information, in continuation of this office No. CDC 2373 dated the 19th August 1921.
 - (4) The Supdt: Karachi City Survey for information.

60.
attach pass
8.
45



L. S. 1907 of 1922 .

MUNICIPAL OFFICE,

Karachi, 10th April 1922 .

MEMO :

With reference to ^{Amended} ~~his~~ ^{their} application with plan received on 30th March 1922, for building on plot No. 6
 Sheet 21 Sub Quarter.
 Mr. Mahomedali Moosaji Ayanoala
 Messrs. is requested to apply for permission to the City Deputy Collector with two
~~are~~ Copies of plans herewith returned duly signed and approved.

Permission to build will only be granted after the approval of the plans by the City Deputy Collector.

~~He~~ ^{They} must not start any building operations until ~~he~~ ^{they} hears further from this office.

M. C., A. M. Inst. C. E.,
 Engineer,
 Karachi Municipality.

L. S. 1908 of 1922 .

MUNICIPAL OFFICE,

Karachi, 10th April 1922 .

MEMO :

Copy to City Deputy Collector for information.

M. C., A. M. Inst. C. E.,
 Engineer,
 Karachi Municipality.



No. E 10761 of 1922.

MUNICIPAL ENGINEER'S OFFICE,
Karachi, 31st March 1922

MEMO:

The above application is forwarded to the Municipal Health Officer
for favour of report.



*Inspect room 10010
Show to Mr.
3/3*

*4698
31/3/22*

[Signature]
M. C. N. S. E.,
Engineer,
Karachi Municipality.

MUNICIPAL HEALTH OFFICER'S REPORT.

Returned to the Engineer, Karachi Municipality, with the following

Remarks:—

*Bath room + w.c. are not shown
on the ground floor. He must keep
the space underneath the stairs
entirely open.*

[Signature]
D. P. H.

D. P. H. (London),
Health Officer,
Karachi Municipality.

Date

192

No. E. 107 of 1922.

MUNICIPAL ENGINEER'S OFFICE,

Karachi, 5th April 1922.

Forwarded to the Building Surveyor and Land Surveyor for report.


S. H. Khan
M. E.,
Engineer,
Karachi Municipality.Amended plan
BUILDING SURVEYOR'S REPORT.Applicant's Name Mahomed Ali Mosaferi AyarwalaWhether he is the owner of the plot on which it is proposed to build YesPlot under whose control Govt.Whether it is permanent or temporary PermanentThe work proposed To make add + altBuilding Surveyor's Report SeeSee appear no objectionDate 15/6/22J. J. J. J.
Building Surveyor.



LAND SURVEYOR'S REPORT.

Does the plot come under Alignment noArea of plot 2/8Area under Alignment nilRemarks Let.

*There appears no objection
to approve the plan.*

Date

192

Land Surveyor

ORDER OF THE ENGINEER.

*no objection**4/4*

M. C., A. M. INST. C. E.,

Engineer,

Karachi Municipality.

2/6/22



Heritage

KMR.CDD.JaQ.1921-1922.02

7246

4

No. L. S. 44/5 of 1922.

MUNICIPAL ENGINEER'S OFFICE,

Karachi, 30/5 1922

Submitted to the Managing Committee for information.

~~Chief Officer & Chief Engineer,~~
H. I. C. E.,
Amended

[Signature]

M. C., A. M. I. C. E.,

Engineer,
Karachi Municipality

Through

THE CHIEF OFFICER & CHIEF ENGINEER,

Karachi Municipality.

RESOLUTION OF THE MANAGING COMMITTEE.

Resolution No. _____ dated _____

I see a paper no objection
2/7

28 05



Form No. 1-500-24-12-21.

Karachi, 30th march 1922.

Notice under Section 96 of Act III of 1901.

THE CHIEF OFFICER & CHIEF ENGINEER,
KARACHI MUNICIPALITY.

Sir,

I beg to inform you that I intend building Amended plan
Erecting on plot No. 6
Survey Sheet No. D. 1 situate in Jail St.
Street, Surangi Quarter.

As required by the Rules of the Municipality, I beg to submit herewith a
plan of the same for your approval.

I beg to remain,

Sir,

Your most obedient Servant,

Address:—

Mahomedali Musap
Amir ul Uloom
in the Karachi

Mahomedali Musap
Amir ul Uloom

Signature of the Applicant.

No. G. 3033 of 1922.MUNICIPAL CHIEF OFFICER AND
CHIEF ENGINEER'S OFFICE,Karachi, 30th march 1922.


Forwarded to the Municipal Engineer for favour of disposal.

Carroll


For Chief Officer and Chief Engineer,
Karachi Municipality.



SECTION ON A.B

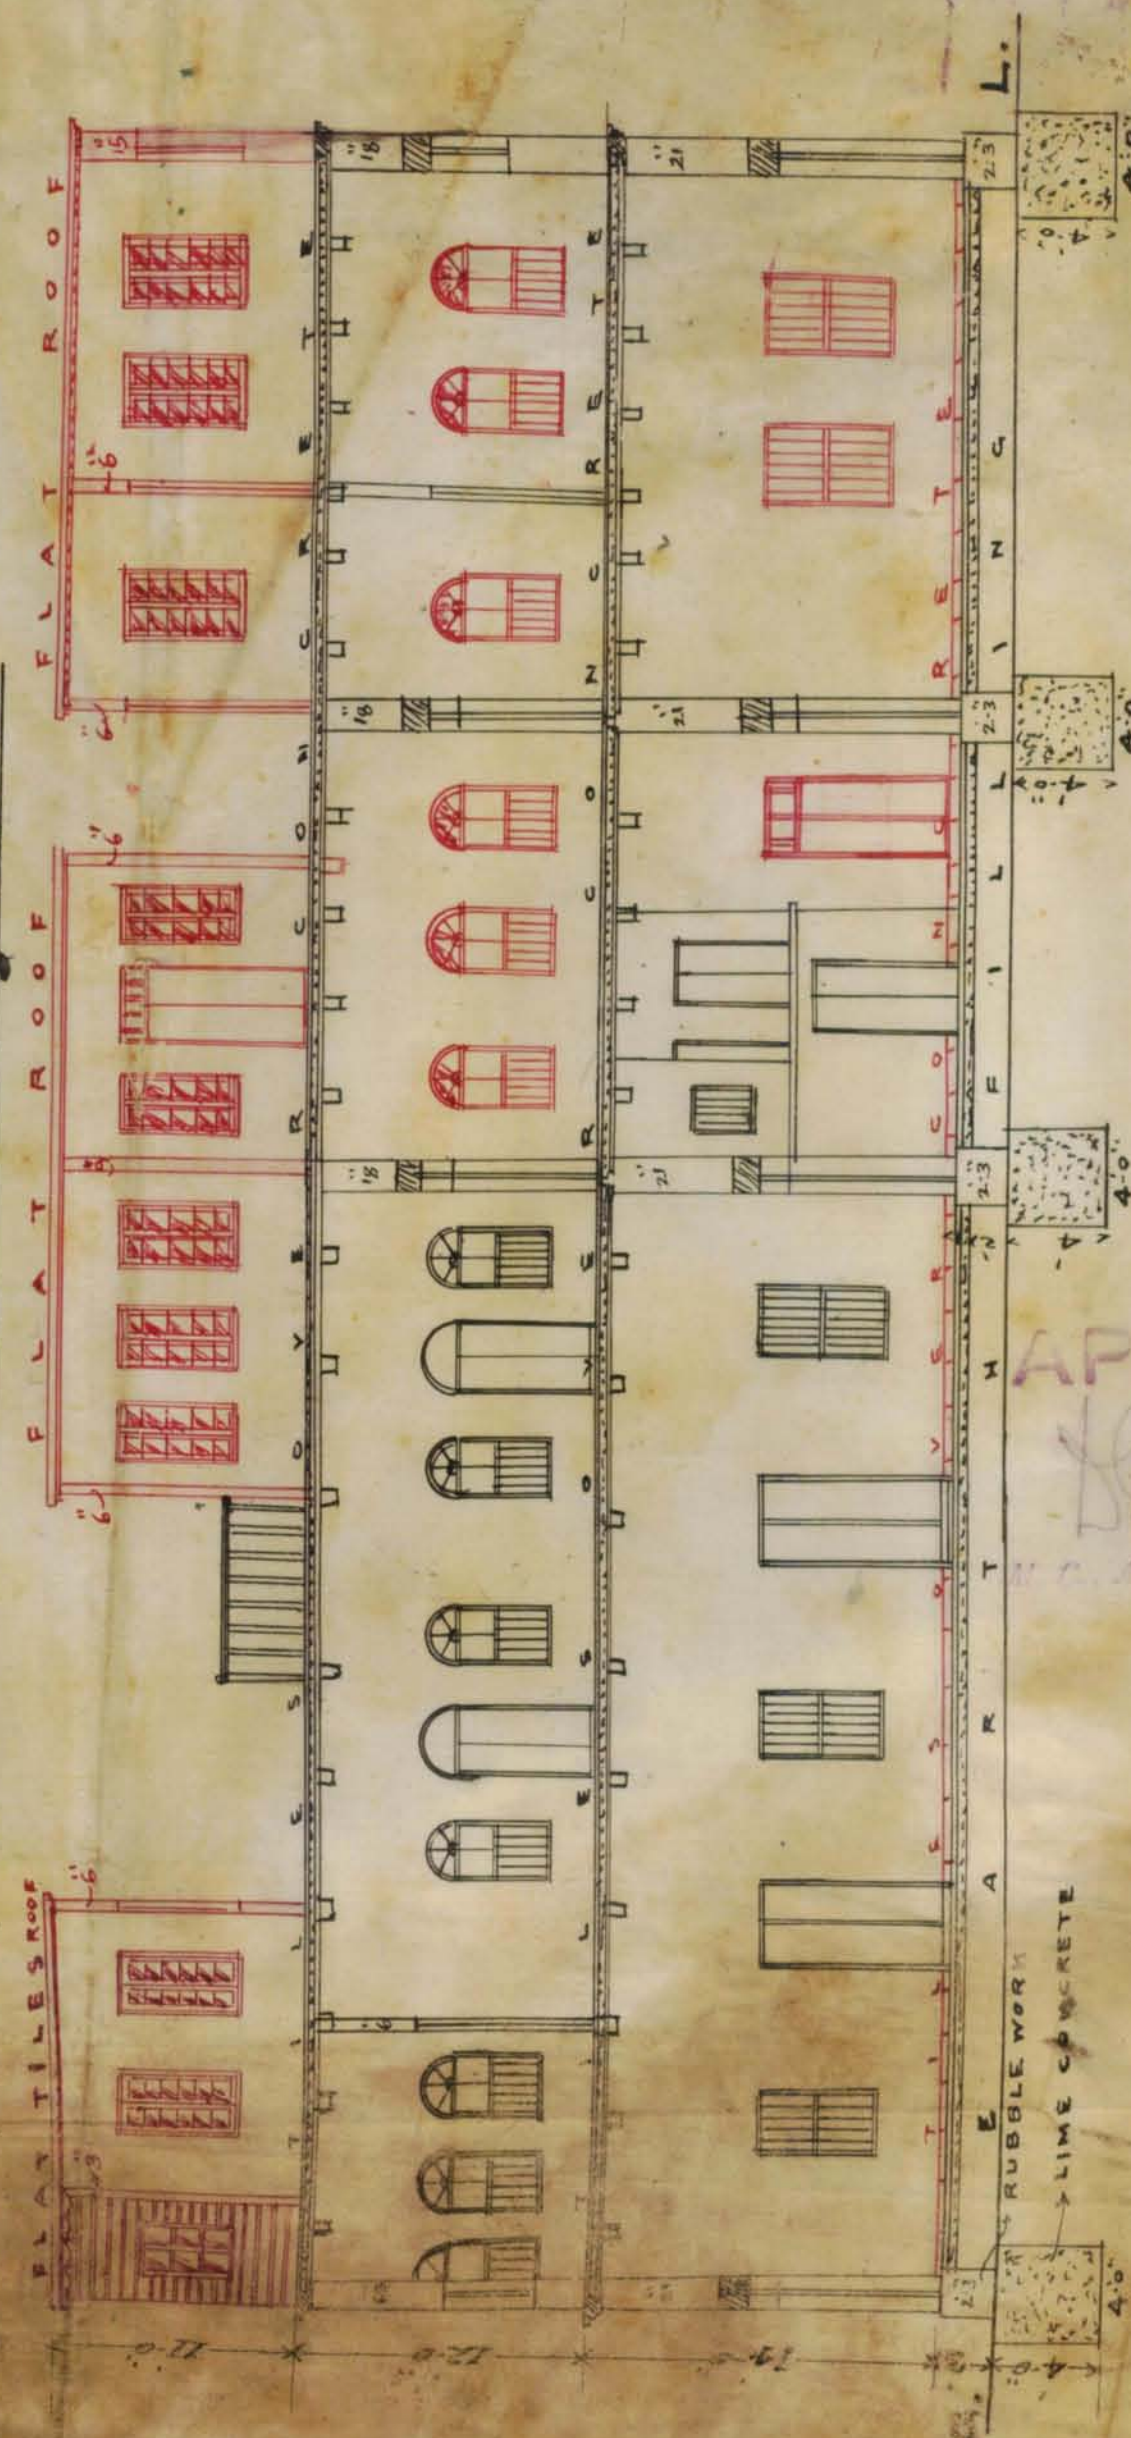


ELEVATION

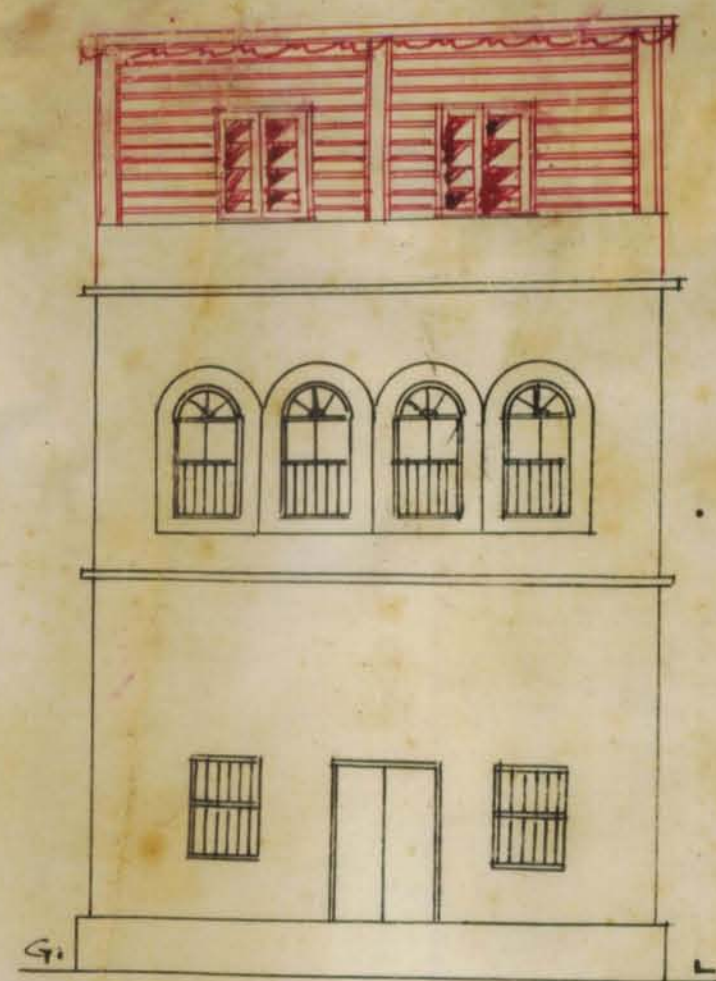

SITE PLAN

SCALE 20' = 1"

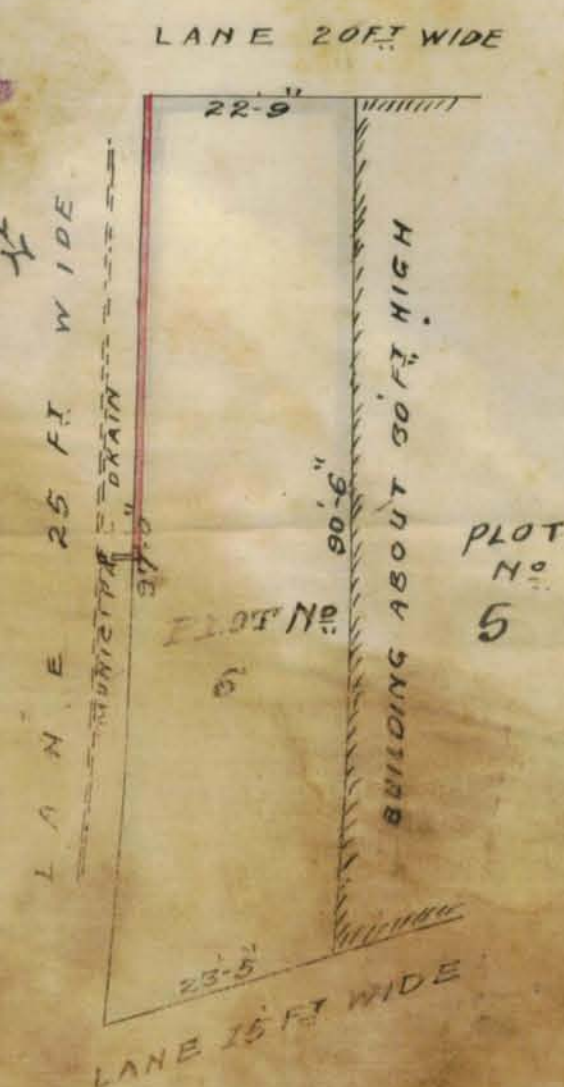

PLOT
No.
5

AMENDAD PLAN
JAIL QUARTER
PLAN OF PROPOSED ADDITIONS & ALTERATIONS TO
EXISTING BUILDING ON PLOT N^o 6-D-1
SCALE 8"=1"

NOTE

NEW WORK SHOWN IN RED LINE
OR COLOURED

ARCHITECT & SURVEYOR
HARRIS



Form No. 6-400-30-4-21.

No. L. S. 5739 OF 1921.

MUNICIPAL OFFICE :

Karachi, ¹⁷/₁₉ 9. 1921.

MEMO :

Building Surveyor Section B- is informed
that Mr. Ahmedul Musawi masoodi Ryand has been permitted
to make additions & alterations in
his house
on plot No. 6. D. Street,
Jail Quarter, report should be made to the
undersigned when the house is completed.

M. C., A. M. I. C. E.,

Chief Engineer,

Karachi Municipality.

