




Heritage

KMR.CDD.JmQ.1925.02

37

Re: plot no. ~~13~~ ¹³, Jm-1, Janshed Q.

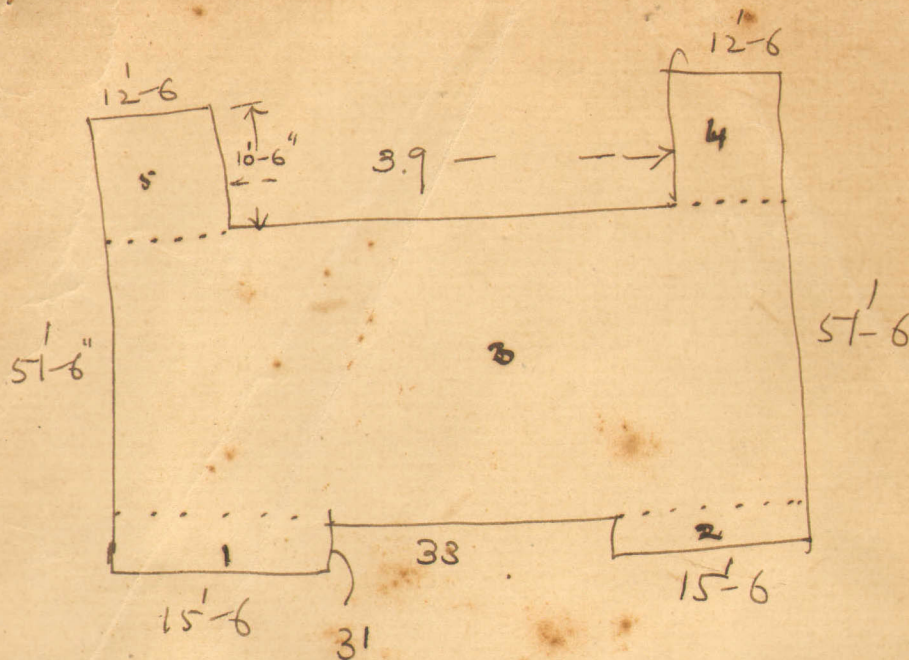

$$\begin{array}{rcl}
 1. & 15\frac{1}{2} \times 3 & = 46\frac{1}{2} \\
 2. & 15\frac{1}{2} \times 3 & = 46\frac{1}{2} \\
 3. & 64 \times 38 & = 2432 \\
 4. & 12\frac{1}{2} \times 10\frac{1}{2} & = 131\frac{1}{4} \\
 5. & 12\frac{1}{2} \times 10\frac{1}{2} & = 131\frac{1}{4} \\
 & & \hline
 & & 2787\frac{1}{2} \text{ sq ft}
 \end{array}$$

$$= \underline{\underline{309.7 \text{ sq yd}}}$$

Total area 944 sq yd.

Area available to be built upon } = 314.7 sq yd.

Submitted

with the boundary in question on 16 ⁸/₂₆

orders are requested 11/4/25

~~2-6~~ Phen
clatter
MP
22/5



BUILDING COMPLETION REPORT.

LAND MANAGER AND ARCHITECT'S OFFICE,

Karachi, _____ 192 .

To

THE LAND MANAGER AND ARCHITECT,

KARACHI MUNICIPALITY.

SIR,

I beg to report that the building work on plot No. 13, Sheet Jm. 1Jamno Quarter owned by Mr. Choithram L.
on 16-8-1928has been completed/according to plans approved by the Municipality. Orders
are requested to file the correspondence.

Yours obediently,

Building Surveyor " "Section,
Karachi Municipality.

No. L. M. A/BS _____ of 192

Karachi, _____ 192 .

Copy to the Assessor & Collector for information,

B. SC. A. M. Ints. C. E.
Land Manager and Architect,
Karachi Municipality.



BUILDING COMPLETION REPORT.

LAND MANAGER AND ARCHITECT'S OFFICE,

Karachi, _____ 192 .

To

THE LAND MANAGER AND ARCHITECT,

KARACHI MUNICIPALITY.

SIR,

I beg to report that the building work on plot No. 13 Sheet Jm. 1.Jaunabad Quarter owned by Mr. Chaitram L.
On 16-8-1926

has been completed according to plans approved by the Municipality. Orders are requested to file the correspondence.

Yours obediently,

Building Surveyor " "Section,
Karachi Municipality.

No. L. M. A/BS _____ of 192

Karachi, _____ 192 .

Copy to the Assessor & Collector for information,

13, Jm 1
Notes in Ex. L. M. A/BS
 "Building completed To copies have been
 within 18 months" party were not filed
 as per Building along with the party of 13 Jm.
 Surveyor's report. 13 Jm. must have been
 On 16-8-26 completed years back
 1923
 24/8 will you please give date of
 completion of this plot?
 B. S. A. M. Ints. C. E.
 Land Manager and Architect,
 Karachi Municipality.
 Please see copy
 on copy in
 of 27. Jm. 1 Jm. 2
 23/8
 24/3

Form No. 37/A—200—24.7.28.

BUILDING COMPLETION REPORT.

LAND MANAGER AND ARCHITECT'S OFFICE,

Karachi, _____ 192 .

To

THE LAND MANAGER AND ARCHITECT,
KARACHI MUNICIPALITY.

SIR,

I beg to report the building work on plot No. 13 Sheet Jm.1

Jamora Quarter owned by Mr. Choithram L.
on 16-8-1926
completed according to the plan approved by the Municipality. Orders are
requested to file the correspondence.

Yours obediently,

Building Surveyor " " Section,
Karachi Municipality.

No. L. M. A. _____ of 1928 .

Karachi, _____ 192 .

Copy to the Assessor & Collector for information.

B. Sc. A. M. Isnt C. E.
Land Manager and Architect.
Karachi Municipality.



Heritage

KMR.CDD.JmQ.1925.02

Form No. 6-200-14-8-25.

No. L. M. A. 110/0 of 1925.

MUNICIPAL OFFICE,

Karachi, 6.11. 1925.

MEMO:

Building Surveyor Section A. is informed
that Mr. Chaitram L. has been permitted
to build
erect a Bungalow his house
on plot No. 13, J. m/l, Street
Jamshed Quarter, report should be made to the
undersigned when house is completed.

Completed.
MD
18/5/22.

Executive Engineer,
Karachi Municipality.


Jm

By Jm.




NGK 2B1


For N

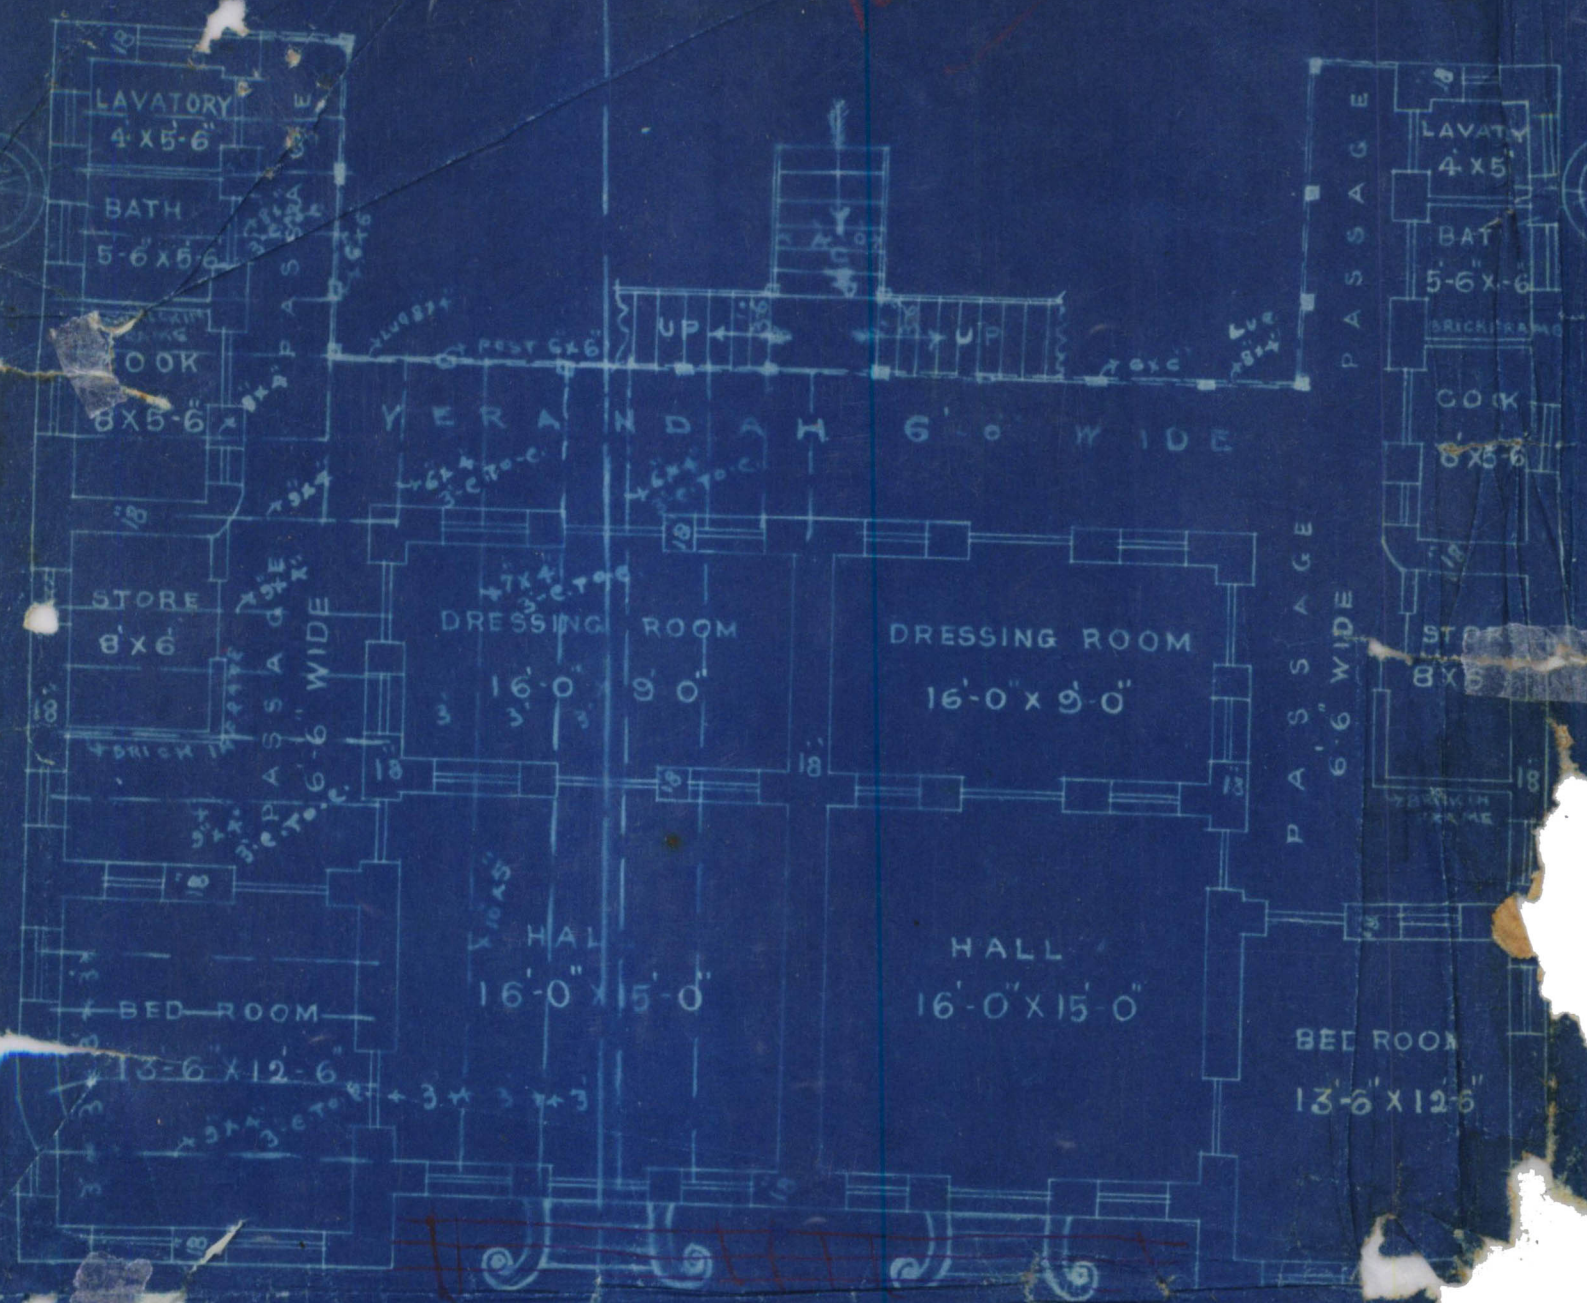


GROUND PLAN

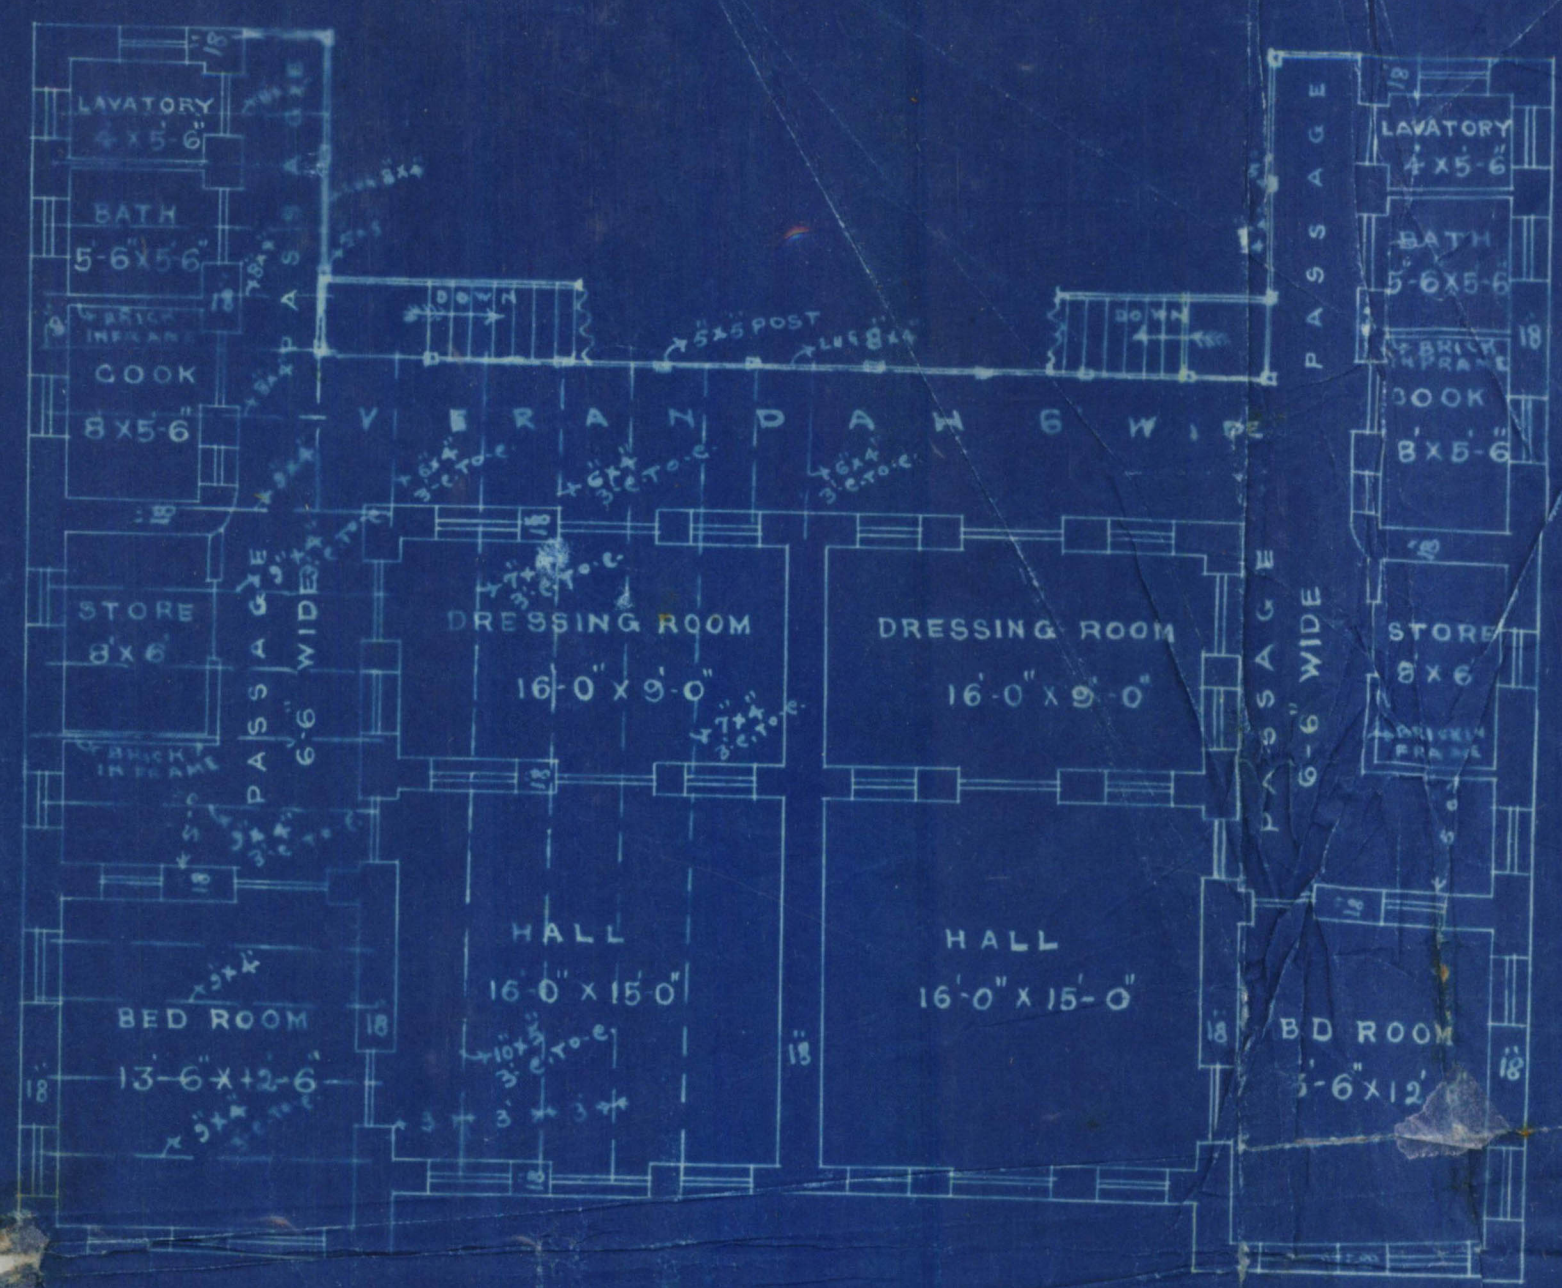

FIRST FLOOR PLAN

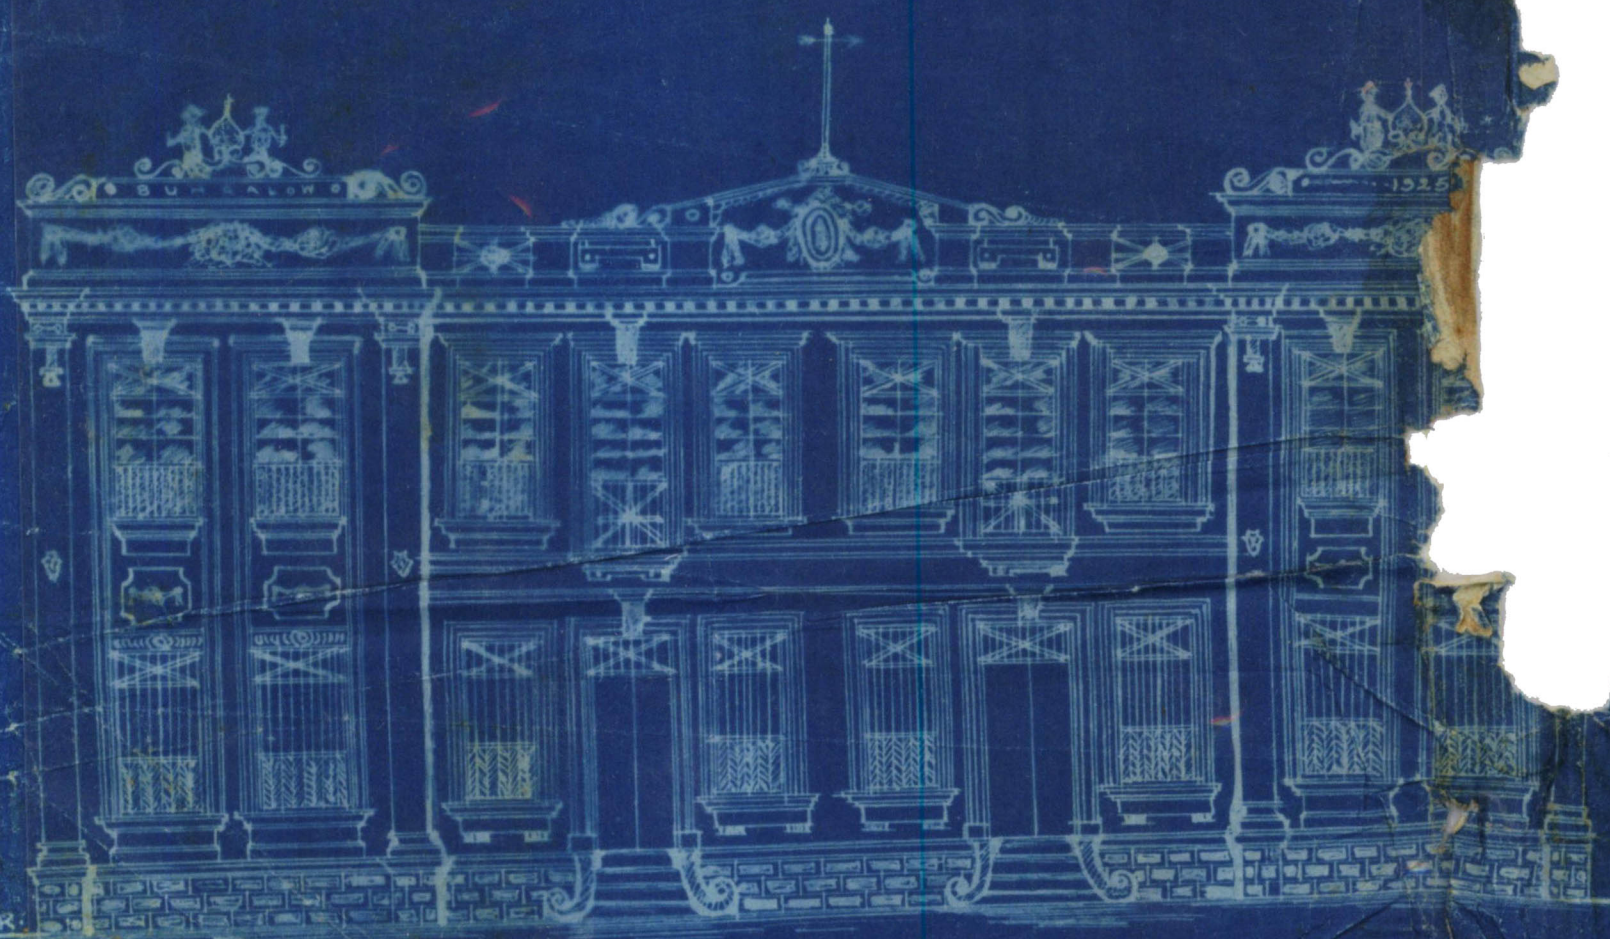

FRONT ELEVATION

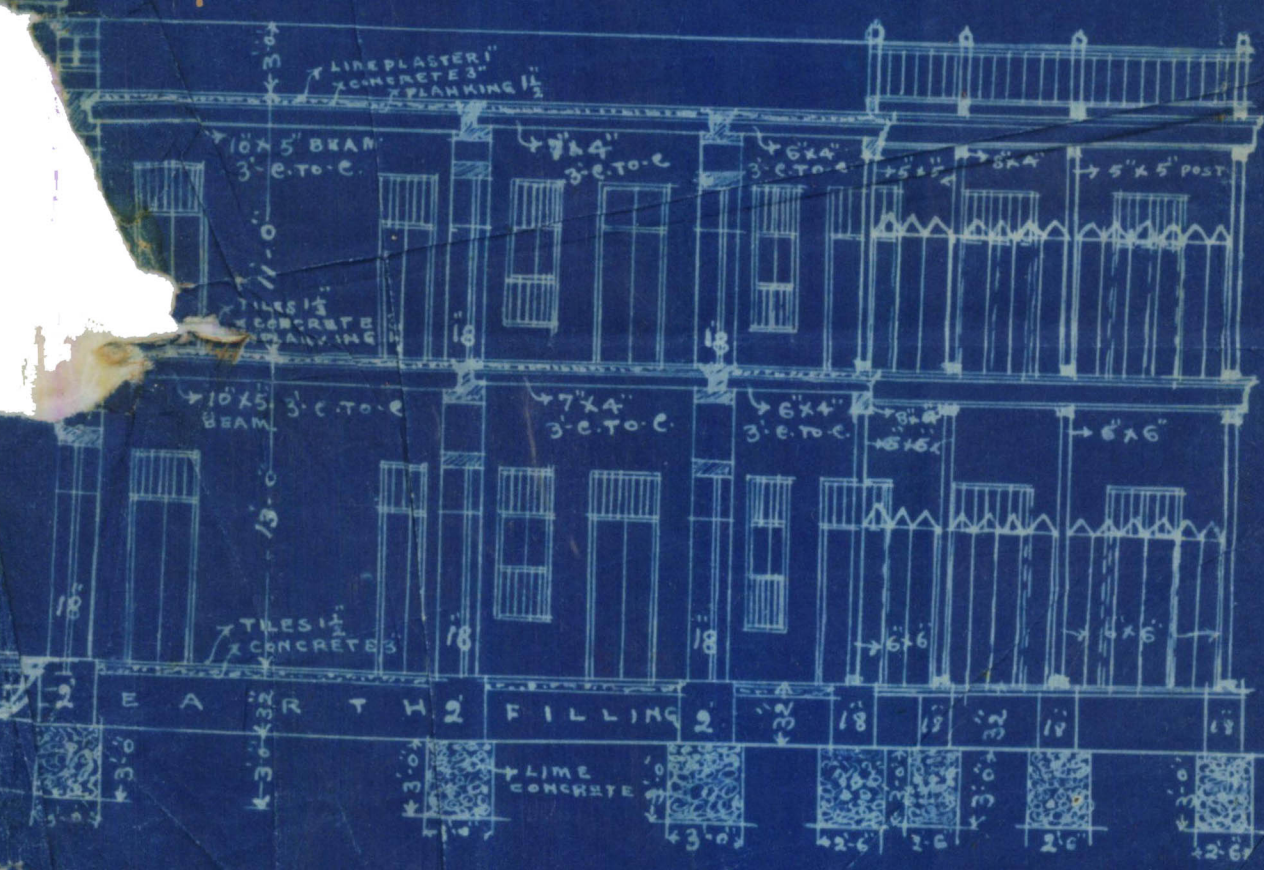


SECTION ON A.B.

PLAN OF PROPOSED BUILDING TO BE
BUILT ON PLOT N^o 13 SHEET N^o J M¹
JAMSHED QUARTER
SCALE 8"=1" INCH

NOTE
TOTAL AREA OF THE PLOT = 944.8 QYDS
BUILDING AREA 314.5 QYDS
OPEN AREA 630.5 QYDS
TOTAL AREA 944.8 QYDS

BLOCK PLAN
SCALE 20"=1" INCH

ROAD 35' WIDE
85'-0"

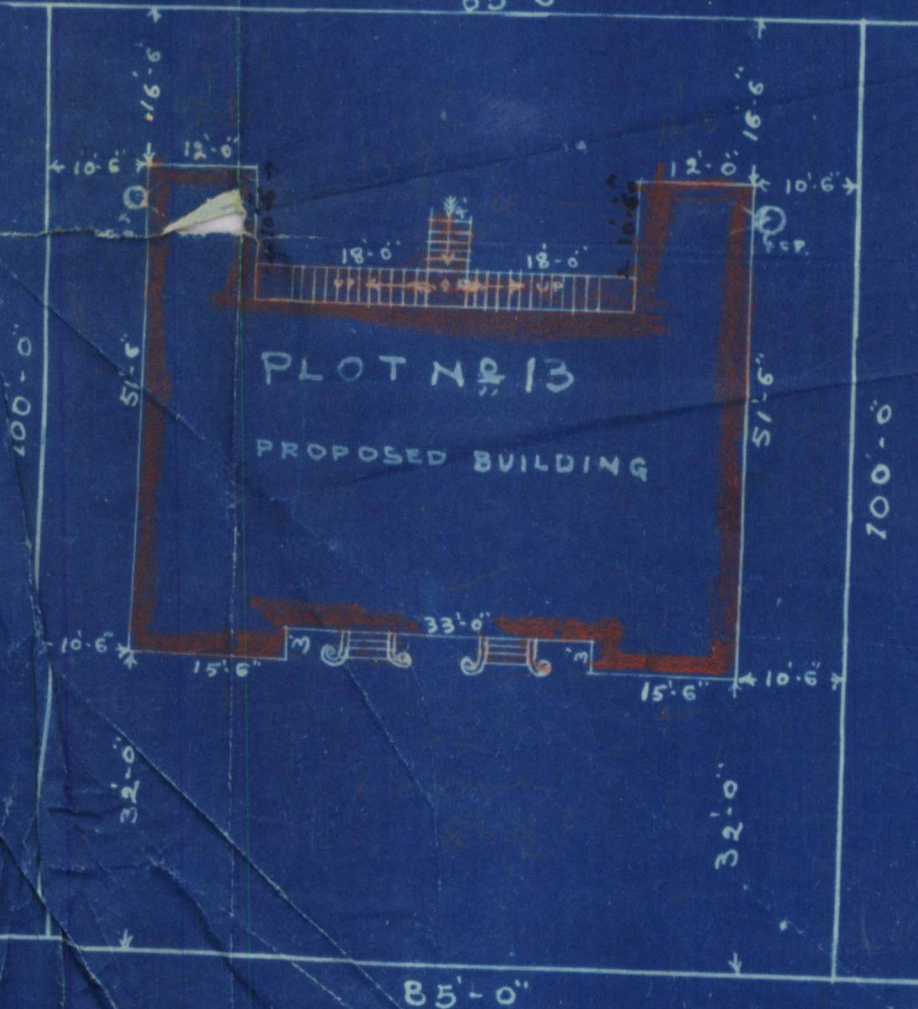

N A L A H

Handwritten signature and date: 1925