

Building Completion Report.

MUNICIPAL OFFICE,

Karachi, 19th April 1921.

To

THE ENGINEER,

KARACHI MUNICIPALITY.


SIR,

I beg to report, the building work on plot No. 25 Sheet 79

Civil Lines Quarter owned by Mr. Tayyab Ali Abdul Hussein
with slight deviations from
is completed according to the plan approved by the Municipality. Orders are
requested to file the correspondence.

1. The Servant ~~Qr.~~ rooms on the 1st floor
have been increased from 7 to 8.
2. out of 2 w.c.s of Louthouse, one is
converted into Bath.


Yours obediently,

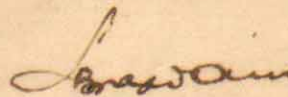Building Surveyor " " Section,
Karachi Municipality.File
19/4P.T.O.
M. V. 19/4

AMENDED PLAN
OF
BUILDING ON PLOT No 25 SHEET F-9
CIVIL LINES QUARTER
SCALE 8 FT = AN INCH

NOTE:-


TOTAL AREA OF THE PLOT	1856 1/2 SQ YDS
1/3 OF THAT WILL BE	619 1/2
PROPOSED MAIN BUILDING AREA	476
OUT HOUSES	131
TOTAL BUILDING AREA	607

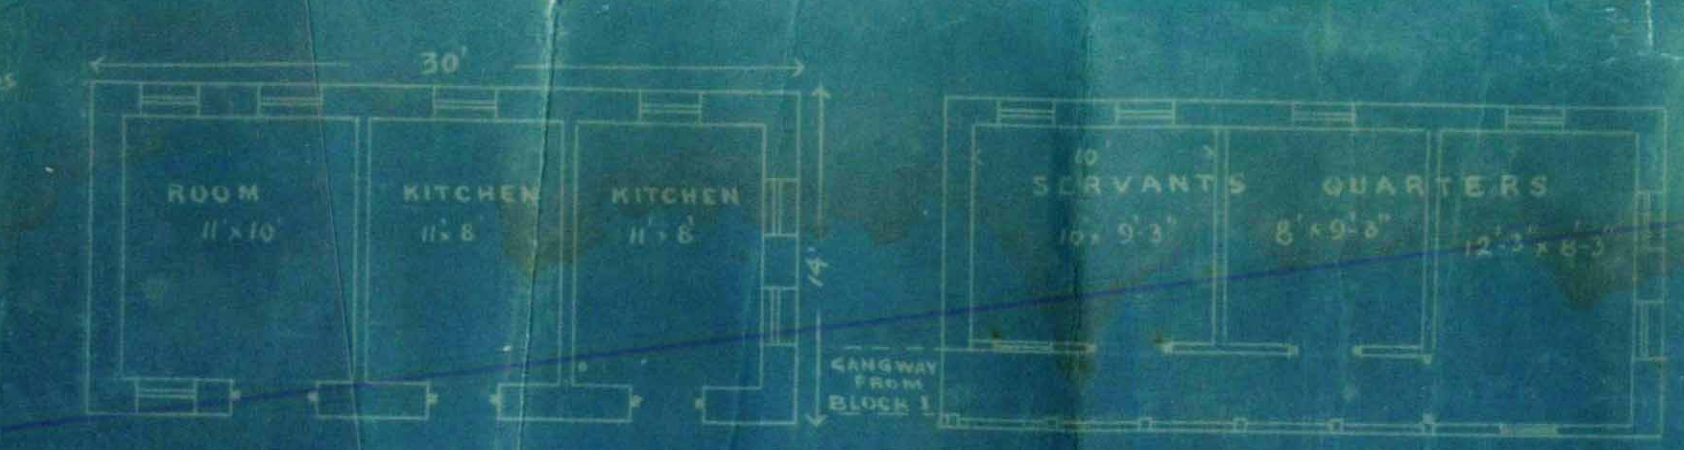


GROUND FLOOR PLAN FOR
OUTHOUSES BLOCK No 2



SECTION ON A B

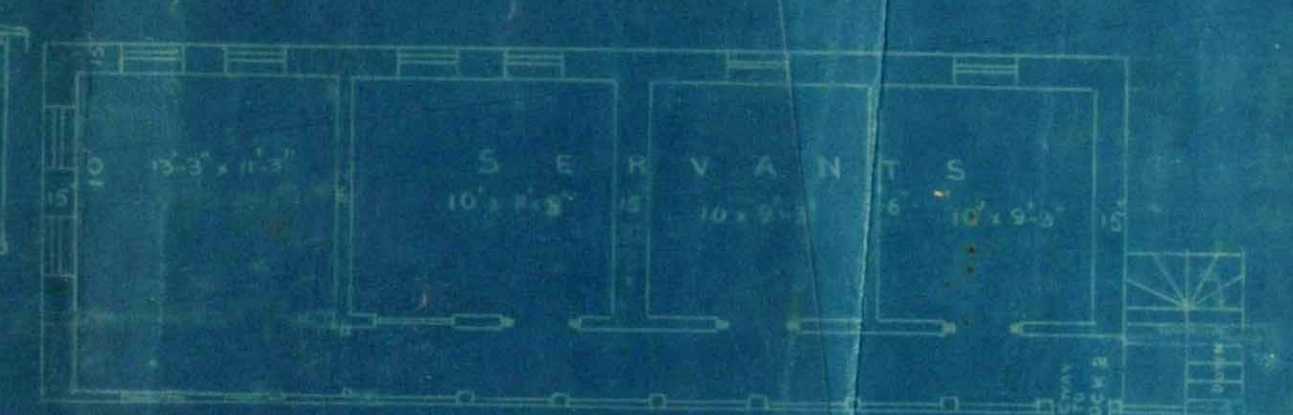

FIRST FLOOR PLAN FOR OUT HOUSES
BLOCK No 1

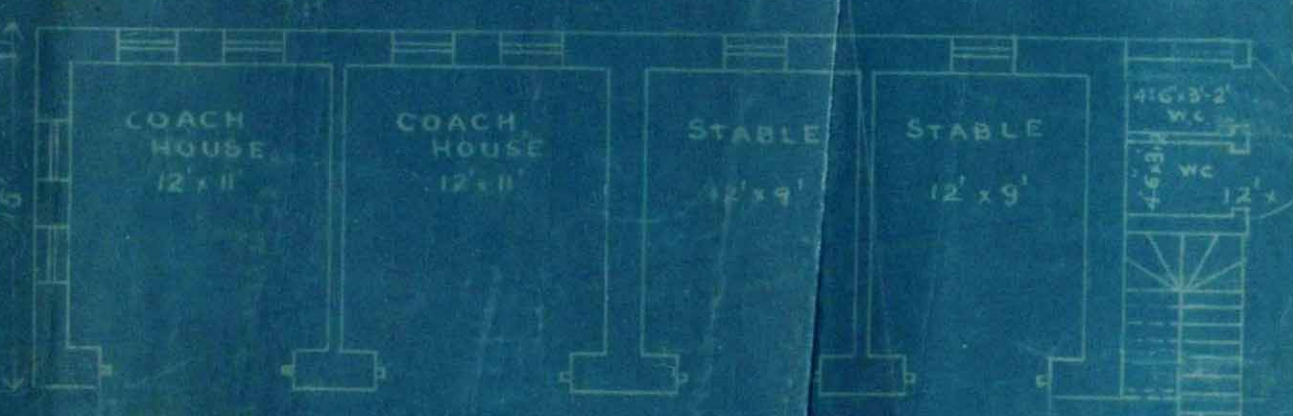


SITE PLAN
GROUND FLOOR PLAN FOR OUT HOUSES
BLOCK No 1
SCALE 20=1



Mohini Kishore
6th July 20
Suzabai...



ELEVATION

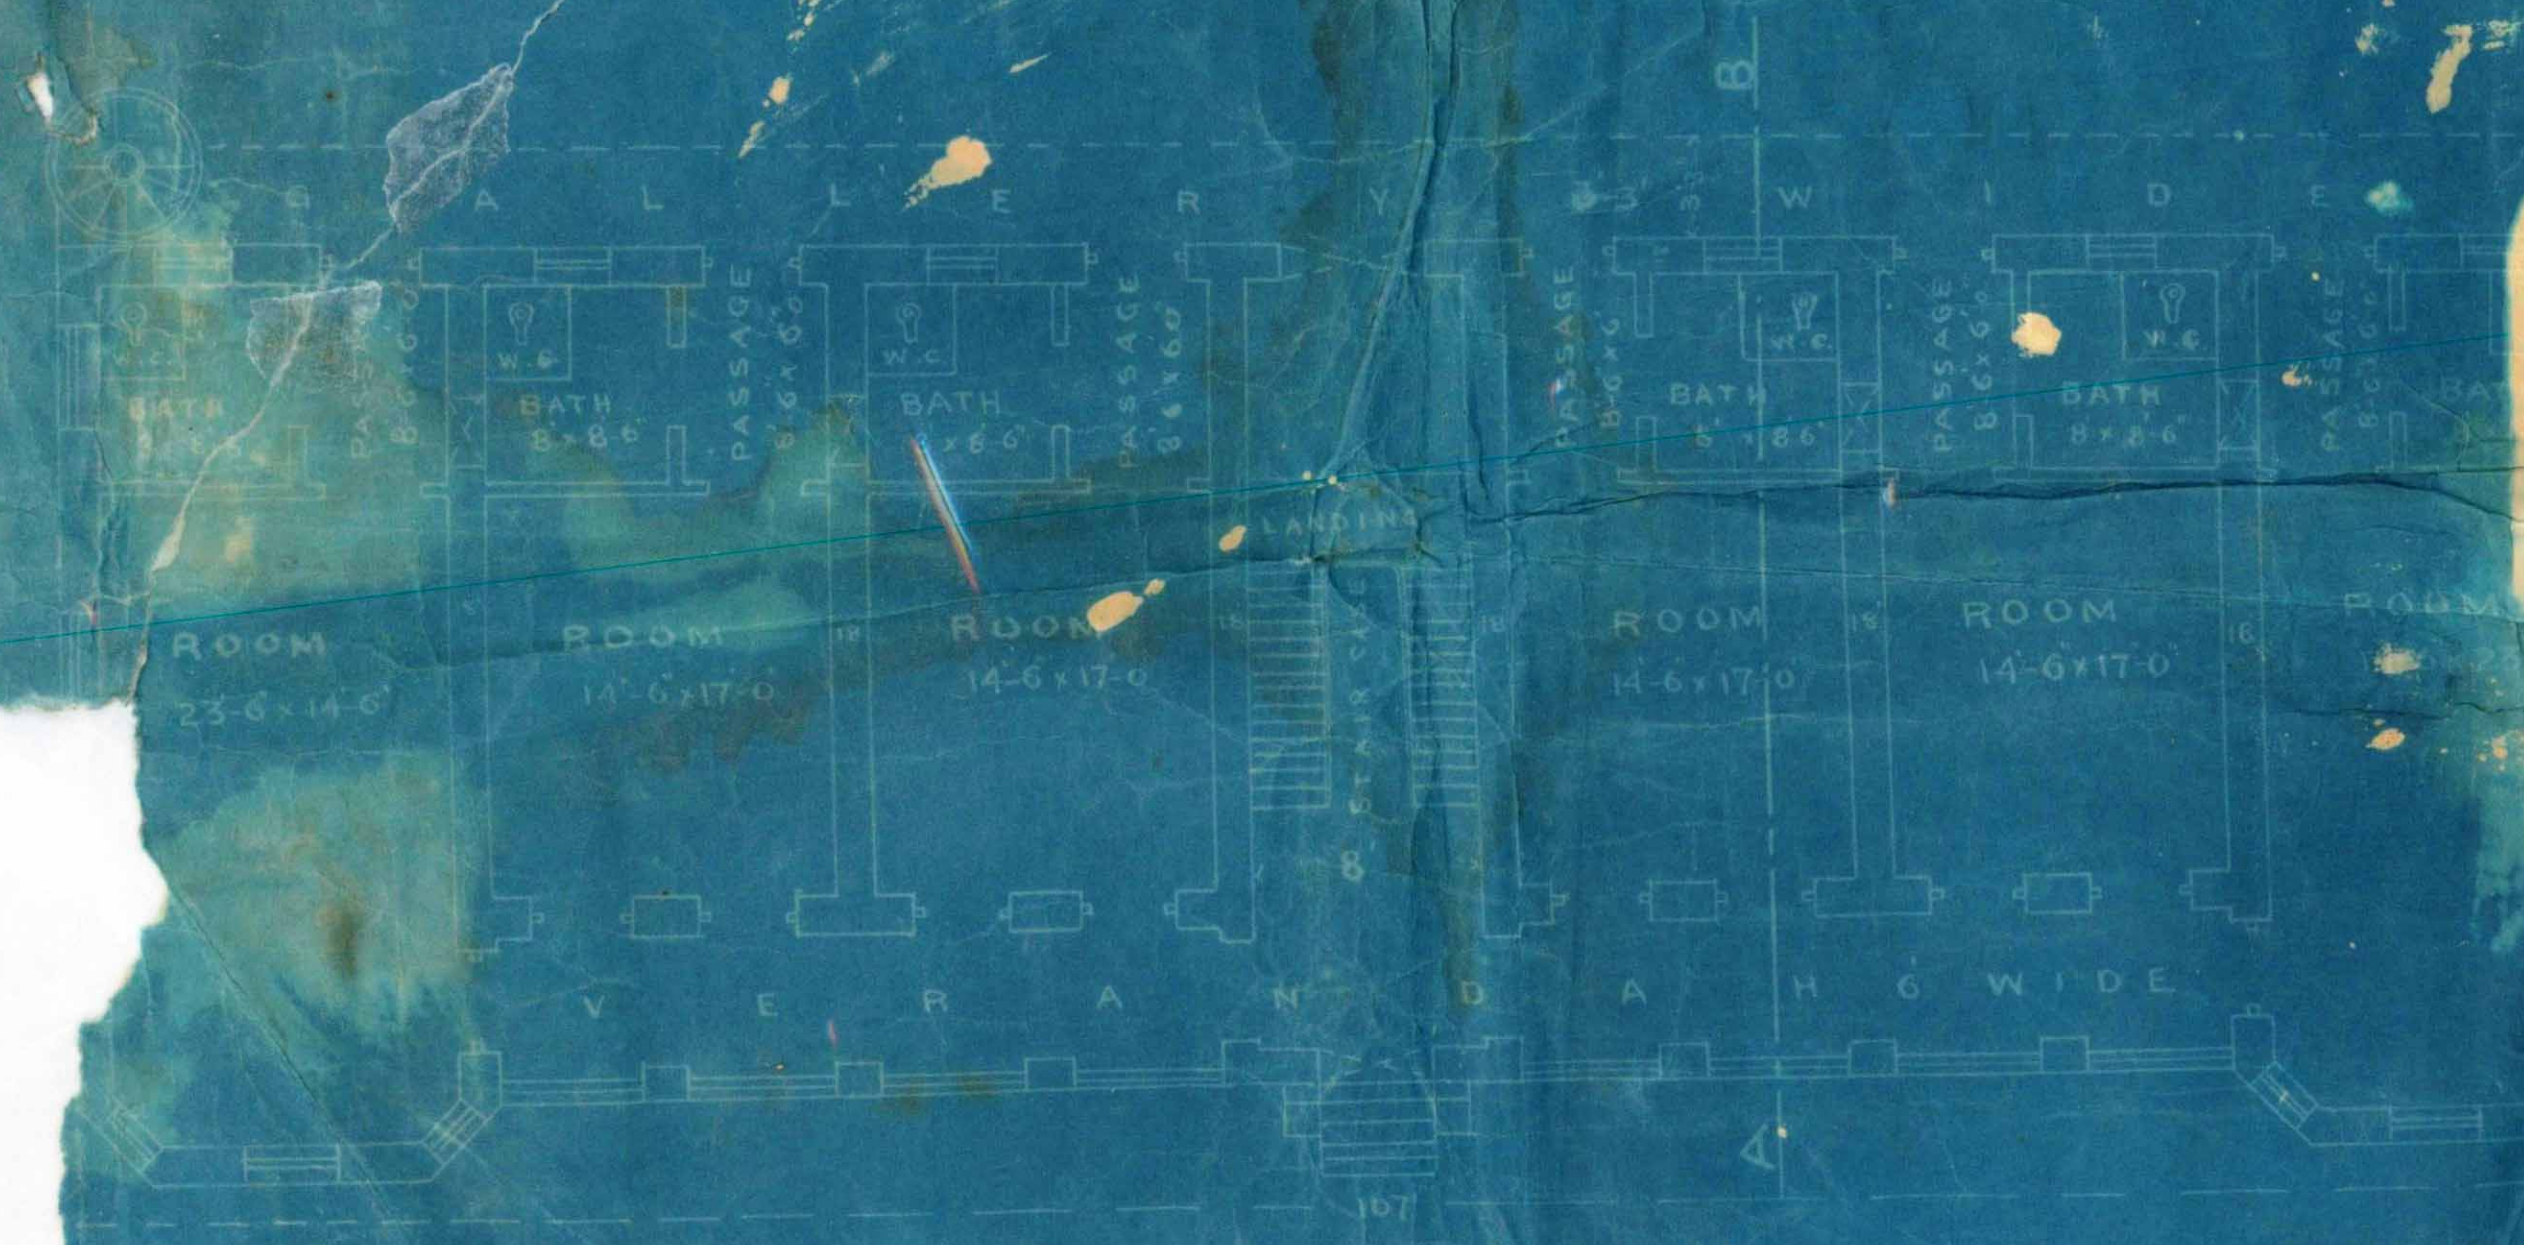

GROUND AND FIRST FLOOR PLAN