

105
KARACHI MUNICIPALITY.

N. J. MODI.

Engineering (London).

INST., C. E., L. C. E.

A. M. I. S. E., M. R. San. I.

Land Manager & Architect.

REFERENCE No. L. M. A. B. S. 4251 of 1929

LAND MANAGER & ARCHITECT'S OFFICE,

KARACHI, 20/7 1929.

From,

THE LAND MANAGER & ARCHITECT,
KARACHI MUNICIPALITY.

To,

Hdharan. Kewalram Esq.

KARACHI.


Sir,

With reference to the Building and Drainage completion certificate dated 16.7 1929, for the newly constructed Building on plot Additions No. F 8 Sheet Jun 3 Quarter, I have the honour to inform you that permission is hereby granted to you to occupy the same. _____ of the Building Additions

I have the honour to be,

Sir,

Your most obedient servant

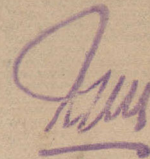NJ B. Sc., A. M. Inst. C. E.,
Land Manager & Architect

17/7/29

BUILDING COMPLETION REPORT.

LAND MANAGER AND ARCHITECT'S OFFICE,

Karachi, _____ 192 .

To
THE LAND MANAGER AND ARCHITECT,
KARACHI MUNICIPALITY.

SIR,

I beg to report that the building work on plot No. E8 Sheet Jan 3
_____ Quarter owned by Mr. Adharan Kewslam.
has been completed according to plans approved by the Municipality. Orders
are requested to file the correspondence.

Yours obediently,

M. P. Talibramani
Building Surveyor "A" Section,
Karachi Municipality.

No. L. M. A/BS 4252 of 1929
Karachi, 2/7 1929.

Copy to the Assessor & Collector for information,



B. SC. A. M. Ints. C. E. 17/29
Land Manager and Architect,
Karachi Municipality.



FORM B.

3

[Vide Rule 238/A (3) (a)]

UNDER BY-LAW NO. 47 (1) UNDER
SECTION 48 (N)*Completion Certificate.*TO BE SUBMITTED BY LICENSED SURVEYOR
BUILDING AND DRAINAGE COMPLETION CERTIFICATE.

I do hereby certify that the following building and drainage work (insert full particulars of the work) with Rubble Stone Masonry work.

R.C.C. Roof. & P.T. Bricks. of Building on Plot No. E/8.
G.M. 3. Jamshed Quartz.

has been supervised by me and has been completed to my satisfaction; that the workmanship and the materials used are good; and that no provision of the Act or the Bye-laws and no requisition made, condition prescribed, or order issued thereunder has been transgressed in the course of the work.

Signed

N.M. Gidani

Dated

16/7/19

Recd: 25.30 P.M.

M. G.

147



4

TELEGRAMS: "DURGWANI"

TELEPHONE NO. 254.

DURGDAS B. ADVANI & Co.

478, BUNDER ROAD,

ARCHITECTS.

Karachi, 16/7 19 27

Approved plan
 attested
 The chief officers
 17/7 Karachi Municipality.

Sir.

I have the pleasure to inform you
 that the works of Building on P.M. No. E/8.
 J.M. 3. Jamsheer Quarters. has been completed.
 I shall thank you to give necessary
 permission to occupy the same.

Competitive certificate of Licensed
 surveyor. of this Building is attached
 herewith with the my kindly be
 discontinued for the date. for Building
 purpose.



TELEGRAMS: "DURGWANI"

TELEPHONE NO. 254.

DURGDAS B. ADVANI & Co.

478, BUNDER ROAD,

ARCHITECTS.

Karachi. _____ 19


yours faithfully

Sham Kewakeh
SecretaryThe Cosmopolitan Coopera-
tive Housing Society Ltd.

NOTE

TOTAL AREA OF PLOTT: 1050 S.Y.S.
BUILT UP AREA = 261.5 "

GROUND FLOOR

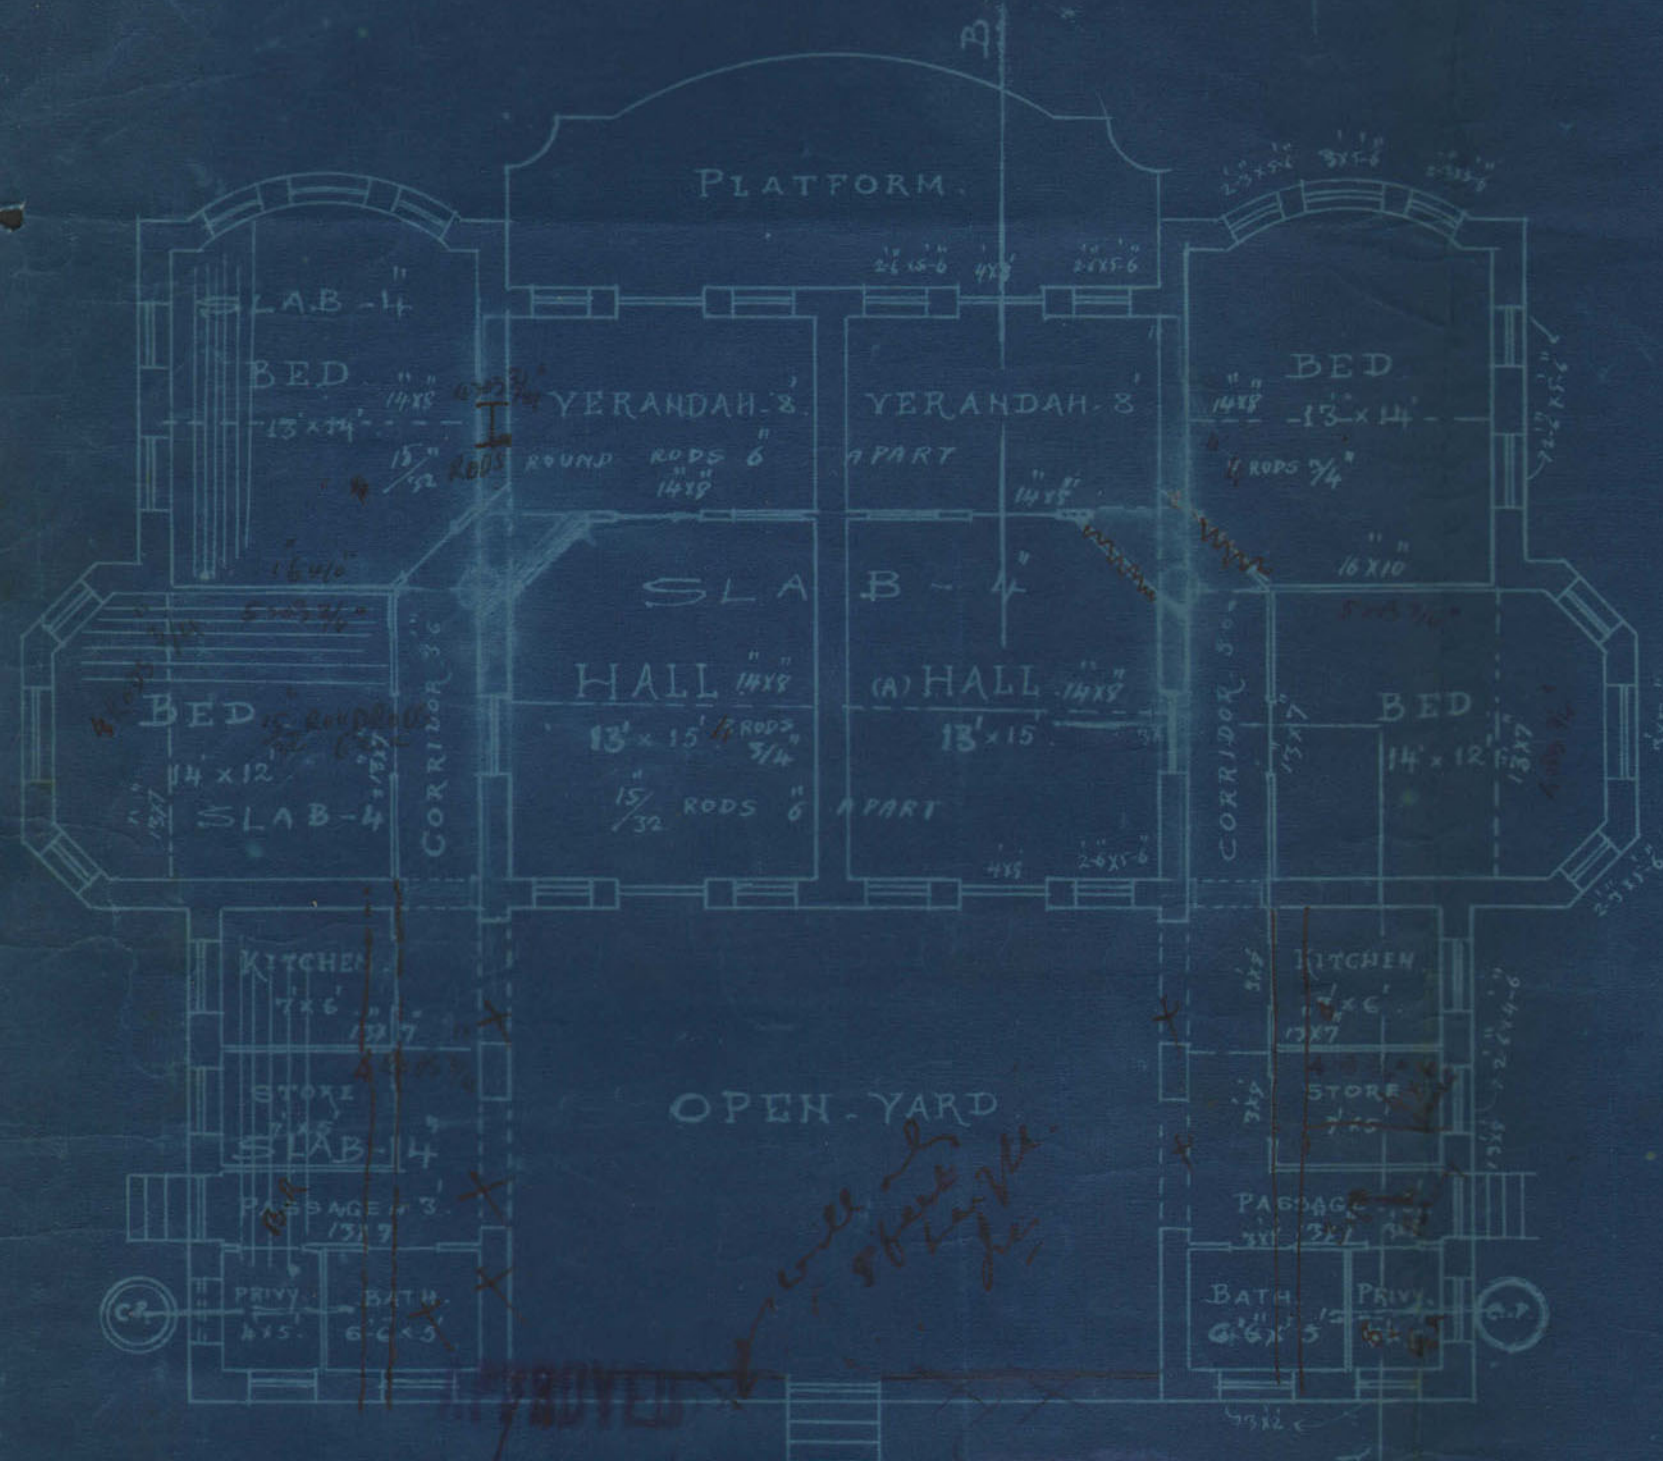

SECTION ON A.B.




LONGITUDINAL SECTION OF T.BEAM A (1/4" x 1/4")



CROSS SECTION OF T.BEAM A (1/4" x 1/4")



SECTION OF COMP. WALL

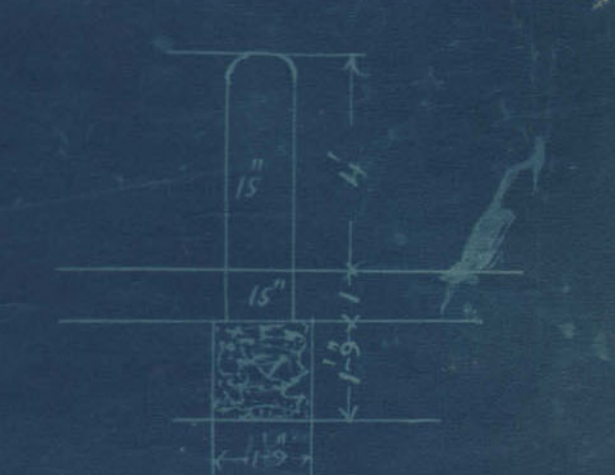

SITE PLAN.

SCALE: 20' = 1"

PLOT No E/3. 105'-0" PLOT No E/4.



PLAN.

SHOWING PROPOSED BUNGALOW

ON PLOT No E/8 SHEET No 2


FOR

"THE COSMOPOLITAN CO-OPERATIVE

HOUSING SOCIETY. LTD."

LEVEL

SCALE: 3' = 1"

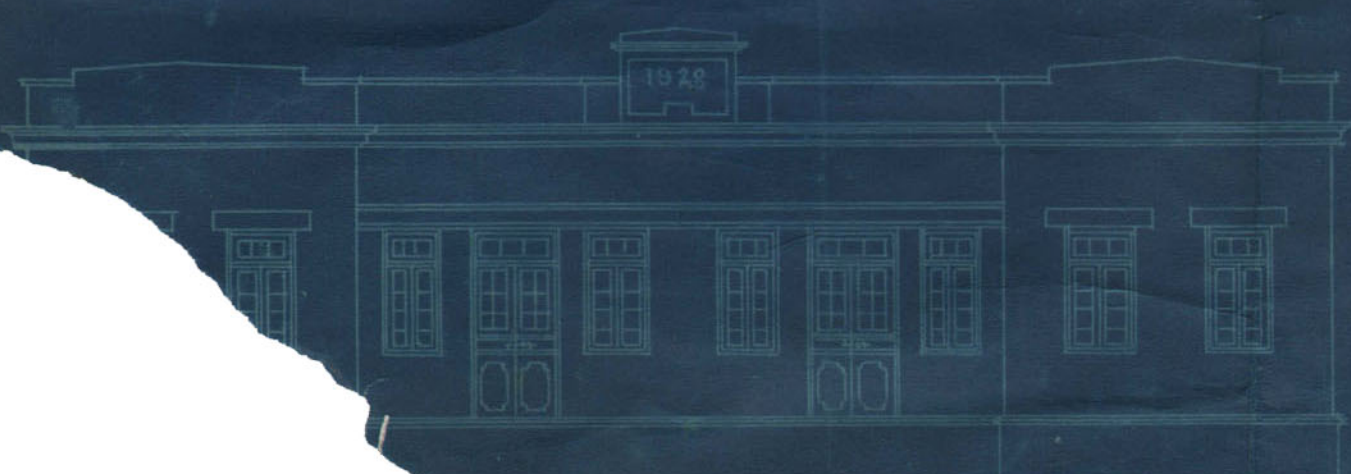

ELEVATION.

35' ROAD

DURGAS B. ADWANI & CO

ARCHITECTS & SURVEYORS

KARACHI. 11.7.28



Form No. 6—300—28-6-27

No. L. M. A. B5/1571 of 192 .

MUNICIPAL OFFICE,

Karachi, 20/3/ 192 7

MEMO:

Building Surveyor Section A is informed
that Mr. Uthman K. H. Say has been permitted
to build C.C.H. S. relief
his house
on plot No. E/8 Bunder Road Bldg Street
Quarter, report should be made to the
undersigned when house is completed.

M. S. T. N.
7/3

Executive Engineer,
Karachi Municipality.

6/3
7/3