



Heritage

KMR.CDD.JmQ.1928-1929.07

B. S. 29-100-4-29.

No. L. M. A.

216
25. 7/6

of 1929.

MUNICIPAL OFFICE,

Karachi,

47

1929

MEMO :

Building Surveyor Section

A'

is informed

that Mr. Wheram Kemabram Nan-See: has been permittedto make additions to

his house

on plot No.

B/6

Jm-3

Street

Jmshed

Quarter, report should be made to the

undersigned when house is completed.

A. J. Modi

Executive Engineer,

Karachi Municipality.

517


cl - please allow
7.c r keep in recordMP
9/29

DURGDAS B. ADVANI & Co.

478, Bunder Road,

ARCHITECTS.

Karachi, 19. 7. 1929

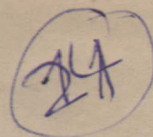

The Land Manager & Architect

Karachi Municipality

Dear sir,

With reference to your No: L.M.A
B.S 4200 dated 18/7/1929, we beg to inform
you that that the amended plan of plot No:
B/6 J.M.3 has been forwarded to you on the
1/7/29.

Yours faithfully

Hulshan Singh

d-7-c
MP
20/29F.C. Advani
Y. 2/7/29Pl. see if you
have recd. the plan.
Y. 2/7/29d- no. write to him to send
MP
23/29Res. on 14.6.29. & passed on
Y. 2/7/29 6.7.29Amended plan
passed on 6.7.29
S. Advani. Y. 2/7/29

24
Rs 4200
18/7/28

From,

The land Manager & Architect,
Karachi Municipality.

To,

M/s Durgdas B. Advani & Co.,
Architect, Karachi.

Sir,

Re:- Plot No. B/6, J.M/3, Jamshed Cr.,

With reference to your completion certificate dated 26-6-29, in respect of building on the above plot I have the honour to request you to please send amended plans for slight deviations made from the approved plan, when permission to occupy the building will be granted to you.

I have the honour to be,

Sir,

Your most obedient servant,

 B.Sc., A.M.Inst. C.E., 15²⁹
LAND MANAGER & ARCHTTECT.

Mrs. Surges & Associates,
Architects, Karachi.

Gentlemen,

Re: plot no. 8/b. Jm. 3, Jamshedpur

With ref. to your completion Certificate
D. 26.6.47 in respect of building on the
above plot. I have the honour to request
you to please send amended plans for slight
alterations made from the approved plan, when
permission to occupy the building will be
granted by you.

I remain,

Yours truly,
11/7

FORM B.

[Vide Rule 238/A (3) (a)]

UNDER BY-LAW NO. 47 (1) UNDER
SECTION 48 (N)

Completion Certificate.

TO BE SUBMITTED BY LICENSED SURVEYOR
BUILDING AND DRAINAGE COMPLETION CERTIFICATE.

I do hereby certify that the following building and drainage work (insert
full particulars of the work) Rubble stone masonry walls, R.C.C
roof and P.Teak doors & windows of building on plot No:
B/6 - J.M.3 Jamshed Quarter

has been supervised by me and has been completed to my satisfaction; that
the workmanship and the materials used are good; and that no provision of the
Act or the Bye-laws and no requisition made, condition prescribed, or order
issued thereunder has been transgressed in the course of the work.

Signed

N.M. Jivani
Dated 26/6/47

Recd. on 4/7/47

*Amended plans
are not returned by
me. 10/7*

10/7

*See the house is built
It is reported that
Amended plans
are sent for
signature*

5-2

cl. Pl Keep this with you
 & send it when amended
 Plans ~~can~~ are received

$\frac{m}{11\frac{7}{29}}$

Roof and F. Teak doors & windows of building on plot No:
 1.1.3 Jambhed Quarter

Handwritten notes:
 1.1.3 Jambhed Quarter
 Roof and F. Teak doors & windows of building on plot No:
 1.1.3 Jambhed Quarter

Handwritten notes:
 1.1.3 Jambhed Quarter
 Roof and F. Teak doors & windows of building on plot No:
 1.1.3 Jambhed Quarter

B.S. 18

200-3-29.

BUILDING COMPLETION REPORT.

LAND MANAGER AND ARCHITECT'S OFFICE,

Karachi, _____ 192

To

THE LAND MANAGER AND ARCHITECT,

KARACHI MUNICIPALITY.

SIR,

I beg to report that the building work on plot No. B/6 Sheet Jan 3.Jamshed Quarter owned by Mr. Usharans Kewaram.

has been completed according to plans approved by the Municipality. Orders are requested to file the correspondence.

Yours obediently,

*M. O. Jagtiani*Building Surveyor "A" Section,
Karachi Municipality

No. L. M. A. _____ of 192 .

Karachi, _____ 192 .

Copy to the Assessor & Collector for information

B.Sc. A. M. Ints. C. E.
Land Manager and Architect.
Karachi Municipality.

Form No. 6—300—28-6-27

No. L. M. A.

15086 of 1928.


MUNICIPAL OFFICE,

Karachi,

37/12 1928

MEMO:

Building Surveyor Section 'A' is informed
that Mr. Hoharam Kewalram Honey Leey has been permitted
to build a house in the Cosmopolitan Cooperative
Honey Leey Ltd. Jamshed his house
on plot No. B/6 J m 2 Street
Jamshed Quarter, report should be made to the
undersigned when house is completed.

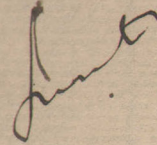
Executive Engineer,
Karachi Municipality.



107

BUILDING COMPLETION REPORT.

25

LAND MANAGER AND ARCHITECT'S OFFICE,

Karachi, 26.7 1929.

To

THE LAND MANAGER AND ARCHITECT,
KARACHI MUNICIPALITY.

SIR,

I beg to report that the building work on plot No. B6 Sheet 3
Quarter owned by Mr. Adharam Kewelram
has been completed according to plans approved by the Municipality. Orders
are requested to file the correspondence.

Yours obediently,


*M. P. Talibramani*Building Surveyor "A" Section,
Karachi Municipality.No. L. M. A/BS 4447 of 1929
Karachi, 3/8 1929.

Copy to the Assessor & Collector for information,


*31/7/29*B. SC. A. M. Ints. C. E.
Land Manager and Architect,
Karachi Municipality.

TOTAL AREA OF PLOT 1000 Sq.Yds
BUILT AREA 104 Sq.Yds


GROUND FLOOR

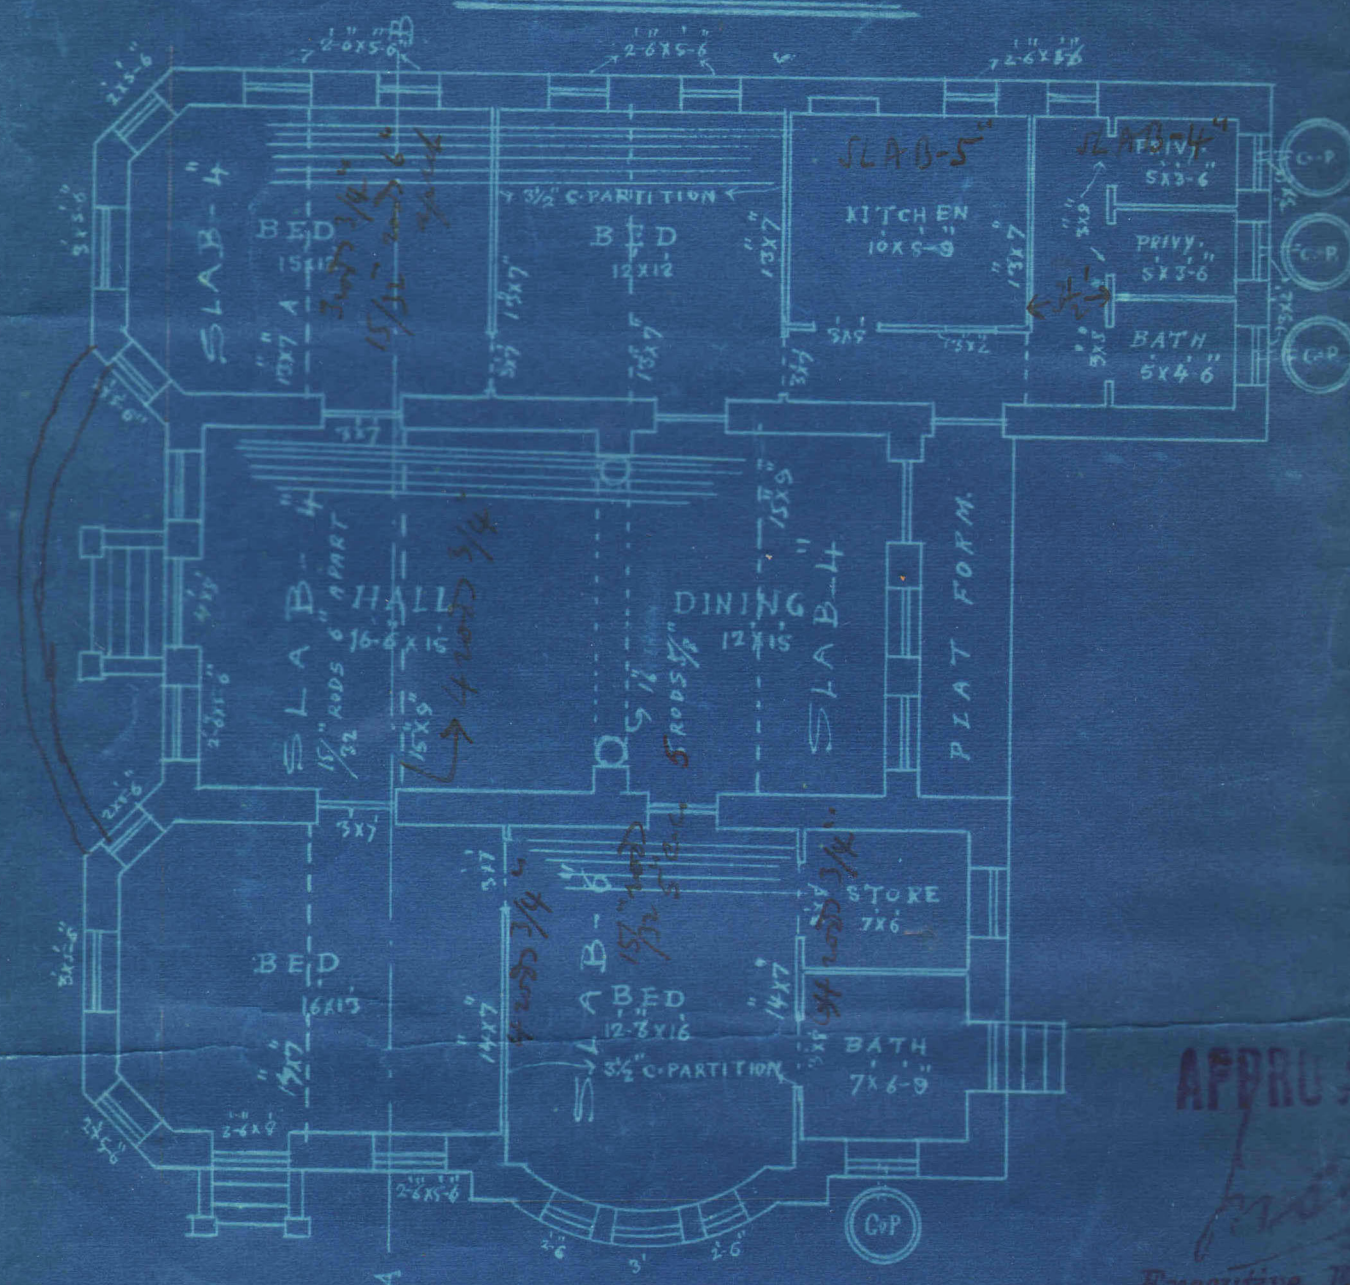


SECTION ON A-B

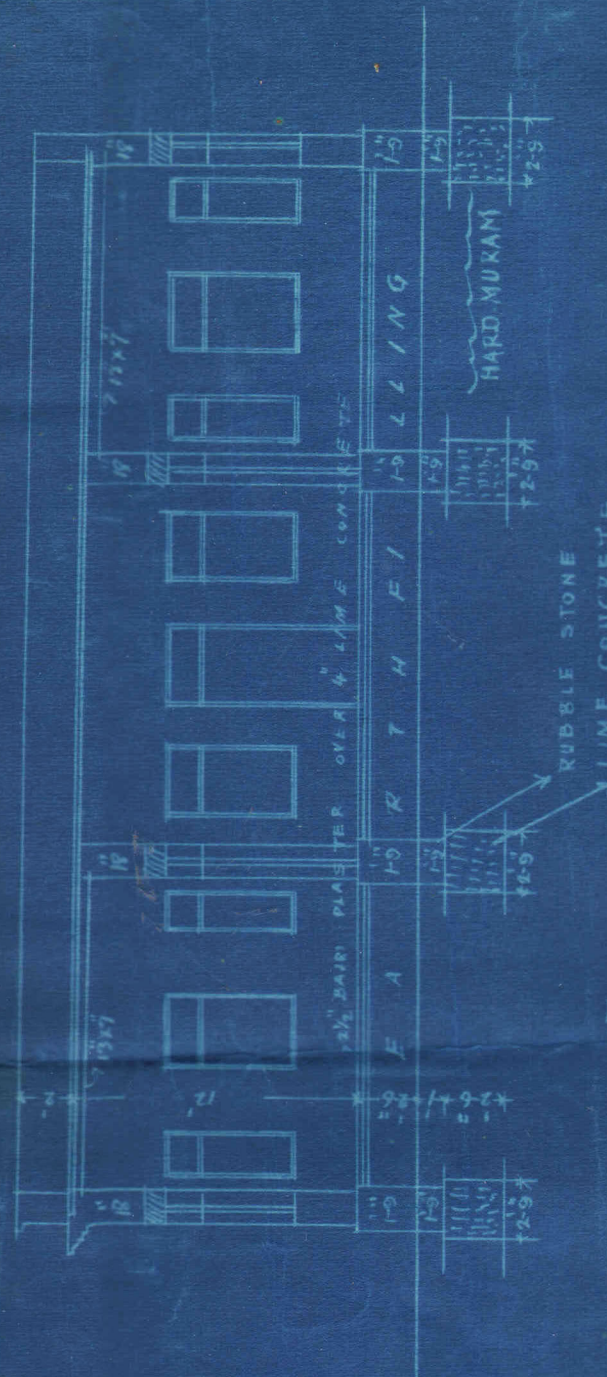


LONGITUDINAL SECTION OF T BEAM A (13'x7')

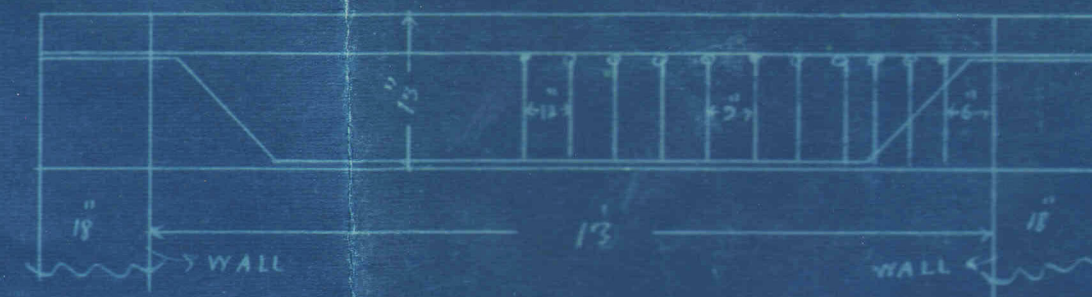

CROSS SECTION OF T BEAM A (13'x7')

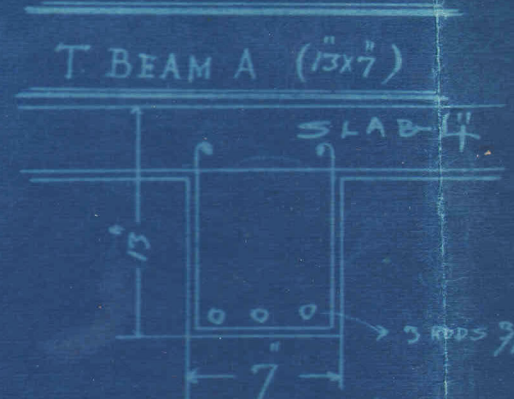

SECTION OF COMP WALL

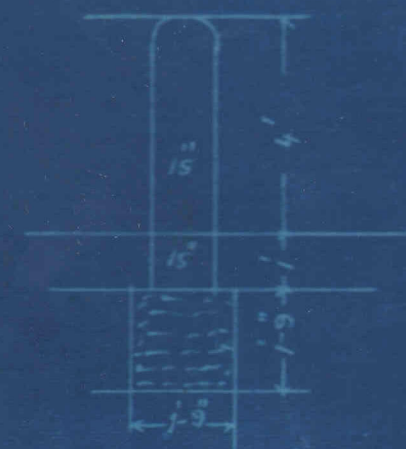


BLOCK PLAN

SCALE 20'=1'



ELEVATION

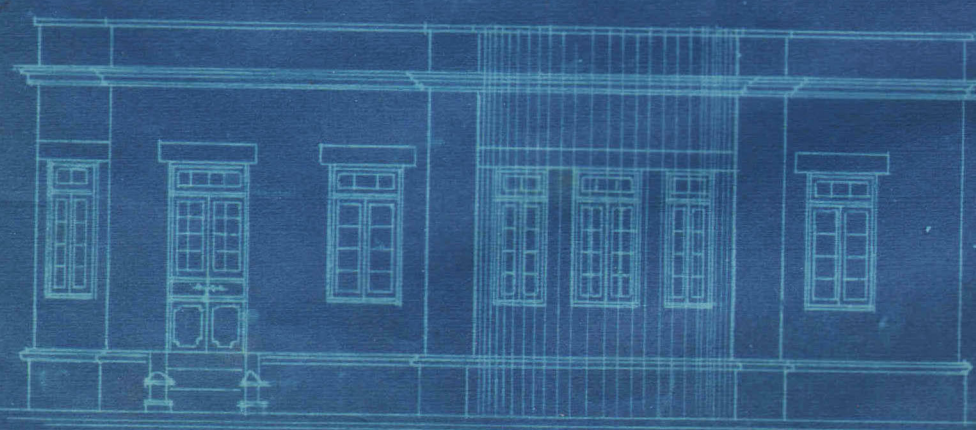

APPROVED
[Signature]
Executive Engineer,
Karachi Municipality

PLAN

SHOWING PROPOSED BUNGALOW

ON PLOT N° B/7 SHEET N° 2.2.2

FOR

"THE COSMOPOLITAN CO-OPERATIVE

HOUSING SOCIETY LTD.

SCALE 8'=1'

[Signature]
DURGAS B ADWANI & CO
ARCHITECTS & SURVEYORS
KARACHI