

108
26
BUILDING COMPLETION REPORT.

LAND MANAGER AND ARCHITECT'S OFFICE,

Karachi, 26.7 1929.

To

THE LAND MANAGER AND ARCHITECT,

KARACHI MUNICIPALITY.

SIR,

I beg to report that the building work on plot No. A/12 Sheet 3Quarter owned by Mr. Adharan Kumbharan.

has been completed according to plans approved by the Municipality. Orders are requested to file the correspondence.

Yours obediently,

*M. P. Talibramani*Building Surveyor "A" Section,
Karachi Municipality.No. L. M. A/BS 4446 of 1929Karachi, 3/8 1929.

Copy to the Assessor & Collector for information,

*31/5/29*B. SC. A. M. Ints. C. E.
Land Manager and Architect,
Karachi Municipality.



B.S. 18

200-3-29.

BUILDING COMPLETION REPORT.

LAND MANAGER AND ARCHITECT'S OFFICE,

Karachi, _____ 192

To

THE LAND MANAGER AND ARCHITECT,

KARACHI MUNICIPALITY.

SIR,

I beg to report that the building work on plot No. A/10 Sheet Jm 3.Jamshed Quarter owned by Mr. V. Bhawan Kewalam.

has been completed according to plans approved by the Municipality. Orders are requested to file the correspondence.

Yours obediently,

Building Surveyor "A" Section,
Karachi Municipality

No. L. M. A. _____ of 192

Karachi, _____ 192

Copy to the Assessor & Collector for information

Out house not.

Guilt 11/6/29

CP. A. K. K. D. D. D.
to make necessary
connections, as the
out houses are not
yet built. 11/6/29B. Sc. A. M. Ints. C. E.
Land Manager and Architect.
Karachi Municipality.


DURGDAS B. ADVANI & Co.

478, Bunder Road,

ARCHITECTS.

Karachi, 17. 7. 1929

To

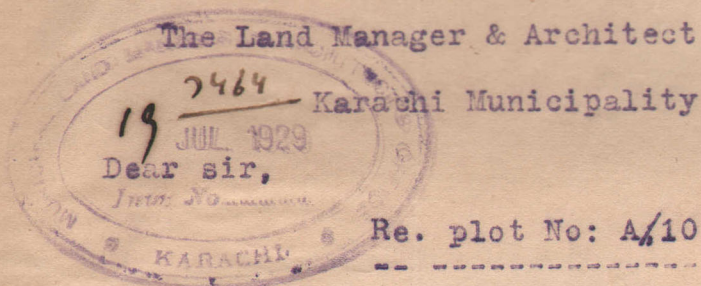

Re. plot No: A/10 J.M.3

d.f.c

With reference to your No: L.M.A/B.S 4133 of 15/7/29, to the address of the H.Secretary C.C.Housing Society, we have the honour to inform you that the outhouses are to be built. The completion certificate sent by us related to the main bungalow which is a separate structure. We shall thank you to give your formal permission.

Yours faithfully

*Mulh an d. f. c.*DURGDAS B. ADVANI & CO
KARACHI*MP
20/7/29**B.S.
me**20/7/29**H.C. albert**CH
20/7*



Bs: 4133

15/7/29

From,

The Land Manager & Architect,

Karachi Municipality

To,

The Honorary Secretary,
The Cosmopolitan Co-operative
Housing Society Ltd., Karachi.

Sir,

Re:-Plot No.A/10, J.M/3, Jamshed or

With reference to completion certificate dated 26/6/29 received from your architect in respect of the building on the above plot, I have the honour to inform you that as the outhouses are not built, amended plans requires to be submitted by you.

You are therefore requested to submit an amended plan, when permission to occupy the building will be granted to you.

I have the honour to be

Sir,

Your most obedient servant

B.Sc., A.M. Inst. C.E.,

LAND MANAGER & ARCHITECT

10/2/29

5-1

To

The Hon. Secy,

Cosmopolitan cooperative H.S. Ltd,
Karachi

Sir,

Re: plot no. A/10, M. 3. Jannat.

With ref. to Completion Certificate of 1928
recd. from your Architects, in respect of the building
on Malcom plot, I have the honour to inform you
that ^{as} the outhouses ^{are} ~~have not yet been~~ built, ~~and~~
amended plans require to be submitted by you.

You are therefore requested to submit an
amended plan, when permission to occupy the
building will be granted by you.

I have etc.

Sd/- 97
in

5-2

200—20-9-28.

KARACHI MUNICIPALITY.

N. J. MODI.

B. Sc., Engineering (London)

A. M. INST., C. E., L. C. E.

A. M. I. S. E., M. R. San. I.

Land Manager & Architect.

REFERENCE No. L. M. A.

OF 192

LAND MANAGER & ARCHITECT'S OFFICE,

KARACHI, 192

MEMO.—

With reference to the Building and Drainage completion certificate dated _____ 192 , for the newly constructed Building Additions on plot No. _____ sheet _____ Quarter, Mr Messrs. _____ is informed that permission is hereby granted to _____ of _____ occupy _____ of _____ the Building Additions

B. Sc., A. M. I. C. E.,

Land Manager & Architect.

400-6-28.

FORM B.

6

[Vide Rule 238/A (3) (a)]

UNDER BY-LAW NO. 47 (1) UNDER
SECTION 48 (N)*Completion Certificate.*TO BE SUBMITTED BY LICENSED SURVEYOR
BUILDING AND DRAINAGE COMPLETION CERTIFICATE.

I do hereby certify that the following building and drainage work (insert full particulars of the work) _____

Rubble stone masonry walls, R.C.C

roof and P. Teak doors & windows of building on plot No:

^{A/10} has been supervised by me and has been completed to my satisfaction; that the workmanship and the materials used are good; and that no provision of the Act or the Bye-laws and no requisition made, condition prescribed, or order issued thereunder has been transgressed in the course of the work.

Signed

N. M. J. G. Vani

Dated

26/6/4

Recd. on 4/7/29
M

57
No. L. M. A. BS/1614 of 192 .

MUNICIPAL OFFICE,


Karachi, 22/3/ 1928.

MEMO :

Building Surveyor Section 'A' is informed
that Mr. Redharam Kemalram has been permitted
to levies
_____ his house
on plot No. 4107, Jm. 3, _____ Street
Jamshedi Quarter, report should be made to the
undersigned when house is completed

Insetna
Executive Engineer,
Karachi Municipality.

GROUND FLOOR.

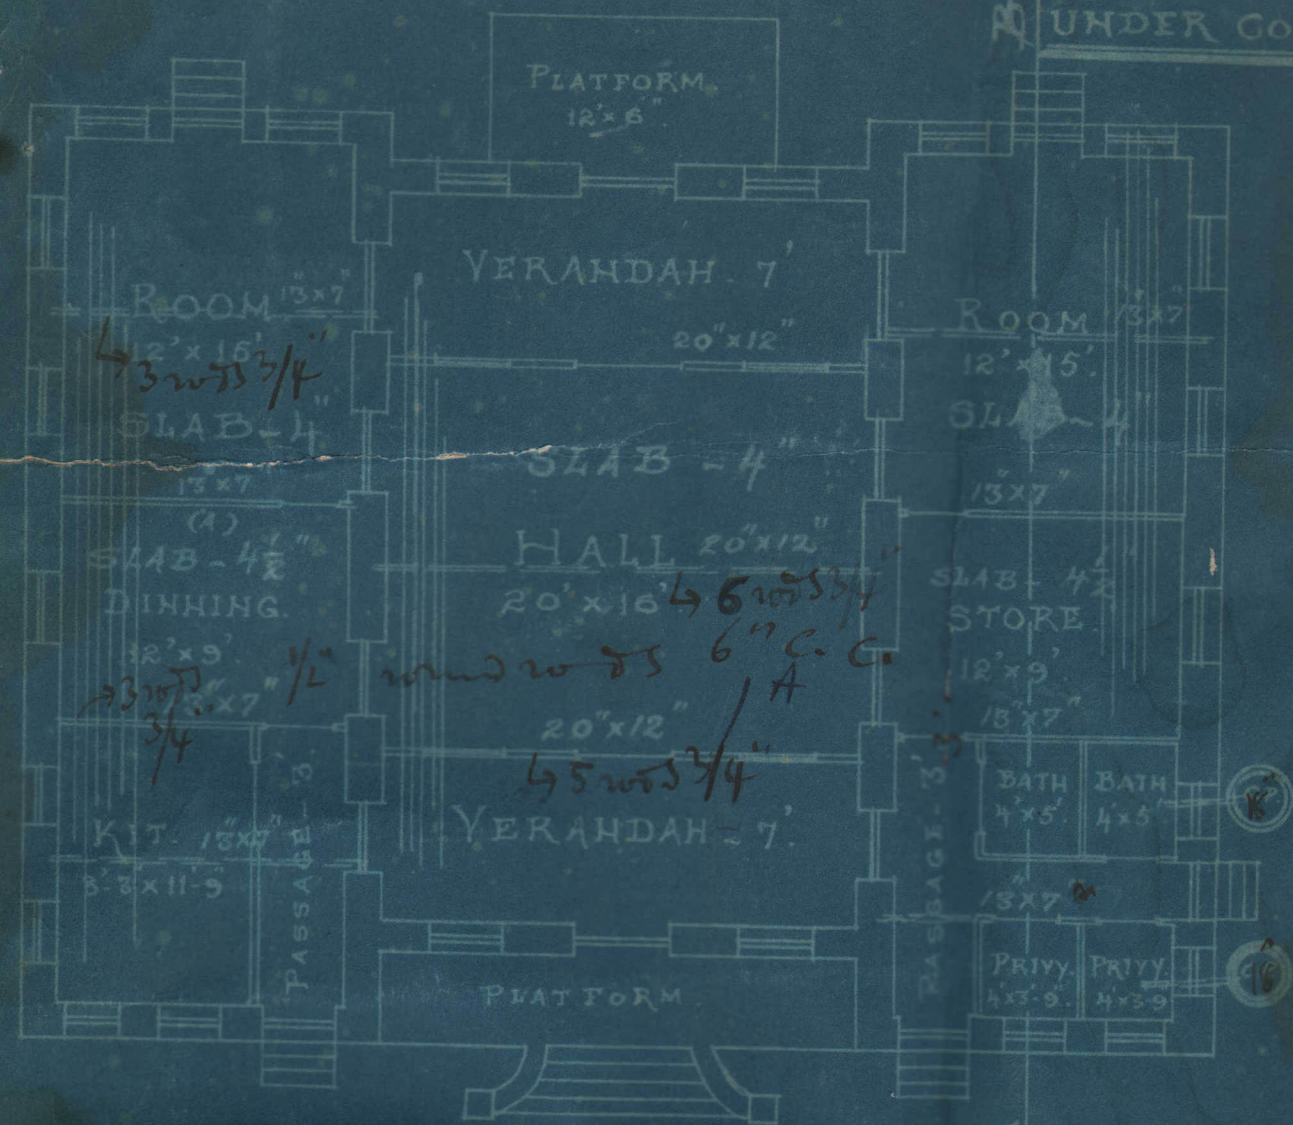


NOTE:
TOTAL AREA OF PLOT: 1000 SQ YDS
UNDER CONSTRUCTION: 250


SECTION ON A.B.




GROUND FLOOR.

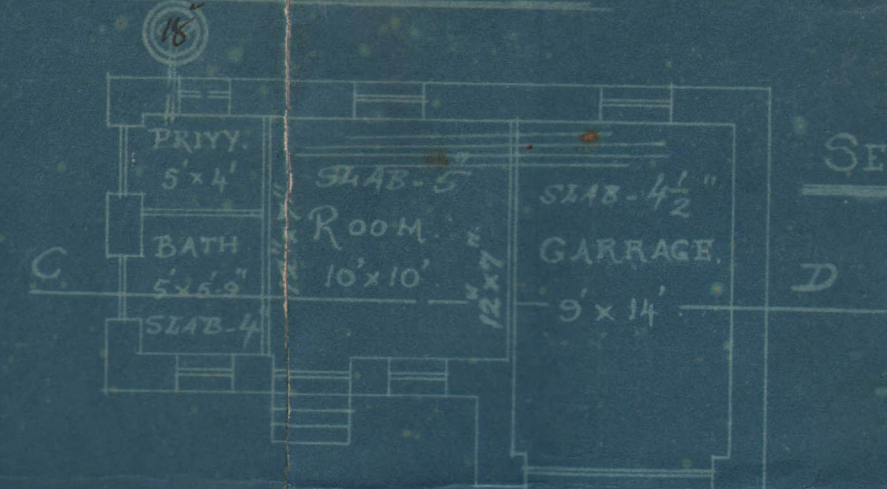


SECTION OF COMP

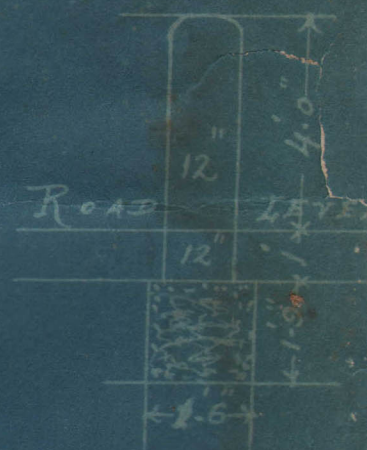

SECTION ON C.D.

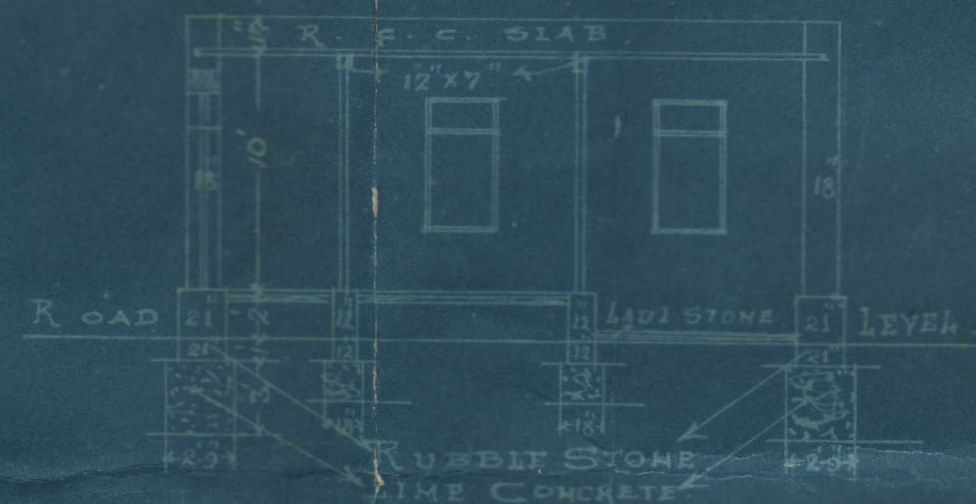

ELEVATION.

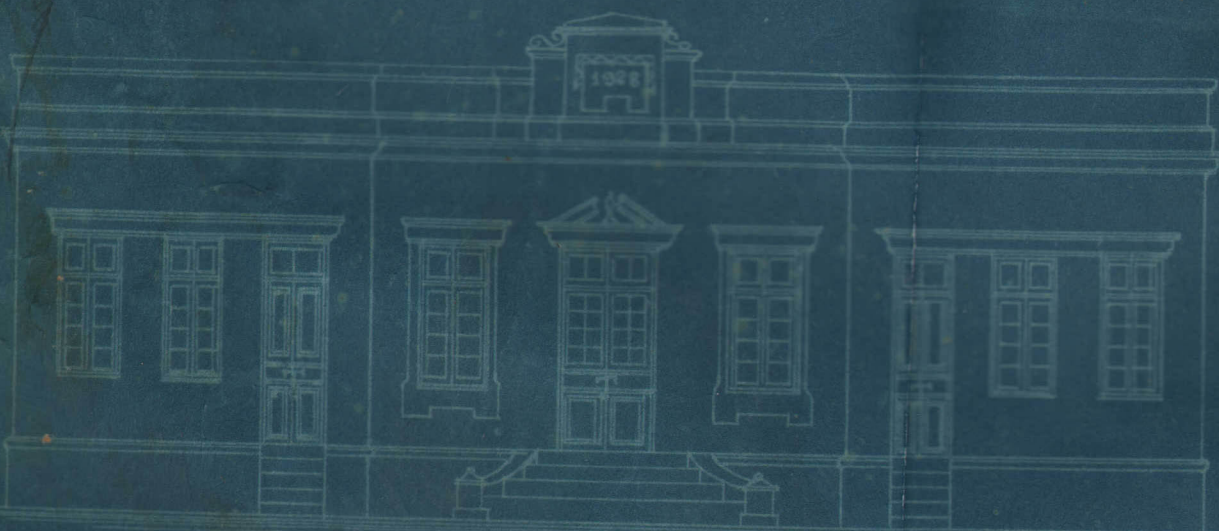

PLAN

SHOWING PROPOSED BUNGALOW
ON PLOT NO A/10 SHEET NO

FOR

"THE COSMOPOLITAN CO-OPERATIVE
HOUSING SOCIETY. LTD."

LEVEL.

SCALE: 8"=1"

BLOCK PLAN.

SCALE: 20"=1"


PLOT NO A/4

PLOT NO A/5




ROAD 35' WIDE

LONGITUDINAL SECTION OF T.BEAM A (13'x7')

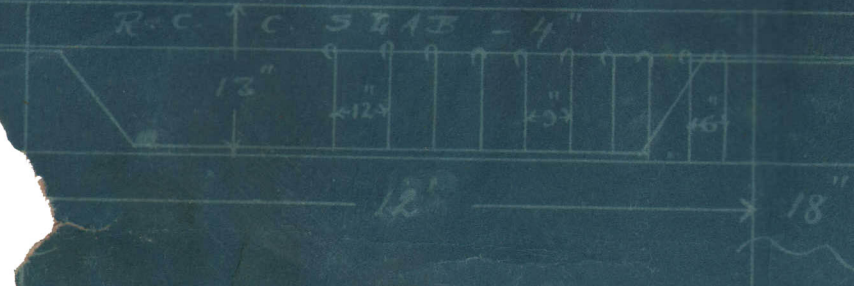

CROSS SECTION OF T.BEAM A (13'x7')

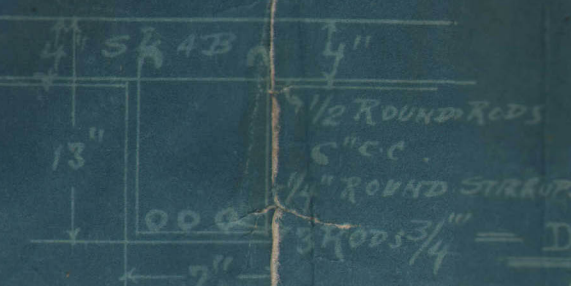

APPROVED

Executive Engineer,
Karachi Municipality

DURGAS B. ADWANI & CO.

ARCHITECTS & SURVEYORS.

KARACHI. 21-2-28.