

Form No. 8-400-2-11-21.

ORDER UNDER SECTION 96 (2) OF ACT, III OF 1901.

No. L. S. 667 OF 1922.

MUNICIPAL ENGINEER'S OFFICE,

Karachi, 2 2 1922.

MEMO.

With reference to ^{his}~~their~~ application, dated 8 10 1921.Mr. Mulla Mahomed Noor Mahomed is informed
~~Messrs.~~ ~~are~~that the plan submitted by ^{him}~~them~~ for building a house. on plot No. 183 Survey Sheet K6
situate in Street, Lyan
Road

Quarter, is approved, and permission to build in accordance therewith is granted. The building to be erected, subject to the By-laws and Rules of the Municipality.

M. C., A. M. Inst. C. E.,

Engineer,

H. Jora Karachi Municipality.

NOTICE 1.—This pass does not give permission to occupy Municipal land with building materials. This can only be allowed when the street is wide enough to permit building materials being deposited on it without it being a source of danger to the public, and only then on a hoarding being placed round the land to be occupied and on payment, in advance, of fees for occupation of Municipal land, at the following rates :—

	Rs.	A.	P.
(1) For the first three months, per square yard per diem	..	0	0 $\frac{1}{2}$
(2) For the next three months " "	..	0	0 1
(3) For any subsequent time " "	..	0	0 2

NOTICE 2.—Windows, steps and doors of the building will not be permitted to project on or overhang any public street or Municipal land.

NOTICE 3.—Plinths will not be allowed to project more than 2 inches on any Public street for ornamental purposes.

Copy to the B. S. B. Smith & Co. for information & report. 668Copy to the Inspector of the Hq. for information & report. 669Copy to the S. O. M. for information & report. 670

183 to 6 Lyar Dr

Submitted with report that
the C.D.C. has permitted the
Man vide his letter No 2884
dated 28th Oct 21.

The despatch clerk of C.D.C.,
through oversight seems to have
forgotten to send the copy
of the letter to the Municipal.

The attached is the copy
received by the owner from the C.D.C.
Under the circumstances it is
suggested that a copy of
the letter be maintained in
the office & the usual
permission be issued to
the owner.

28/1/22 *S. Narayan*
P.D.

Submitted for order. There
appears no objection to the
pass as usual. *S. Narayan*
27/1

Yes
1/2

20.

attach pass

S.
2/2

3
No. cDe2884 of 1921.

Revenue Department.


City Deputy Collector's Office

Karachi, 28th October 1921.

Memorandum,

With reference to his application dated 20th October 1921, requesting permission to build a dwelling house on plot No. 183 (Sheet K-6) Lyari Quarter, in accordance with plan No. 695 approved by the Engineer, Karachi Municipality, Mulla Mahomed ^{now Mahomed} is informed that the permission applied for is granted, provided he obtains permission of the Karachi Municipality before commencing the work.

2/- Plan No. 695 is returned herewith duly sanctioned.

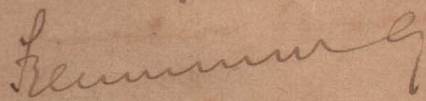
City Deputy Collector, Karachi.

- ✓ (1) Mulla Mahomed Nurmahomed.
- (2) The Engineer, Karachi Municipality, for information with reference to his endorsement No. L.S. 6541 dated 14-10-1921.
- (3) The Income Tax Collector, Karachi for information.
- (4) The Superintendent Karachi City Survey for information.
- 80
20th Nov 1921

Form No. 18. 500-29-12-19.

No. L.S. 487 of 1922

MUNICIPAL OFFICE,

Karachi, 26th January 1922

MEMO :

Mr. Mulla Mahmood Nur Dal ~~are~~ ^{is} informed that undersigned
Messrs.

has been made aware of ~~their~~ ^{his} having started the building operations on plot
No. 183 K6 Lyari Qr. in anticipation of getting permission
from this office as well as the office of City Deputy Collector. Instructions are
therefore given to ~~them~~ ^{him} to stop the work at once on receipt of this notice, failing
which the unauthorized structure will be removed at ~~their~~ ^{his} risk and cost.

A. M. INST. C. E.,

ENGINEER,

Karachi Municipality.

Form No. 30—400—26-7-1921.

L. S. 6540 of 1921.

MUNICIPAL OFFICE,

Karachi, 14th Dec 1921.

MEMO :

With reference to ^{his}~~their~~ application with plan received on 5th Nov 1921, for building on plot No. 183

Sheet K 6 Lyari Quarter.

Mr. Mulla Mahomed Noor Mahomed.

~~Messrs.~~

^{is}~~are~~ requested to apply for permission to the City Deputy Collector with two
Copies of plans herewith returned duly signed and approved.

Permission to build will only be granted after the approval of the
plans by the City Deputy Collector.

^{He}~~They~~ must not start any building operations until ^{he}~~they~~ hears further
from this office.

M. C., A. M. Inst. C. E.,
Engineer,
Karachi Municipality.

----- :O: -----

L. S. 6541 of 1921.

MUNICIPAL OFFICE,

Karachi, 14th Dec 1921.

MEMO :

Copy to City Deputy Collector for information.

M. C., A. M. Inst. C. E.,
Engineer,
Karachi Municipality.



400-14-5-211

No. E 140 of 1921.

MUNICIPAL ENGINEER'S OFFICE,
Karachi, 4-5th October 1921.

MEMO:

The above application is forwarded to the Municipal Health Officer
for favour of report.

*26 22
6/10/21*

*Mr. Naraiah
sumo to
5-6
21*

D. P. H.
M. C. M. E. O.,
Engineer,
Karachi Municipality.

MUNICIPAL HEALTH OFFICER'S REPORT.

Returned to the Engineer, Karachi Municipality, with the following

Remarks:—

No objection

Consent

To build a house

No objection

Sanitary Officer
Health Officer
Building Surveyor

D. P. H.
D. P. H. (London),
Health Officer,
Karachi Municipality.

Date 7-10-1921

No. E. 140 of 1921.

MUNICIPAL ENGINEER'S OFFICE,

Karachi, 8th October 1921.

Forwarded to the Building Surveyor and Land Surveyor for report.

[Signature]
M. A. I. C. E.,
Engineer,
Karachi Municipality.

BUILDING SURVEYOR'S REPORT.

Applicant's Name Mulla Mahmad Noor Ndt.Whether he is the owner of the plot on which it is proposed to build YesPlot under whose control GrobWhether it is permanent or temporary PermanentThe work proposed To build a houseBuilding Surveyor's Report seeNo objectionDate 11/10/21

[Signature]
Building Surveyor.

LAND SURVEYOR'S REPORT.

Does the plot come under Alignment ho
Area of plot 24/1/8
Area under Alignment 24/1/8
Remarks Lis. 24

There appears no objection
to approve the plan with the consent
of C.O.C.

Date 192

Land Surveyor. 11/10

ORDER OF THE ENGINEER.

Show site on survey sheet

14/10 D

no obj.
14/10 D

M. C., A. M. INST. C. E.,

Engineer,
Karachi Municipality.

No. L. S. 747 of 1921.

MUNICIPAL ENGINEER'S OFFICE,

Karachi, 2/4/22 1922

Submitted to the Managing Committee for information.

[Signature]
M. Inst. C. E.,
Chief Officer & Chief Engineer,
Karachi Municipality

[Signature]
M. C., A. M. I. C. E.,
Engineer,
Karachi Municipality

Through

THE CHIEF OFFICER & CHIEF ENGINEER,

Karachi Municipality.

RESOLUTION OF THE MANAGING COMMITTEE.

Resolution No. _____ dated _____

500-1-2-1921.

FORM No. 1.

Karachi, 3-10-1921

Notice under Section 96 of Act III of 1901.

THE CHIEF OFFICER AND CHIEF ENGINEER,
KARACHI MUNICIPALITY.

SIR,

I beg to inform you that I intend building Houseon plot No. 183Survey Sheet No. K. 6 situate in _____Street, Gari Quarter.

As required by the Rules of the Municipality, I beg to submit herewith a
plan of the same for your approval.

I beg to remain,

Sir,

Address:—

M. Nazir & Khinji

Your most obedient Servant,

Mulla Mohomed
Noor Mahomed

Signature of the Applicant.

No. G 9691 of 1921.

MUNICIPAL CHIEF OFFICER AND
CHIEF ENGINEER'S OFFICE,

Karachi, 5-10-1921

Forwarded to the Municipal Engineer for favour of disposal.


Larain aloth

for Chief Officer and Chief Engineer,
Karachi Municipality.


PLAN

OF PROPOSED BUILDING ON PLOT
Nº 183 K.6 LYARI QUARTER

SCALE 8"=1" INCH.

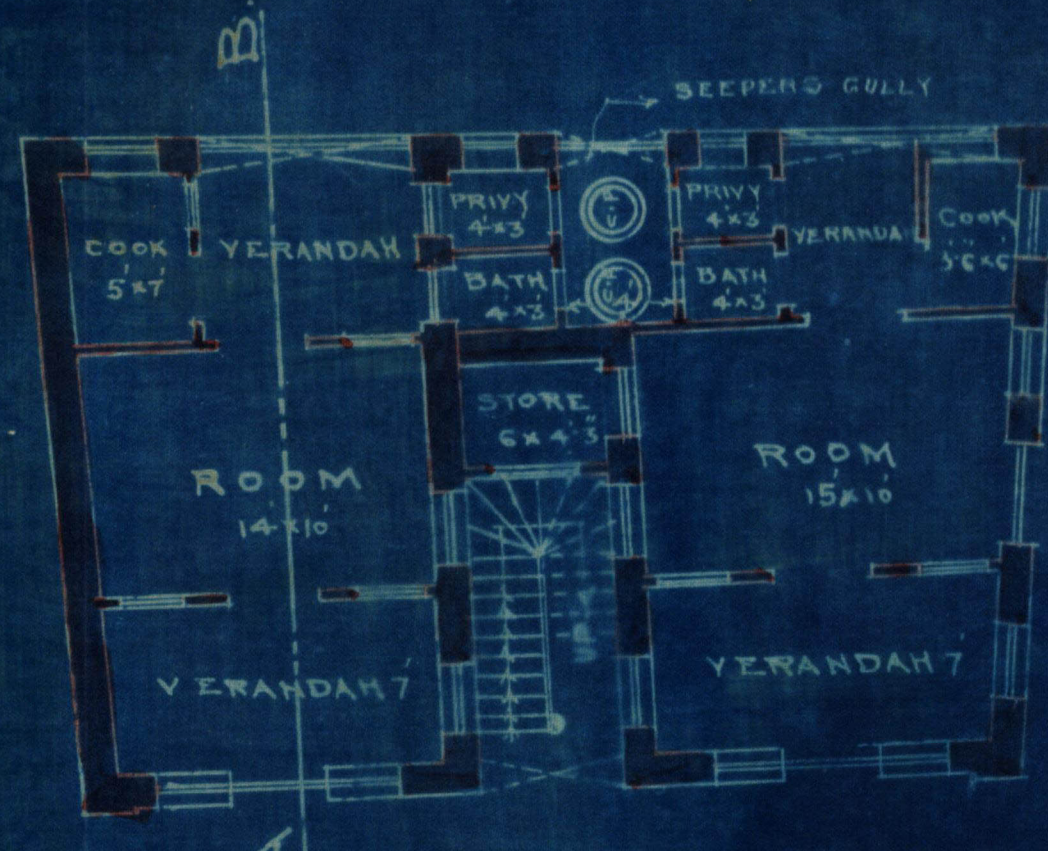


GROUND PLAN

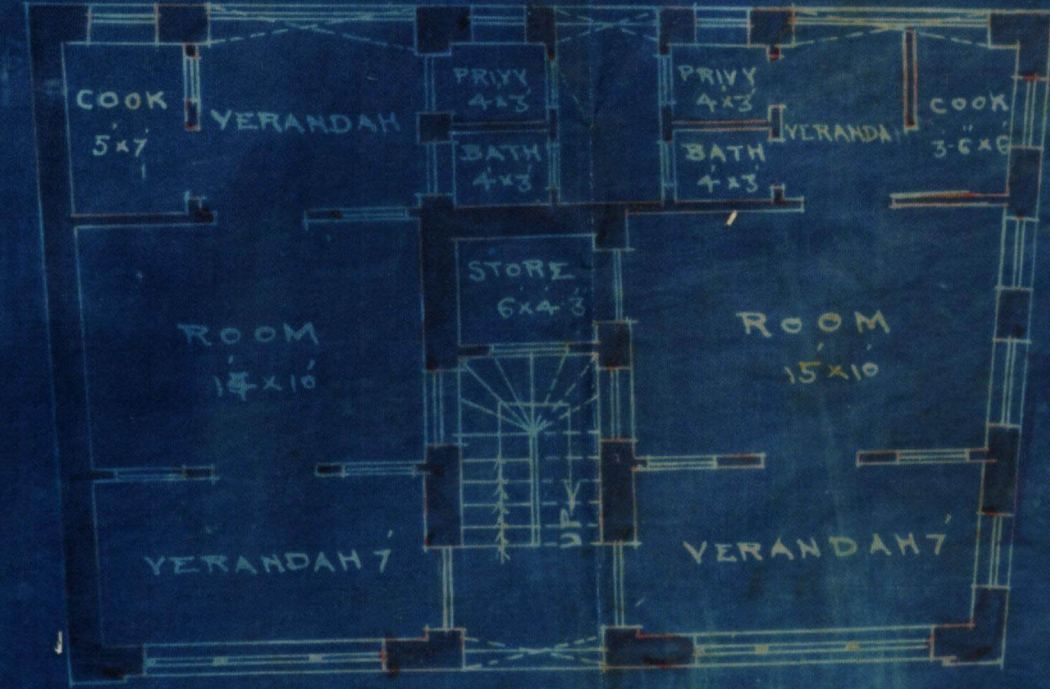

1ST & 2ND FLOOR PLAN




ELEVATION

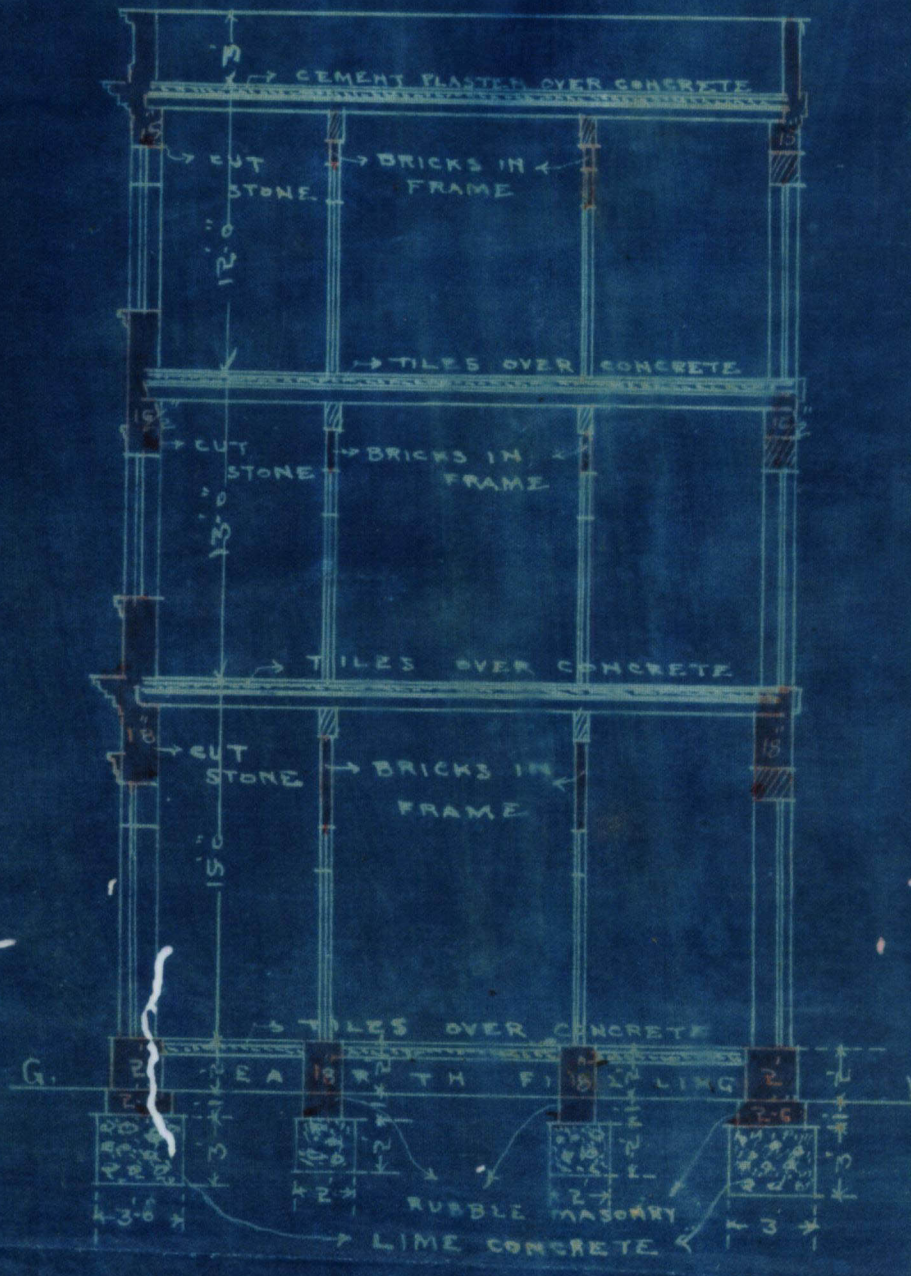

SECTION ON A.B.

SITE PLAN
SCALE 20"=1"

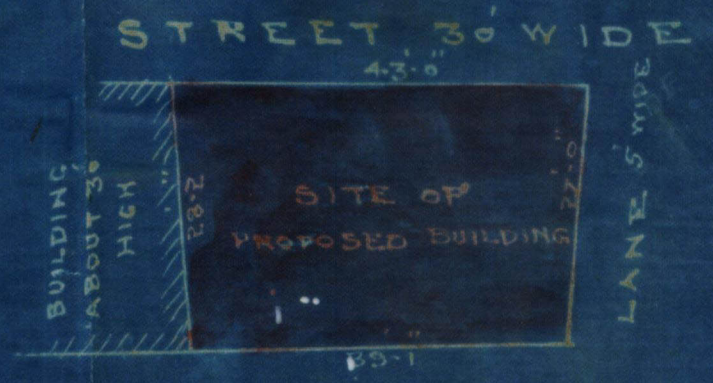

Shirazi Khan
ARCHITECTS & SURVEYORS



ε