



Heritage

KMR.CDD.OIQ.1920-1921.02

Building Completion Report.

MUNICIPAL OFFICE,

Karachi, 26th May 1921.
31

To

THE ENGINEER,

KARACHI MUNICIPALITY.

SIR,

I beg to report, the building work on plot No. 5249 Sheet A1

Q.T. Quarter owned by Mr. Assamel Hanray.

is completed according to the plan approved by the Municipality. Orders are requested to file the correspondence.

Yours obediently,

Building Surveyor " " Section,
Karachi Municipality.

Copy to asc

File

M.C. & A.M.I.C.E.,

Engineer.

Karachi Municipality



Heritage

KMR.CDD.OIQ.1920-1921.02

Form No. 6.

No. L. S.

4234 OF 1920

MUNICIPAL OFFICE,

Karachi 17 7 1920
23

MEMO :

Building Surveyor Section B is informed
that Mr. Asanmal Hemraj has been permitted
to build.

_____ his house
on plot No 52 & 49 A.1 K. Kushabhai Shree
Old Town Quarter report should be made to the


Undersigned when the house is completed.

M. K. K. K.
A.M. INST., P.E.,

ag : Engineer,
Karachi Municipality.

No. 158

Block Plan
Scale 20' = 1" inch

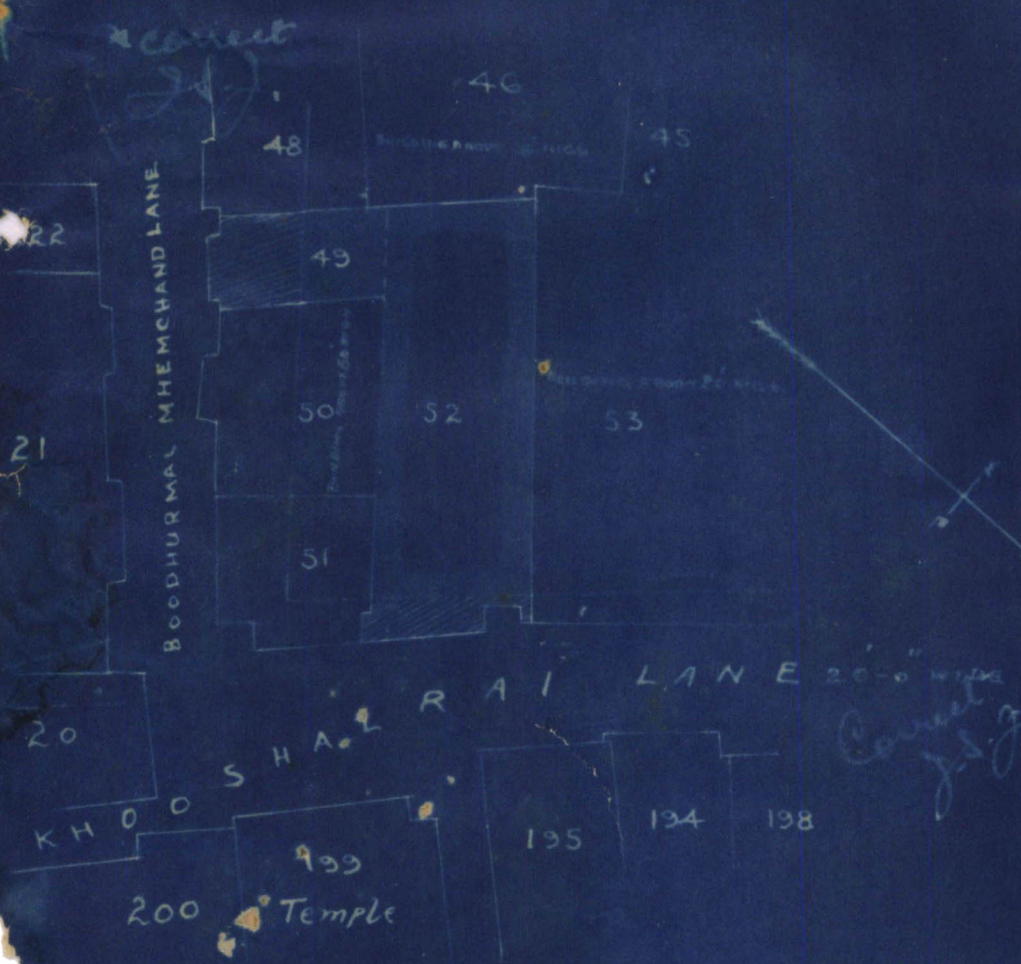


Plan of Proposed Building
to be built on Plot No 52 & 49
Sheet A-1, Old Town Q. B.
Scale 8' = 1" inch.




APPROVED

M. I. M. E.
Architect Engineer
Karachi


Arif ul Hameed

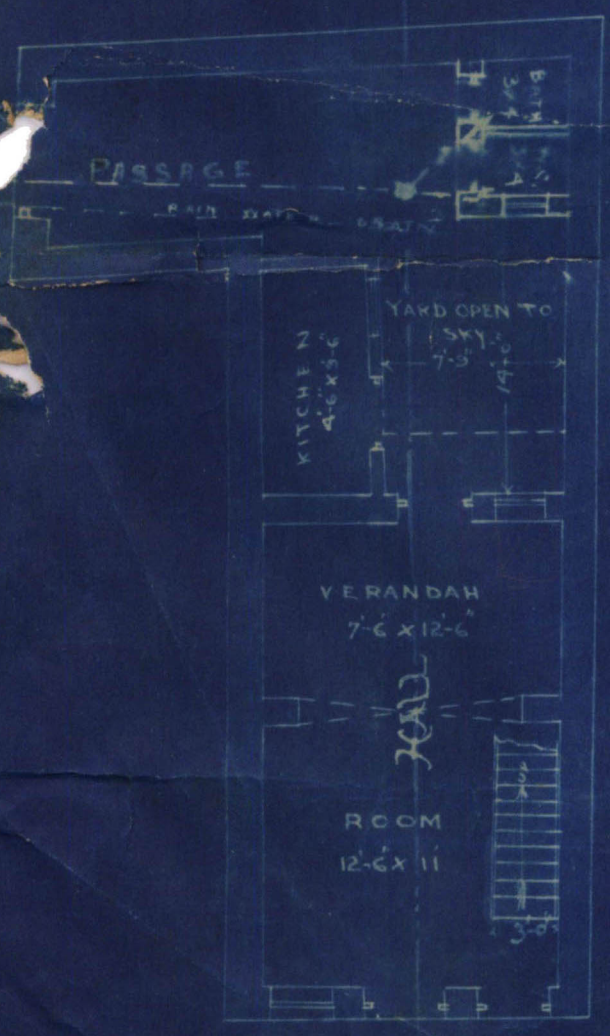

GROUND PLAN

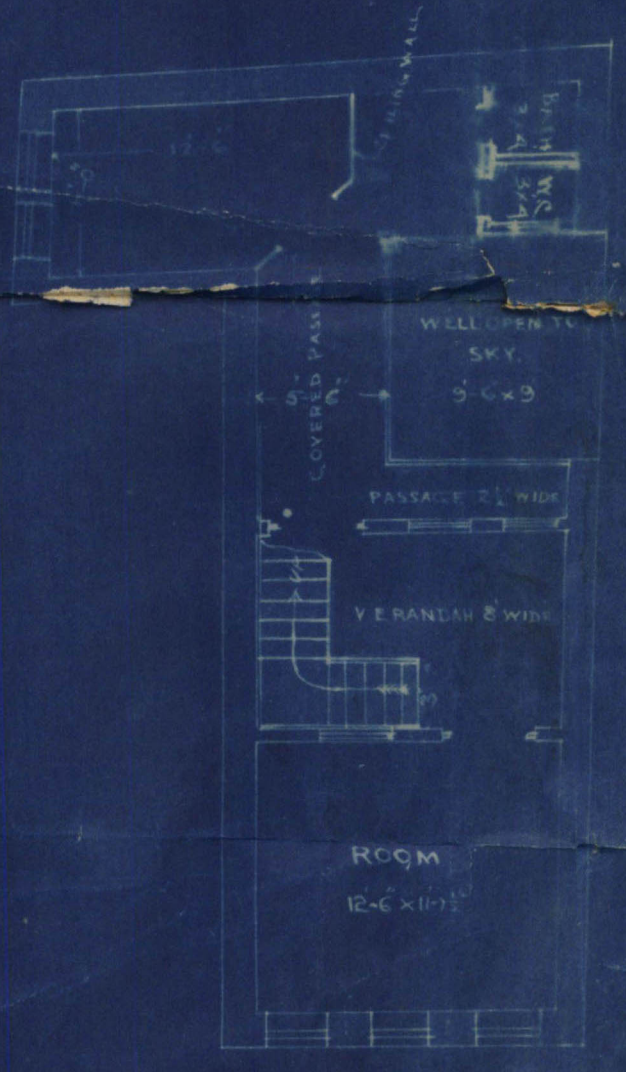

1st & 2nd FLOOR PLAN

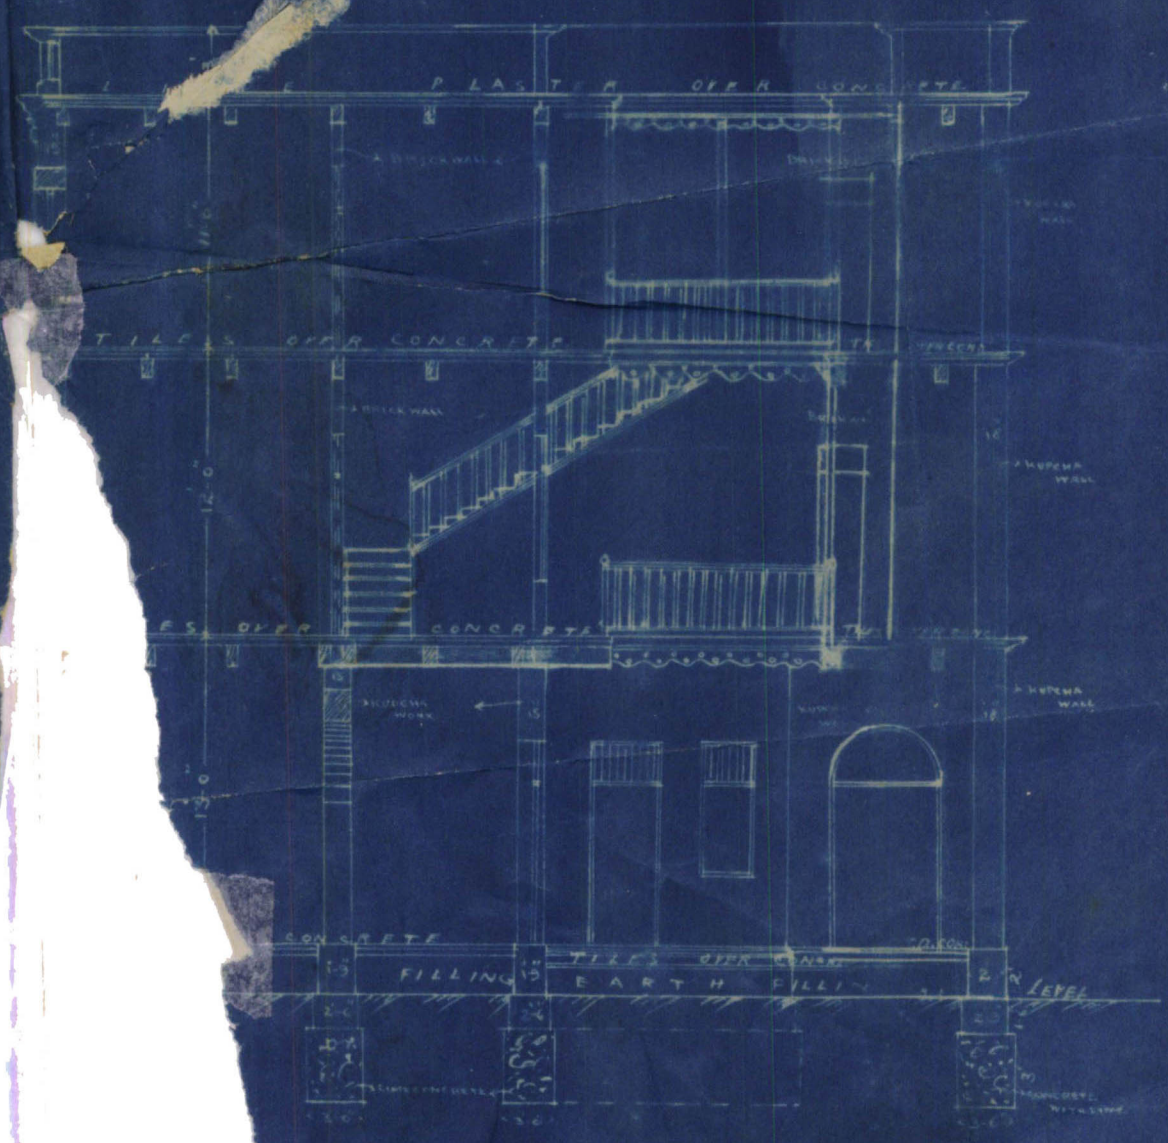

SECTION ON A, B.

T. A. Shiveshanker Mudhali
ARCHITECTS & SURVEYORS
KARACHI.