



Building Completion Report.

No. L. S. 5599

21

MUNICIPAL OFFICE,

Karachi, 6th Sep 1921.
12th

To

THE ENGINEER,

KARACHI MUNICIPALITY.

SIR,

I beg to report, the building work on plot No. 21 & 3 Sheet AB
Old Town. Quarter owned by Mahraj Rewachand Katarachand
with slight deviation in staircase & bath
is completed according to the plan approved by the Municipality. Orders are
requested to file the correspondence.

Yours obediently,

Building Surveyor "A" Section,
Karachi Municipality.

Copy to the A/c for information

Barrington Brown,
M. C. S. M. T. C. E.,
Engineer,
Karachi Municipality.



No. L. S.

OF 1921

Form No. 6-100-30-4-21.

MUNICIPAL OFFICE :

1516

Karachi,

20
25

1921.

MEMO :

Building Surveyor Section B. is informed
that Mr. Bhewachand Rotanehand has been permitted
to make additions & alterations on
his house
on plot No 24 & 3. A6 Sukh-dhar Street,
Old Town Quarter, report should be made to the
undersigned when the house is completed.

B. Cunningham
M. C., A. M. I. C. E.,

Chief Engineer,
Karachi Municipality.



400-26-4-20.

Form No. 5.

No. L. S. 6875 of 1920.

MUNICIPAL OFFICE,

Karachi, 2 / 12 / 1920.
6


MEMO:

Inspector Bldg: Surveyor. B. Quarter, is informed
that Mr. R. S. Chaudhary & Rotachand has been permitted
to build
his house
on plot No. 44.2A+3 ad. Sukhadham Street
Old Town Quarter. Report should be made to the
undersigned when the house is completed.


M. H. H. H. H. H.
A.M. INST., E. E.Engineer,
Karachi Municipality.

Through the Health Officer, Karachi Municipality.

Note.—The plot is held as a temporary occupation lease and the owner agrees to remove the building at any time on receiving a notice to do so.

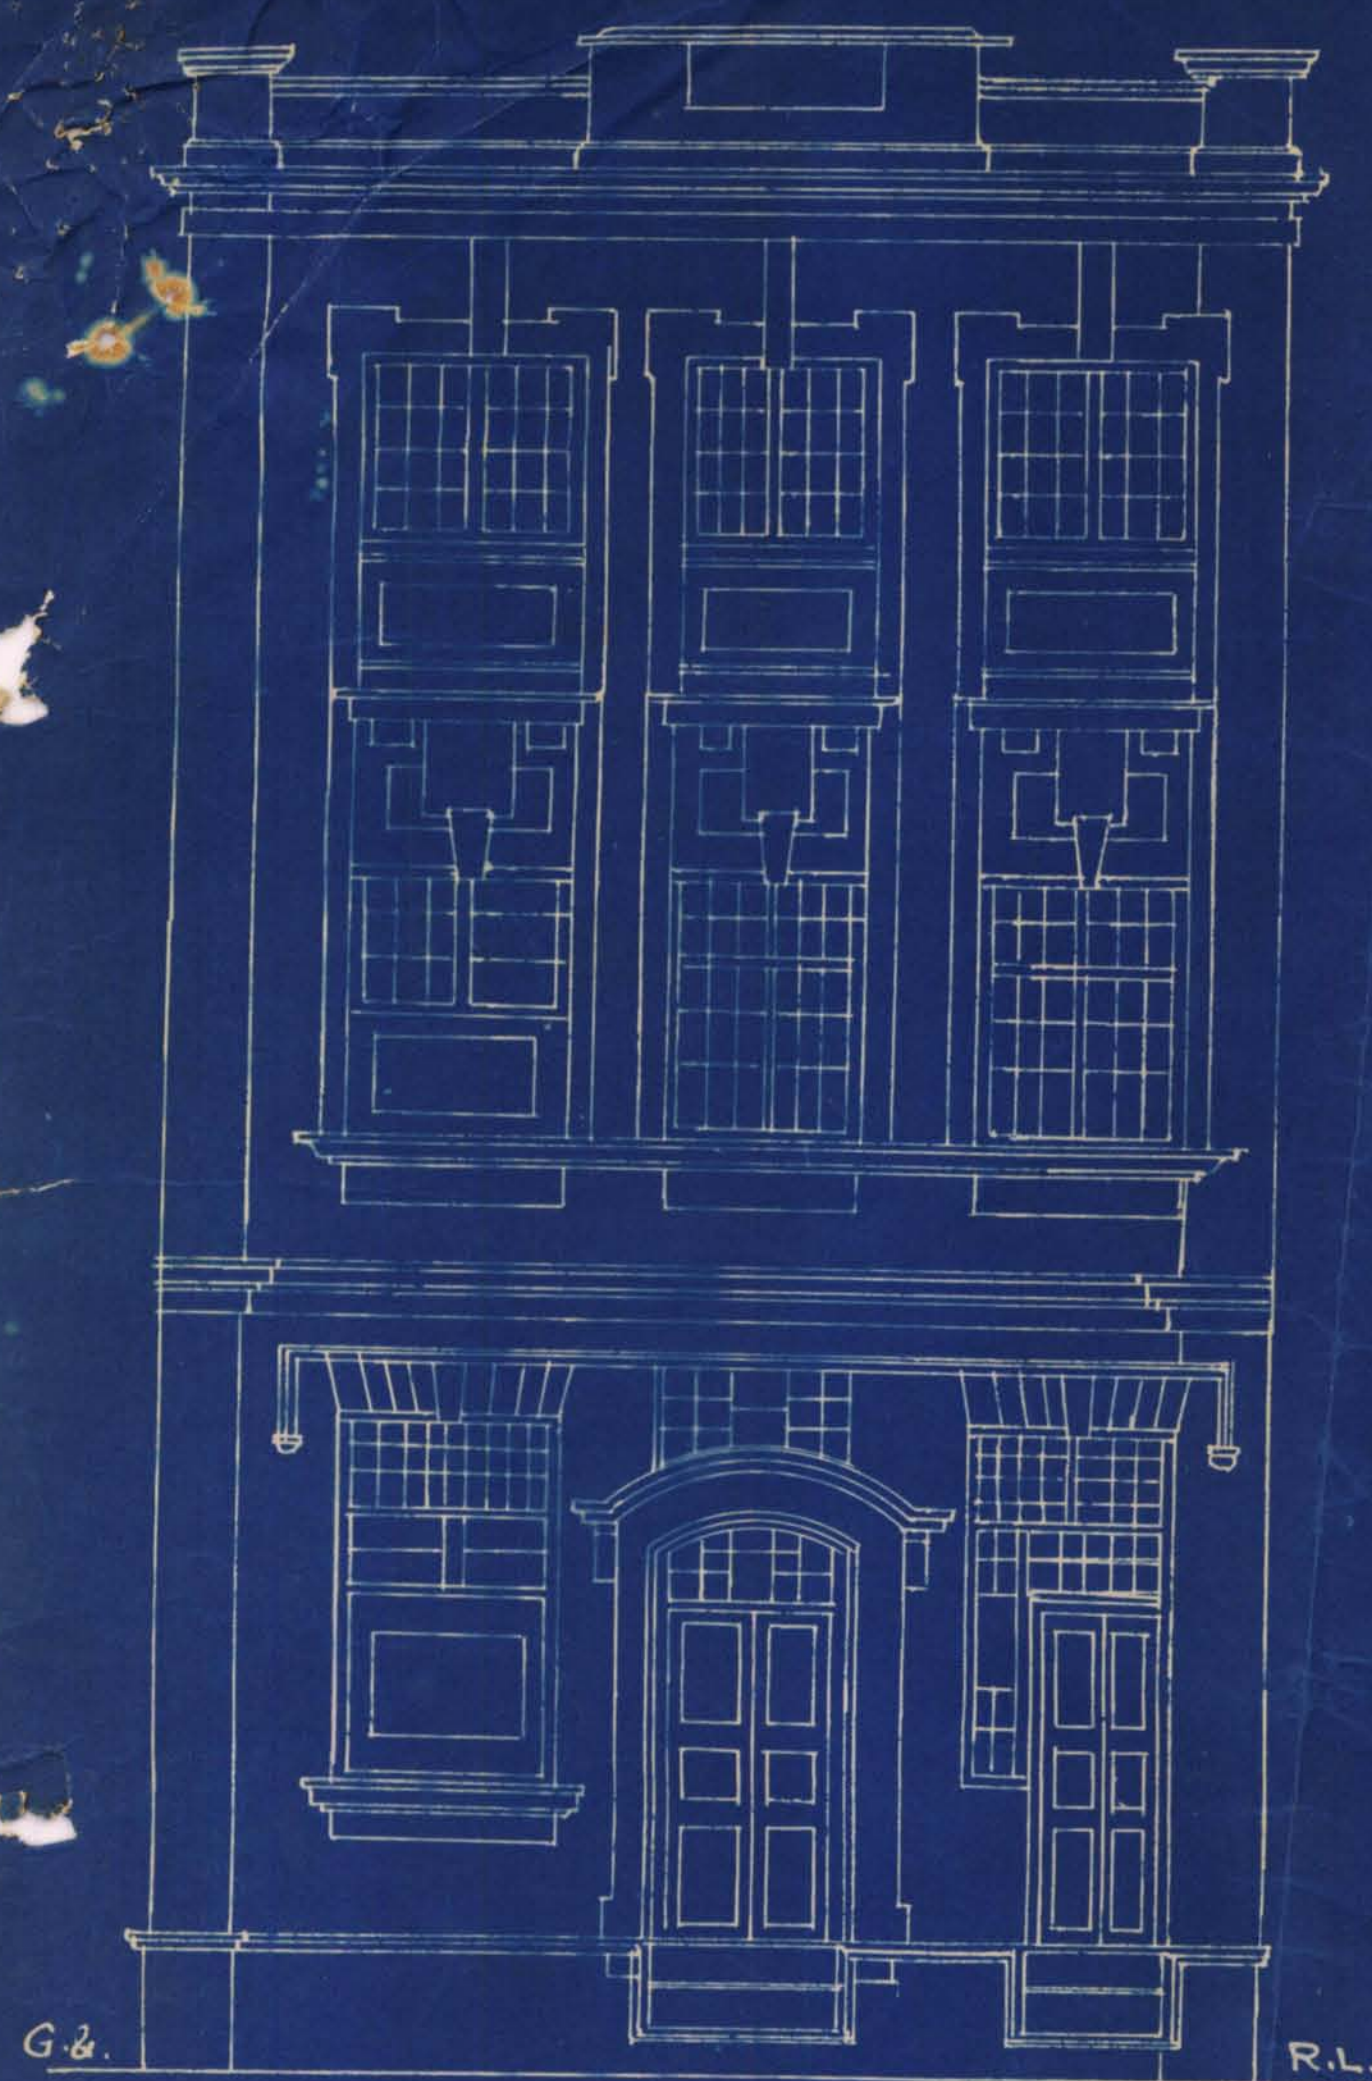

EAST ELEVATION

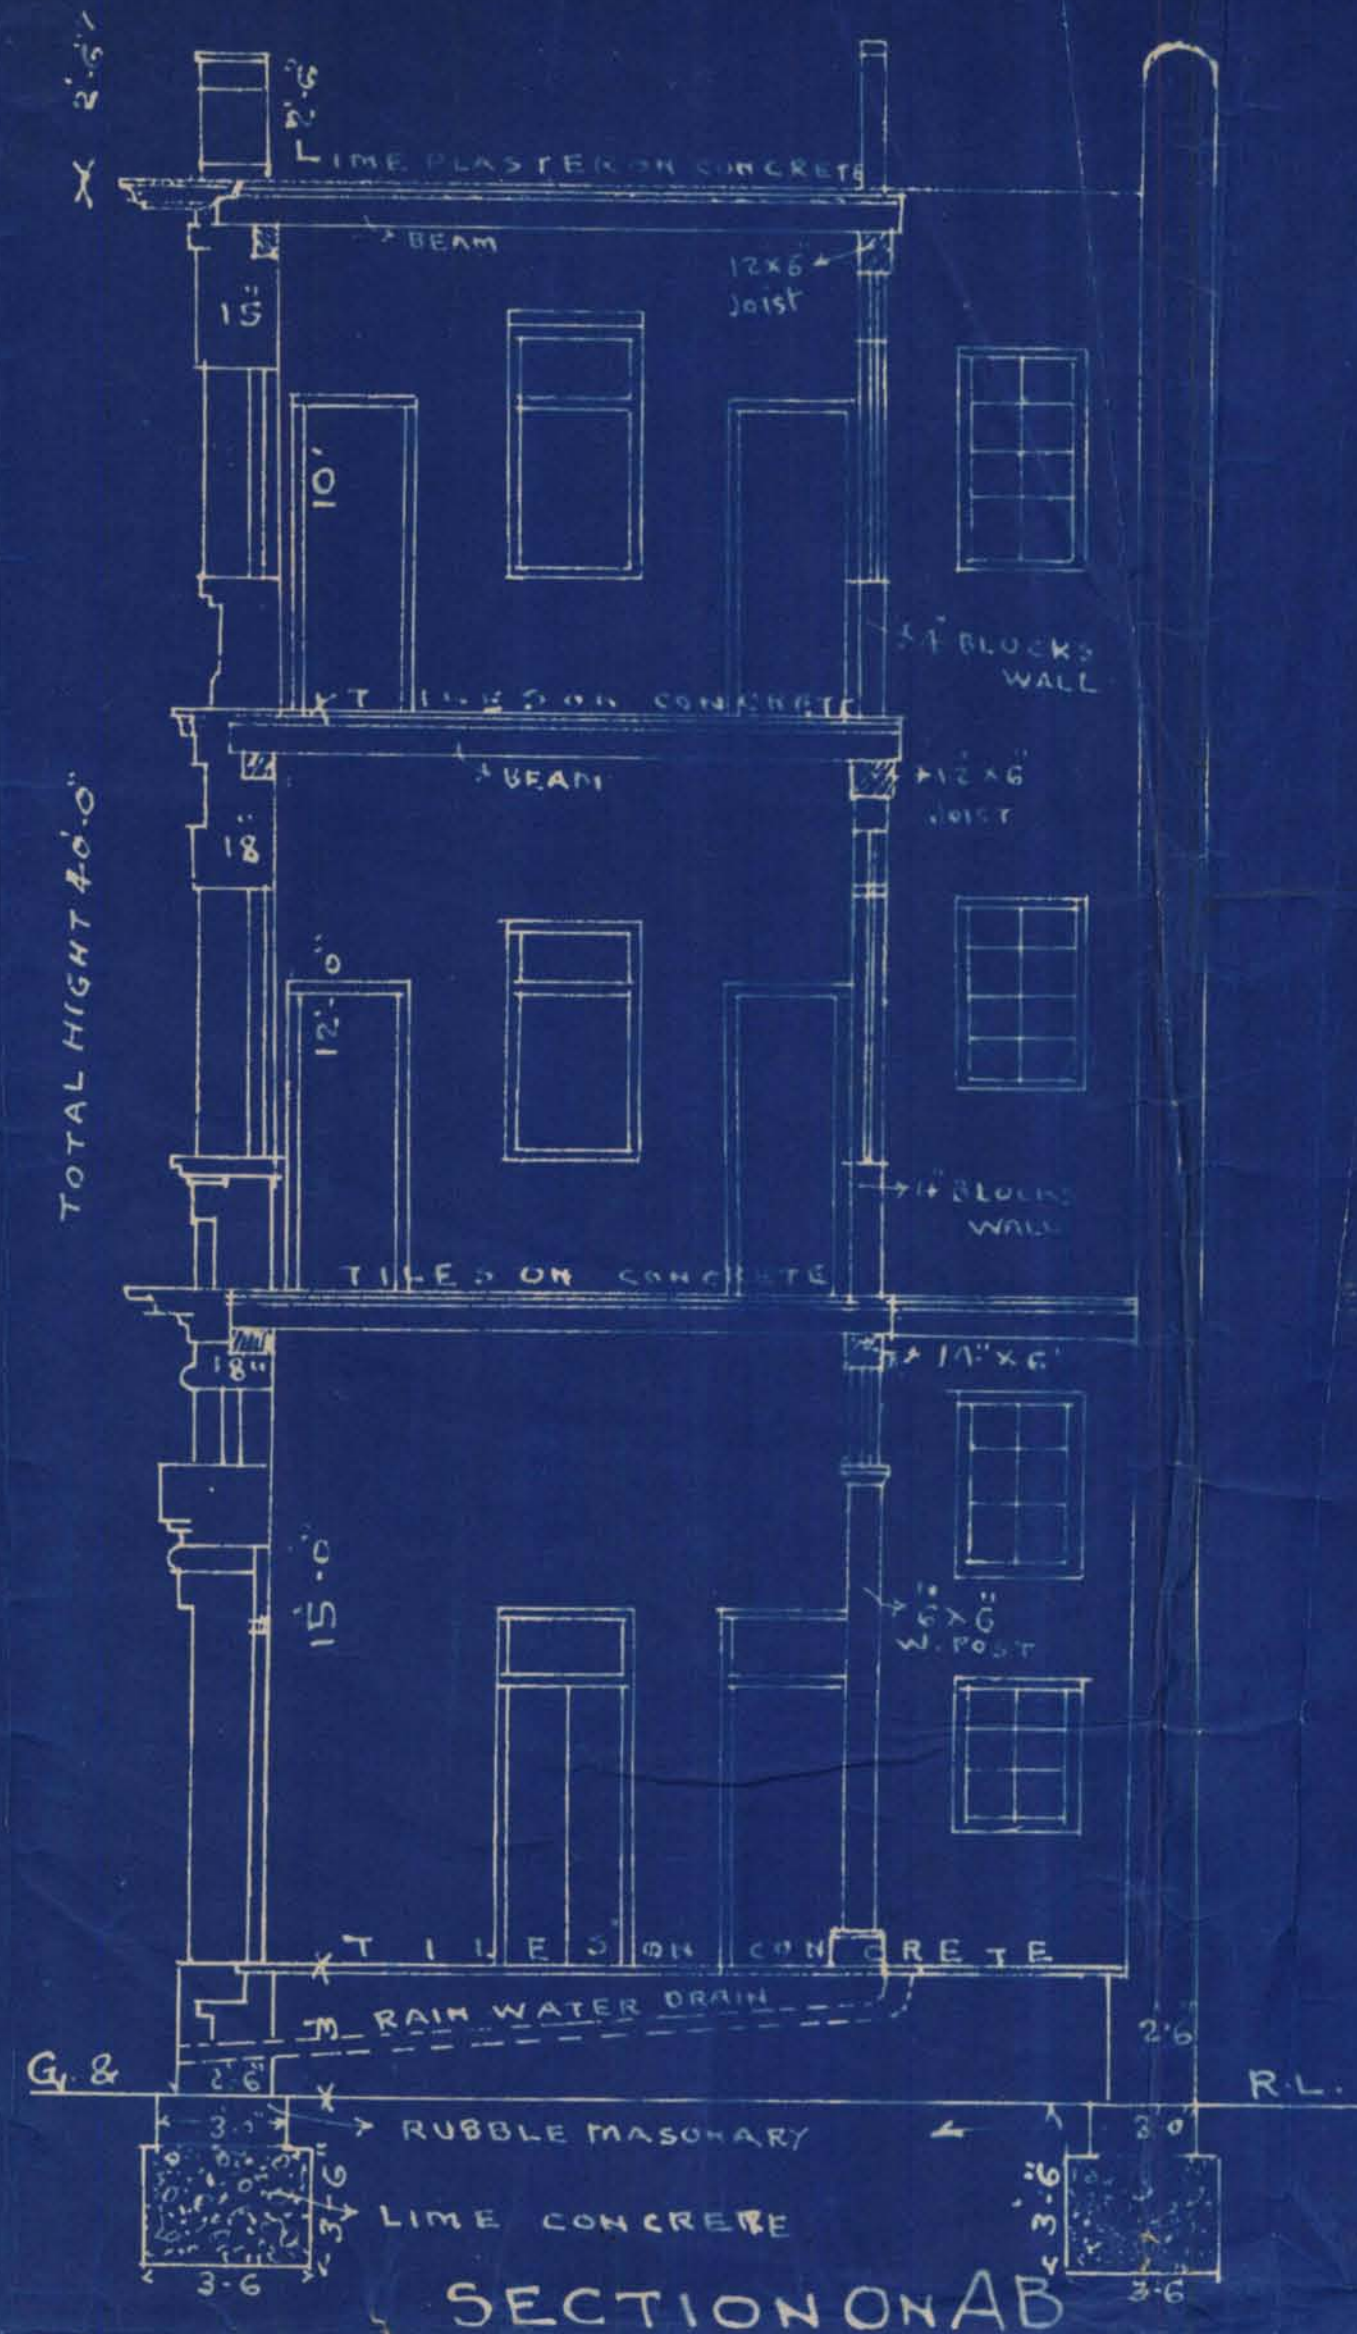


SECTION ON AB

PLAN OF PROPOSED BUILDING
ON PLOT NO 2A & 3 SHEET A6
OLD TOWN Q
SCALE 4 = 1


BLOCK PLAN
SCALE 20 = 1



No. 294

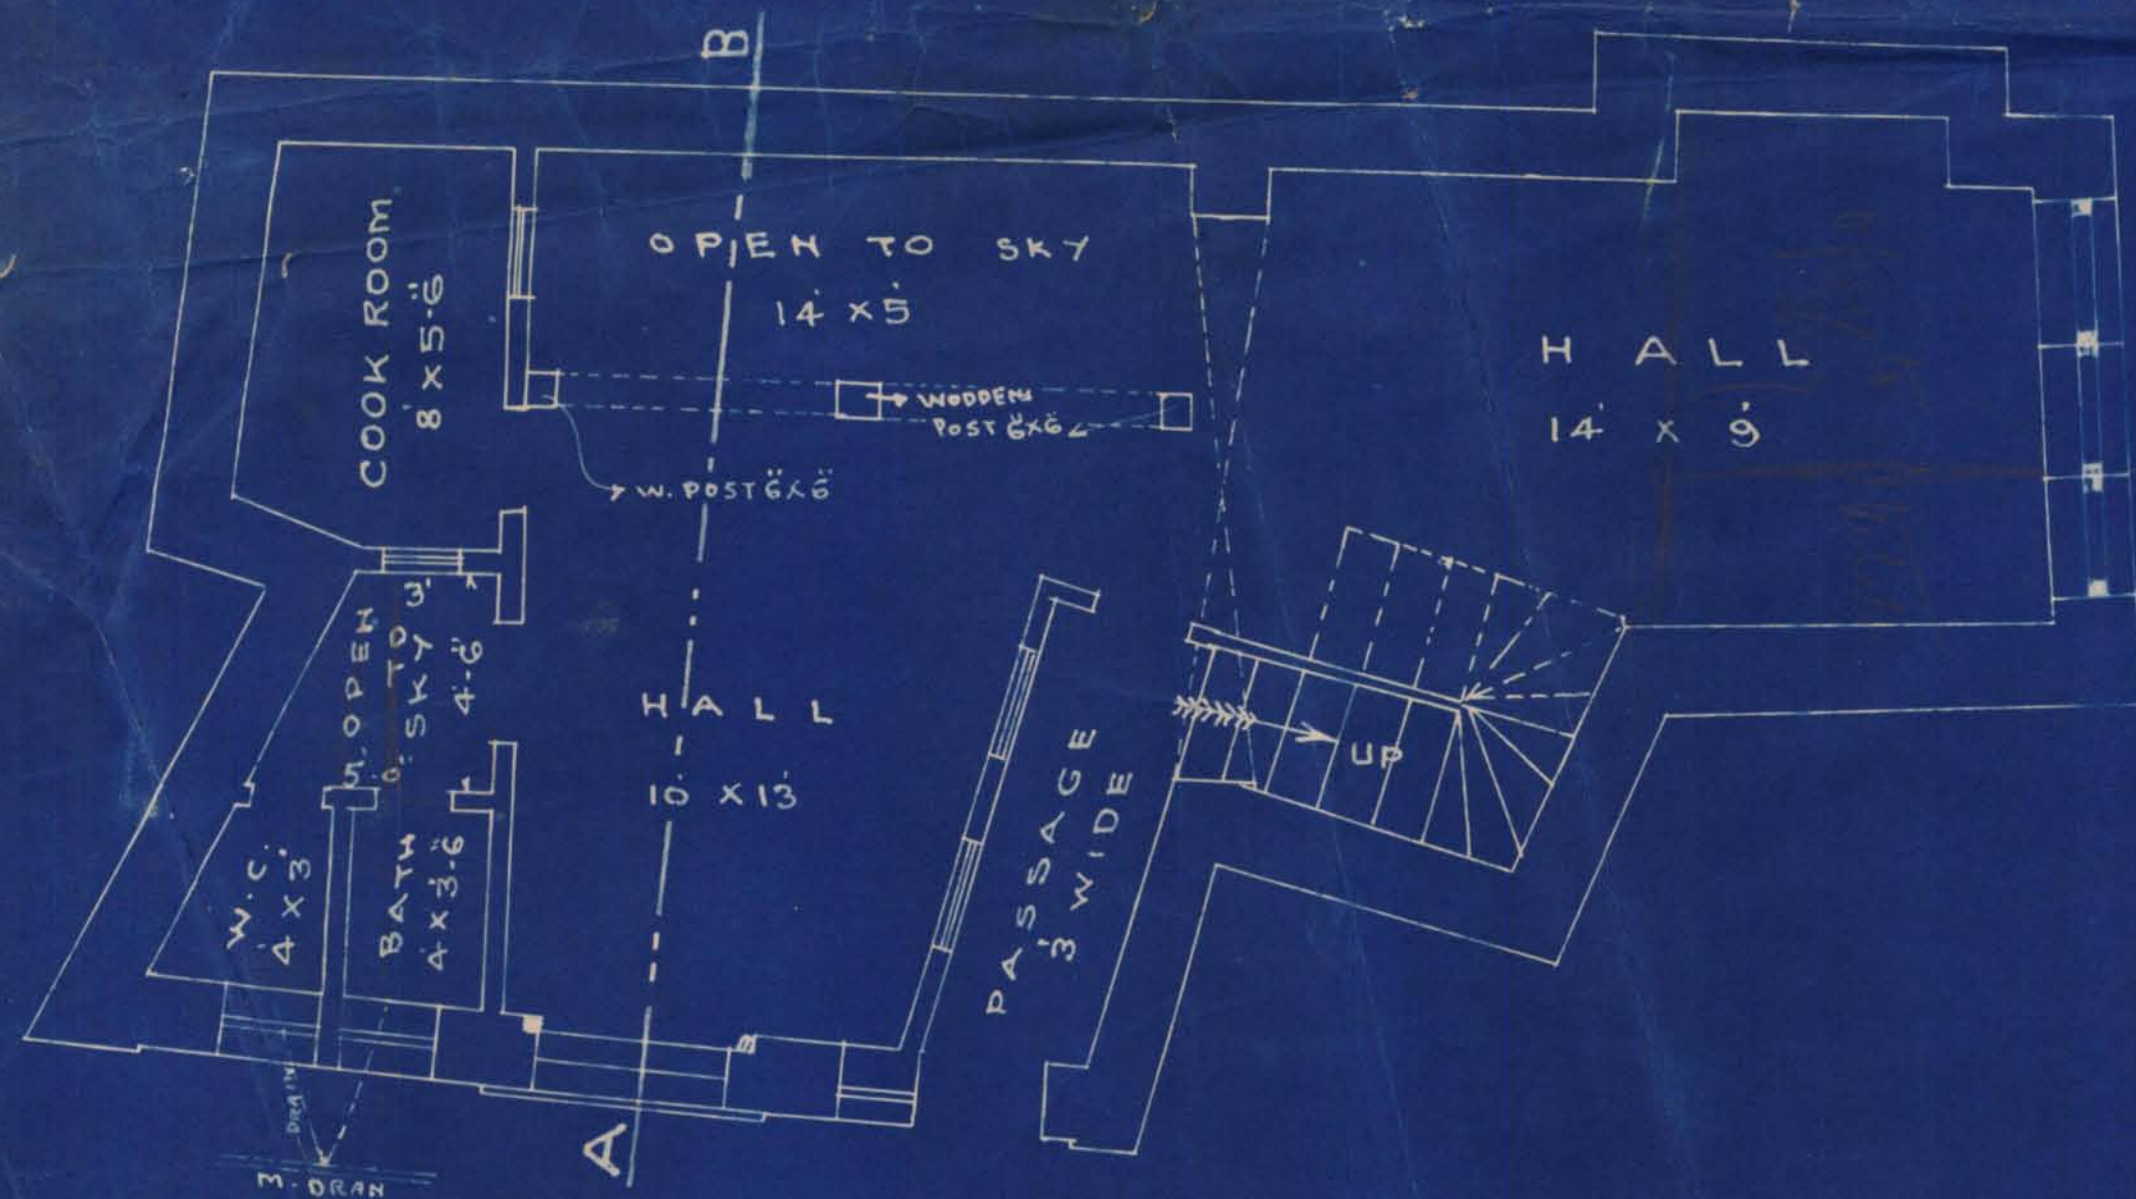

GROUND FLOOR PLAN

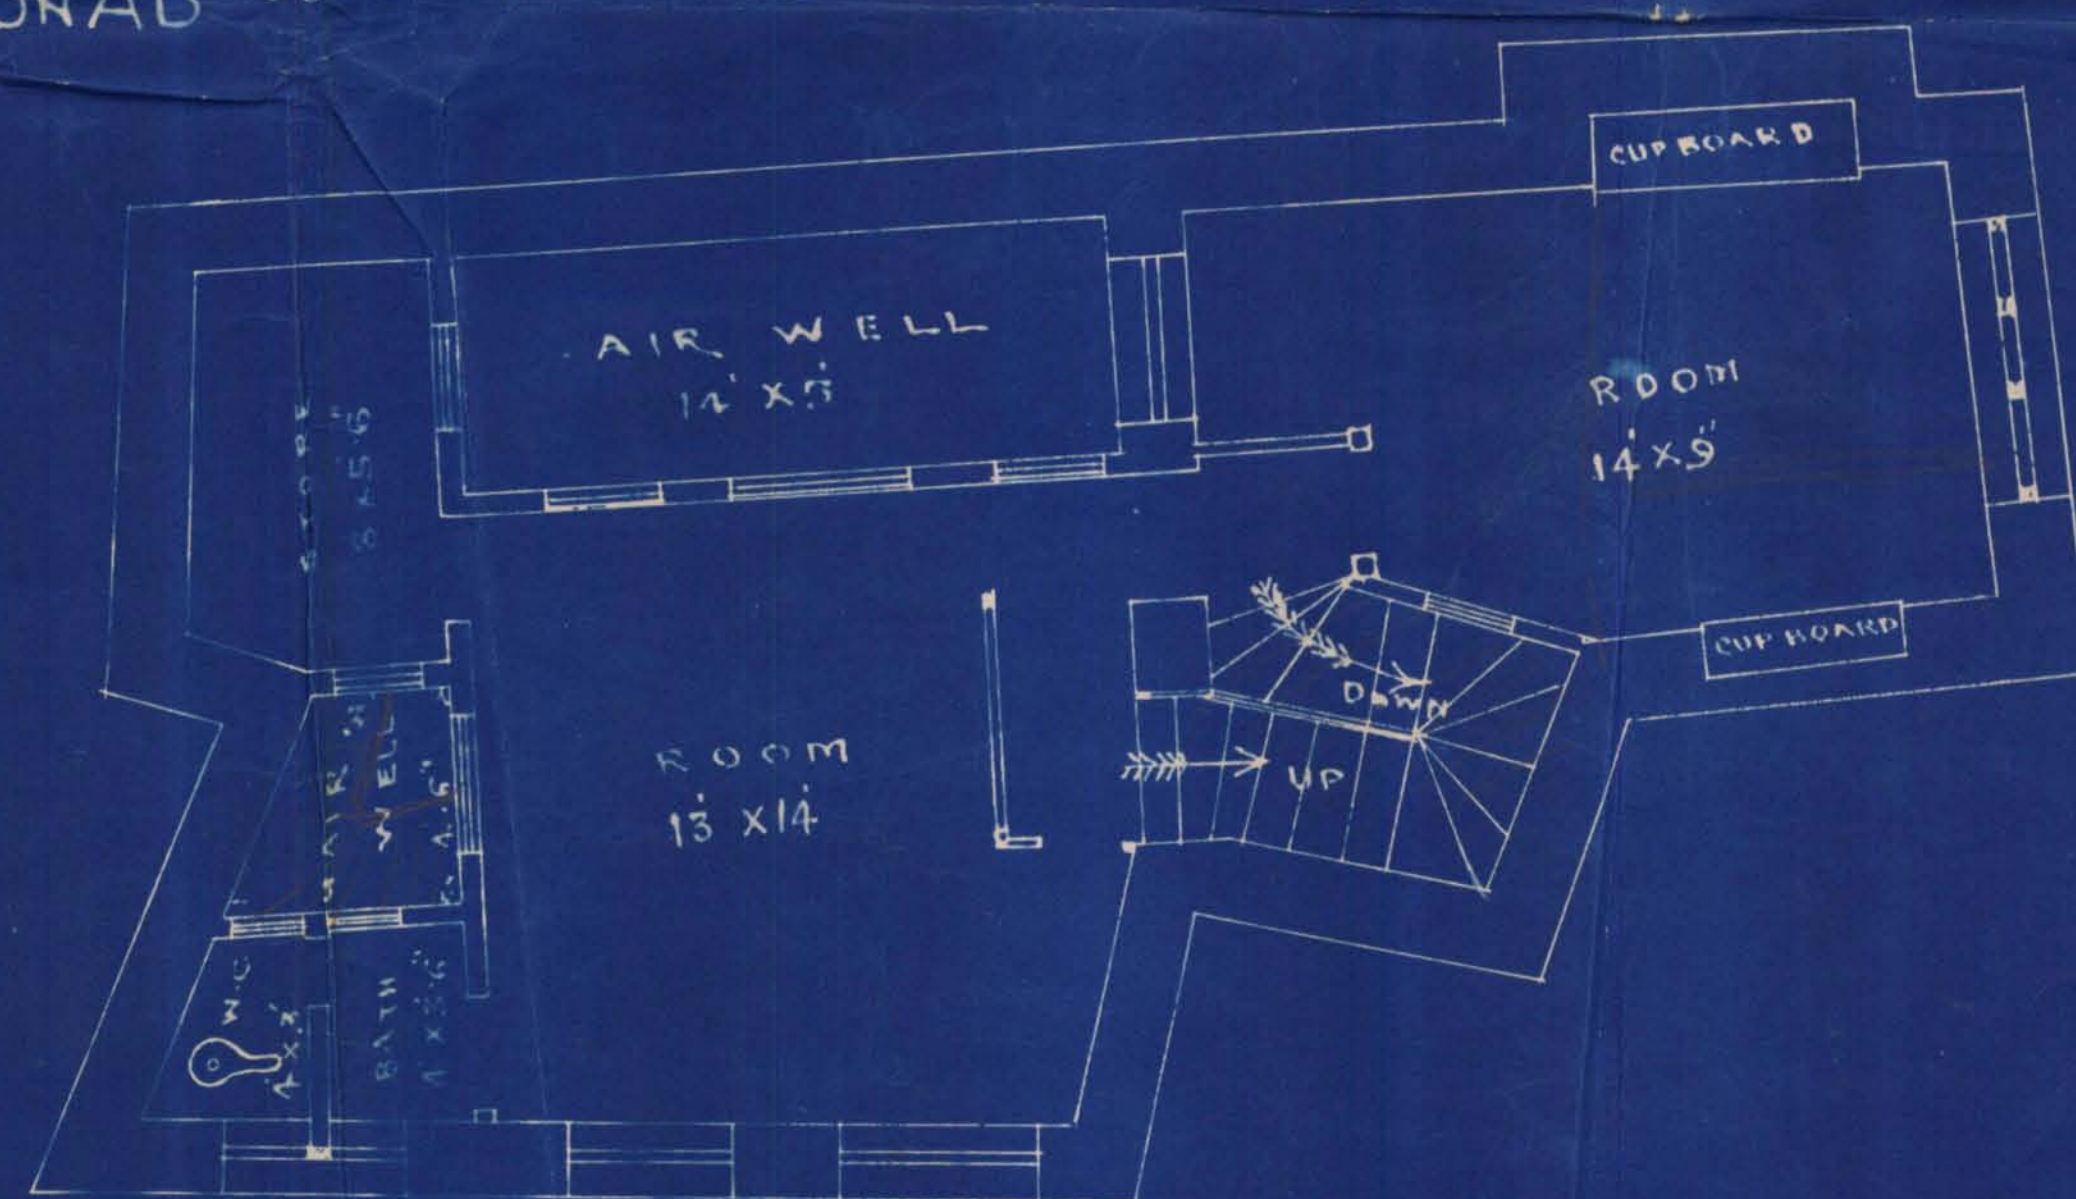

1ST & 2ND FLOORS PLAN



PLAN SHOWING PROPOSED ADDITIONS & ALTERATIONS
ON EXISTING BUILDING STANDING ON PLOT NO

2A & 3 SHEET N^o A6 OLD TOWN OF

SCALE 4" = 1'

10.166

AREA = 108.54
To be acquired about 20.14
Total 88.40

BLOCK PLAN
SCALE 20' = 1'




Reservoir Building
Rochester Palace

J.R. Shrivastava-Khandekar
30/11/21

ELEVATION

SECTION ON A.B.

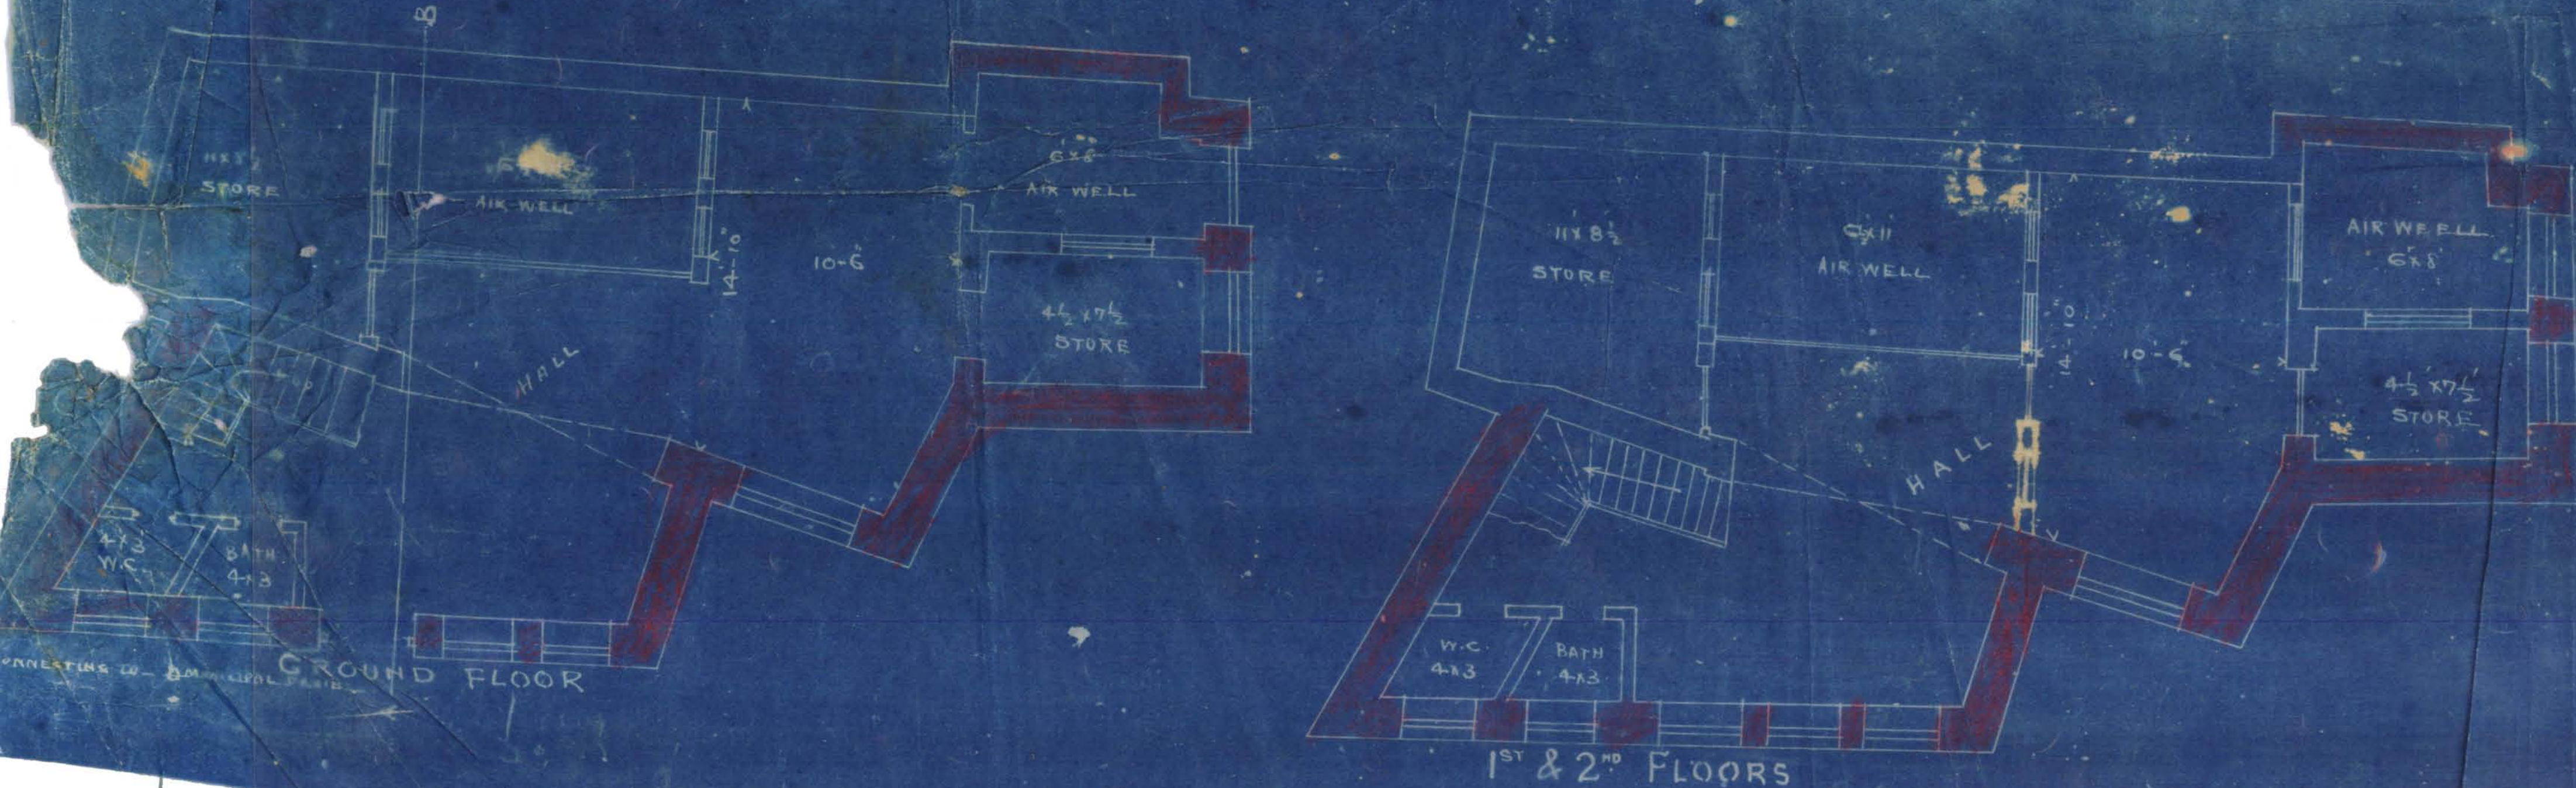





Heritage
FOUNDATION

KMR.CDD.OIQ.1920-1921.01

7-1

54

King
18

11-2-2011
11-2-2011



Heritage
COMMISSION

KMR.CDD.OIQ.1920-1921.01

72
Undersigned has the honour to

Engineer the accompanying plan for the proposed building on plot No 3160 R.S.T.D.D.

FE. 1160 FF.

Sheet 8.1. Jail. Quarter submitted by

Mr.

Messrs.

Gulam Hussain Cheralingji Ramwala the registered
occupant of the plot.

There being no objection from either a Municipal or Sanitary point of view, undersigned recommends permission to build may be accorded, with the sanction of the Managing Committee, under the Land Sale



Heritage

KMR.CDD.OIQ.1920-1921.01

8

BUILDING COMPLETION REPORT.

MUNICIPAL OFFICE,

Karachi, 30th June 1921
1.7.21

To,

THE ENGINEER,

KARACHI MUNICIPALITY.

SIR,

R.S. 4082
1.7.21

I beg to report that the building work on plot No. 3
 sheet 7/5 Sadar Bazar Quarter owned by
 Mr. Jalirji Cowaji is completed
 according to the plan approved by this office.

Copy to the Officer & Collector
 for information

P. B. Shindeoan

M. C. A. 1129/60. P.S.

for
Karachi Municipality

Yours obediently,

B. Rawani
 Building Surveyor, „A„ Section,
 Karachi Municipality.



Form No. 3-24,000-4-32

9
Department.

FILE No. of 1932.

SECTION

PART

To Mr. G. S. S. S.

Disposal No.. 13 06/14

Subject

Re plat no - 20. Jul. 1920

NOTE:—Former Correspondence filed in file Compilation No.
Subsequent Correspondence filed in file Compilation No.