

11-1
16A2 0-T

No. E.

1727

of 191

MUN.

Karachi, 12

MEMO:—

With reference to his
their17th Feb. 1917 Mr. Thakurdes Fate
Messrs.informed that plot No. 16 22 Old 3does not stand in the Land Register in his name. He
their Theyrequested to produce any documentary evidence to prove uwhen his request for a pass will be considered.
theirJ. Crest.

A.M.INS

E

Karachi Mu

m

1-2

has failed
documents
since lost 8th year
for her
Deer

founder, to file

Blair

6/10

27
10



200-12-7-16

Form No. 1.

Karachi, 17 — 2 — 1917

NOTICE UNDER SECTION 96 OF ACT III OF 1901.

To

THE CHIEF OFFICER AND CHIEF ENGINEER,

KARACHI MUNICIPALITY.

Sir,

I beg to inform you that I intend building

on plot No.

Survey Sheet No. 162 situate in

Street, Old Town Quarter.

As required by the rules of the Municipality, I beg to submit herewith a
plan of the same for your approval.

I beg to remain,

Sir,

Your most obedient servant,

Signature of the applicant.

No. G. 1845 of 1917

MUNICIPAL CHIEF OFFICER AND

CHIEF ENGINEER'S OFFICE,

Karachi, 19 — 2 — 1917

Forwarded to the Municipal Engineer for favour of disposal.

M. INST. C. E.,

Chief Officer and Chief Engineer,

Karachi Municipality.



2-2
4346
21.2.17
2
No. E. 1332 of 191

MUNICIPAL ENGINEER'S OFFICE.

Karachi, 19th Feb.

MEMO.

The above application is forwarded to the Municipal Health Officer for
favour of report.

Launce
A. M. I. C. E.,

2nd Engineer,
Karachi Municipality.

MUNICIPAL HEALTH OFFICER'S REPORT.

Returned to the Engineer, Karachi Municipality, with the following
remarks:—

No objection

D. P. H.
D. P. H. (London),
Health Officer,
Karachi Municipality.

Date 24-2-1917

No. E. 1332 of 1917

MUNICIPAL ENGINEER'S OFFICE.

Date 26th Feb. 1917

Forwarded to the Building Surveyor for report

W. L. S.
A. M. I. C. E.,

2nd Engineer,
Karachi Municipality.

Through

THE LAND SURVEYOR,

Karachi Municipality.



3

BUILDING SURVEYOR'S REPORT.

Applicant's name _____
Whether he is the owner of the plot on which it is proposed to build _____
Under whose control _____
Whether it is permanent or temporary _____
The work proposed _____

Building Surveyor's report _____

Date _____ 191 _____

Building Surveyor.

Submitted through the Land Surveyor

LAND SURVEYOR'S REPORT.

Does the plot come under Alignment Portion of the plot
has been already been acquired.

Area of plot _____

Area under Alignment _____

Remarks

Sir, with reference to this I have to
report the plot is not subdivided as
yet. otherwise there seems no objection
to go ahead with.

Yours obed

Nathoo

Date 17-8- 1917.

Land Surveyor.

ORDERS OF THE ENGINEER.

No objection1.20/8/17

A. M. I. C. E.,

Engineer,

Karachi Municipality.

MUNICIPAL ENGINEER'S OFFICE

Karachi 191

A. M. I. C. E.,

Engineer,

Karachi Municipality.

Through

The CHIEF OFFICER & CHIEF ENGINEER.

KARACHI MUNICIPALITY.


RESOLUTION OF THE MANAGING COMMITTEE.

Resolution No. _____ dated _____




PLAN
SHOWING PROPOSED BUILDING ON
PLOT NO: 16 SITE A2
OLD TOWN QATER
SCALE 8 FT = 1 IN

GROUND FLOOR

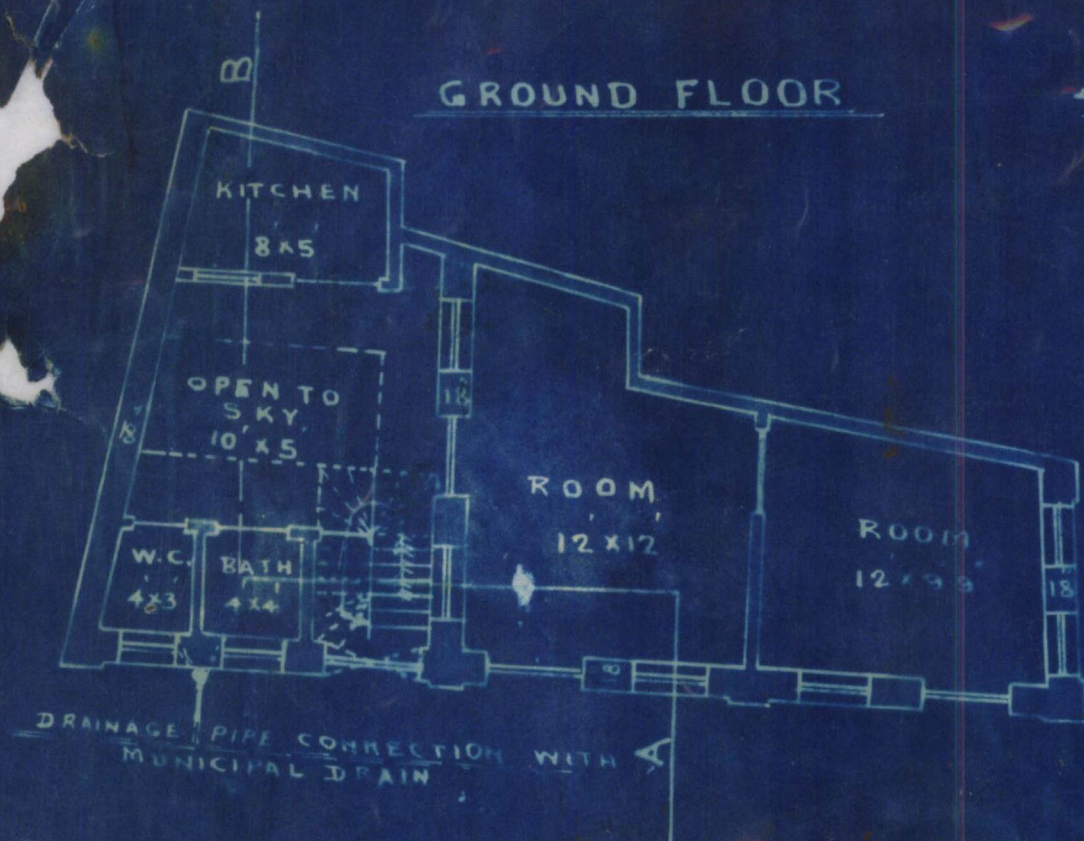


FIRST & 2ND FLOOR

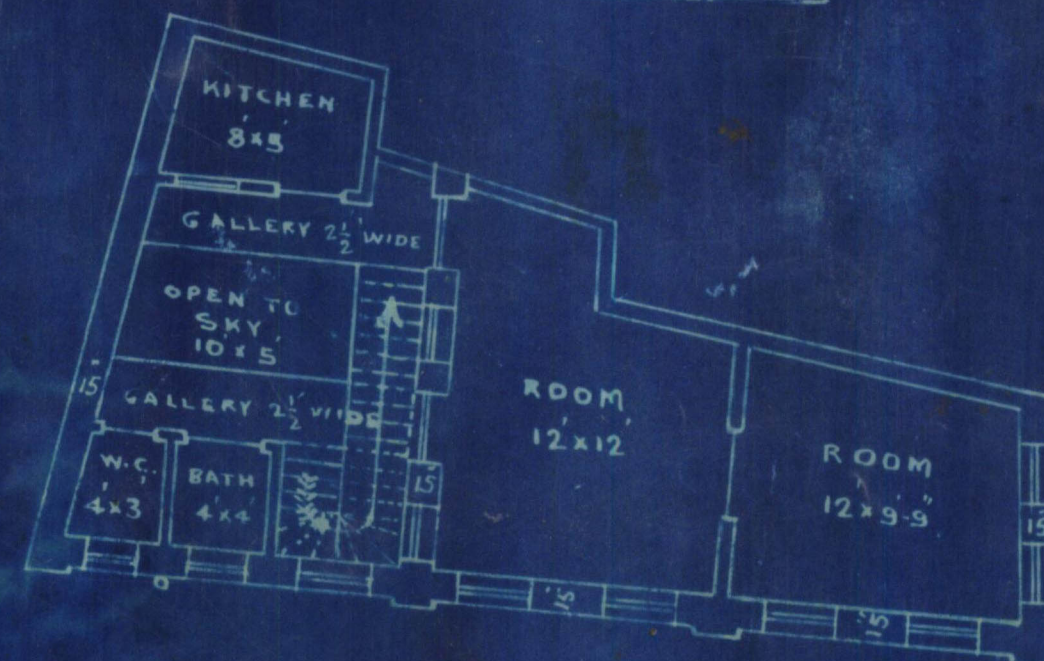

ELEVATION




SECTION B

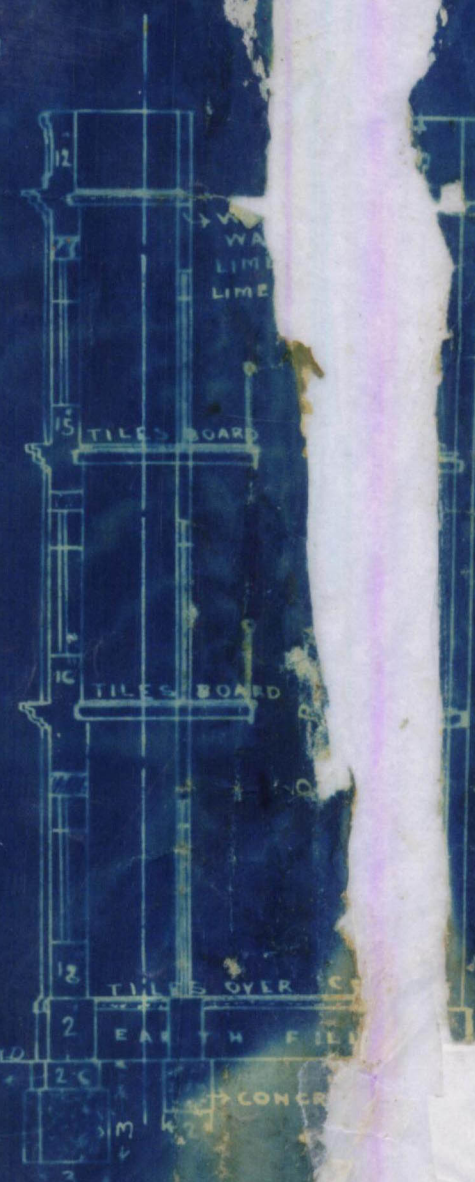

EXISTING
SITE PLAN


SCALE 20 FT = 1 INCH

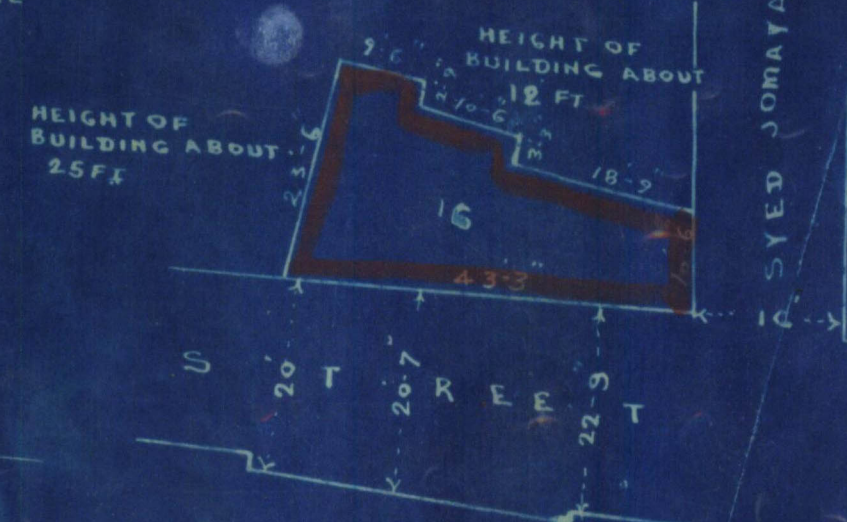


Architect & Surveyor
Karachi 12-2-17

PLAN
SHOWING PROPOSED BUILDING ON
PLOT NO: 16 S. A. 2
OLD TOWN QUARTER
SCALE 8 FT = 1" INCH

GROUND FLOOR

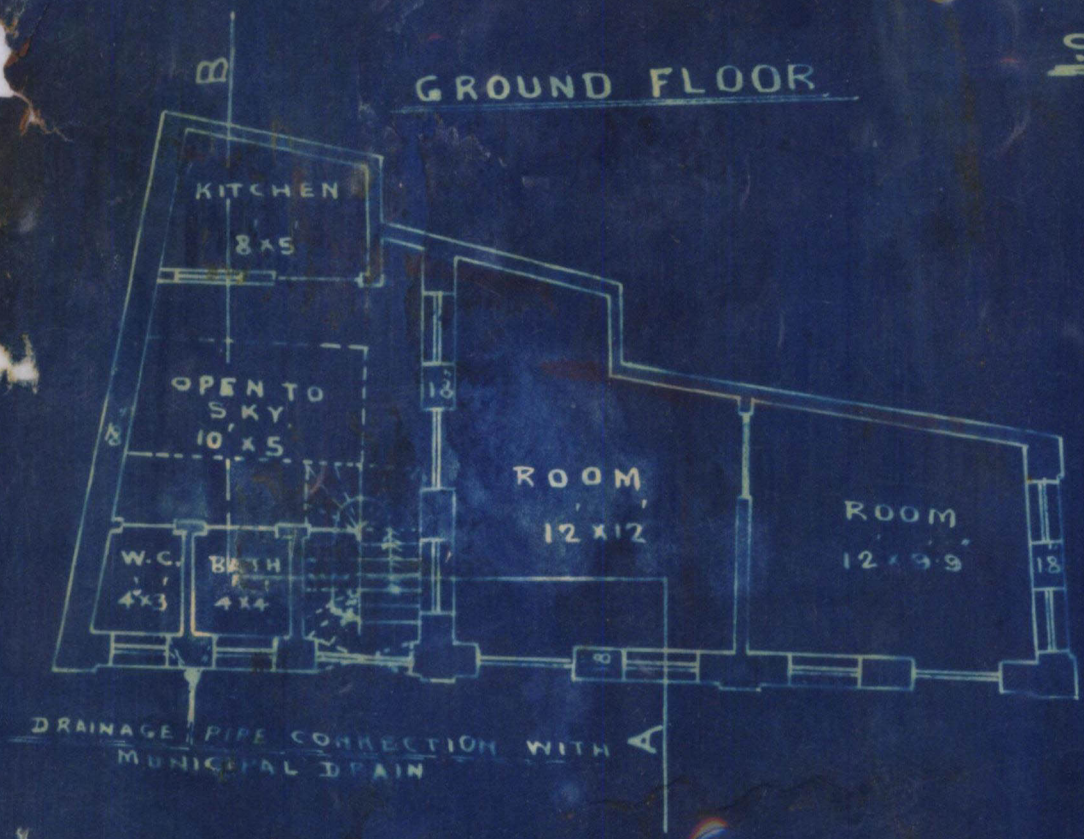


FIRST & 2ND FLOOR

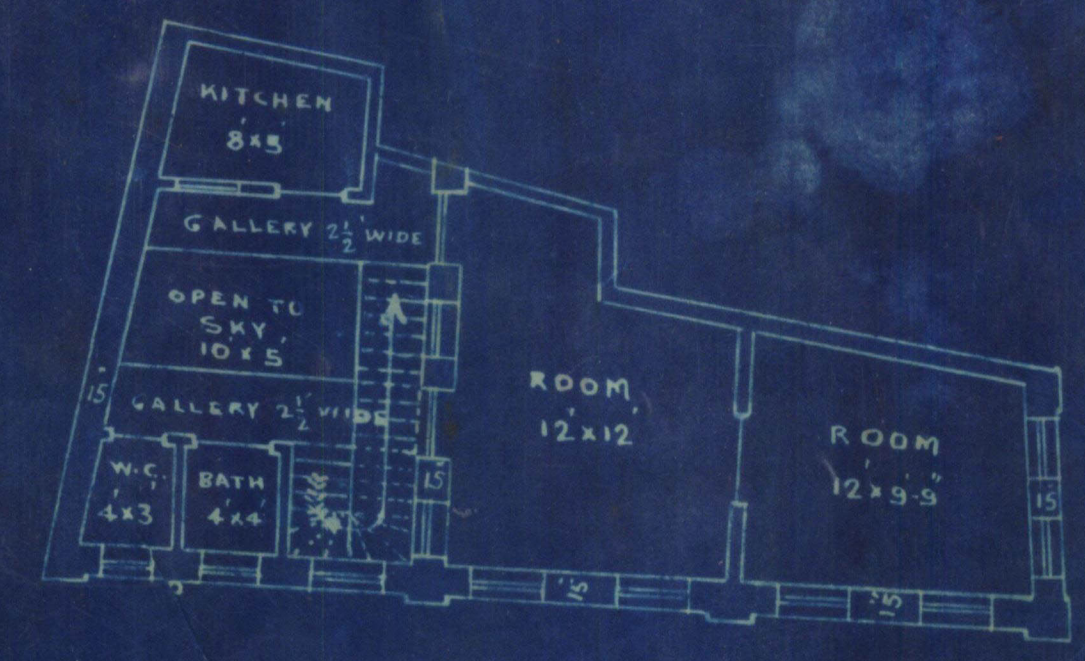


ELEVATION



SECTION

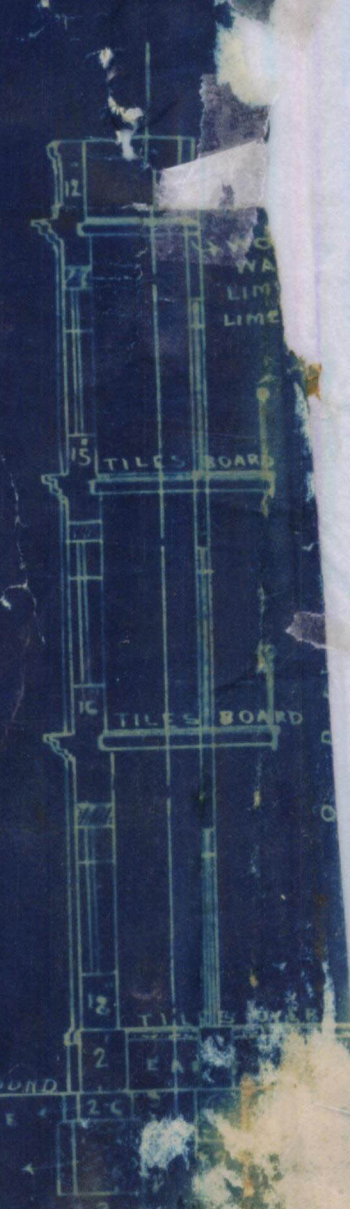


EXISTING
SITE PLAN
SCALE 20 FT = 1" INCH

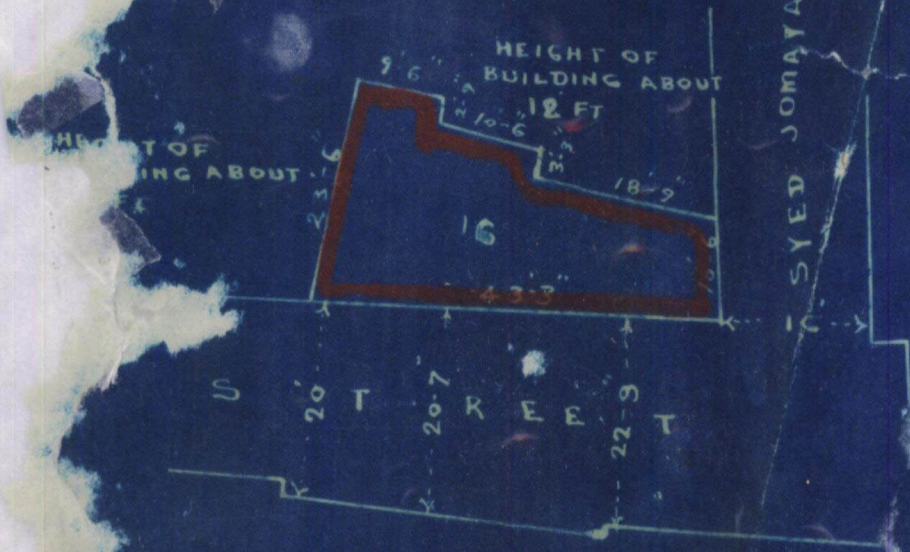

Architect Surveyor
Kamchi

PLAN N.A. 19
 SHOWING PROPOSED BUILDING ON
 PLOT NO. 15 AT THE CORNER OF
 OLD TOWN STREET AND WATG ROAD
 SCALE 8 FT = 1 INCH = 178 3/4 IN


GROUND FLOOR

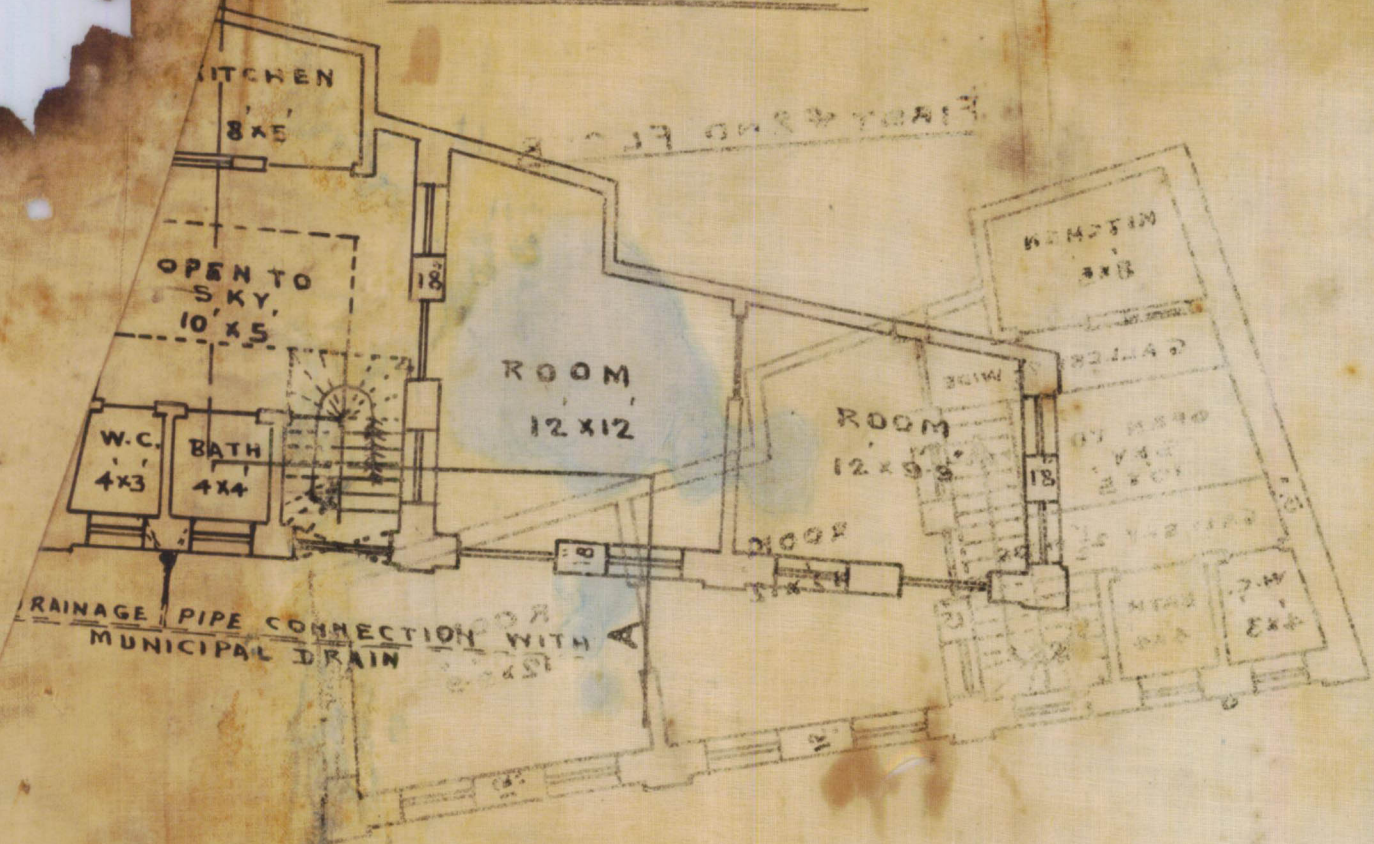


ELEVATION



SECTION CONCRETE

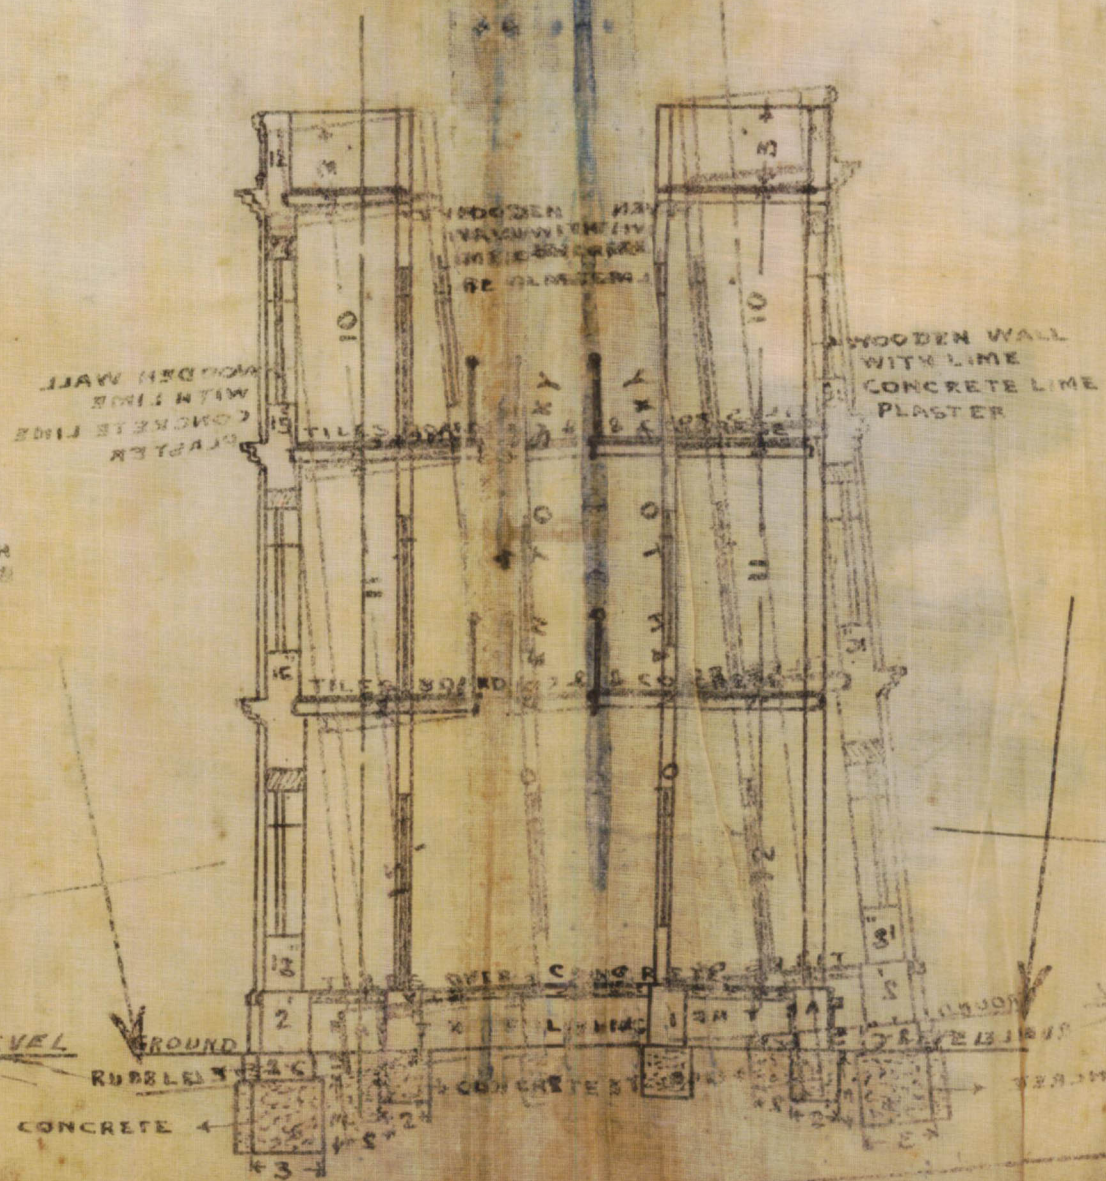

FIRST & 2ND FLOOR

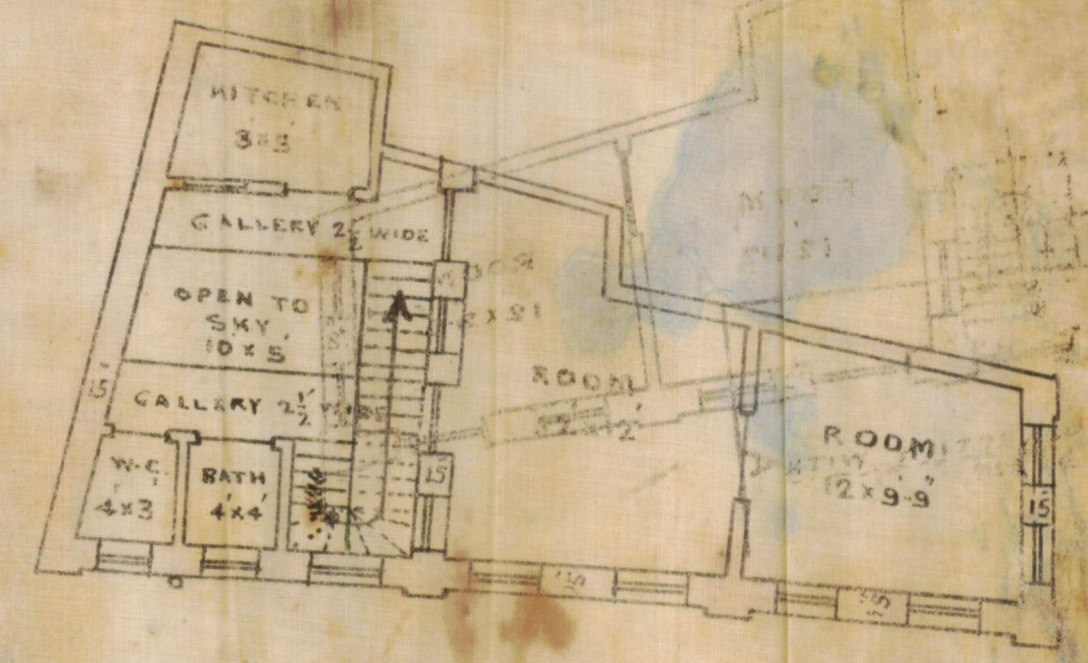

Architect & Surveyor
 Karachi 2-2-17