

BUILDING COMPLETION REPORT.

MUNICIPAL OFFICE,

Karachi, 20th / 11 / 1919

To,

THE ENGINEER,

KARACHI MUNICIPALITY.

SIR,

I beg to report that the building work on plot No. 2229229
sheet A2 Old Town Quarter owned by
Mr. Thamwadee Hengraj is completed
according to the plan approved by this office.

Yours obediently,

File
Mull 20
11

Bravani
Building Surveyor, A.T.B. Section,
Karachi Municipality.

2-1

No: W/ 3758 of 1919.

Superintendent of Machinery's Office.


Karachi, 11th November 1919.

M E M O / -

Mr: Thanwerdas Hemraj, owner of plot No: 222 & 223, A-2, Old Town Quarter is requested to provide a storage tank and pump, when he intends to fit water closet pans to the 1st & 2nd floor. *to flush them*



D.K.C.

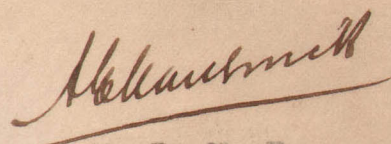

M. I. M. E.

Superintendent of Machinery,
Karachi Municipality.

10/06


No: W/ 3759 of 1919.


Superintendent of Machinery's Office

Karachi, 11th November 1919.

Copy forwarded to the Acting Engineer for information.

F. C. is herewith returned.

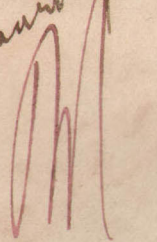Landsurveyor

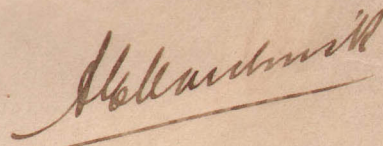


M. I. M. E.

Superintendent of Machinery,
Karachi Municipality.



Building Surveyor B for

information

Nathan

13/11/19

Letter received from
Chief Engineer
to the W.C. showing
plans of water
discharge of water
on the corner
of the building
this letter is
better in the

No: W 3797 of 1919

Superintendent of Machinery's Office

Karnachi, 11th November 1919.

Copy forwarded to the Acting Engineer for information.

F. C. is herewith returned.

M. I. M. E.

Superintendent of Machinery,

Karnachi Municipality.

Letter received from
Chief Engineer
to the W.C. showing
plans of water
discharge of water
on the corner
of the building
this letter is
better in the



3705
22/10

3-1



No: W/ 3525 of 1919

Superintendent of Machinery's Office.

Karachi, 16th October 1919.

18

20/10/19

With reference to the Acting Engineer's No.

E. 2299 dated 29th October 1918, undersigned the

honour to inform him the owner of No. 229, A-1,

Old Town Quarter does not desire to fit the water closets on the first & second floor at present.

There is no objection to the water closets being fixed up on 1st and 2nd floor but to shortage of water to the owner himself wants to put in this water supply better

There is no objection to the water closets being fixed up on 1st and 2nd floor but to shortage of water to the owner himself wants to put in this water supply better

Superintendent of Machinery,
Karachi Municipality

D. K. C.

Forwarded to the Land Surveyor

20
Hall To

20/10/19
20/10/19
the paper for J. & report.

Nathan

22/10/19.

Sir

With respect to the
Suez to report that
there is no objection
to the W.C.'s being
fixed upon 1st and
2nd floor due to
shortage of water
as the owner himself
wants to put in in
this bldg. It is
better on the contrary
L.O.

Yours truly

J. J. J. J. J.
B.S.B.

28/10/19.

W 5240
3.11.19

Submission to the
3.11.19 as Engineer for
work.

Nathan
28/10/19

Whereas H. please send

At. 20/10

Submitted with the
plan for favour of reference

31/10/19
submitted to
the as Engineer for work.
In case of any mistake, report
take sent for. Nathan

D. Inspector for 3/10/19

all +



4

NO. 179

(200-7.12.17.)

Form No. 6.

No. E. 2297 191

MUNICIPAL ENGINEER'S OFFICE,

Karachi, 29th Oct. 1918.

MEMO.

Building Inspector Peelian "B" is informedthat Mr. Thamerdas Hemraj has been permittedto build his houseon plot No. 2222 + 229 A2, Street, Old Town

Quarter. Report should be made to the undersigned when the house

completed.

H. H. H. H. H.

A.M. INST. C.E.,


Engineer,

Karachi Municipality.

P



WEST ELEVATION

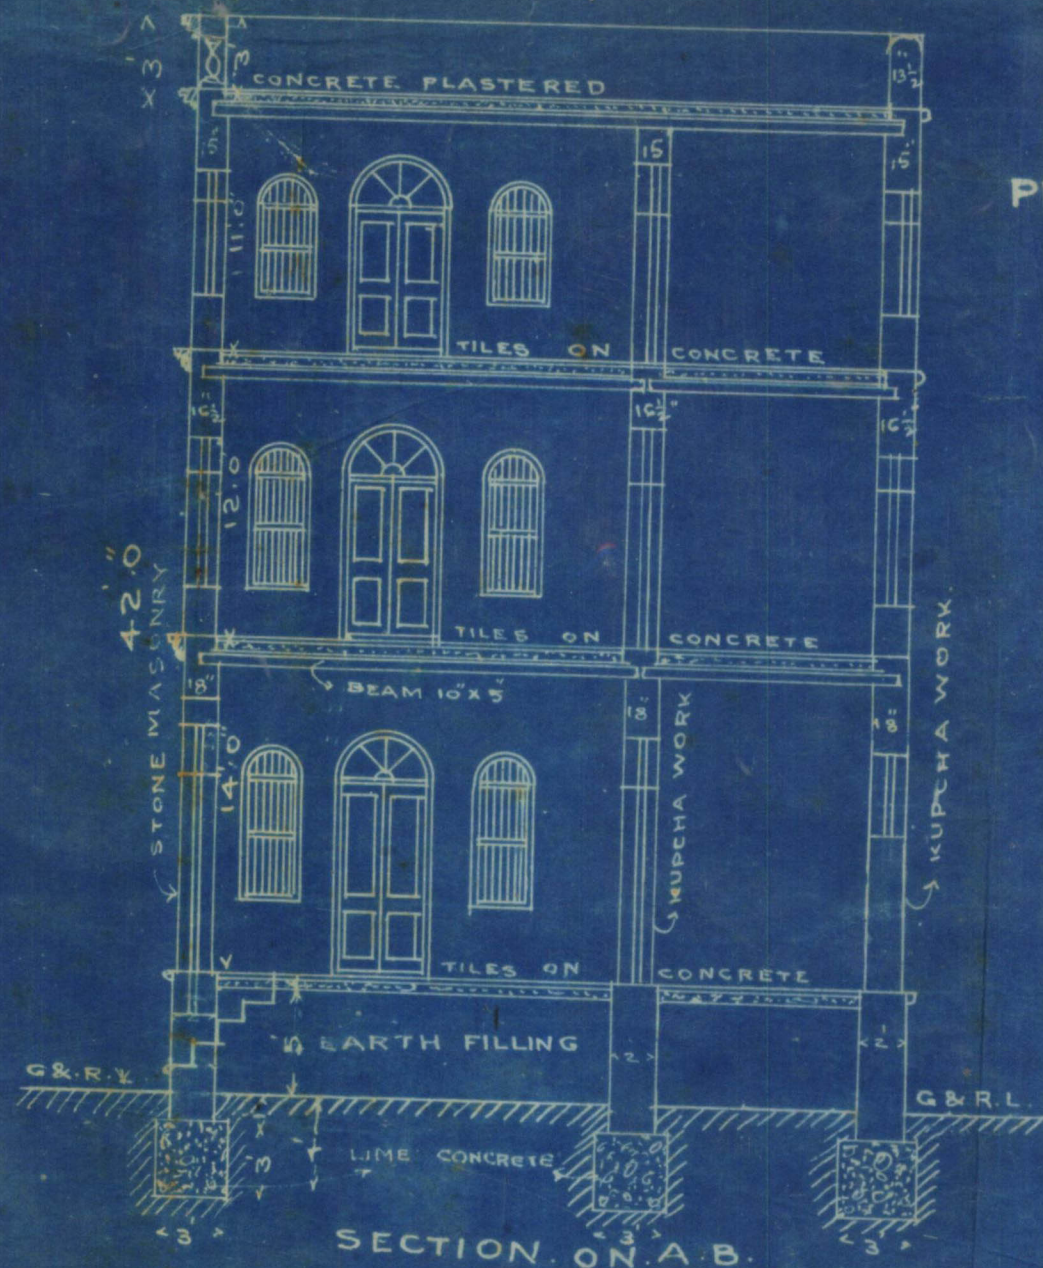


SECTION ON A.B.

PLAN OF
PROPOSED BUILDING ON PLOT N^o 222.8223
SHEET A-2 OLD TOWN Q8
SCALE 8"=1'

M. K. Nayak
12th Aug. 18
B.A., L.C.E.
ARCHITECT & ENGINEER

BLOCK PLAN


SCALE 20"=1'

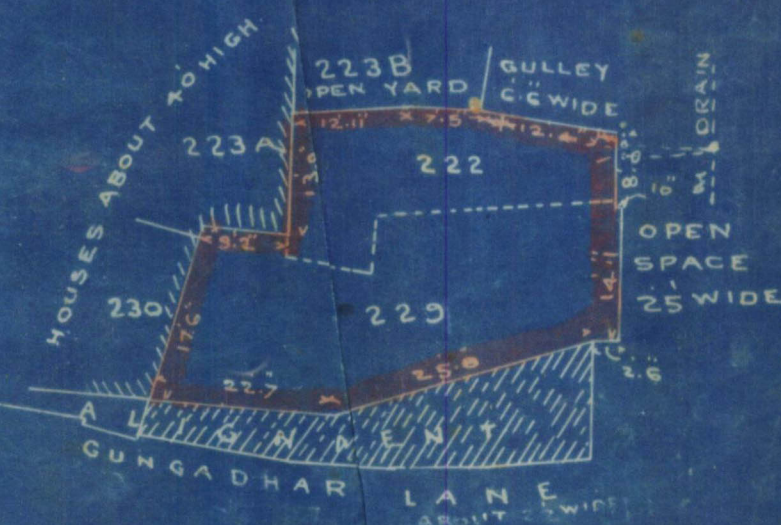

Thawade Henry



PLAN OF GROUND FLOOR
GUNGADHAR LANE ABOUT 22' WIDE

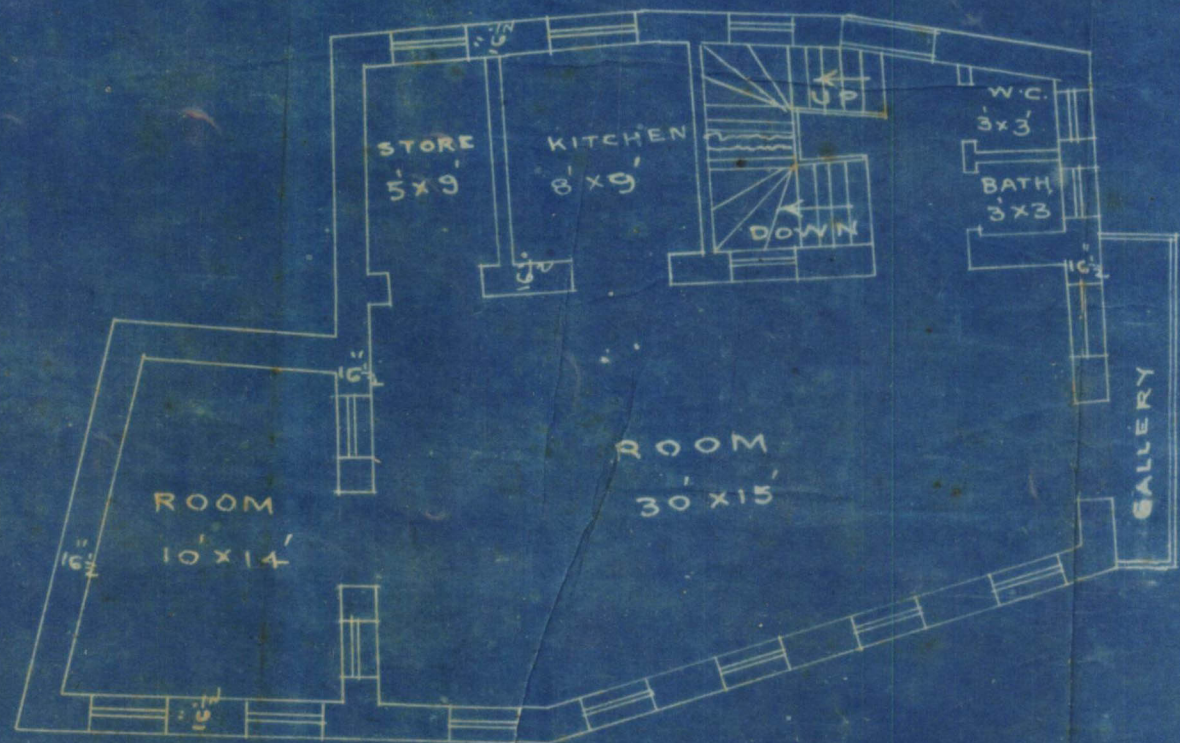

2nd
PLAN OF 1st FLOOR