


PLAN OF BUILDING

ON PLOT No 6/1 SHEET FIS SUDDER BAZAR Q8


SCALE 8 FT = 1 INCH

No. 30

GROUND FLOOR

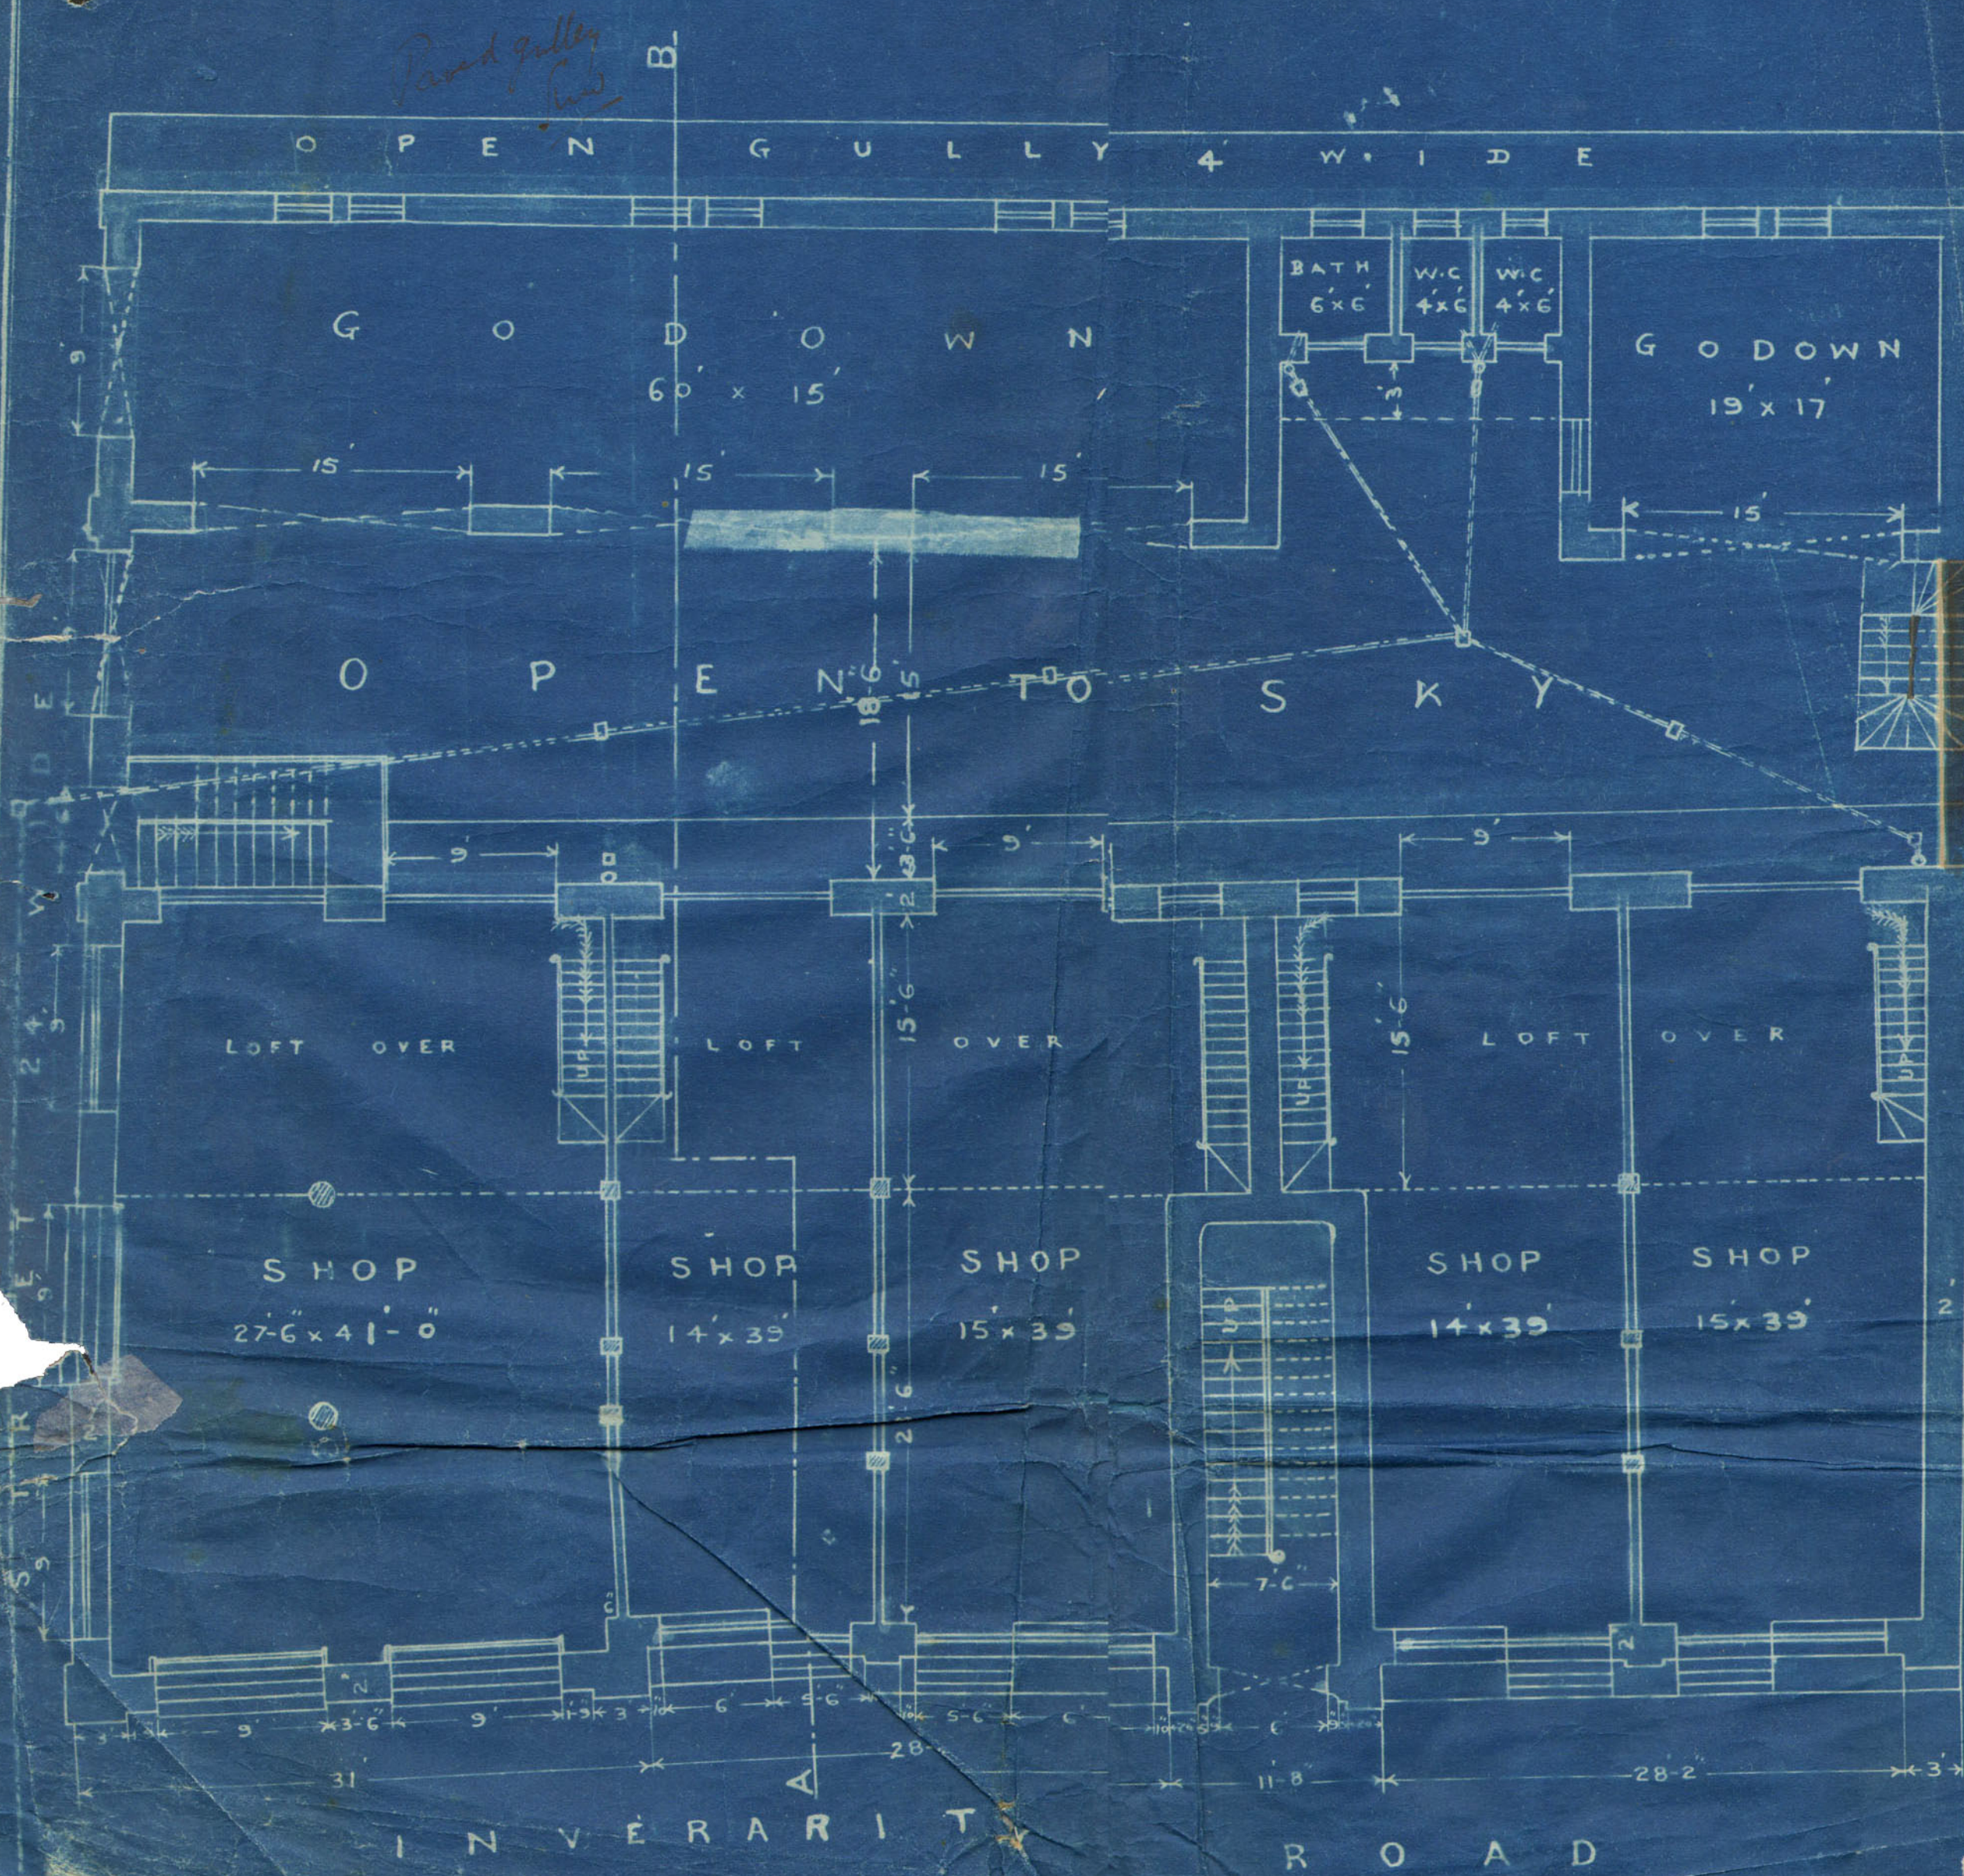

FIRST & SECOND FLOOR

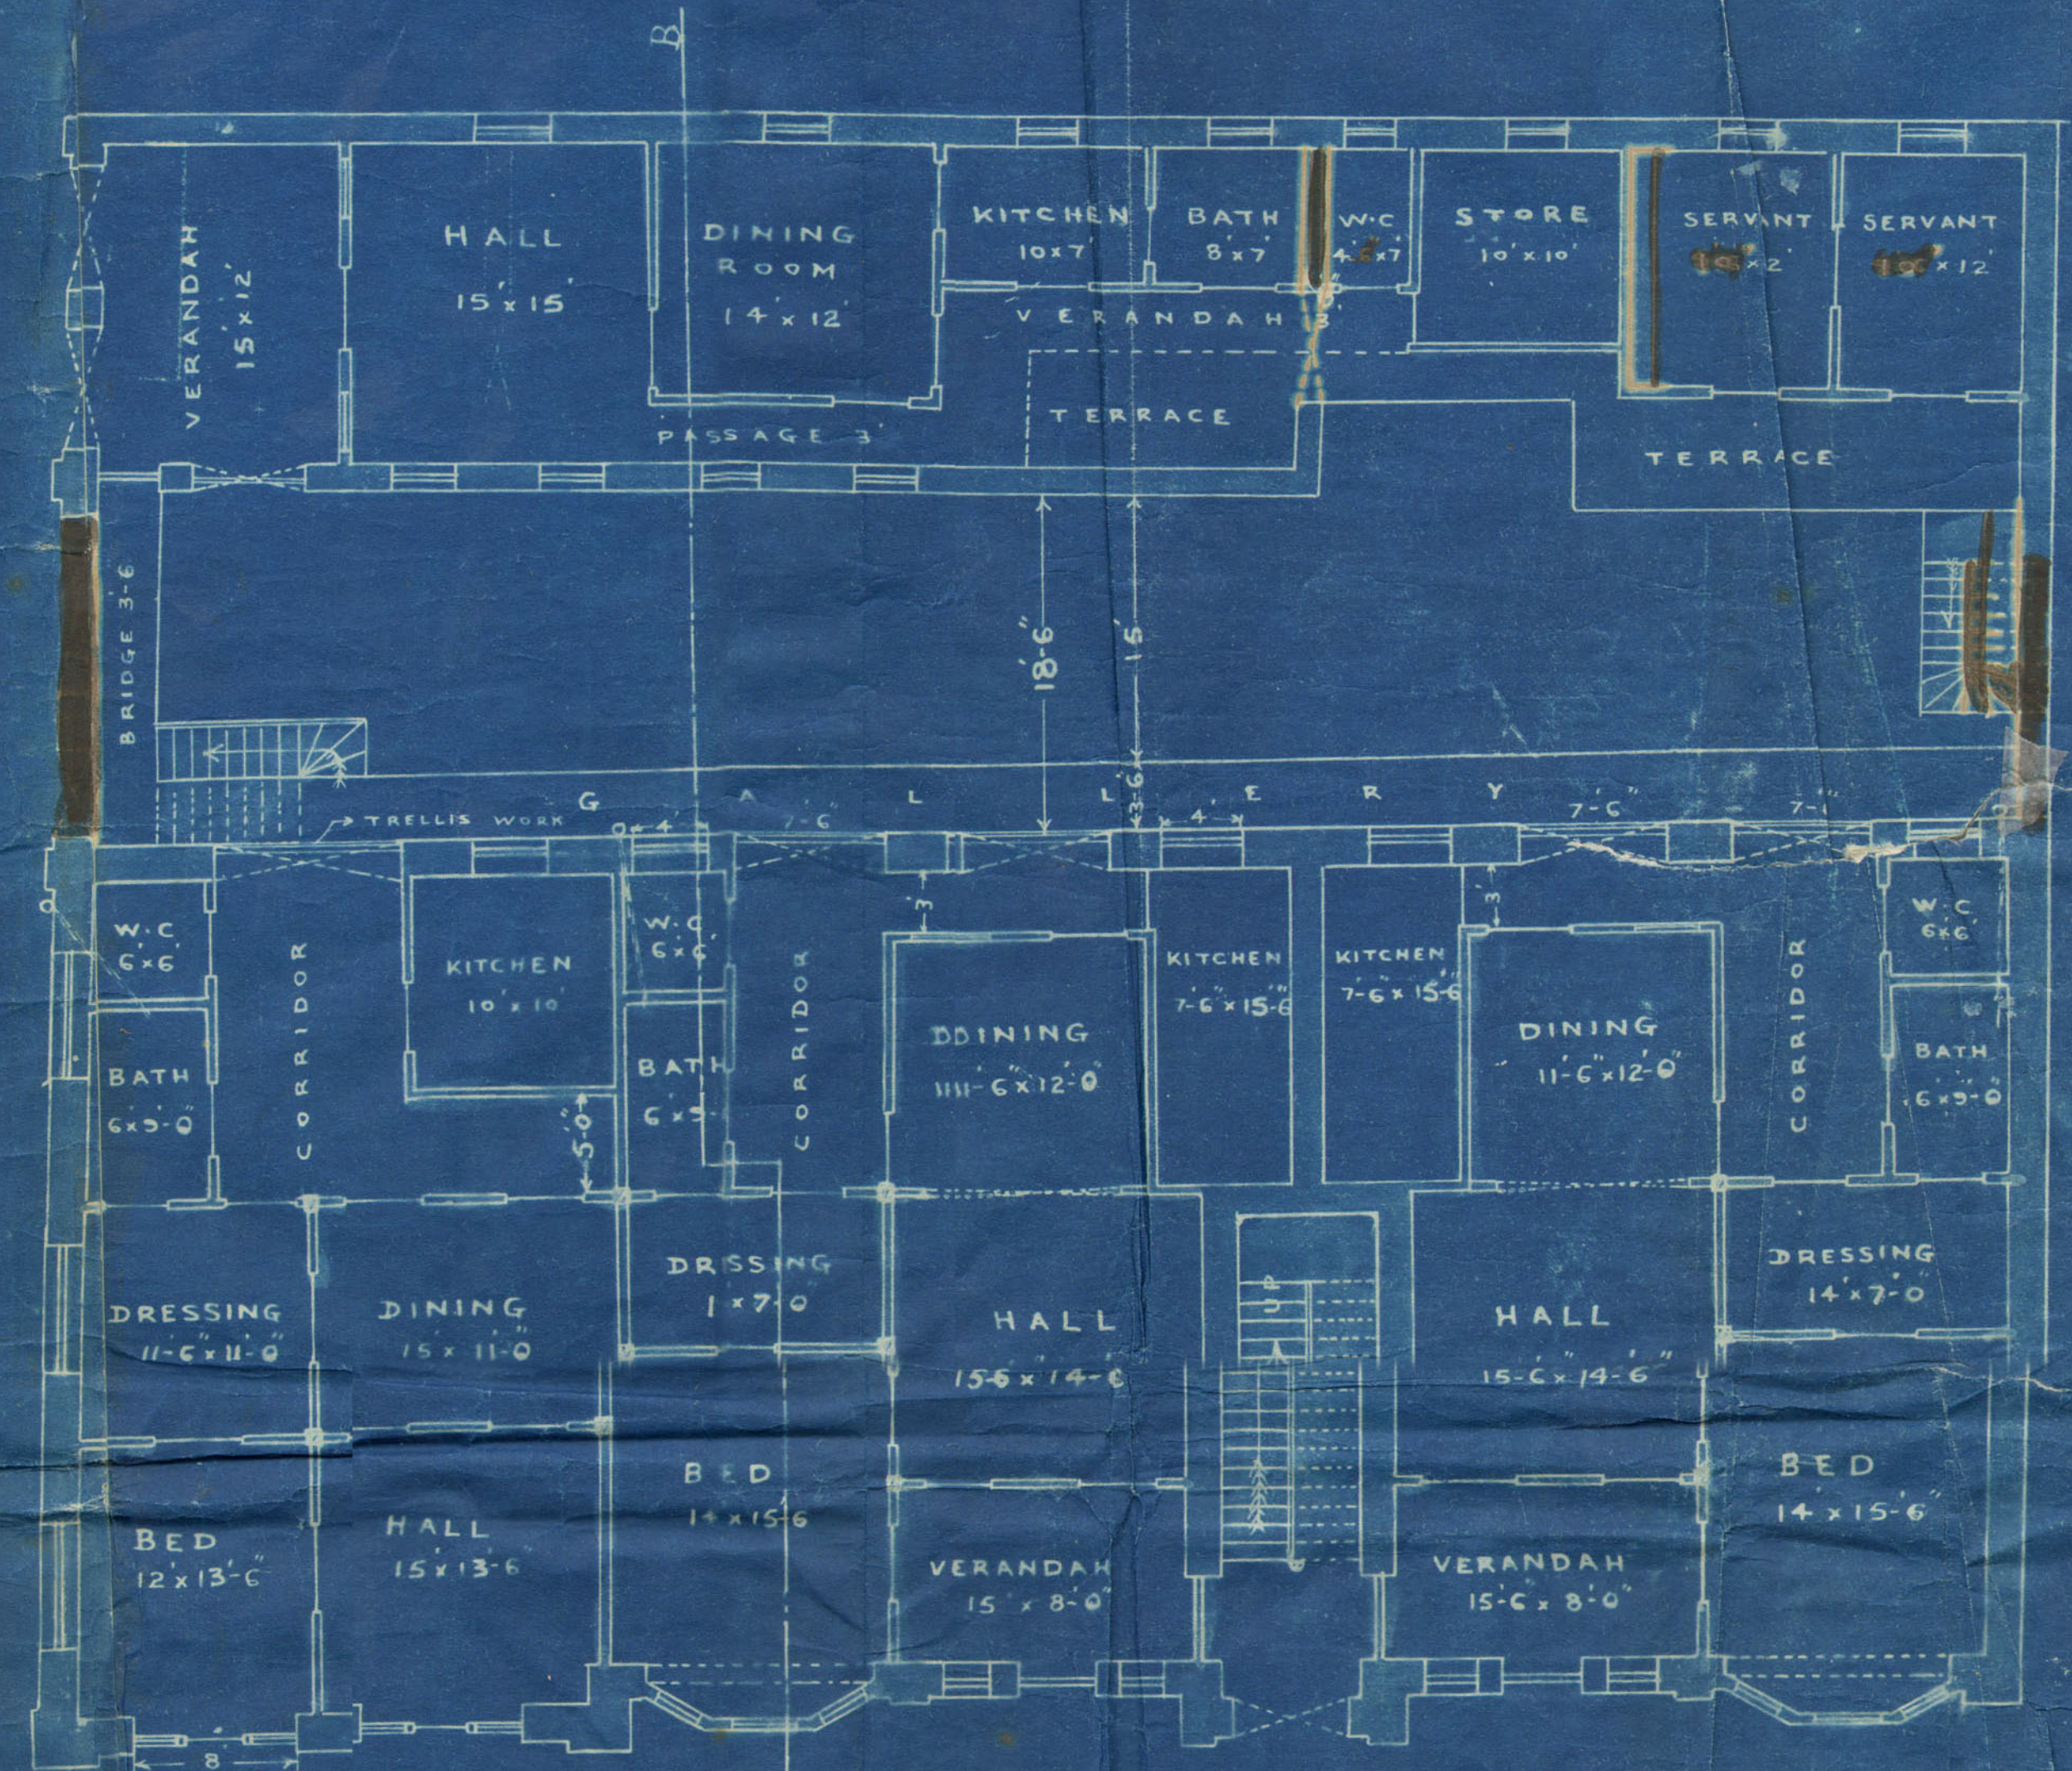



APPROVED

Handwritten signature
Handwritten signature
 KARACHI 12-11-1918

*A amended plan
of Building on plot No 6/1 sheet
Sudder Bazar Quarter
Scale 8=1"*

Ground Floor

First Floor

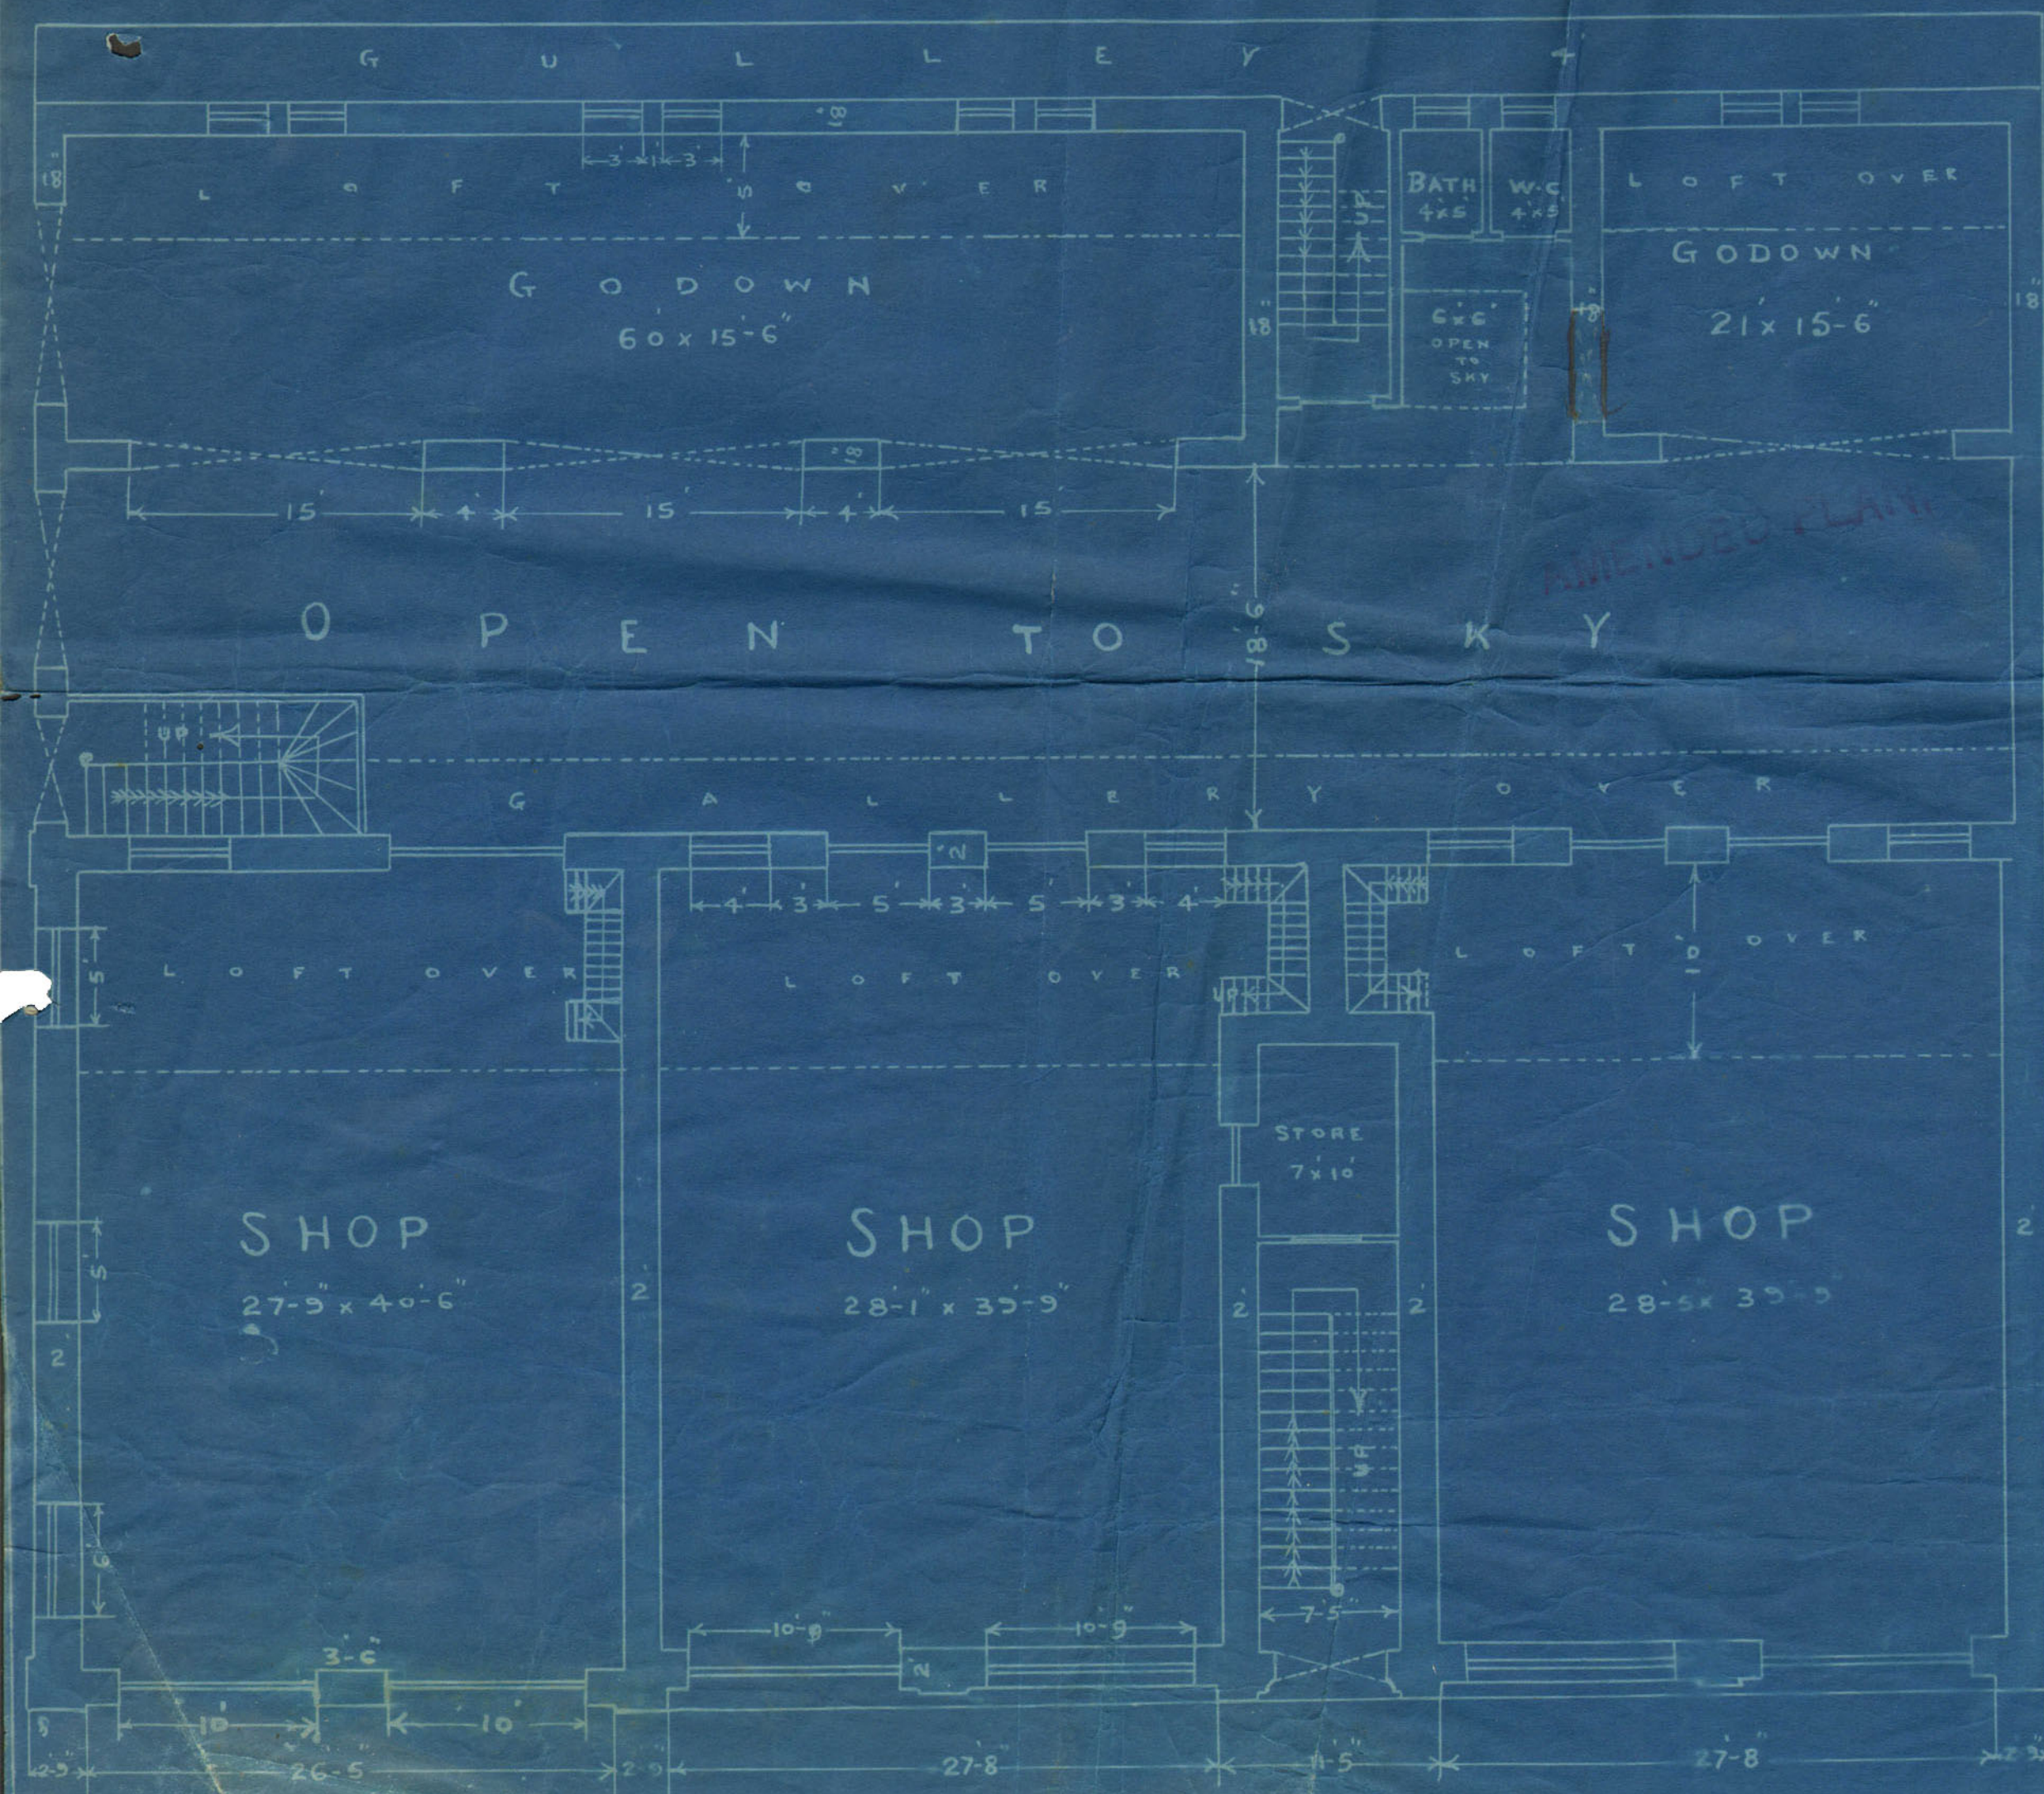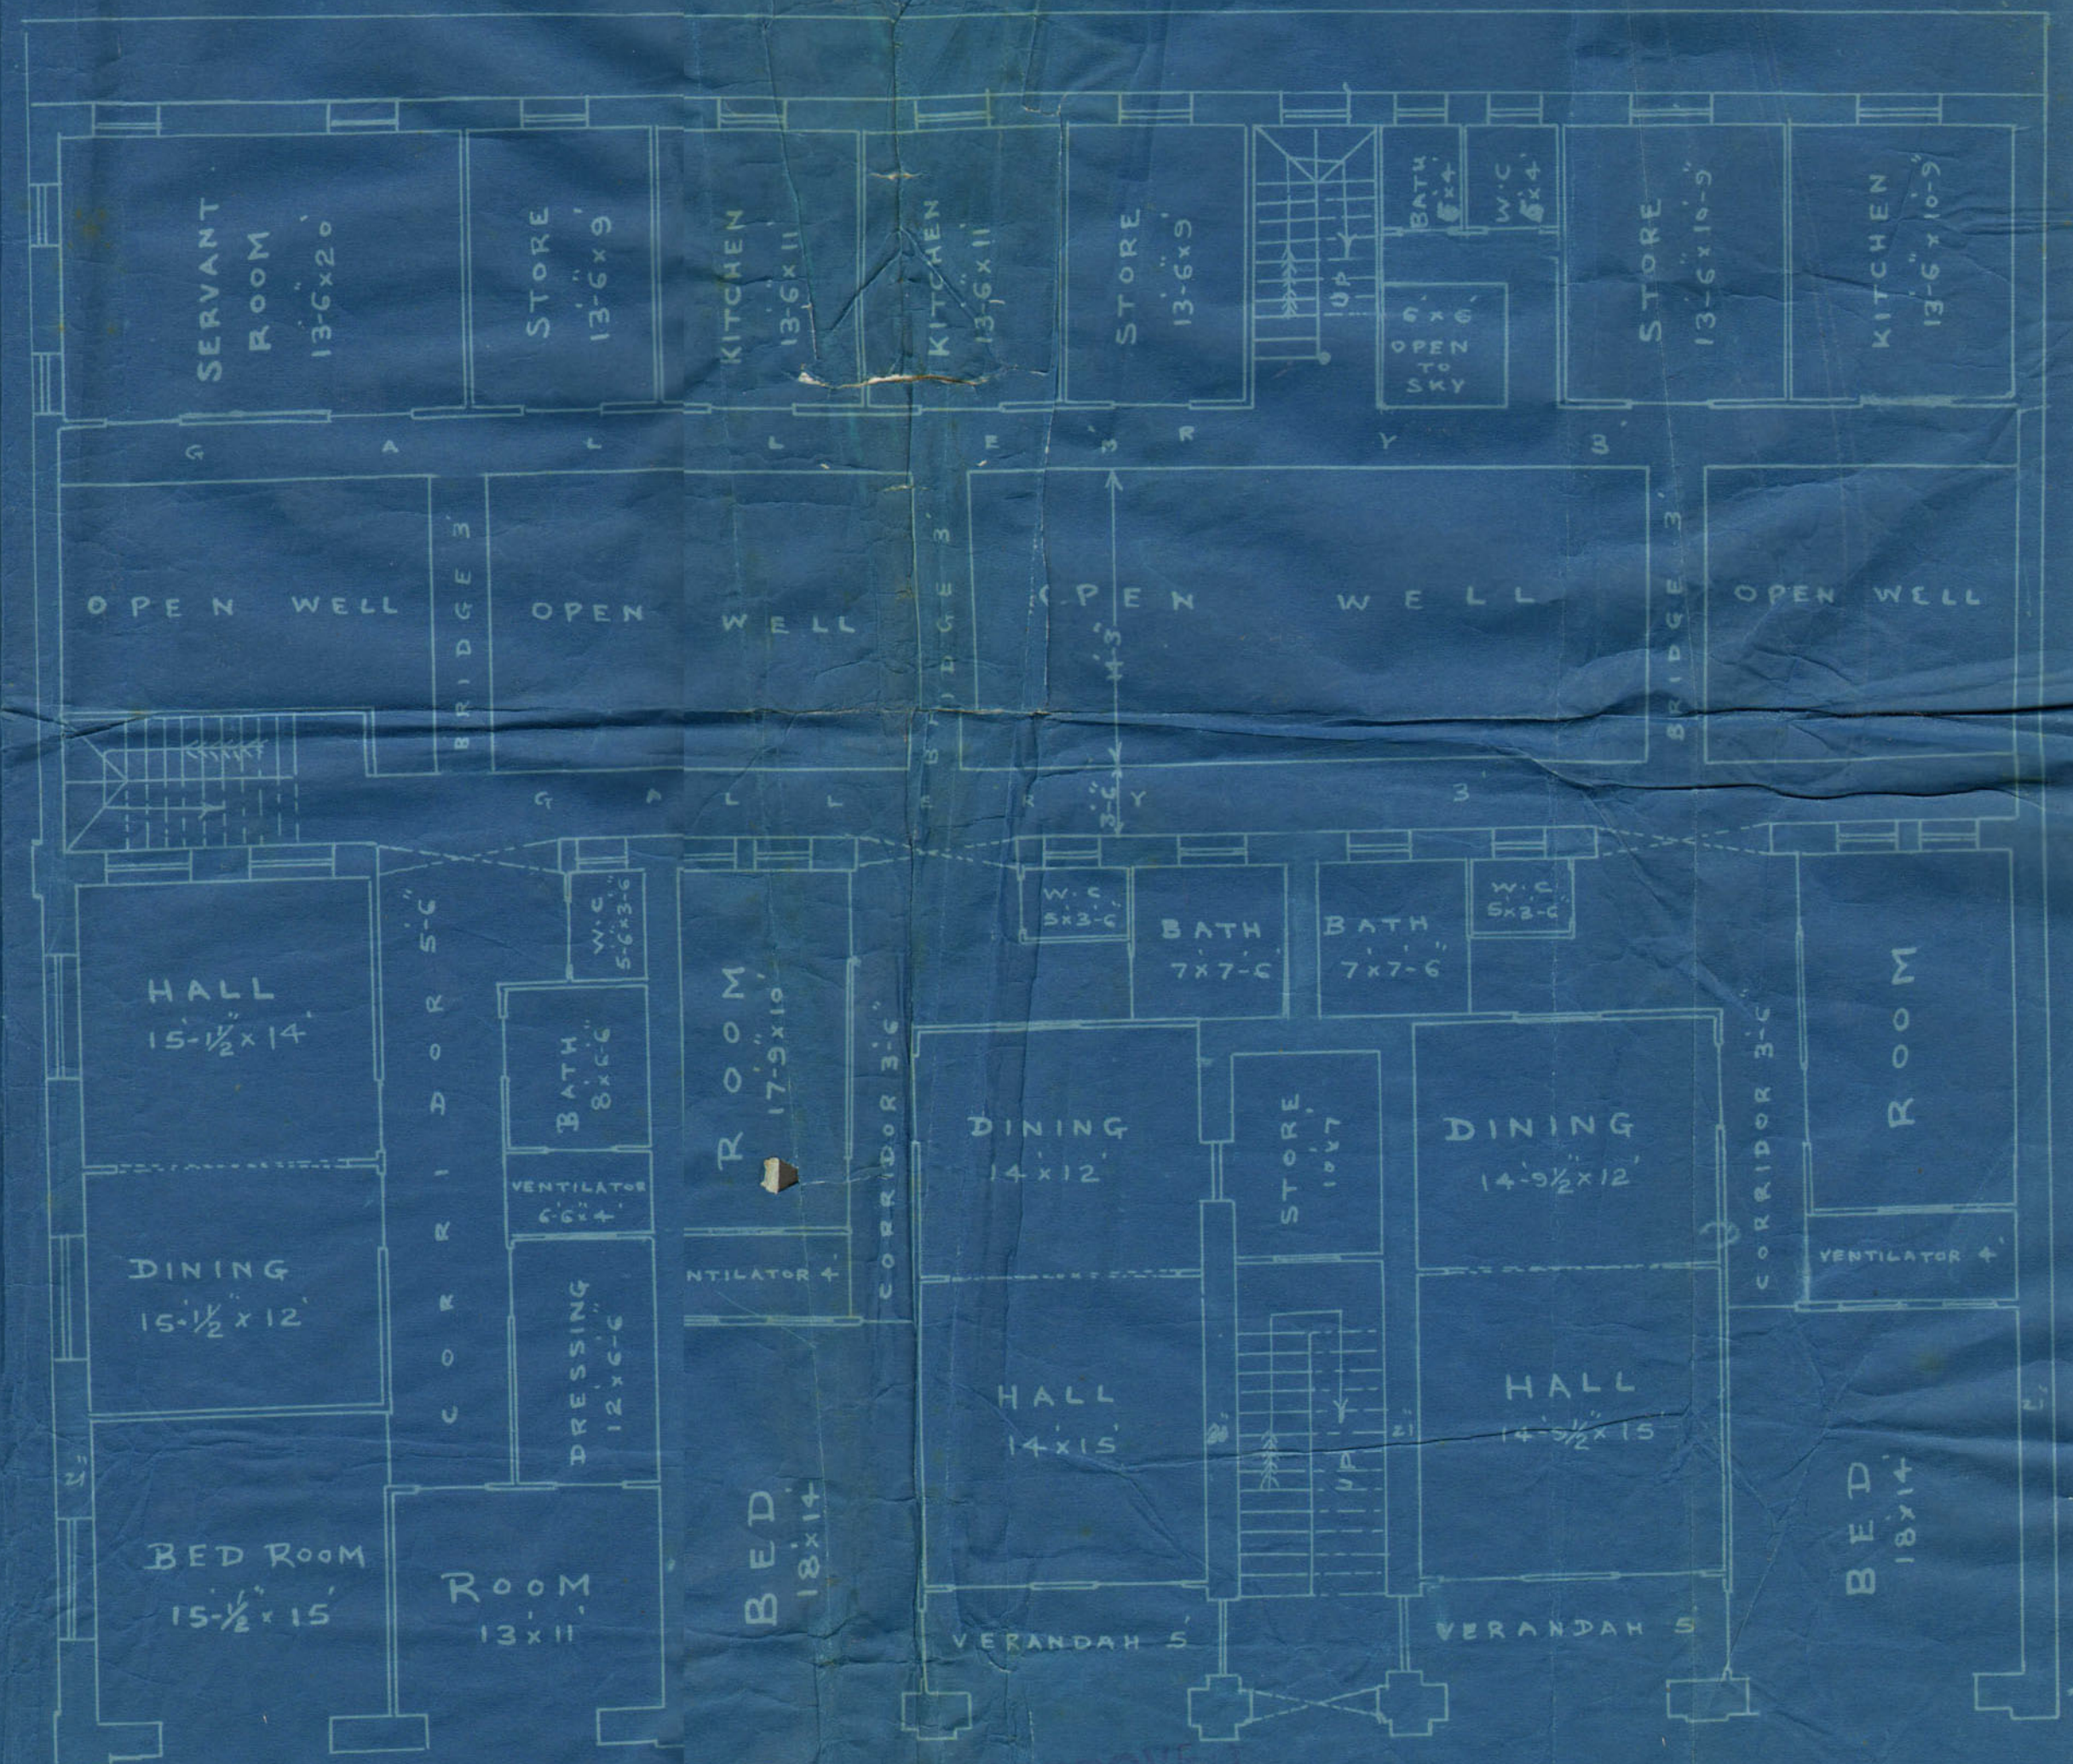

*APPROVED
H. M. M. M.*

*H. M. M. M.
ARCHITECT*

K A R A C H I

12. 7. 13

The Engineer

Karachi Municipality

Sir,

I beg to submit herewith two copies of emended plan of my building on plot No: 6/1 sheet F 15 Sudder Bazar quarter for favour of approval. I shall feel obliged by early permission.

I beg to remain

Sir

Your most obedient servant

Pandit Karam

No objection
14/7/13





Sir

With respect to
 this I beg to report -
 that there is / no
 objection to the
 plan as submitted
 but there is only one
 servants Rm provided
 between three tenements
 in place of two already
 shown in approved plan. R.O.
 Your obdtly.
 J.S. Jagan.
 P.S.A.

14/11/19.

Submitted to the Engrs
 for order. order was
 should be of stone
 & more servants Rm
 required.

Nachi

14
7/3

Insufficient servants
 quarters

Attn 15
 7

memo.

16/7/19.

16

With reference to his application with ^{consent} plan received on 14/7/19. re bldg on plot No 6/1, P₁₅-Saddan Qtr. Mr Shamdas Kodummal is informed, that the plan as submitted is approved and a copy of it is herewith forwarded to ^{him} ~~them~~ duly signed & approved to build according to the plan

M. S. S. S.

P2



No. L.S. 3714 of 1919.

Municipal office,

Karachi 18th July 1919.

Memo,

With reference to his application with amended plan received on 14th July 1919 regarding building on plot No. 6/1, F-15 Sadar Bazar Quarter Mr. Shamdas Kodanmal is informed the plan as submitted is approved and a copy of it is herewith forwarded to him duly signed and approved to build according to the plan.

M. I. M. E.,

Ag: Engineer,

Karachi Municipality.



for

*Amended plan
of Building on plot- No 6, Sheet F 15
Subber Bazar Quarter
Scale 8"=1"*

APPROVED
M. K. S. S. S.

SECTION ON A.B.

SECTION ON C.D.

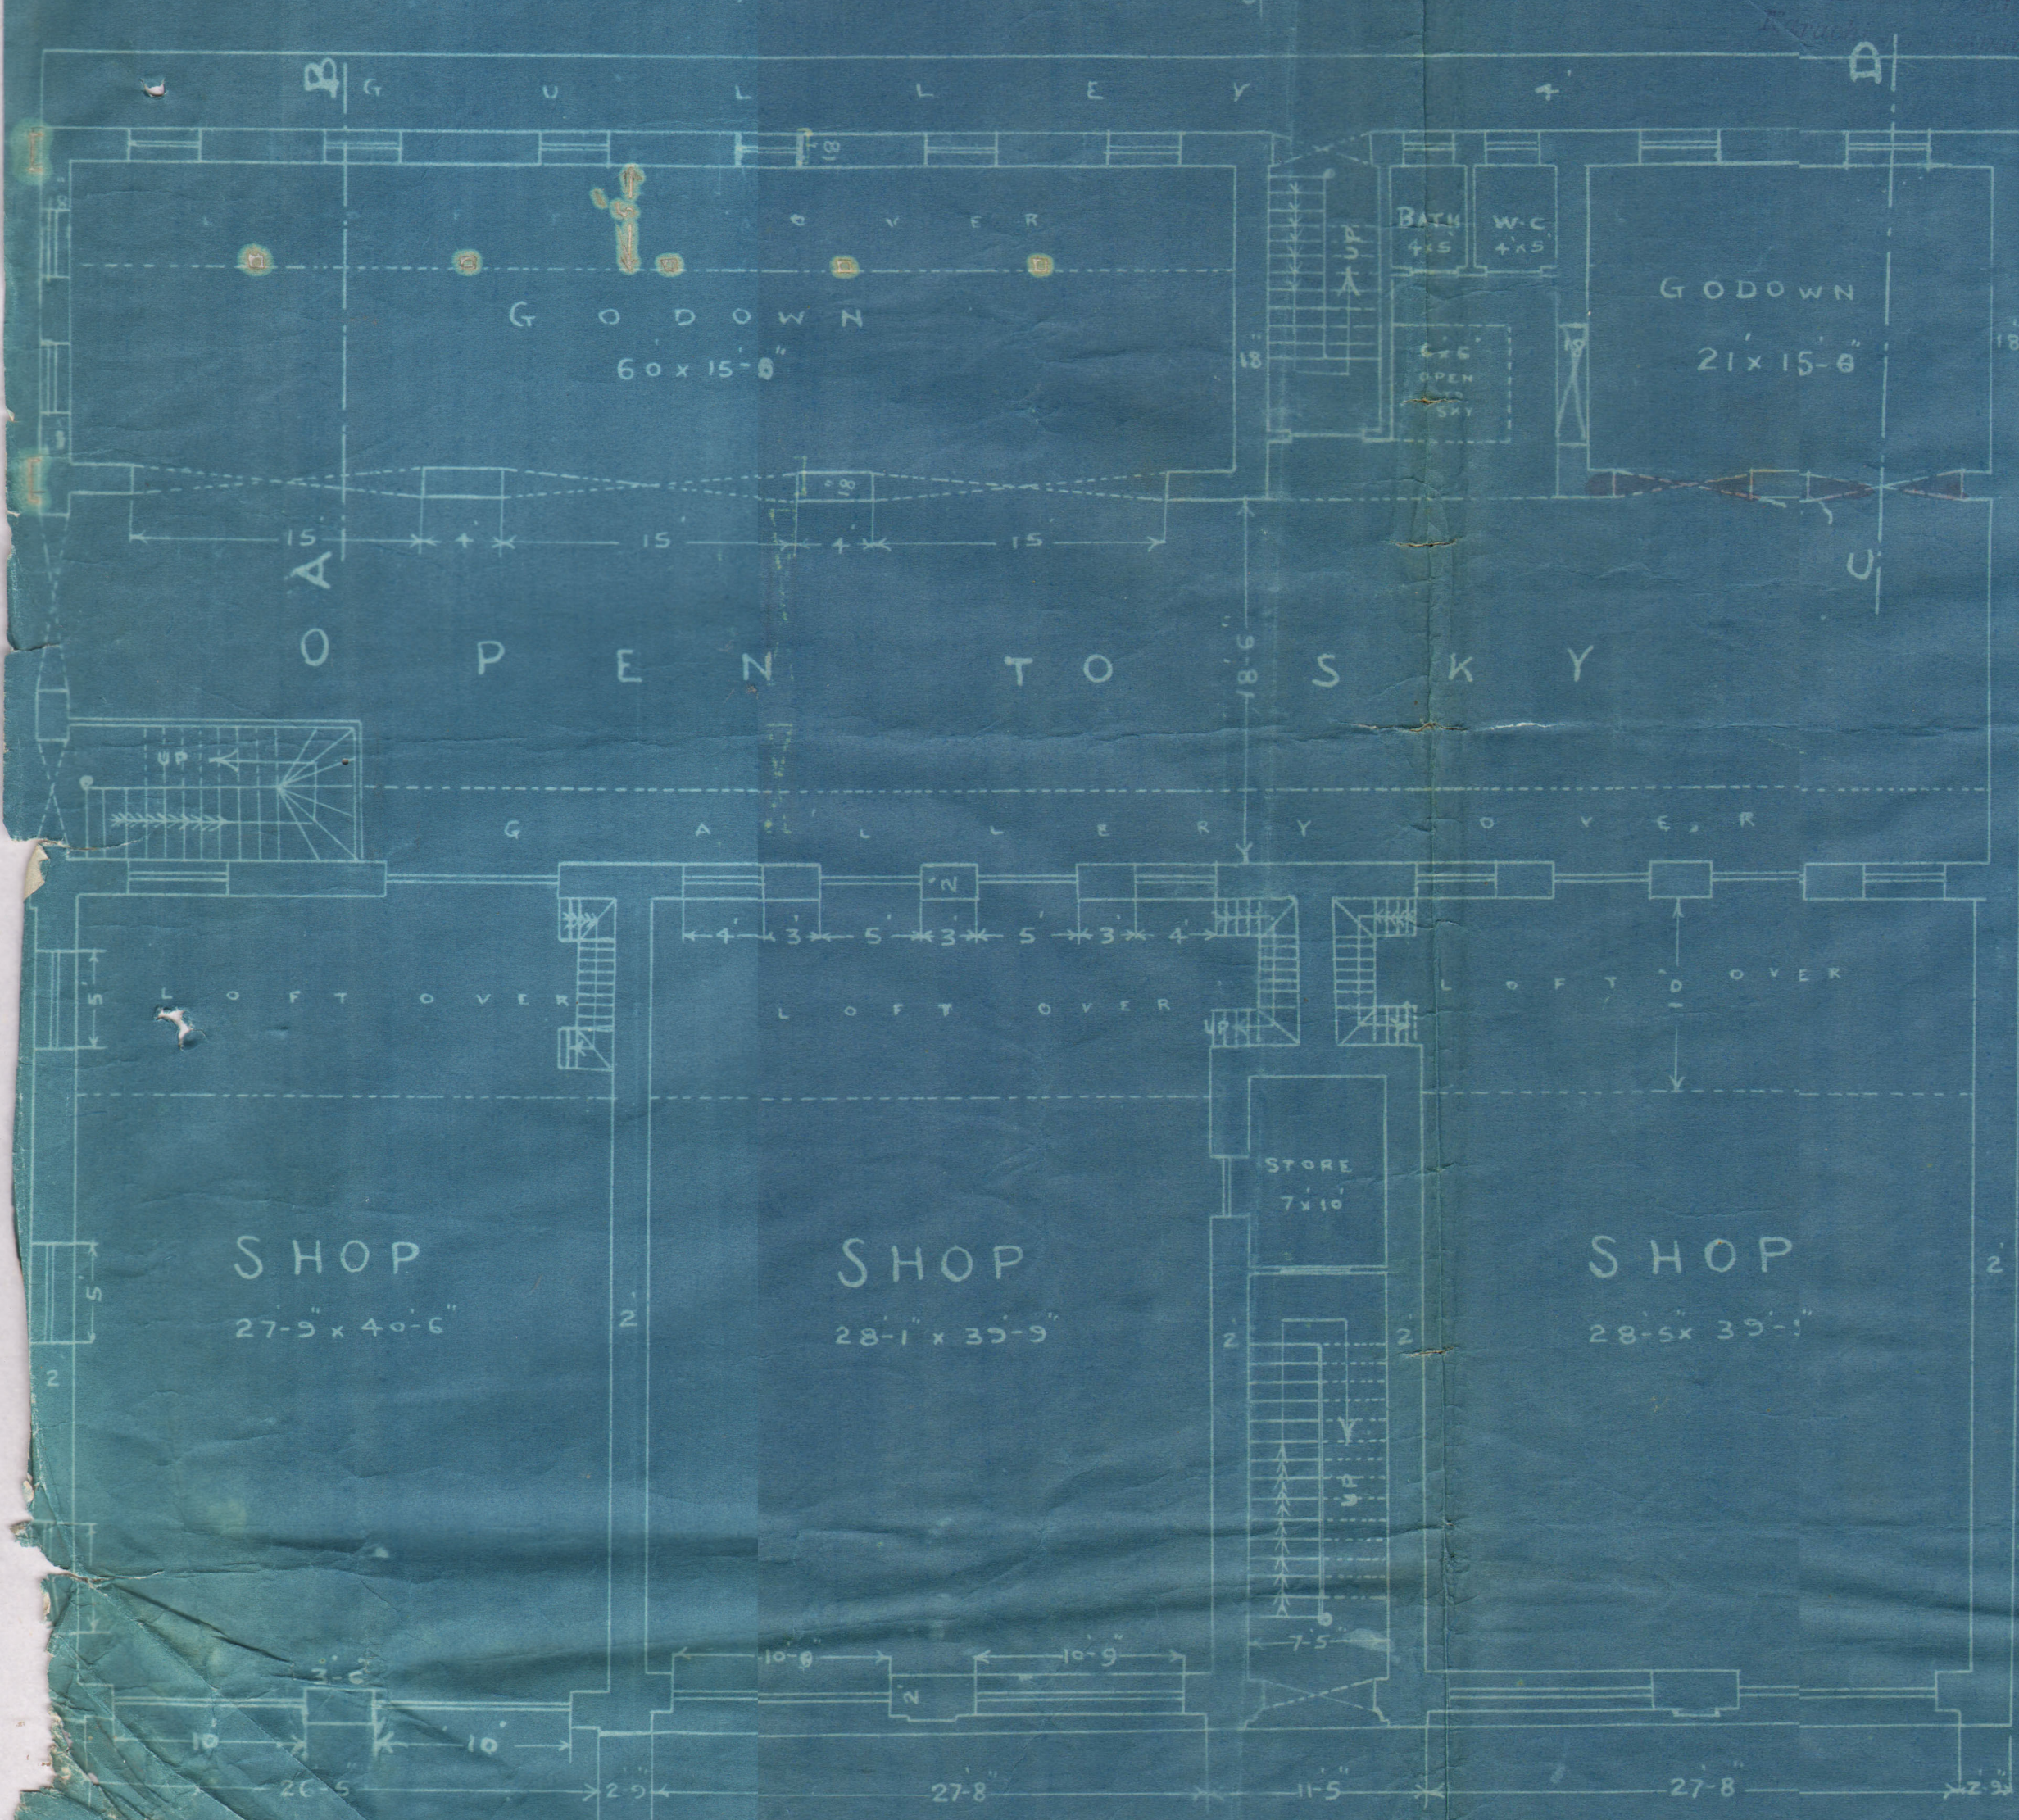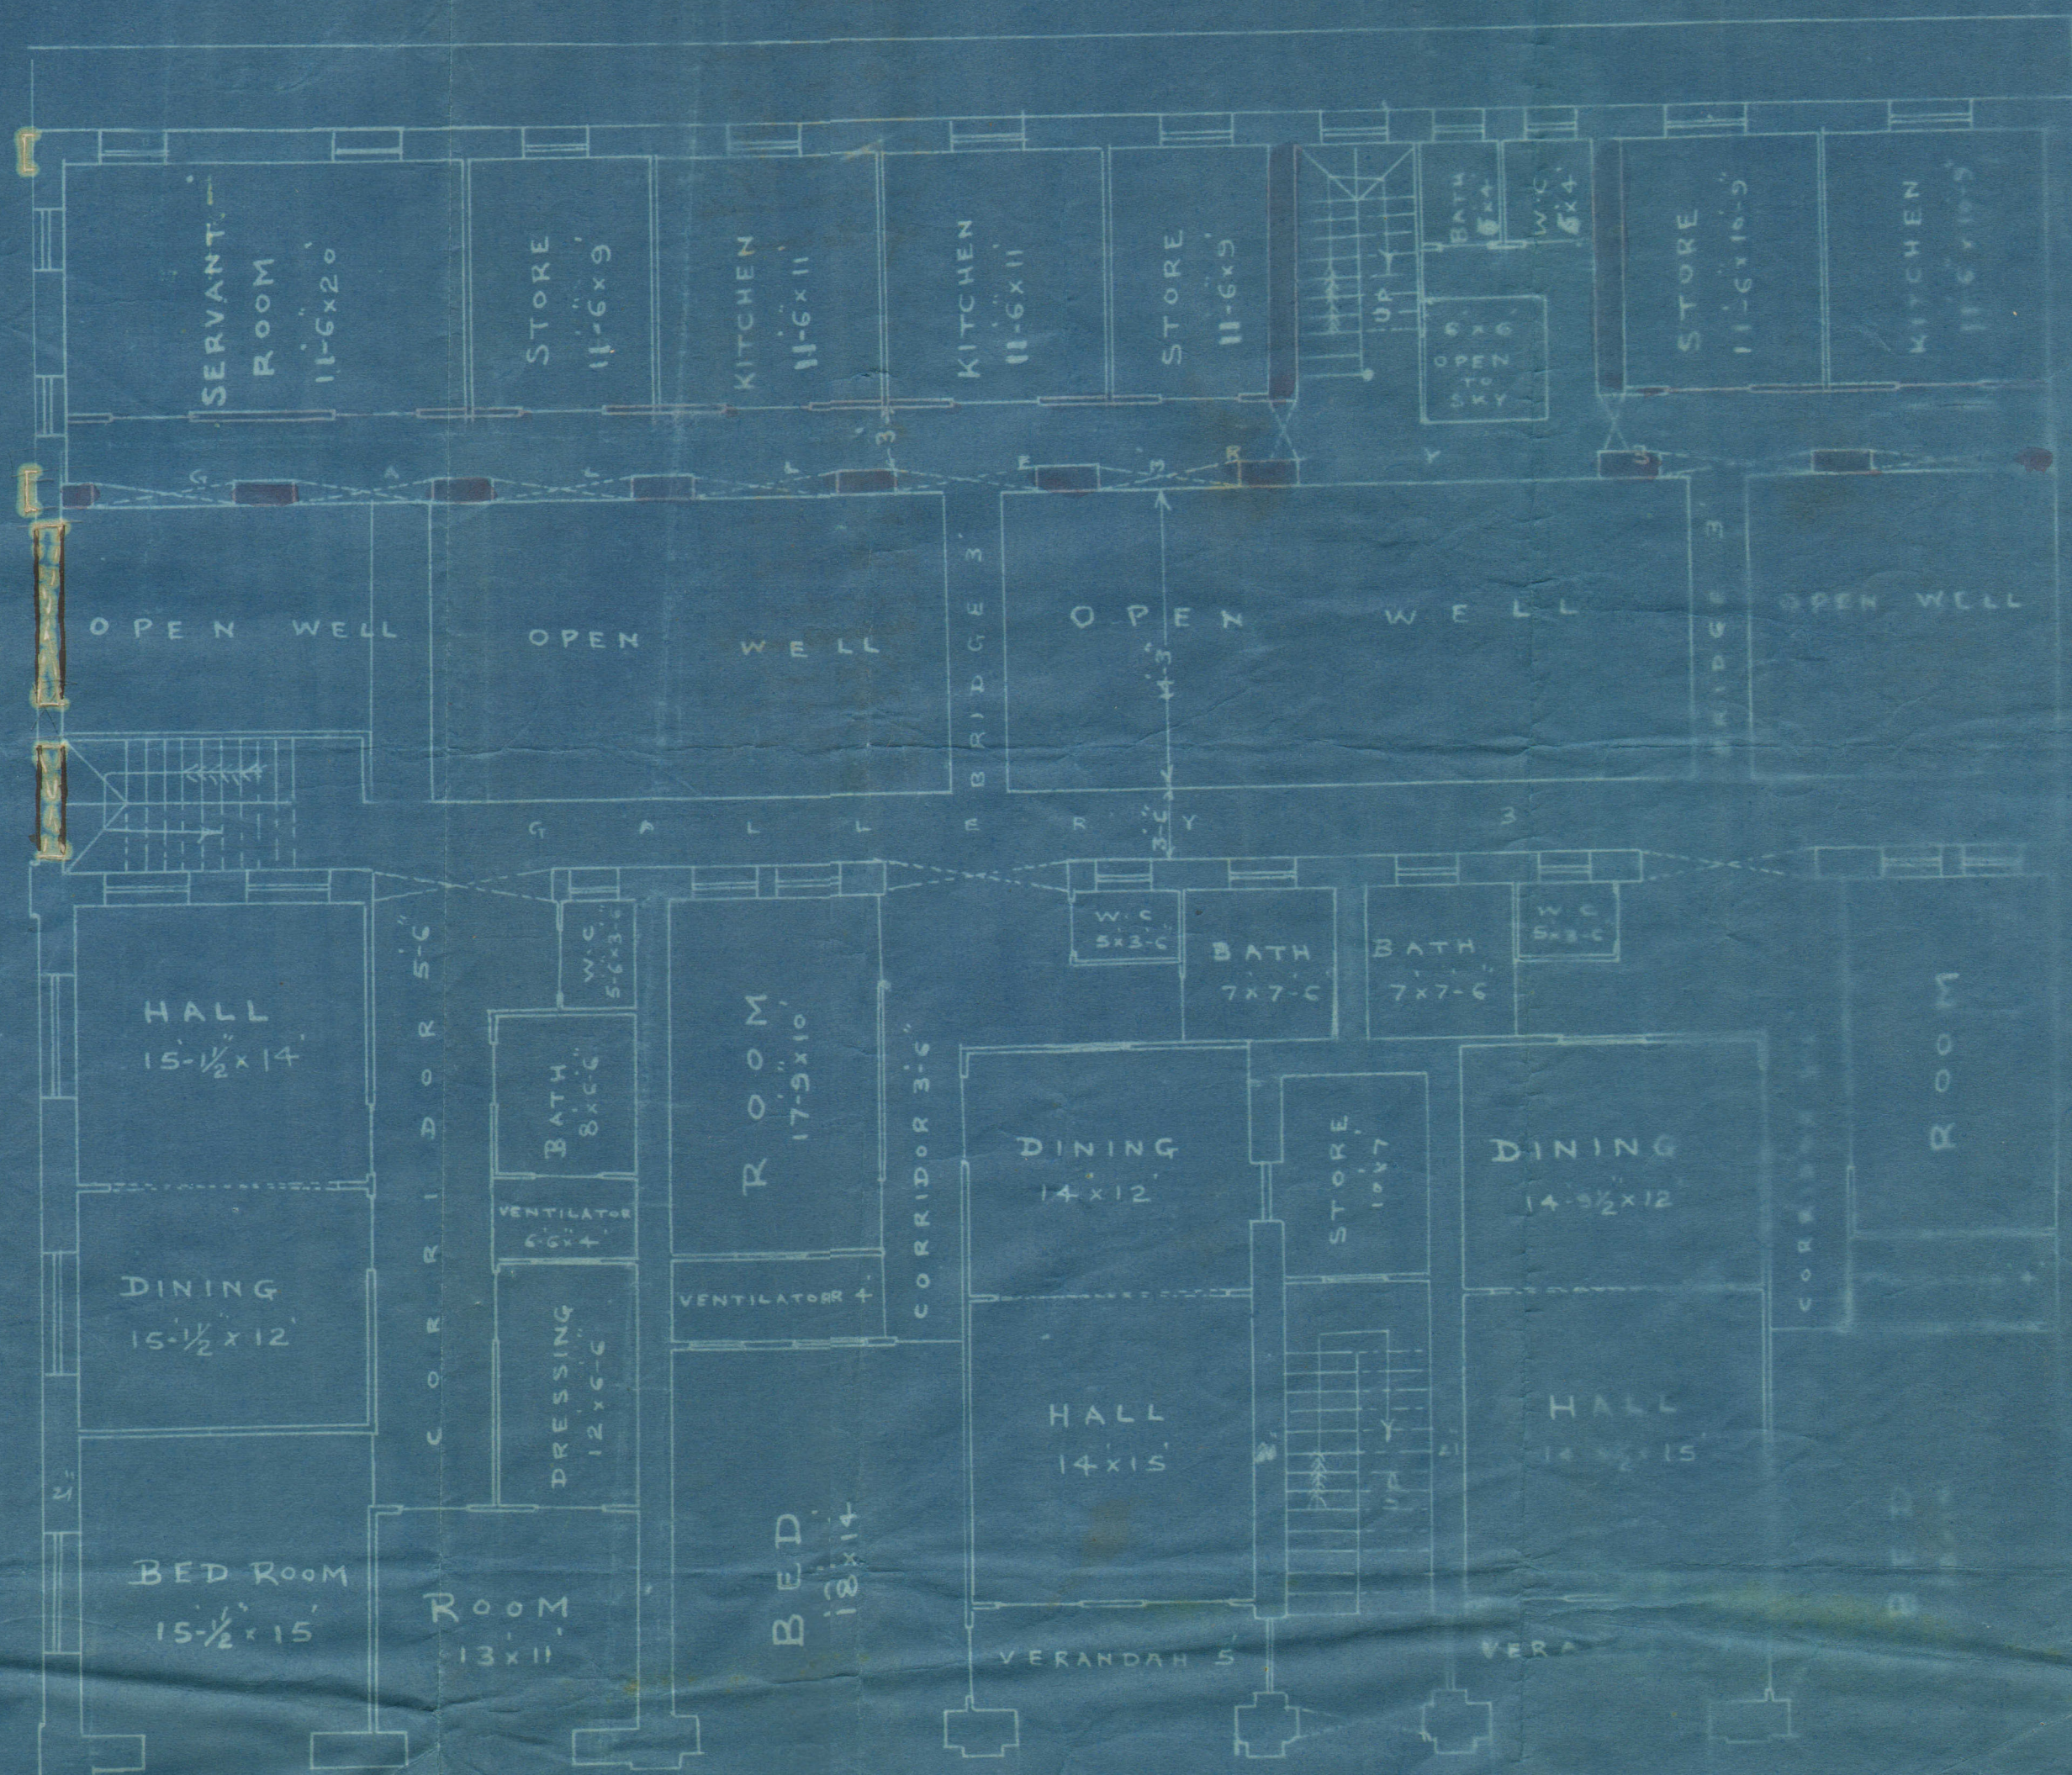

3240
19/9/19.

1911

KARACHI.

18. 9. 19

The Engineer

Karachi Municipality

Sir,

I beg to submit herewith amended plan in duplicate for building under construction on plot No: 6/1 sheet F 15 Sudder Bazar Quarter. The amendments are only made in the back portion of the building.

I remain

Sir

Your most obedient servant

Shams Karam mal

2 P.
M.

8477
19/9/19



19-2

Mr. Varma for call
 upul ofc.
 S. B. haime
 - 20/9

Sir

With reference to the
 beg to report the amends
 - Meats shown on ground floor
 are not objectionable.

With reference to the amends
 Meats proposed on 1st floor i.e.
 Carrying of front gallery
 wall right up to the level of
 the roofing is most objectionable.
 as it will make the rooms
 very dark.

Yours obediently

22/9/9

With reference to the

Carrying of the front wall on
 1st floor is meant only to
 carry the loads of the floors

which otherwise would come on
 W & D wall. As the proposed wall
 is with open arches it does not
 affect light & air there is no
 objection in granting permission
 S. B. haime for 23/9/9
 signed 23/9/9

Mr. Varma
 27/9/9


No. L.S. 5238 of 1919. 21

Municipal office,

Karachi. 29th September 1919
30

Name,

With reference to his letter dated 19th Instant with an amended plan for the building under construction on plot No. 6/1 F-15 Sadar Bazar Quarter Mr. Shandas Kedumal is informed the same is duly approved and returned herewith to proceed with the work in accordance with it.

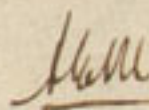

M. I. M. K.,

Ag: Engineer,

Karachi Municipality

30/9/19

Recd.

20/9

With reference to his letter dated 19th
instant with ^{an} amended plan for the building
under construction on plot No. 61, F/5
Rau Sudda Bazar Quarter No. Shanda
Kodumal is informed, ~~permitted~~
~~that~~ the same is duly approved & returned
herewith to proceed with ^{the} work in
accordance with it.



M. I. M. E.
Acting Engineer,
Karachi Municipality.