
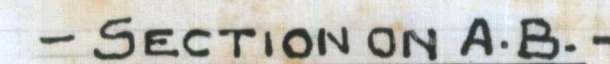


— SCALE 8' FEET = 1" —

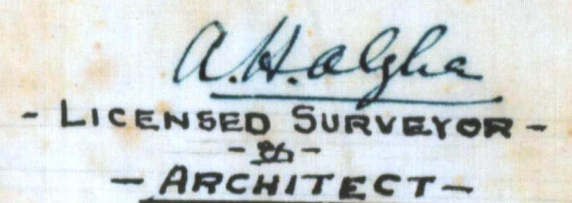

Ibrahimji Hakimji
-OWNER-

KARACHI MUNICIPALITY.

—:O:—

N. J. MODI.

B. Sc., (Engineering London.)

A. M. INST., C. E., L. C. E.

M. R. San. I., A. M., I. S. E.

Land Manager & Architect.

REFERENCE No. L. M. A.

11566

LAND MANAGER & ARCHITECT'S OFFICE,

Karachi, 28/11/1925

MEMO:—

With reference to ^{his}~~then~~ application dated 7-11-25 with a

plan for the proposal ^{Building}~~addition~~ on plot No. 24 Survey Sheet No. 2C

~~Bunder~~ Quarter Mr. Ebrahimjee Hakeemjee is informed that

until the following requirements are complied with the plans cannot be passed.

- (1) Galleries in the middle open space must be removed & open space increased.
- (2)
- (3) Two more Copies of plans are required
- (4)
- (5)
- (6)
- (7)
- (8)
- (9)

The plans are returned herewith for amendment.

B. Sc., A. M. I. C. E.,

Land Manager and Architect.

25/11/25

Form No; 1-500 1-5-25.

Karachi, 7. 11. 1925

NOTICE UNDER SECTION 96 OF ACT III OF 1901.

THE CHIEF OFFICER,

KARACHI MUNICIPALITY.

SIR,

I beg to inform you that I intend building building

on plot No. 2 c

Survey Sheet No. _____ Situate in C. 4

Street, Bander Quarter.

As required by the Rules of the Municipality I beg to submit herewith a Plan of the same for approval.

I beg to remain,

Sir,

Your most obedient Servant,

A. H. Agha
or Ibrahim Hakeemji

Signature of the Applicant

Address:—

A. H. Agha
Architect.

No. G. 12600
7-11 of 192

MUNICIPAL CHIEF OFFICER'S OFFICE,

Karachi, 7/11 1925

Forwarded to the Health Officer for favour of passing on to the Land Manager and Architect after putting his remarks.

for Chief Officer
Karachi Municipality.

SCALE 3' FEET = 1"



A. H. alpha
- LICENSED SURVEYOR
- ARCHITECT