



BUILDING COMPLETION REPORT.

MUNICIPAL ENGINEER'S OFFICE,

Karachi, 31.7. 1924.

To

THE ENGINEER,
KARACHI MUNICIPALITY.

SIR,

I beg to report, the building work on plot No. 135 Sheet K-8
Lyara Quarter owned by Mr. Ali Dulrahman is
completed according to the plan approved by the Municipality. Orders
are requested to file the correspondence.

Yours obediently,

A. H. Agha
Building Surveyor "B" Section,
Karachi Municipality.

No. L. S. 4354 of 1924Copy to the Assessor and Collector for
information. 5.8.24

M.C., A.M. INST. C.E.,

21/8/24
Engineer,
Karachi Municipality.

21/8.



No. E.

OF 191 .

MUNICIPAL OFFICE,

Karachi, 25. 7. 1924.

Memo.

Mr. Abdulrahman
Messrs.~~is~~ informed that it is observed that in building~~his~~ on Plot No. 135
~~their~~Survey Sheet K. 8, Lyaree Quarter,~~he is~~ deviating from the approved plan, ~~by putting partition~~
~~they are~~ into shop, changing position of bath & pantry &
changing size of Cook & store on 1st floor.Instructions are therefore given to ~~him~~ to at once stop the work and
to submit an amended ~~plan~~ plan within a week
make the building in conformity to the approved plan, or steps will be taken
under the Act.The Municipal Building Surveyor will be on the site on
191, at A.M., to point out such
deviations when ~~he~~ or ~~his~~ representative is requested to be present,
~~they~~ ~~their~~Make correction on plan
& forward for H.O.'s
opinion - 25/7

A.M. INST. C.E.,

Engineer,

Karachi Municipality.

Inst. 25/7
25/7

No objection

28/7/24

B.S. for further disposal

30/7/24.

No objection to prayer for flushing
Water coming
for flushing
28/7



No. E. OF 191 .

MUNICIPAL OFFICE,

Karachi, 25 . 7 . 1924.

Memo.

Mr. Abdulrahman
Messrs.~~is~~ informed that it is observed that in building~~his~~ on Plot No. 135
~~their~~ Nos.Survey Sheet K. 8, Lyzar Quarter,

~~he is~~ deviating from the approved plan, *by gutting partition*
~~they are~~ *into his shop, changing position of bath & privy & changing*
size of Cook & store on 1st floor.

Instructions are therefore given to ~~him~~ ^{him} to at once stop the work and
to submit an amended plan within a week
make the building in conformity to the approved plan, or steps will be taken
under the Act.

The Municipal Building Surveyor will be on the site on
191, at A.M., to point out such
deviations when ~~he~~ ^{he} or ~~his~~ ^{his} representative is requested to be present,

A.M. INST. C.E.,

Engineer,

Karachi Municipality.



Form No. 6-400-30-4-21.

No. L. S.

3642 OF 1923

MUNICIPAL OFFICE.

Karachi,

17-7.

1923.

1928

MEMO :

Building Surveyor Section B is informed
that Mr. Abdul Rahman has been permitted
to build
his house
on plot No. 135-K-8 Sidhy Gillage Road Street,
Lynae Quarter, report should be made to the
undersigned when the house is completed.

M. C., A. M. I. C. E.,

Chief Engineer,
Karachi Municipality.



Heritage
FOUNDATION

KMR.CDD.LyQ.1923-1924.01


— PLAN OF PROPOSED BUILDING —

— ON PLOT NO 135 K-8 —

— LYAREE Q.R. —

— SCALE 8"=1" —


149

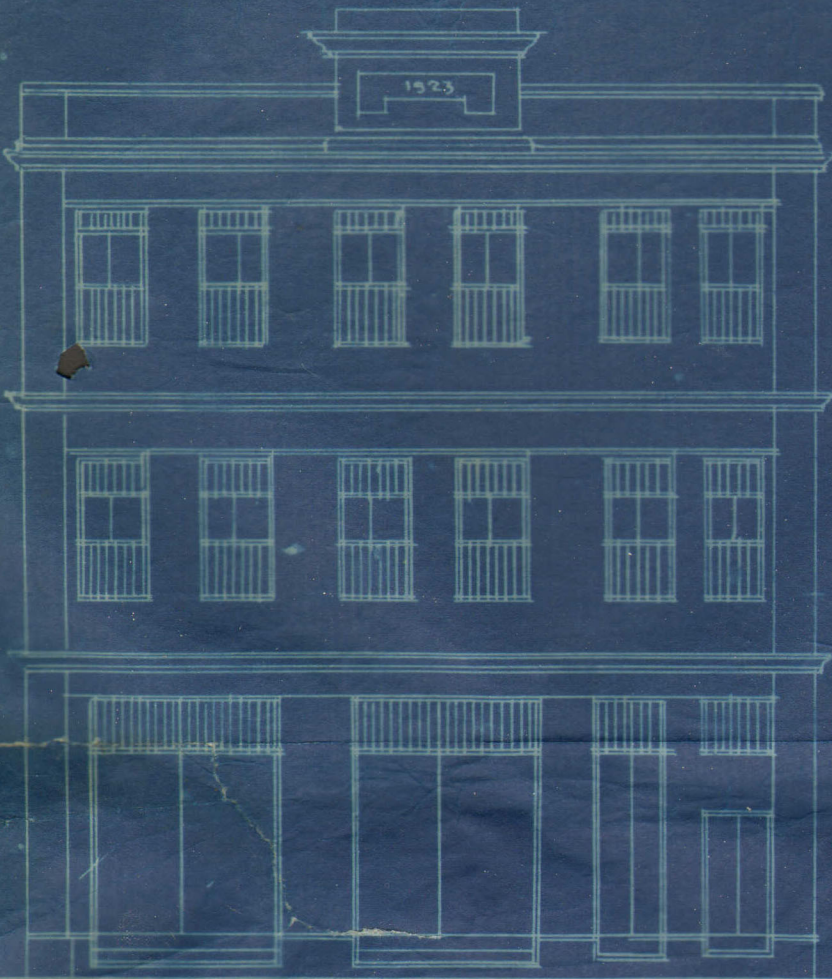

— FRONT ELEVATION —


APPROVED

M. I. M. E.
Architect
Karachi Municipality

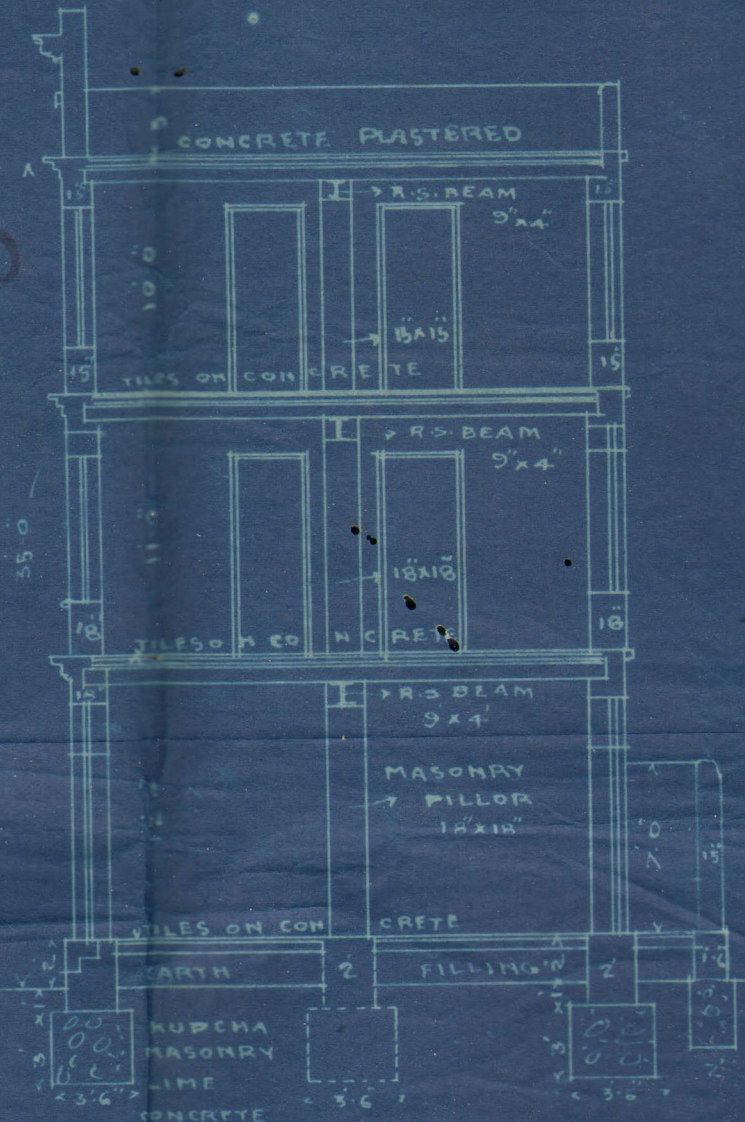


— SECTION ON A-B —

Khunji Maria
12.6.2

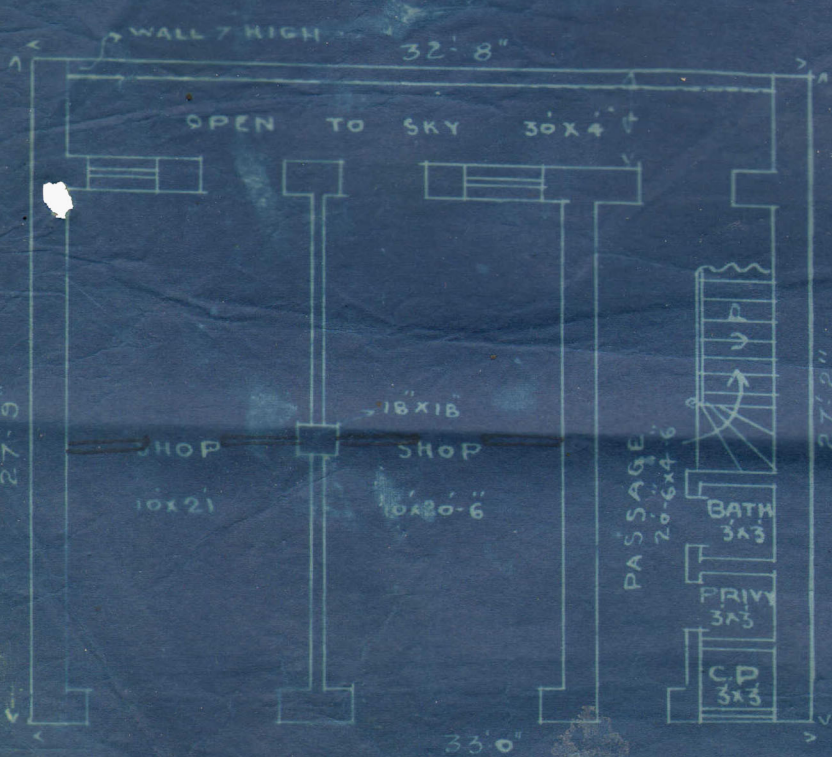

— PLAN OF GROUND FLOOR —

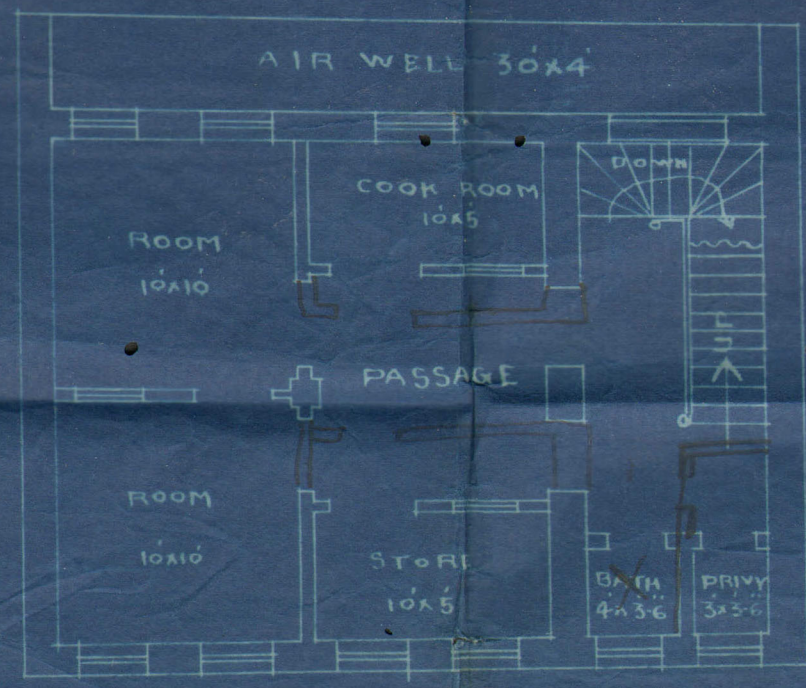

— PLAN OF 1ST & 2ND FLOOR —

BLOCK PLAN
SCALE:- 40'=1"



SIDHY VILLAGE LANE
18 WIDE

OWNER
ABDULREHMAN

PLAN OF PROPOSED BUILDING

ON PLOT NO 135 K.B


LYAREE Q.B

SCALE 8"=1"


149




FRONT ELEVATION

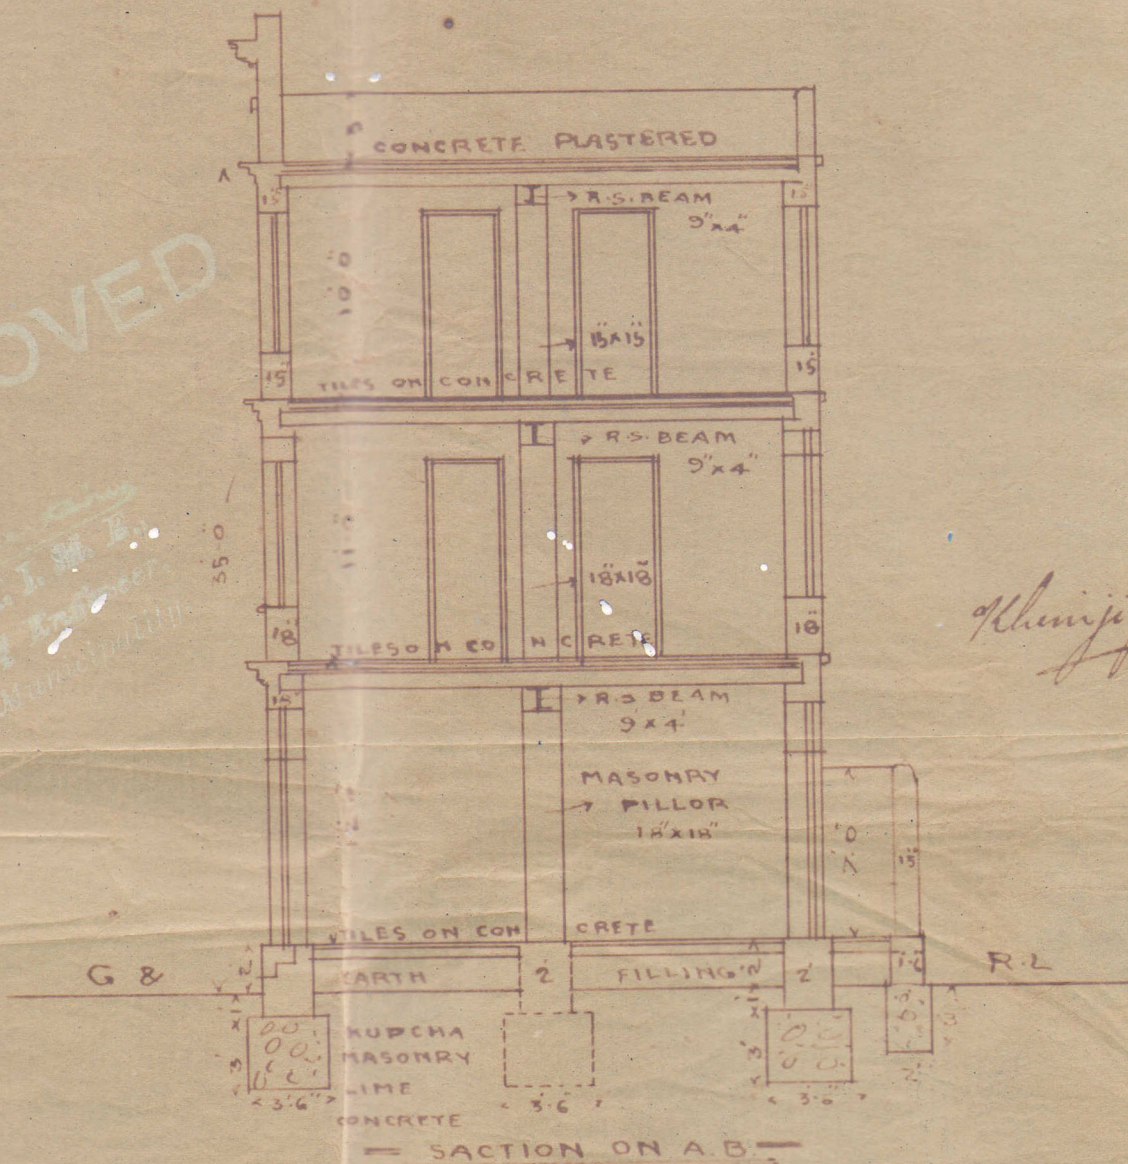

SECTION ON A.B.

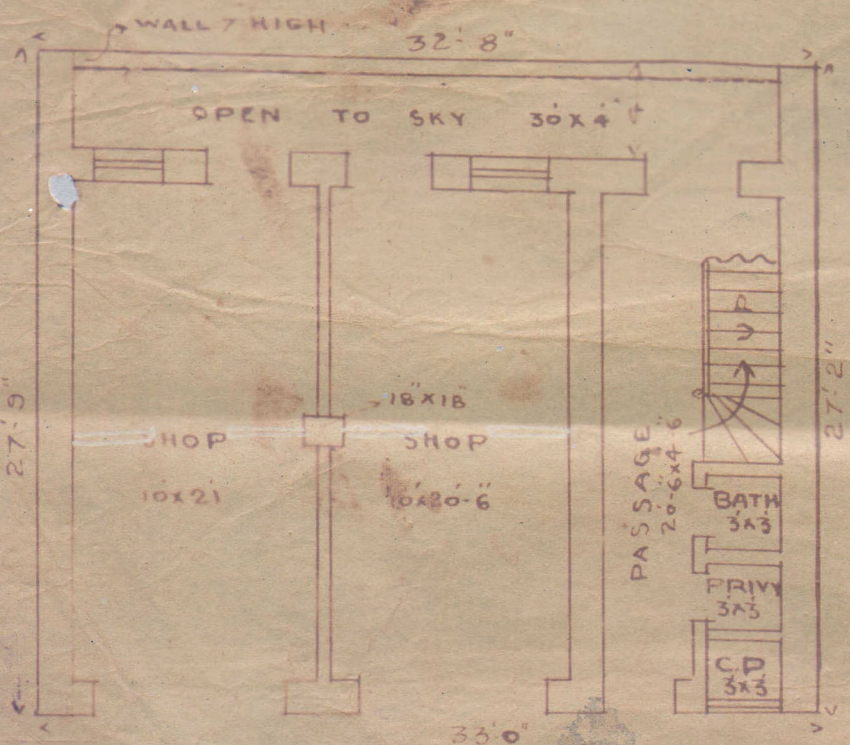


PLAN OF GROUND FLOOR

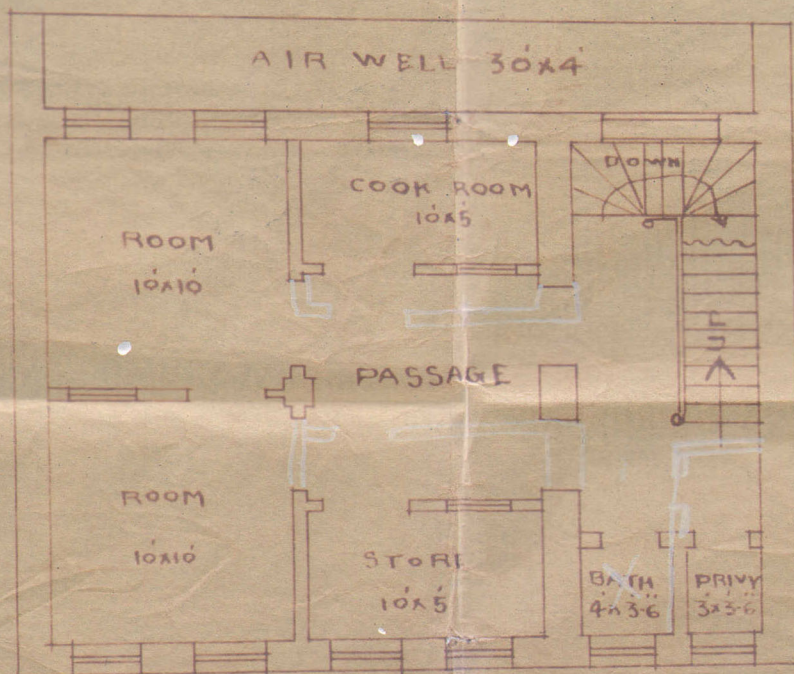

PLAN OF 1ST & 2ND FLOOR

BLOCK PLAN
SCALE: 40"=1"

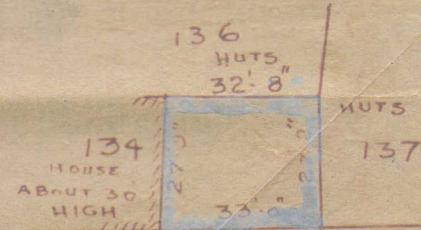

SIDHY VILLAGE LANE
18 WIDE

OWNER
ABDULREHMAN