

LAND DEPARTMENT.

FILE No. of 192

Compilation No.

Subject

Re plot 4 M. M. 1
Macli Macau

15

NOTE:—Former Correspondence filed in

file

Compilation No.

Subsequent Correspondence filed in

file

Compilation No.

卷四

349. The East India Company Co. L.B. 32, P. 6.
350. P. Allana & Bros. 32, A 12 mes.
351. Fazalollahi Jannabadi. 31, S.B. 6. Cedar Reg.
352. Jazgheli. Mehmed Ali & Bros. 10 & 11, R.P. 1.
353. Kipomel Chotram. 54 & 55, M. 2.
354. Issaji. Issaji. 25, M.P. 2 mes.
355. Ellis Haji. Vahidino. 43, 44 & 45, O.T. 9 old.
356. Ghulam Hussain Elshahingji. 24, M.P. 2 mes.
357. Muner Jannabadi. 14, P.R. 2. Reed.
358. Co-op. Co-operation & Society L.B. D/H, M. 3. Jamna.
359. M. & Mahom. 87, M. 1, SD.
360. Mahomed Hussain Kassim. 106 & 107, K.F. Lyari.
361. K.F. Anwar Mahomed Ali & Co. 105, A.F. old Jamna.

BUILDING COMPLETION REPORT.

MUNICIPAL ENGINEER'S OFFICE,

Karachi, _____ 192

To

THE ENGINEER,
KARACHI MUNICIPALITY.

SIR,

I beg to report the building work on plot No. 4 Sheet MMIM. J. Mian Quarter owned by Mr. P. M. Gausshi

completed according to the plan approved by the Municipality. Orders are requested to file the correspondence.


Yours obediently,

Building Surveyor "B" Section,
Karachi Municipality.L. M. A

N. L. S.

16000

of 1928.

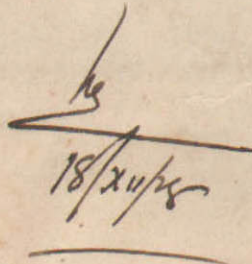Karachi, 18/12 1928Copy to the Assessor and Collector for
information
18/12/28B. SC., A.M. INST. C. E.,
Land Manager & Architect.
Karachi Municipality.

FORM B.

[Vide Rule 238/A (3) (a)]

UNDER BY-LAW NO. 47 (1) UNDER
SECTION 48 (N)

Completion Certificate.

TO BE SUBMITTED BY LICENSED SURVEYOR
BUILDING AND DRAINAGE COMPLETION CERTIFICATE.



I do hereby certify that the following building and drainage work (insert full particulars of the work) Second floor of the Building on
Plot No MM 1 No 4 Machi Miami Quarter
Completed

has been supervised by me and has been completed to my satisfaction; that the workmanship and the materials used are good; and that no provision of the Act or the Bye-laws and no requisition made, condition prescribed, or order issued thereunder has been transgressed in the course of the work.

P.S. me
13/12

Signed P. N. Jandhi
Dated 12/12/1928

Telegraphic Address:
"PAKCO," Karachi.

5



KMR.CDD.MmQ.1928.01

Codes used:
A. B. C. 5th, 6th & Improved Editions
Bentley's & Private.

PARSRAM & CO.,

ARCHITECTS, ENGINEERS, CONTRACTORS & ESTATE AGENTS.

PARSRAM M. GANDHI,
A.M.I.E., B.E., M.R.S.I. (LONDON).
~~BHOJRAJ L. KHATHURIA~~
B.E., M.R.S.I. (LONDON).

~~FUDYANI BUILDING~~
~~RUNDER ROAD,~~

NO. _____ KARACHI, 2nd ~~MANAGER~~ 1928

To

The Land Manager,

Karachi Municipality.



Dear Sir,

I expect to fill cement -
concrete for roof on plot MM1 4 on
4th inst.

Yours Faithfully

P. M. Gandhi
A.M.I.E.B.E.

*P.S. lie
5/11*

*C. P. attach inspection
X sketch is already entered
inspection sketch 5/11
attach. All sta.*

*C. P. I want with plan
5/11*

*B.S. P. Inspection plans are already
handed over to you immediately
over Fe. is read from
D.C. not plan are
split with clear
J.M.K.
2/11*

M. M. 1
C-1

Harris Road

(4)

175

Young Husband Road

Ejector



No. L. M. A. 10592. of 1928.


MUNICIPAL OFFICE,

Karachi, 24/8 1928.


MEMO :

Building Surveyor Section B is informed
that Mr. P. M. Gadhvi has been permitted
to build
_____ his house
on plot No. 175 C-1 Street
Wachi Wami Quarter, report should be made to the
undersigned when house is completed

Executive Engineer,
Karachi Municipality.

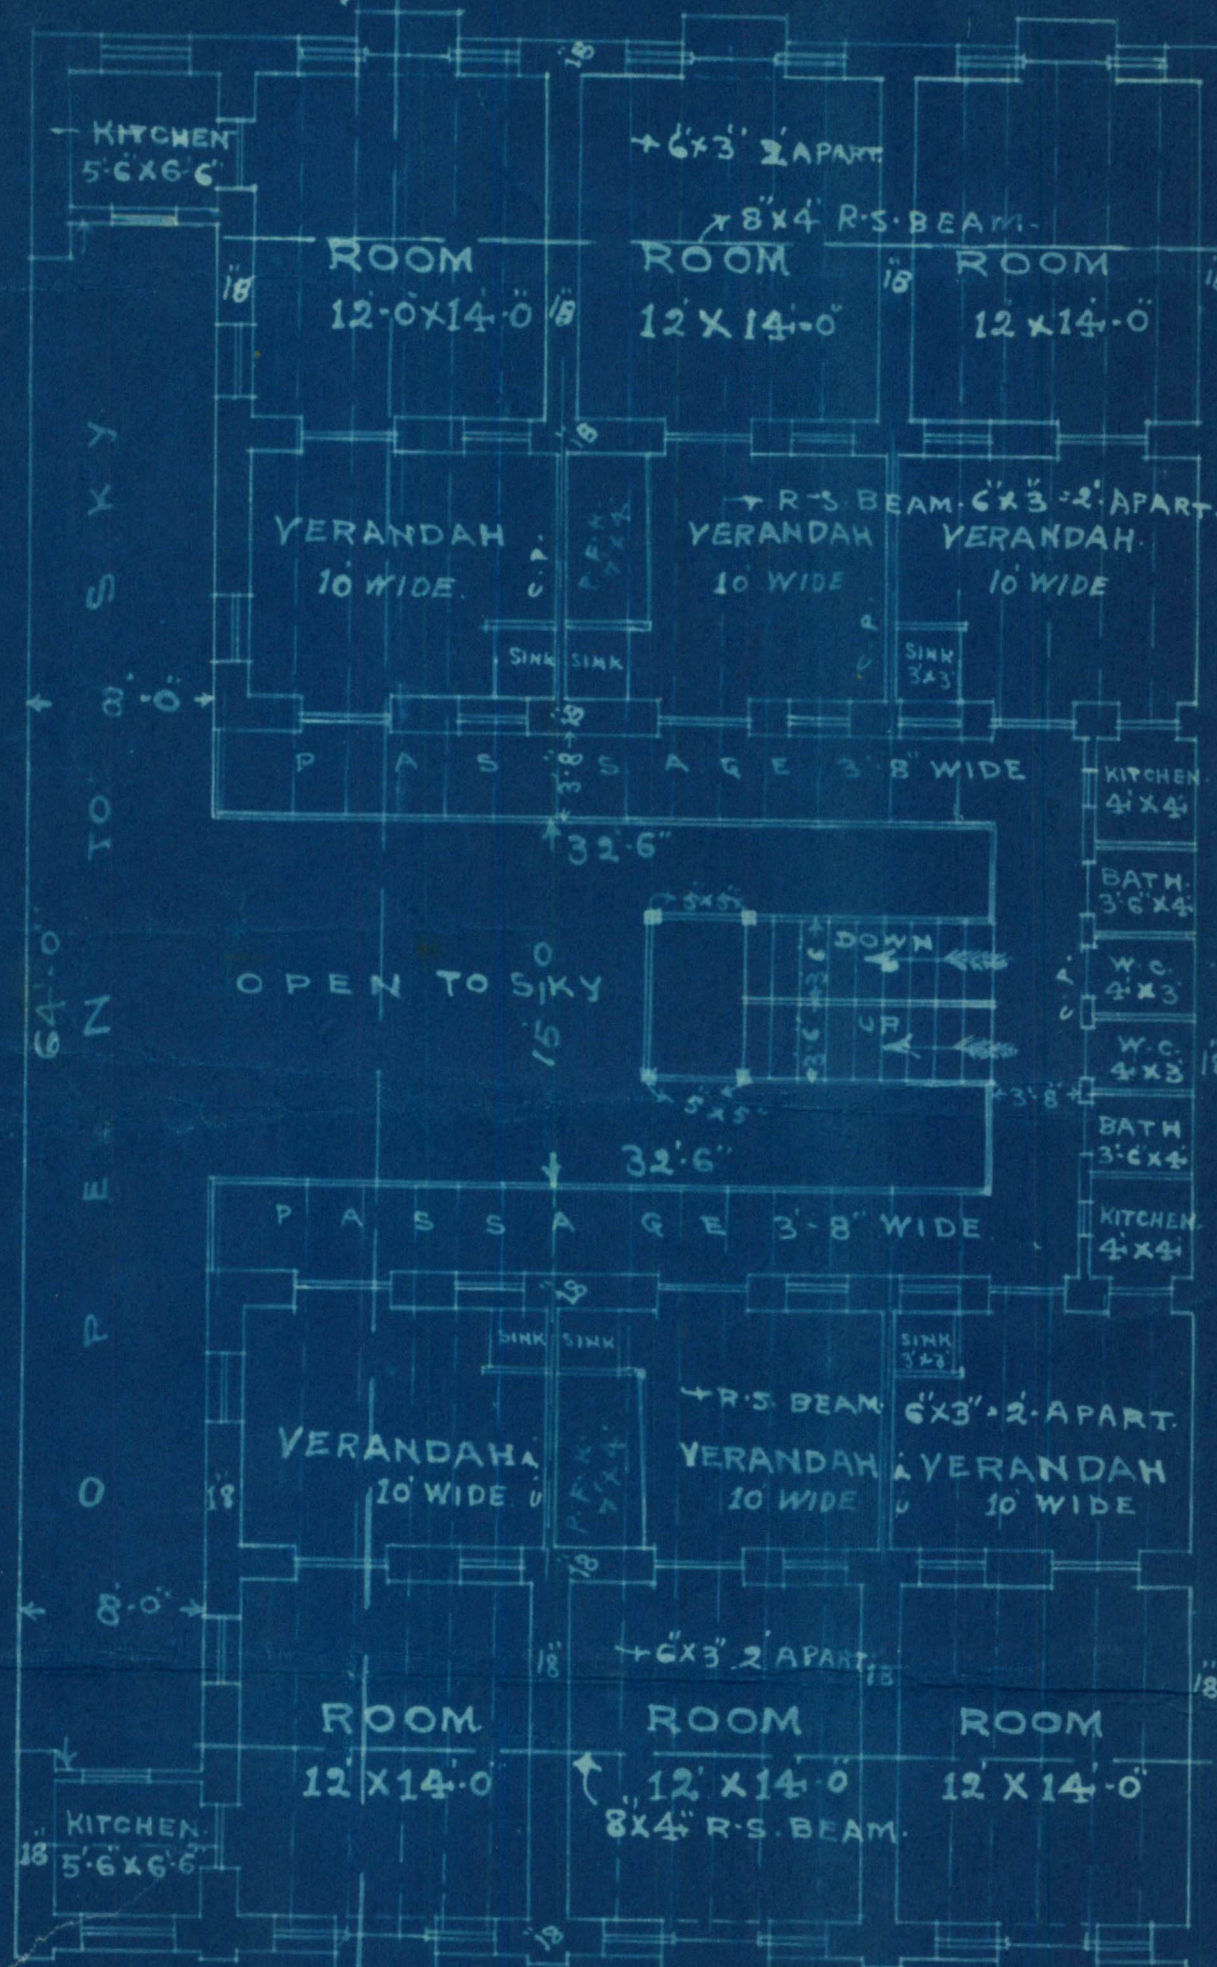

FIRST FLOOR PLAN

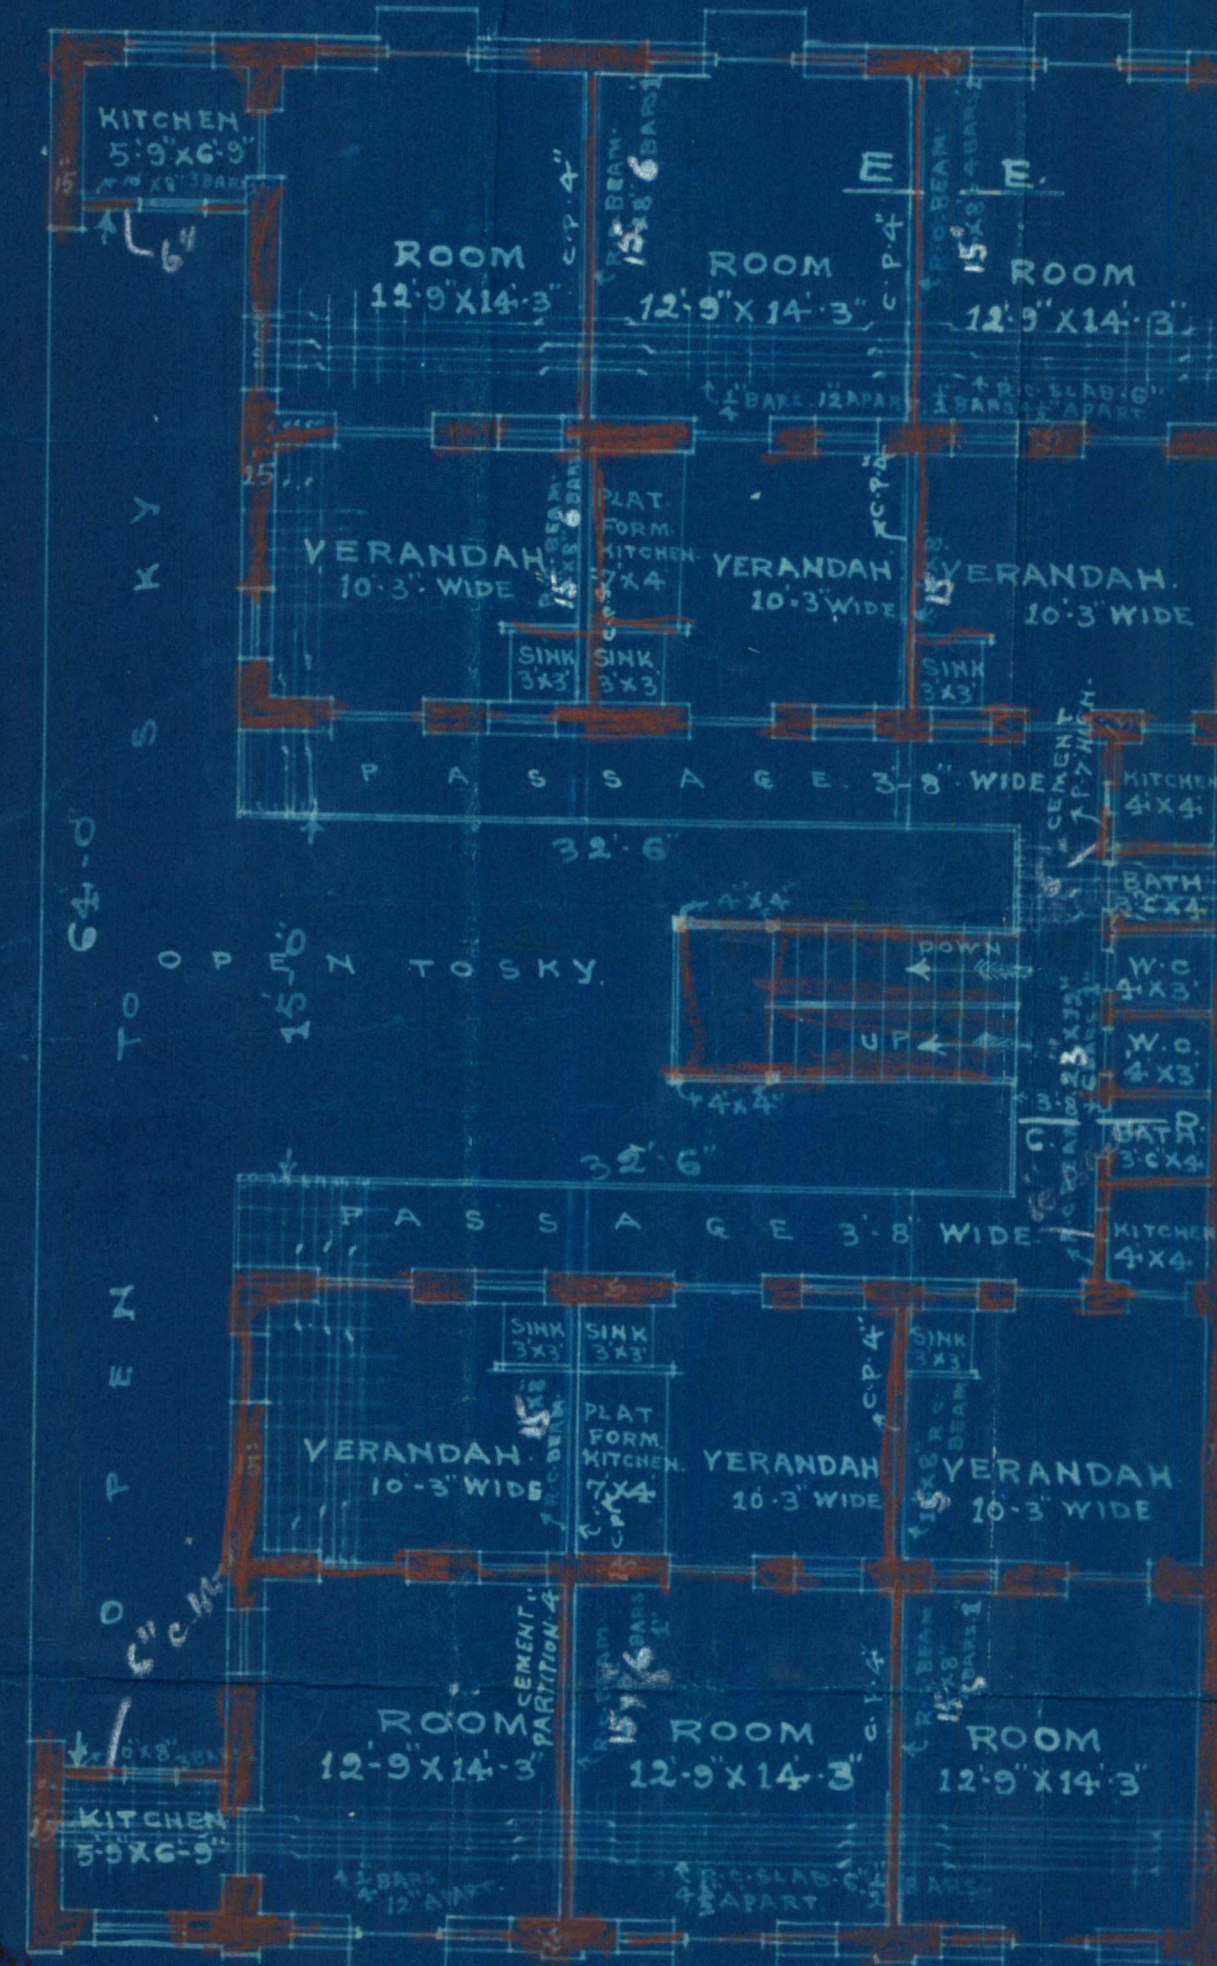

2ND FLOOR PLAN

PLAN OF PROPOSED 2ND FLOOR
TO BE BUILT ON PLOT NO. 175 SHEET NO. C.1
MUCHIMEANI QUARTER
SCALE 8-1" INCH

NOTE

BUILT AREA = 293 S.Q.YD.
OPEN SPACE = 146 " " "


TOTAL OF PLOT AREA 439 S.Q.YD.




DETAILS OF R.C. BEAM. SECTION E.F.
ON SECTION C.D.
SCALE 4-1" INCH

BLOCK PLAN


SCALE 4-0-1" INCH.

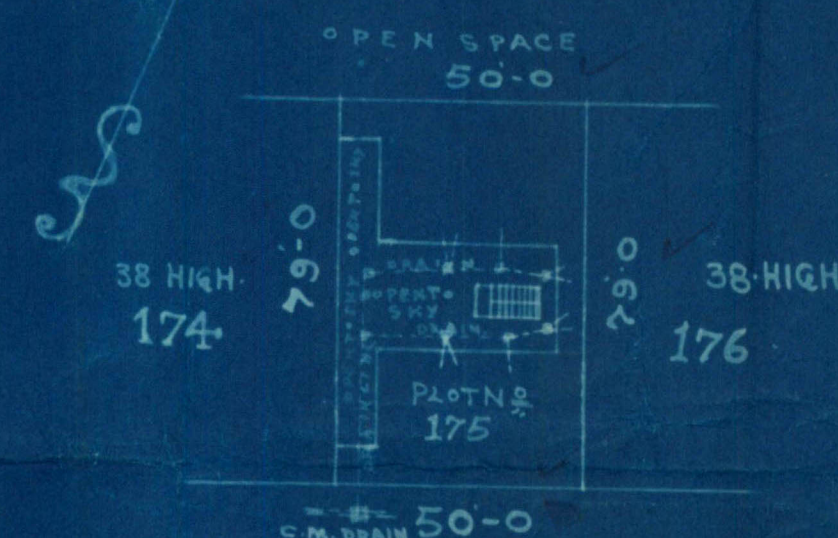


YOUNG HUSBAND STREET
57' WIDE.

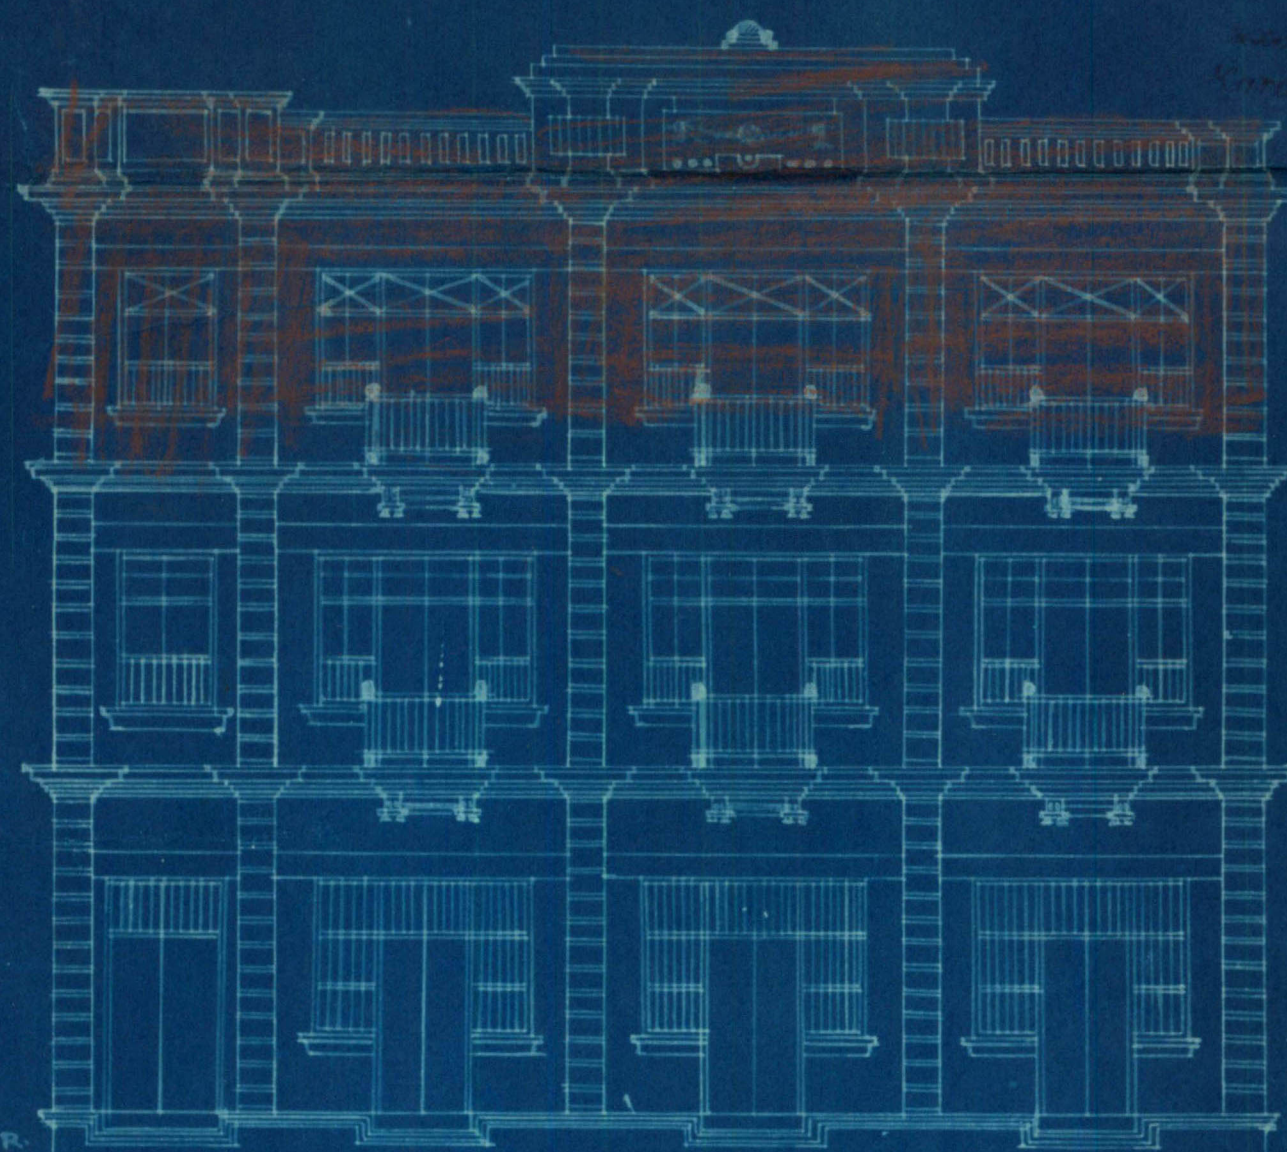

FRONT ELEVATION

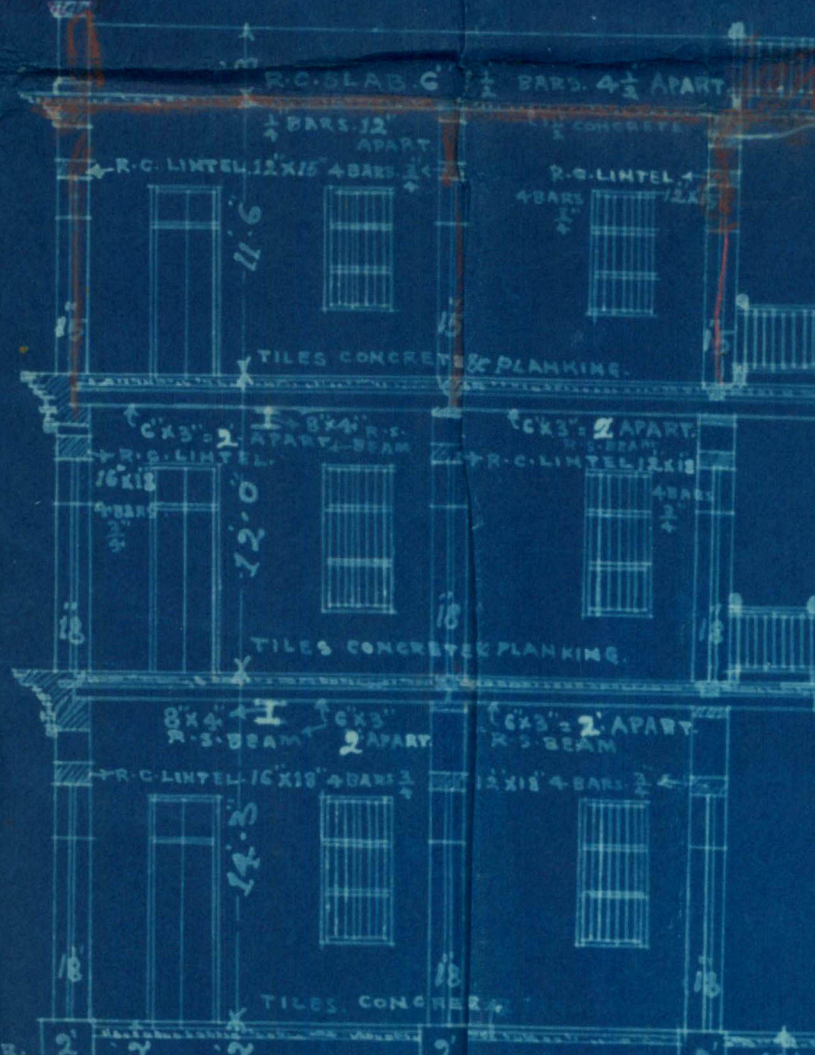

SECTION ON A.B.

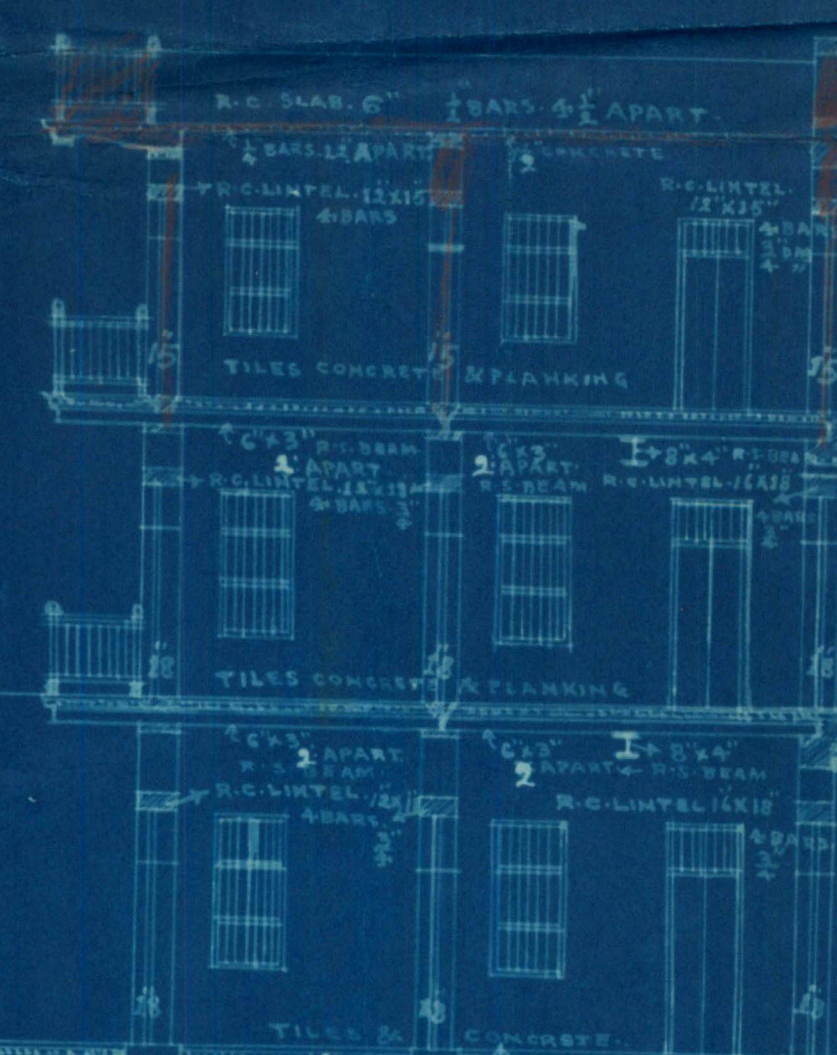

P. H. *[Signature]*
A. M. E. B. M. P. S. I.
Architect & Engineer
15/11/1928