



Department.

FILE No.

of 193

SECTION

PART

Disposal No.

14

Subject

27/4, Jan 3, Janshad

NOTE:—Former Correspondence filed in

file

Compilation No.

Subsequent Correspondence filed in

file

Compilation No.

No: Old-20.27/4, Jan



Heritage

KMR.CDD.JmQ.1938-1939.02

600-8-38

KARACHI MUNICIPAL CORPORATION.

Diary sheet in respect of Building Regulation plans received.

Date of receipt.	Date When sent.	Date When Retd.	Date when sent to B. S.	Date when put up to L. M. A.	Date when obj. sent.	Remarks.
23-11-38.						
H. O. ...	26-11-38	27/11				
E. E. ...	- 45 -	"	20/11/38			DEC 1 3 1938
L. S. ...	- 50 -	20/11				
19/12						
H. O. ...	19/12	22/12	22/12/38			
E. E. ...	-					
L. S. ...	-	21/12				
H. O. ...						
E. E. ...						
L. S. ...						



Heritage

KMR.CDD.JmQ.1938-1939.02

600-9-28.

Office Telephone Nos. 2805,
2806 & 2807.

F. M. I. KURESHI,
B. Sc. Engineering (Edin.)

LAND MANAGER & ARCHITECT



**MUNICIPAL CORPORATION
KARACHI.**

JAN 13 1939

Reference No. ~~B.S.P.L.C.P.~~ 614/38

From

ORDER UNDER SCH. VI, CHP. XI, RULE 5 (1) OF
ACT XVII OF 1933.

To,

Mr. Tanwar Lal Teramdas

KARACHI,

With reference to your application with plan for Bungalow
on plot ^{old No 27/4} ~~New No 393~~ Sheet No. 2, M. 3 Quarter received in this
office on _____, I have to inform you that the said plan is approved
and permission to build in accordance therewith is hereby granted. The building must be
erected in conformity with the Bye-laws and rules of the Karachi Municipal Corporation.

A copy of a approved plan is attached herewith.

F. M. I. Kureshi

Land Manager & Architect.

Karachi Municipal Corporation

JAN 12 1939

NOTICE, 1:—This sanction holds good, provided the work of construction is
commenced in earnest within a year from this date, whereafter the sanction will be deemed
to have lapsed.

NOTICE, 2:—This sanction does not entitle the owner to build on land not conveyed
to him either by the Government or the Municipality by a Sanad or entry in a Sanad.

NOTICE, 3:—This pass does not give permission to occupy Municipal land with
building materials. This can only be allowed when the Street is wide enough to permit
building materials being deposited on it without it being a source of danger to the public and
only then on a boarding placed round the land to be occupied and on payment in advance, of
fees for occupation of land.

NOTICE, 4:—Rain water Spouts and Spouts from the balconies, windows, steps and
doors of the building will not be permitted to project on or overhang public street or
Municipal land.

NOTICE, 5:—Plinth cornice will not be allowed to project more than 2 inches on
any Public street for ornametal purposes.

NOTICE, 6:—You are required to give timely intimation to the Land Manager and
Architect before filing in the foundation and before concrete is filled in for Re-inforced
concrete work.

NOTICE, 7:—In case of set back or set forward, the first course of Plinth must be
laid after the line is checked by the Land Surveyor.


NOTICE, 8:—All Tanks built for purposes of carrying building operations must be
covered with Planking as required by Rule 9 (2) (b) of Chapter II Schedule VI of Municipal
Rules sanctioned by the Commissioner-in-Sind under his No. Gel 6101, dated 25-11-35.

NOTICE, 9:—Proper boarding and fencing round the plot be provided before
starting the work.


PLAN SHOWING PROPOSED ADDITIONS & ALTERATIONS WITH FIRST FLOOR. ON PLOT No. 393 SHEET J.M. 3. FOR THE COSMOPOLITAN CO-OPERATIVE HOUSING SOCIETY LTD. JAMSHED QUARTER. SCALE 8-1.



NOTE: ALL R.C. PILLARS IN GROUND FLOOR 18" DIA. 4 RODS 1"
" " " " " FIRST " 15" DIA. 4 RODS 3/4"
NOTE: ALL OUTER WALLS 6" THICK.
" " " " " PROPOSED BLOCK SHOWN RED COLOUR.

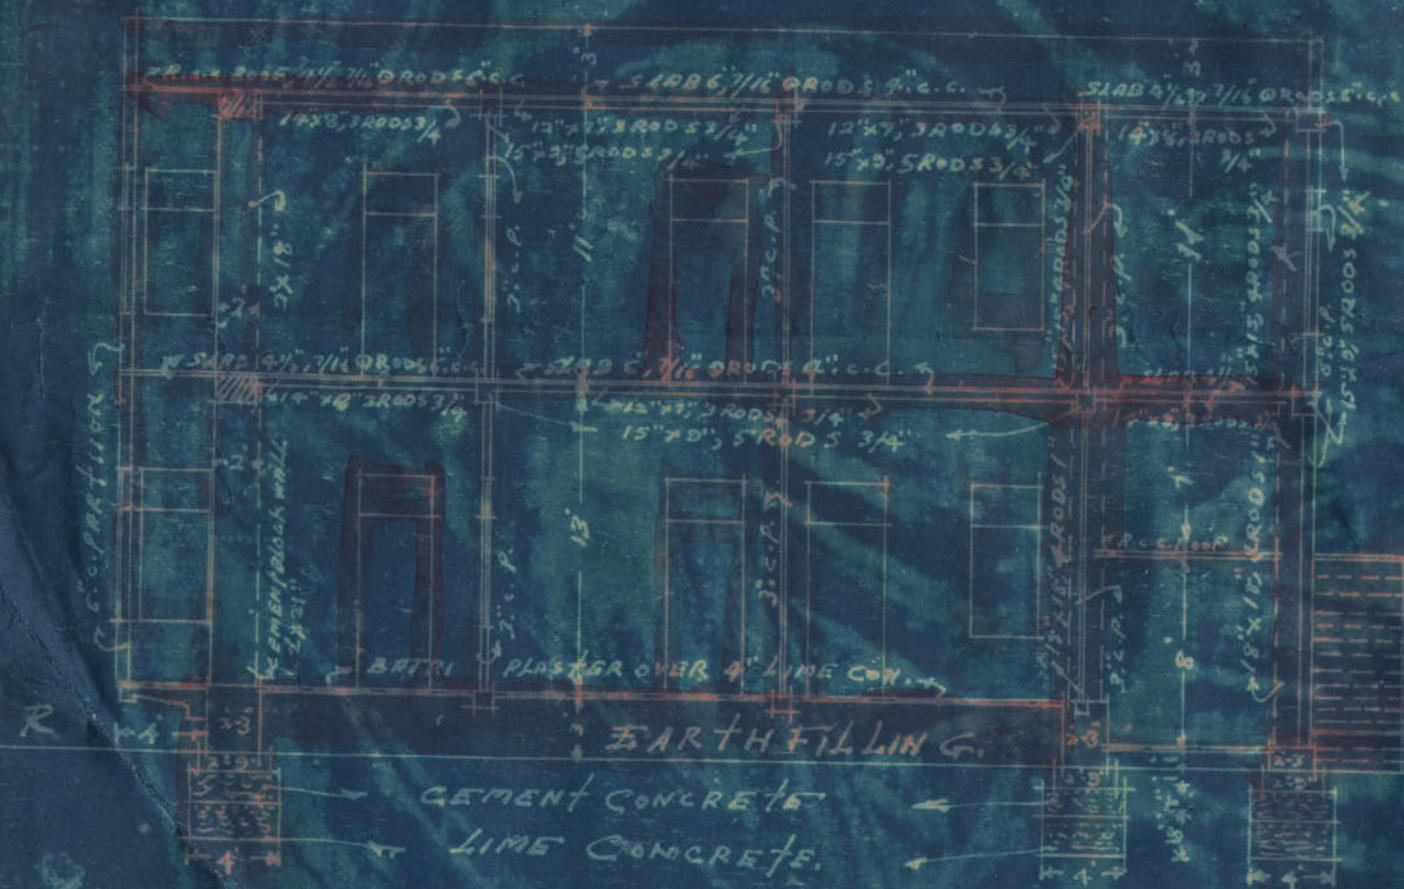

TOTAL AREA OF PLOT 393 50.705
ALLOWABLE BUILT AREA 331.50
EXISTING BUILT AREA 150.00
PROPOSED BUILT AREA 178.95
Details of Existing Structure:-
(1) 1 x 15.75 x 3.3125 = 52.27
(2) 1 x 13.5 x 2.5 = 33.75
(3) 1 x 12.75 x 2.5 = 31.88
(4) 2 x 12.75 x 2.5 = 63.75
Deduct 78.95
(5) 1 x 11.46 x 16.56 = 189.68
(6) 2 x 2.5 x 2.5 = 12.50
135.21 = 150.00
Details of Proposed Structure:-
(1) 1 x 15 x 16.75 = 25.13
(2) 1 x 34.5 x 26 = 907.50
(3) 1 x 18 x 17.75 = 320.25
(4) 1 x 3 x 19.5 = 58.50
(5) 1 x 10.45 x 17.75 = 184.54
(6) 1 x 2.25 x 5.5 = 12.38
(7) 1 x 3.5 x 7.75 = 27.13
(8) 1 x 4 x 5 = 20.00
(9) 1 x 8 x 11 = 88.00
(10) 1 x 1 x 1/2 = 1.50
Deduct:-
(1) 1 x 1 x 1.5 = 1.50
1610.58 - 1.50 = 1609.08
1609.08 + 178.95 = 1788.03
331.50 - 1788.03 = 150.00
331.50 - 150.00 = 181.50
181.50 = 178.95

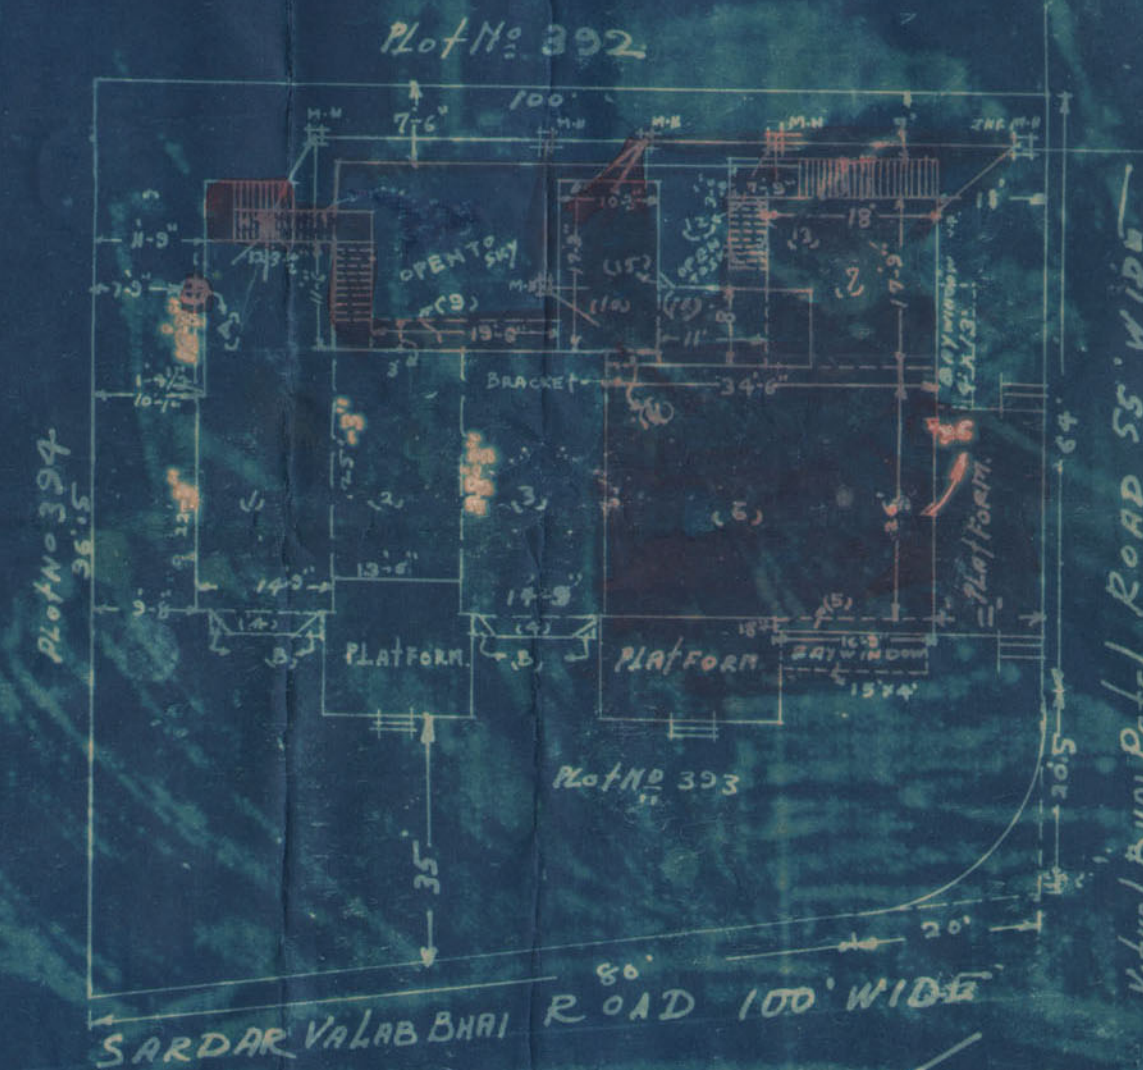

1. This section shows the proposed structure of the building. It includes a central hall, several bedrooms, a bathroom, a kitchen, a store, and a verandah. The plan is labeled 'SECTION ON A.B.' and includes various dimensions and structural notes.

APPROVED
JAN 1939
Z Land Manager and Architect

HARRINDAS M. GIOVANI & Co.,
ARCHITECTS & ENGINEERS.




Heritage

KMR.CDD.JmQ.1938-1939.02

NARAINDAS M. GIDWANI & Co.

ARCHITECTS & ENGINEERS

Bunder Road,

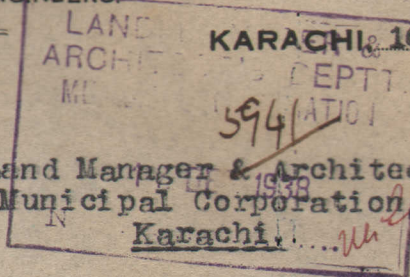

KARACHI, 16th. Dec. 1938.

The Land Manager & Architect,
Municipal Corporation,
Karachi.

Dear Sir,

New No. 393 J.M.3.

Re: Plot No.27/4. J.M.3.

With reference to your letter No. L.C.P.614/38 dated 13th. Dec. 1938, we have to state that :-

L.S.'s Objections Nos.1 & 2 are complied with.

S.E.'s Objections Nos. 3 is complied with.

H.O.'s Objection No.4. W.C. under the staircase has been removed.

L.M.'s Objections Nos.5,6,8 & 9 are complied with.

✓ Re: No.7, door has been removed and window put instead.

✓ Re: No.10. W.C. marked X has been removed.

The plans may therefore be kindly approved.

Submitted

Yours faithfully,

All objections
complied with

N.M. Gidwani

5/11
Add. finally
6/11

Plans approved

5/11

KARACHI MUNICIPAL CORPORATION.

Case No. LCP

for building on plot

No.

27/4

S. S.

Pin 3

Quarter

Jankar

:0:

Land Survey

Forwarded with Compliments to the ~~Health Officer~~ with a request~~Executive Engineer~~

to state if his following objections previously raised are now complied with


I Measurement & plot nos. are correct & shown

II Road name & width as per

19/11/38
For Land Manager & Architect.Remarks of the ~~Health Officer/Ex. Engineer.~~

Objection No 1 & 2 complied by the Architect

No Objection to the site plan as connected

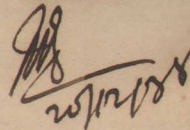Health Officer
Executive Engineer


 S.L.S.
 21/11/38
 20/12/38
 21/12



7

Hox }
EE }Below plan Feb. 27/49 JmQ
I. answered for.

Proceed as per to the Health
 Officer in favor of his
 report and the press on to
 the Ex. Engineer direct.
 to his report. His original
 objection memo is enclosed

Foundry
 19/12

Superintendent
 to show to the
 report

11178.

Same objection
 put abt.
 21/12

8



Heritage

KMR.CDD.JmQ.1938-1939.02
1000-6 38.

KARACHI MUNICIPAL CORPORATION.

BUILDING SECTION.

REVIEW FORM.

NOV 26 1938

Case No. P/E 614/38

RE:—Plot No. 27/4, Sheet No. Jan. 3, Jan. 20. Qr.

A copy of plan is forwarded with compliments to the Health Officer for favour of remarks

10592
For Mr. Wad
to show 5/10/11

[Signature]

FOR LAND MANAGER & ARCHITECT.

HEALTH OFFICER'S REMARKS

W.C. into the Staircase.
cannot be allowed.

[Signature]
for HEALTH OFFICER.
29/11



Heritage
FOUNDATION

KMR.CDD.JmQ.1938-1939.02

NOV 26 1938

1000-10--38

KARACHI MUNICIPAL CORPORATION.

Case No. 0614/38.

Plot No. 274, P-3, Jm 820 Q.

Forwarded with compliments to the Sub. Engineer Drainage for favour of remarks.

[Signature]

FOR LAND MANAGER & ARCHITECT.

SUB. ENGINEERS REMARKS

Position of O.H. tank should be shown.

M 28/11/29

Sub. Engineer

Dt 28/11

No objection

Date _____

SUB. ENGINEER.

Dt 22/12

Returned with compliments to the Land Manager & Architect.

FOR SUB. ENGINEER.

Office Telephone Nos. 2805,
2806 & 2807.

LAND MANAGER & ARCHITECT.



MUNICIPAL CORPORATION,
KARACHI.

DEC 1 2 1938

Reference No. L. C. P. 614/38

To, Mr. N. M. Gidvani, Architect for owner.

Dear Sir,

With reference to your application dated 23-11-38
with a plan for the proposed buildings/additions and alterations on plot
No. 27/4 Survey Sheet No. J.M.3, Jamshed Quarter,
I have to request you to comply with the following requirements:—

L.S.'s objections.

1. Measurements and plot nos. be correctly ~~shown~~ shown.
2. Road name and width be given.

S.E.'s objection.

3. Position of O.H. tank should be shown.

H.O.'s objection.

W.C. under the staircase can not be allowed.

L.M.'s objections.

5. The compulsory open space should be clearly marked on the plan.
6. The spiral staircase should be shown in site plan and its distance from boundary be given.
7. Door to the bay window can not be permitted.
8. Section through the bath and W.C. under landing be given.
9. ~~Raising~~ ^{existing} built up area should be checked with Building Surveyor.
10. W.C. X can not be allowed.

The plans are returned herewith rejected.

Yours faithfully,

Objection No. 3 complied with.

No objection

Abdul Qadir

Sub-Engineer

Land Manager & Architect,

J.H.S.
10/12

Dec 21/12