



Heritage

KMR.CDD.MaQ.1934.02

Office Telephone Nos. 1140 & 1141.
Residence „ „ 199.

NUMERALI BHALEDINO,
L. C. E.
LAND MANAGER & ARCHITECT



**MUNICIPAL CORPORATION,
KARACHI.**

Reference No. B. S. P. 662/34

17 DEC 1934

To,

.....**Mr. Devkishindas..(Architect)**

.....

KARACHI.

Dear Sir,

Re:—Plot No. 112 Sheet M.R.5 Market Quarter.

With reference to the plan for proposed.....

AMENDMENTS

.....submitted for the above plot,

you are requested to kindly call at the Municipal Office on any
week day except Saturday from 3-30 p. m. to 4-30 p. m. when the

requirements of this will be pointed out to you. **Other copy of the**


blue print will have to be corrected or one more

copy of the correct plan will have to be submitted.


Lu 15712

For Land Manager & Architect,

B. S. 38—600-8-34

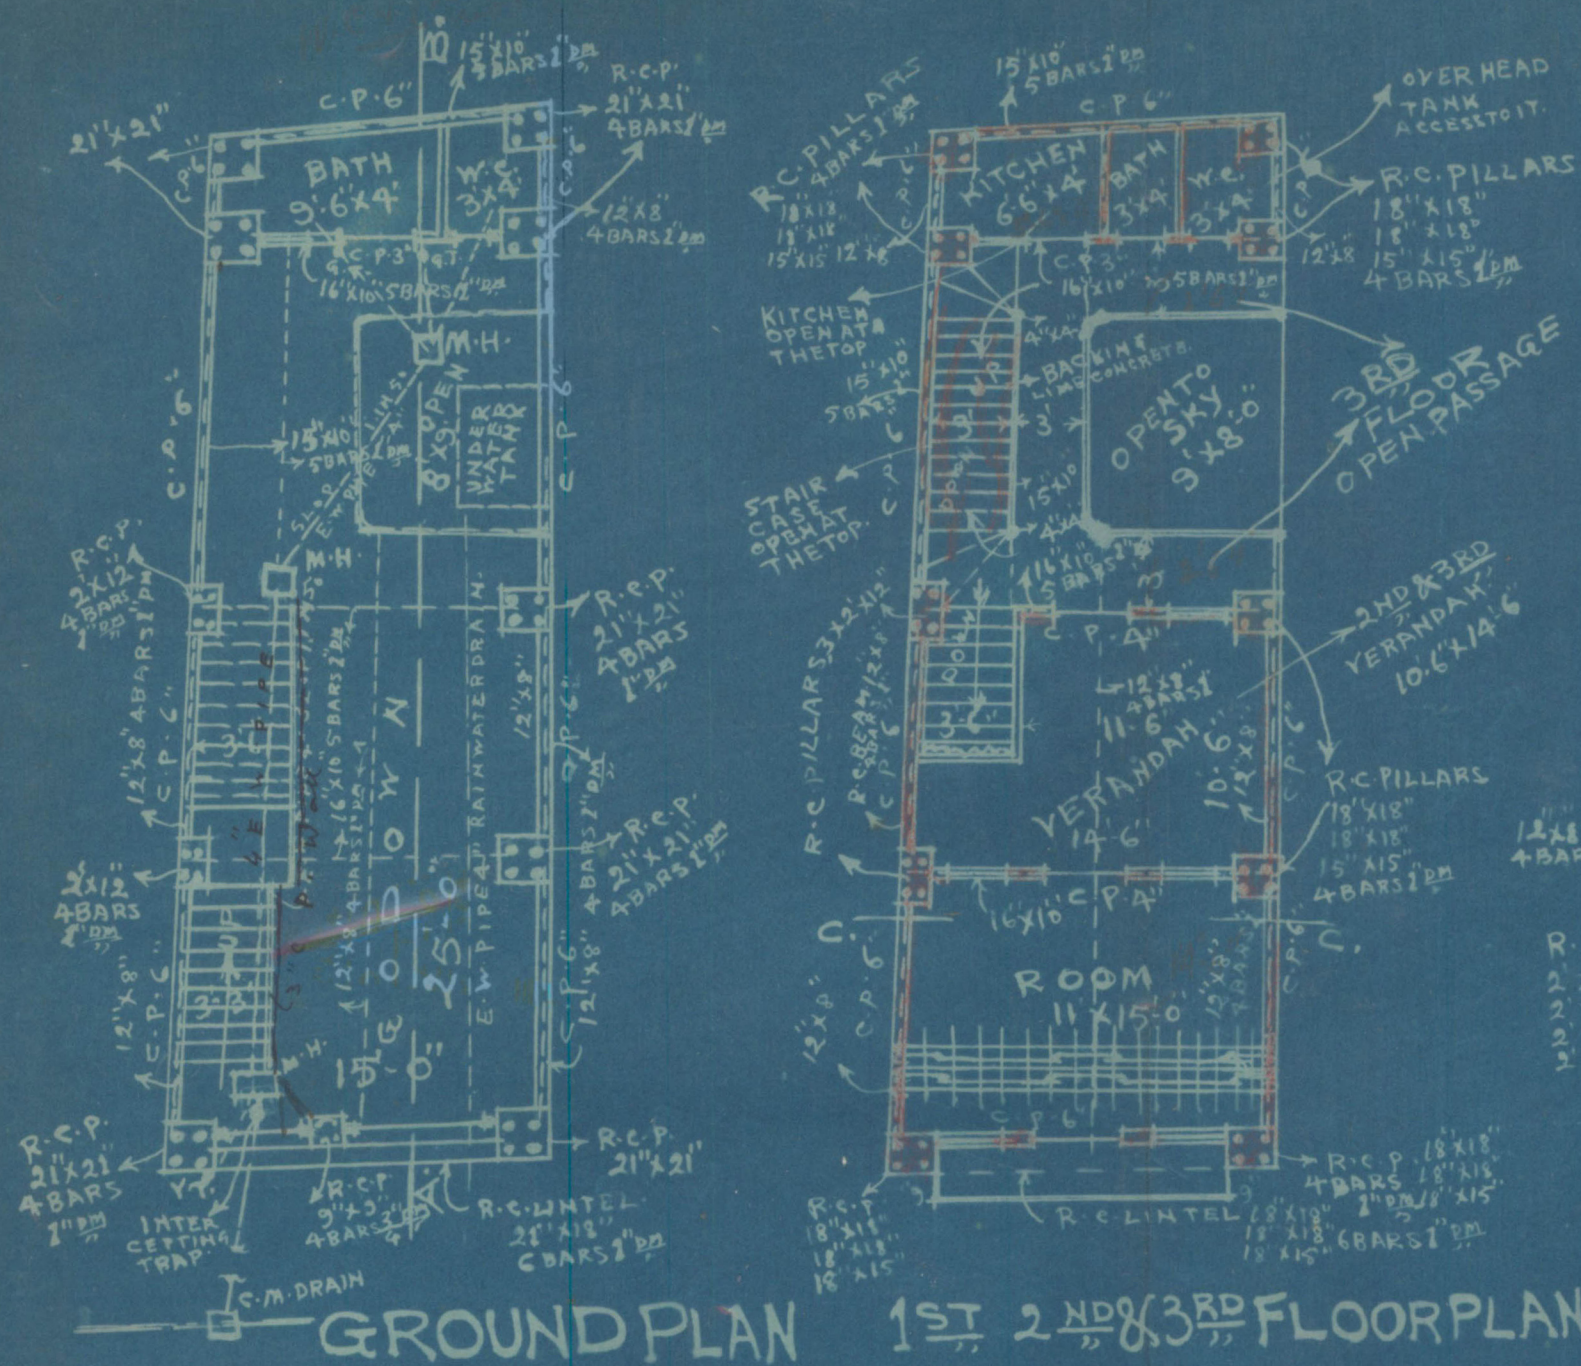


AMENDED PLAN OF BUILDING ON PLOT NO. 112 SHEET NO. M.R. 5 MARKET QUARTER SCALE 8" = 1" INCH

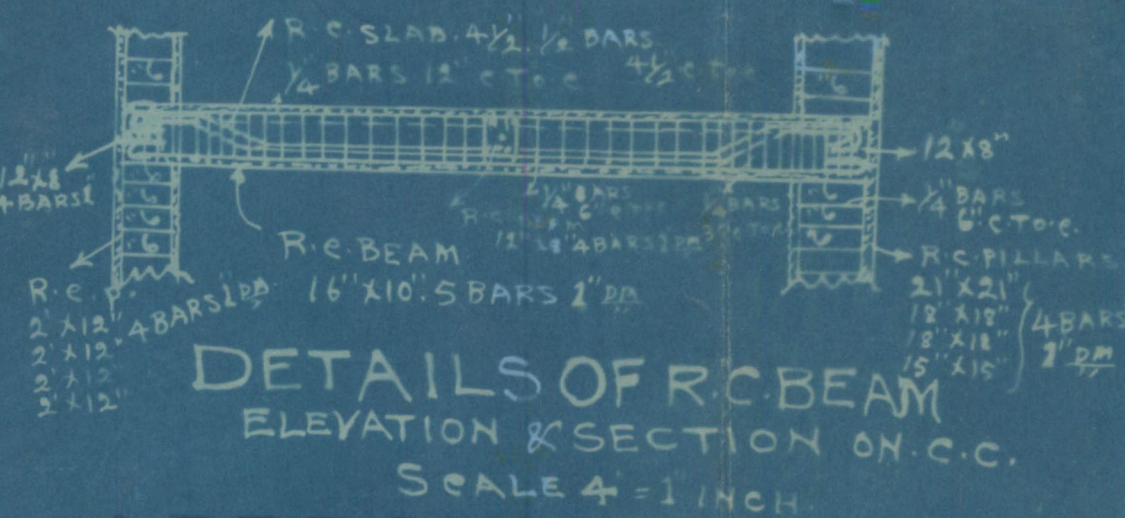

APPROVED.


Land Manager & Architect

BLOCK PLAN SCALE 20" = 1" INCH

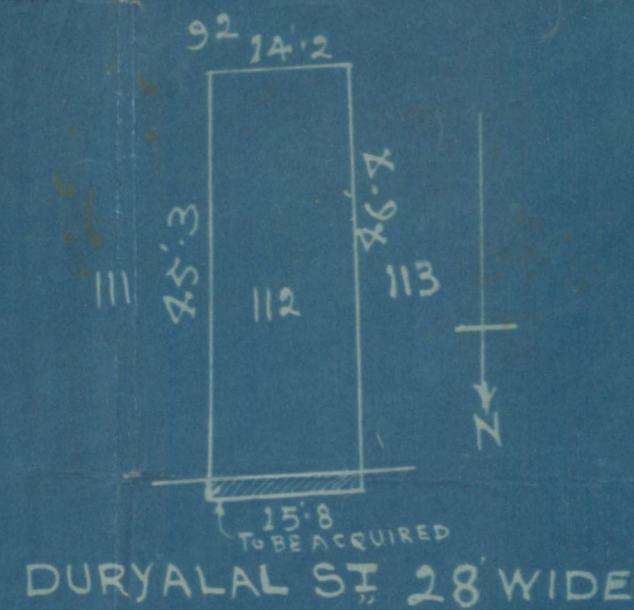

*1250a nava nava
Derigmal Samandas*

*Dev Krishna das h.
16.11.34*

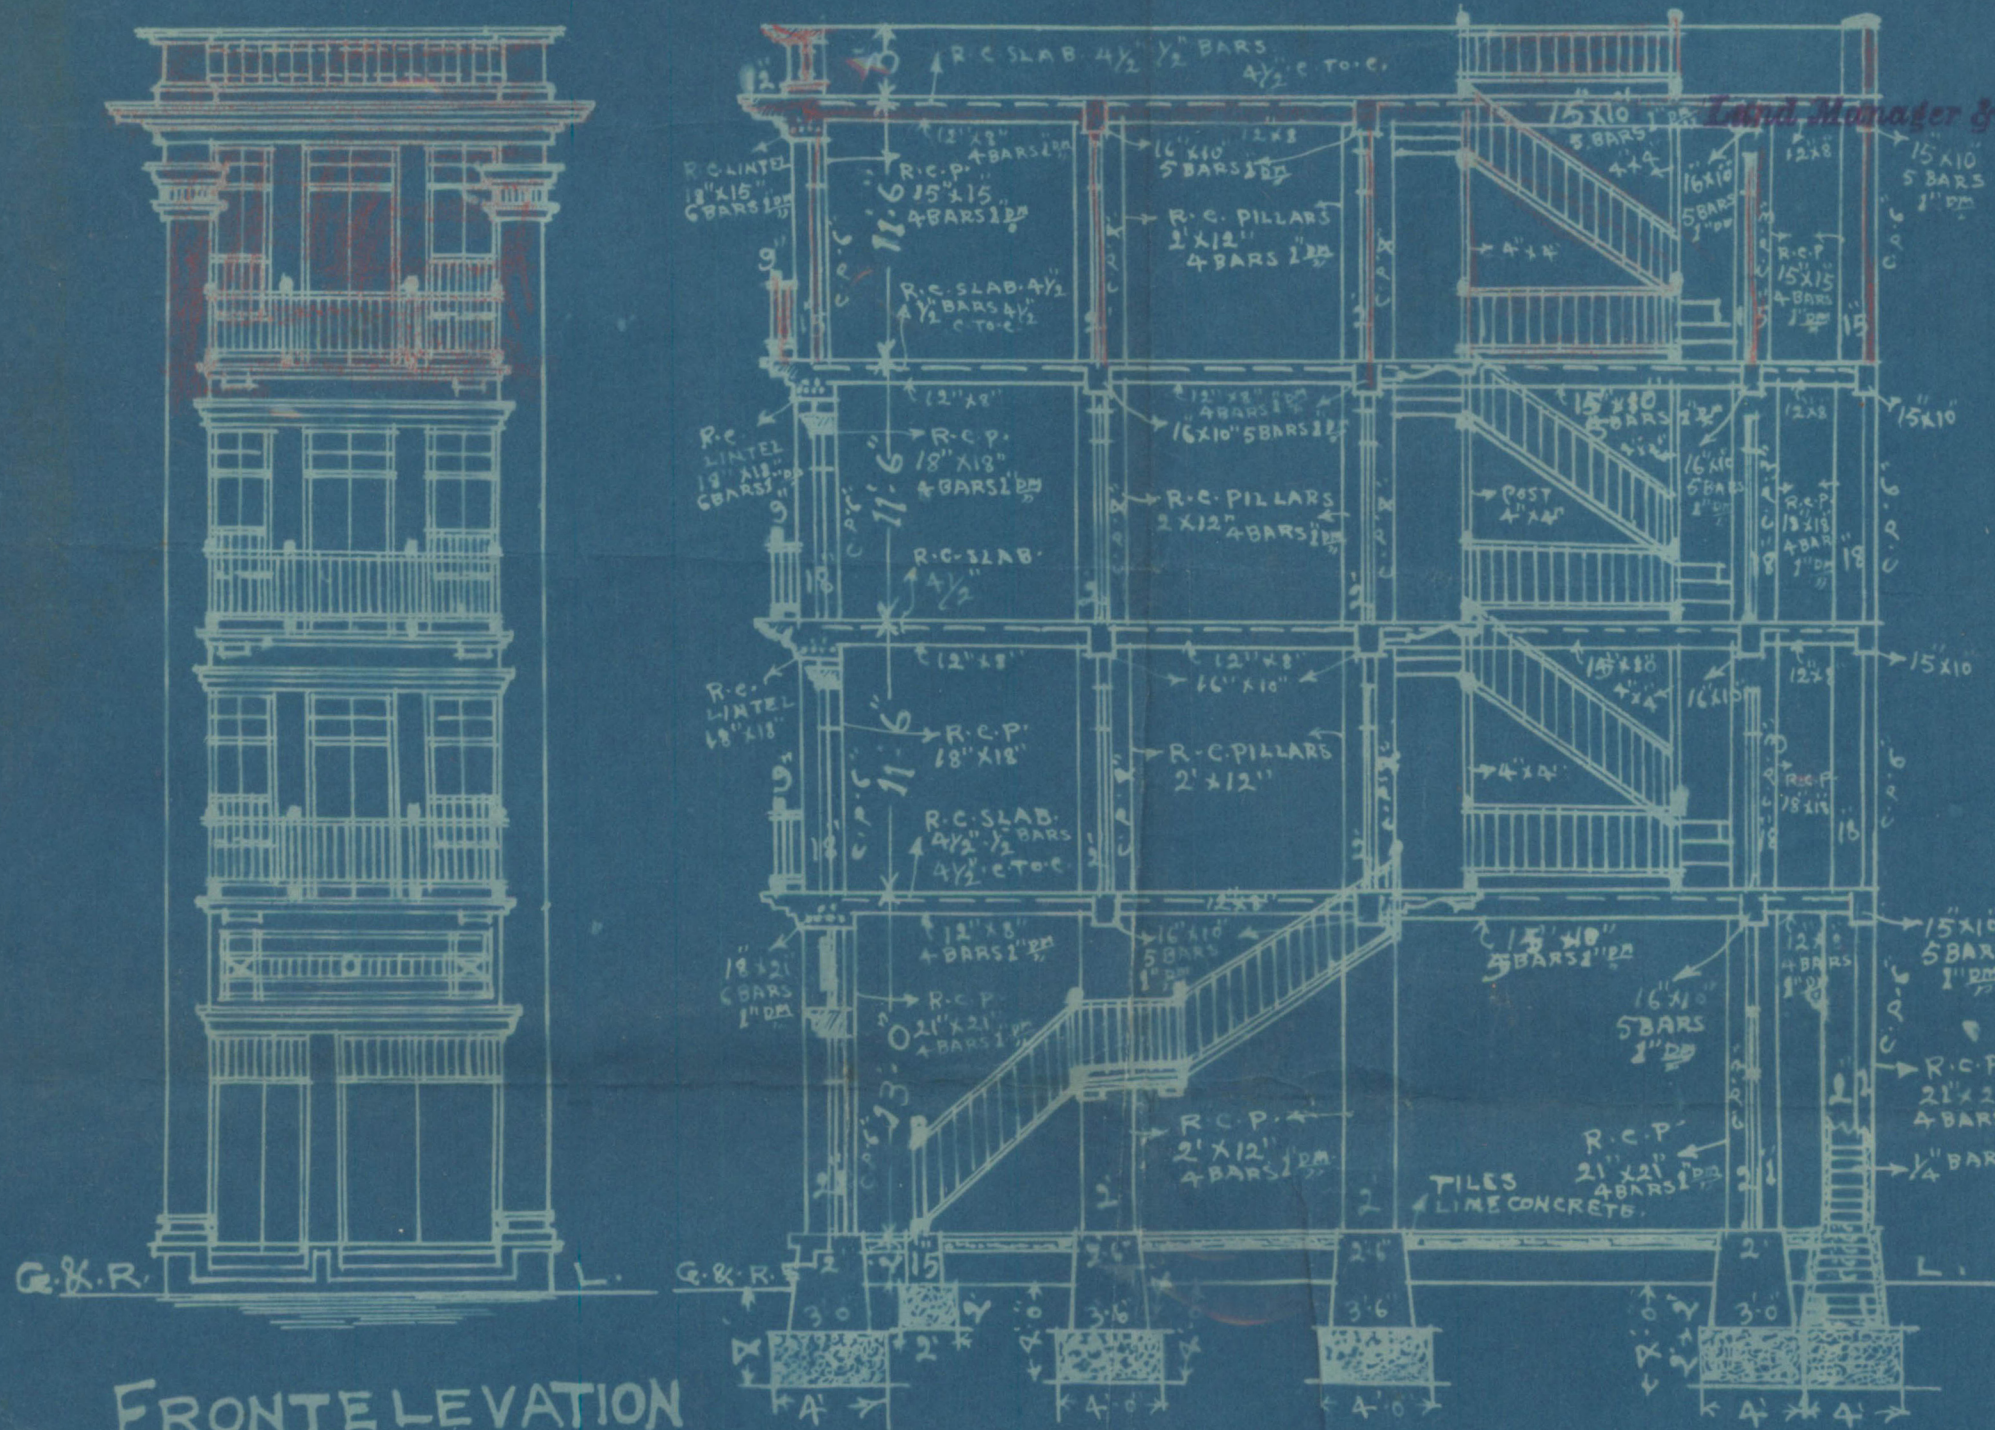

Office Telephone Nos. 1140 & 1141.

Residence „ „ 199.

KUMBERALI BHALEDINO,

L. C. E.

LAND MANAGER & ARCHITECT



MUNICIPAL CORPORATION
KARACHI.



KMR.CDD.MaQ.1934.02

Reference No. B. S. & P.662/34

To,

Mr. Devkishindas (Architect) 10 JAN 1935

for owner .

KARACHI.

RE: Plot No. 112 Sheet No. M.R.5, Market Quarter

Dear Sir,

With reference to your application dated 16.11.34

with amended plans for the building on the above plot a copy of the plan duly signed and approved is returned herewith.

Yours faithfully,

B. S. 35.
600-10-34.

① Stair can be ready for final use
② gallery passage is ready
③ g.v. floor paving remain to be done.

Lambaree Bhaleedino
ce/ Land Manager & Architect. 8/11

27/11



Heritage

KMR.CDD.MaQ.1934.02

DEVKISHINDAS & Co.

NEAR KHORI GARDEN,

ARCHITECTS
AND
SURVEYORS.KARACHI. 13th Dec 1934LAND
ARCHITECT'S DEPT.
KARACHI MUNICIPALITY
13. DEC 1934
4403

To

The Land Manager & Secy
Karachi Municipal Corpn

Sir.

Re plot 112 MR-5
Market Q^r

I hereby inform you
that reinforcement for ground
floor roofing has been laid
for the above plot. Please
depute your B.S to inspect the
same.

Yours faithfully

 DKS
 .ni
 14/12

Devkishindas

P. attach with plans.

17/12




Heritage

KMR.CDD.MaQ.1934.02

DEVKISHINDAS & CO.

ARCHITECTS
AND
SURVEYORS.

NEAR KHORI GARDEN,

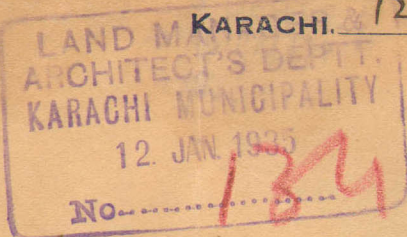12th Jan 1935

To

The Land Manager & Architect
Karachi Municipal Corporation

Re plot no 112 in R-5 marked

Sir,

I hereby inform you
that R.C. roof of 2nd floor
on the above plot will be
fixed on the 16th inst. which
please noteYours faithfully
DevkishindasP.S.
file

P. attach with plan. 15/1

16/1

P. Karp building

17/1



DEVKISHINDAS & CO.

ARCHITECTS
AND
SURVEYORS.MANAGER &
ARCHITECT'S DEPT.
KARACHI MUNICIPALITY
KARACHI.

31. JAN 1935

No.

NEAR KHORI GARDEN.

31 Jan 1935

To

The Land manager & Architect
Karachi Municipal Corporation

Sir

Re plan no 112 M.R.S
market Q²

I hereby inform you
that reinforcement has been
laid for the top floor on the
above building under construction
which please note.

Yours faithfully
DevkishindasMS. inc
1/2P. attach with plan.
1/2

LAND MANAGER &
ARCHITECT'S DEPTT.
KARACHI MUNICIPALITY

27. MAR. 1935

No. 991

NOTICE OF COMPLETION UNDER SECTION 187 (1) OF THE
CITY OF KARACHI MUNICIPAL ACT. 1933.

Karachi, 26th March 1935

To,
The Chief Officer,

Karachi Municipal Corporation,

DEAR SIR,

I hereby inform you that my following building and drainage
work (insert full particulars of the work) Plot no 112 MR-5
Market Q^t. Ground & 3 upper floors
R.C. roofs

has been completed and the certificate of completion signed by the Licensed
Surveyor, who supervised the work, is submitted here-below.

Yours faithfully,

Benjamin Samunda
Owner,

Address

Completion Certificate

TO BE SUBMITTED BY LICENSED SURVEYOR

BUILDING AND DRAINAGE COMPLETION CERTIFICATE.

I do hereby certify that the following building and drainage work
(insert full particulars of the work) Plot no 112 MR-5
Market Q^t ground & 3 upper floors
R.C. roofs

has been supervised by me and has been completed to my satisfaction, that the
workmanship and the materials used are good; and that no provision of the act
or the Bye-laws and no requisition made, condition prescribed, or order issued
thereunder has been transgressed in the course of the work

Signed.

D. Krishnaswami 2

Dated

26th March 1935

NOTICE OF COMPLETION UNDER SECTION 187 (1) OF THE
CITY OF KARACHI MUNICIPAL ACT. 1933.

Karachi, 26th, March 1935

To,

The Chief Officer,

Karachi Municipal Corporation,

DEAR SIR,

I hereby inform you that my following building and drainage
work (insert full particulars of the work) Ground & three upper floors
R.C. Roofs on plot No. 112, M.R.5 Market Qr;

has been completed and the certificate of completion signed by the Licensed
Surveyor, who supervised the work, is submitted here-below.

Yours faithfully,

(sd) Devjimal Samandas .

Owner,

Address

—: o :—

Reference No. B. S. C. 112/M.R.5

Municipal Office,

Karachi, 28.3.35

1. Copy forwarded to the Assessor, Karachi Municipal Corporation for information. The above notice of completion was received on 27.3.35
2. Copy forwarded to the Superintendent of Machinery, Karachi Municipal Corporation to communicate direct to the owner if there is any objection to occupy the building and to send copy of his objection to the undersigned.
3. Copy to the Land Surveyor, Karachi Municipal Corporation to take action at once if there is any encroachment on Municipal Land.

For Land Manager & Architect,
Karachi Municipal Corporation

2000-3.35.

f.e. attached
28/3

P. M. up comp.
report after amends
29/3



BUILDING COMPLETION REPORT.

Land Manager & Architect's Office.

Karachi 5.4.35

Undersigned begs to report that the construction of building
on plot No. 112 Sheet M.R.5 Market Quarter owned by
Mr. Devjimal Samandas
has been completed according to plans approved by the Municipal Corporation.
Orders are requested to file the correspondence.

B. E.

Building Surveyor

,, C ,, Section

No. B. S. CP. 662/34

Karachi, _____

Copy forwarded to the Assessor for information in continuation to this
office No. C. 112/M. R. 5 dated 28-3-35

R. B. 14 { 1000-8-34

Rue Land Manager & Architect.

5.4.35