

Building Completion Report.

MUNICIPAL OFFICE,

CB
Karachi, 26th May 1921.
31

To


THE ENGINEER,

KARACHI MUNICIPALITY.

SIR,

I beg to report, the building work on plot No. 45 A/4. Sheet
61. Jail. Quarter owned by Mr. Atmaram Saini
is completed according to the plan approved by the Municipality. Orders are
requested to file the correspondence.

Yours obediently,

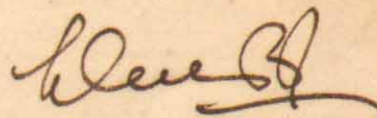

Building Surveyor " " Section,
Karachi Municipality.

*copy to etc
file*

M. C. A. M. I. C. E.
Engineer,
Karachi Municipality

NO. L. S. 8329 of 1921.

Municipal Office.


Karachi 26th February 1921.

MEMO : -

E-1

Re: Plot No. 45-A/4 & 14D, Jail Quarter.

In continuation of this office No. 8180 dated the 26th Ultimo: the Superintendent of Machinery is informed, permission has been granted to the owner of the above plot and so the drainage work may be carried out now.

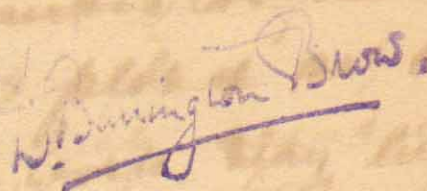
W. Dunnington Brown.

M. C. A. M. I. C. E.

ENGINEER.

KARACHI MUNICIPALITY.

P.L.V.

M.

Memo: —

Re. plot no 45 A/4 9140. Jail 9th

In continuation of this office no
8180 dated the 26th ultimo the

S.O. No. is informed, permission

has been granted to the owner
of the above plot & so the —

Drainage work may be carried
out now.

872

SD

M. C., A. M. I. C. E.,

T. Sincer

Karachi Municipality

31 Jan 1921

To

The Engineer

Karachi Municipality

Re building on plot no 45A/4 2140 E. 1st 1919.

Sir,

In reply to your memo no 1150/258180 dated 26th inst I beg to inform you that I have erected only 6' high partitions which serve as mere curtains and it is not necessary for me to apply for permission I hope you will cancel the notice issued against me.

I beg to remain
 Sir,
 Your most obedient servant
 Ghulam Ishaq Khan

Mr. Bhall
 for the report
 8/2/21

File
 8/2

Form No. 17-400-4-7-19.

No. L. S. 8180 OF 1921.

MUNICIPAL OFFICE,

Karachi, 25th Jan 1921.
26

Memo.

Mr. Atmarain Shivandas
Messrs.

is informed that it is observed that in building

his Building on Plot No. 45 A/4 4140
sheet Nos.

Survey Sheet 81., Jail Quarter,

he is deviating from the approved plan, He is erecting
~~partitions walls~~ extra to make more room
in the 2nd floor & one room in the middle without
permission

Instructions are therefore given to him to at once stop the work and
them
make the building in conformity to the approved plan, or steps will be taken
under the Act.



A.M. INST. C.E.

Engineer,
Karachi Municipality.

8181
S.C.

Copy to owner
to Supdt of work
for information and
to stop the drainage
work.



Heritage

KMR.CDD.JaQ.1920-1921.01

No. L. S.

OR 1920

Form No. 6.

No. 106

MUNICIPAL OFFICE,

Karachi

22.

4.

1929.

MEMO :

Building Surveyor Section "B" is informed
that Mr. Atmaram Shandas has been permitted
to build shops & offices
his house
on plot Nos 45 A/4 & 14 D E1 Bunder Road
Jail Quarter report should be made to the
Undersigned when the house is completed.

L. A. H. K. Roy

A.M. INST., C.E.,


Engineer,

Karachi Municipality.

No. 106

BLOCK PLAN

SCALE 20' = 1" IN.

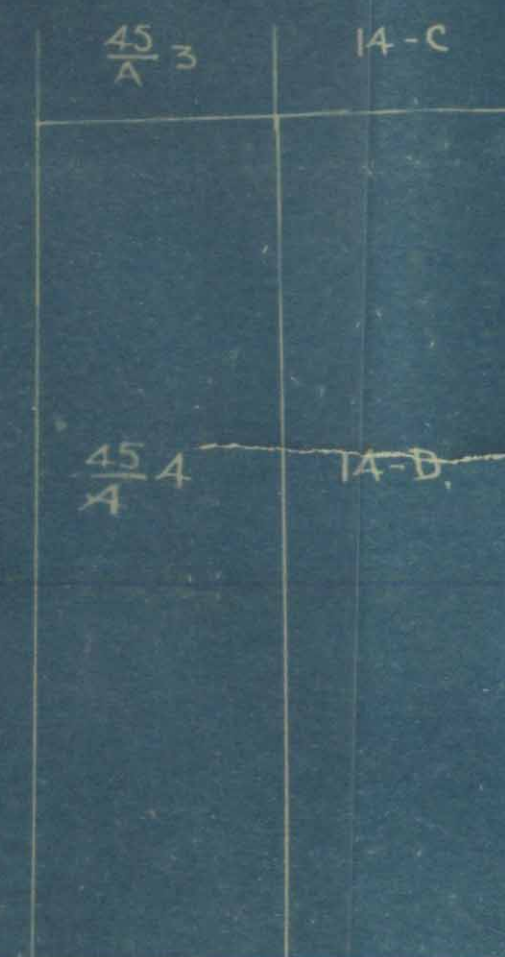

ROAD 35' WIDE

BURDER ROAD

SECTION ON A.B.

Florian human


1911.16

AMENDED PLAN OF BUILDING ON

PLOT Nos 45 A 4, 14-D

SHEET E-1 JAIL QUARTER

SCALE 8' = 1" INCH.

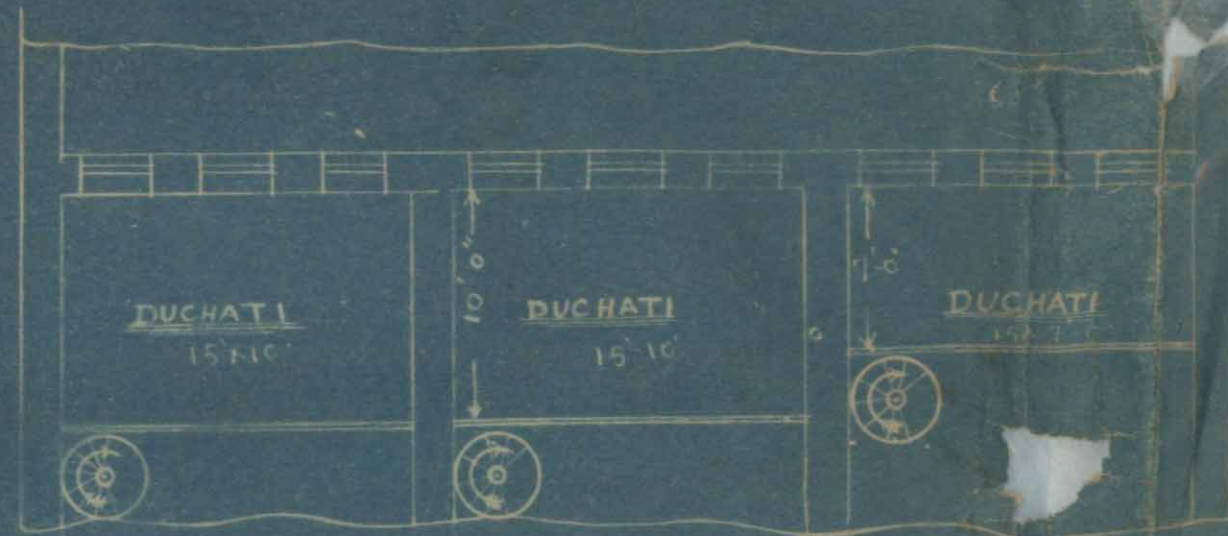

DUCHATI PLAN



GROUND PLAN

FIRST AND SECOND FLOOR PLAN

