



Heritage

KMR.CDD.SeQ.1926-1928.01

LAND DEPARTMENT.

FILE No. of 1928

Compilation No.

Completed Building

Subject

32, 4-4, Sadar Bazar.

NOTE:—Former Correspondence filed in

file

Compilation No.

Subsequent Correspondence filed in

file

Compilation No.

Form No. 37/A-500-12-7-26.

BUILDING COMPLETION REPORT.

MUNICIPAL ENGINEER'S OFFICE,

Karachi, _____ 192

To

THE ENGINEER,

KARACHI MUNICIPALITY.

SIR,

I beg to report the building work on plot No. 32 Sheet G.4

Siddiq Bazar Quarter owned by Mr. Sydar Khan
completed according to the plan approved by the Municipality. Orders are requested to file the correspondence.

Yours obediently,

4/12/28
Building Surveyor "A" Section,
Karachi Municipality.

2. Only two tenements on the East
are constructed

N.L.S. 15268 of 1928.

Karachi, 4/12 1928.

Copy to the Assessor and Collector for information

6/12/28

B. SC., A. M. INST. C. E.,
Land Manager & Architect.
Karachi Municipality.

Form No. 6-500-1-4-26.

No L. M. A. 7575⁺ of 192 .

MUNICIPAL OFFICE,

Karachi, 27-7-1928

MEMO:

Building Surveyor Section A is informed
that Mr. Hyderkhan has been permitted
to build
his house
on plot No. 32, C-4, Saddar Bazar Street
Quarter, report should be made to the
undersigned when house is completed.

Indira
Executive Engineer,
Karachi Municipality.

SEN
27-7-26 *me*

DRAWING NO 366

BLOCK PLAN


SCALE 4'-0"=1" INCH

PLAN

PO

SOMERSET STREET 80 WIDE

DINSHAW STREET 13' WIDE

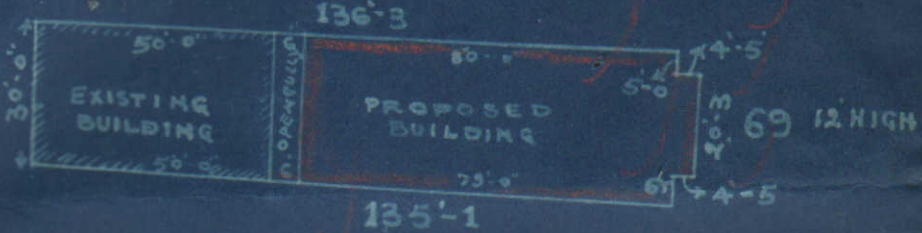


POLICE LINES STREET 22'-3" WIDE

EXISTING BUILDING

APPROVED


M. H. Jani

Executive Engineer,
Karachi Municipal Corporation

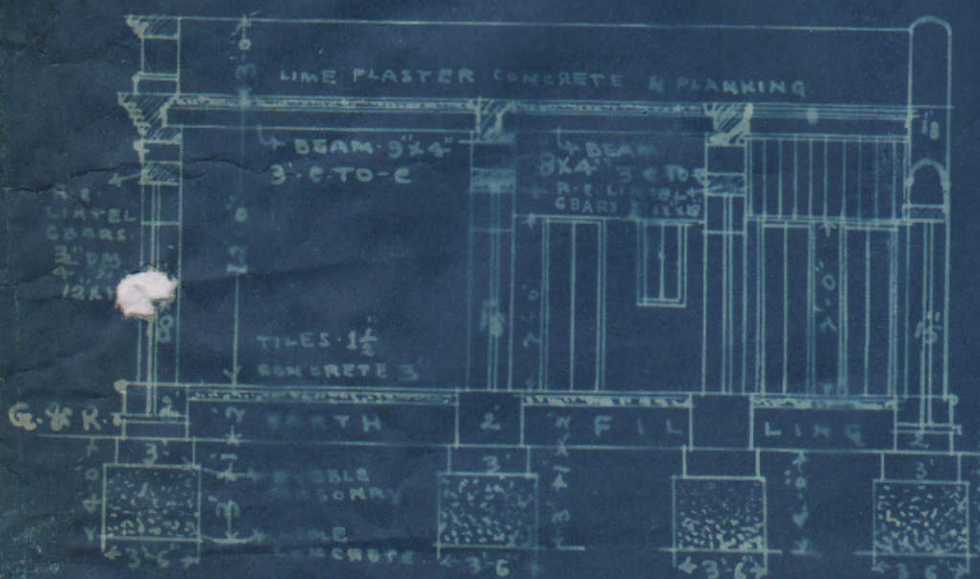

SECTION ON A-B

M. H. Jani
DRAFTSMAN
KARACHI

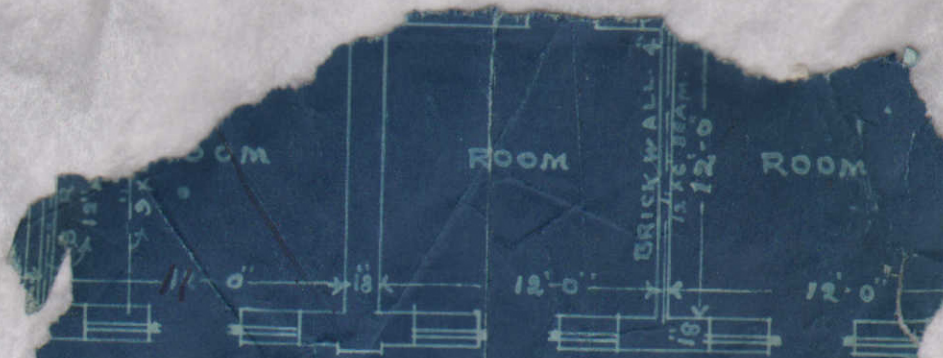


FLOOR PLAN

W. C. H. H. H. H.

Architect

7/1/19

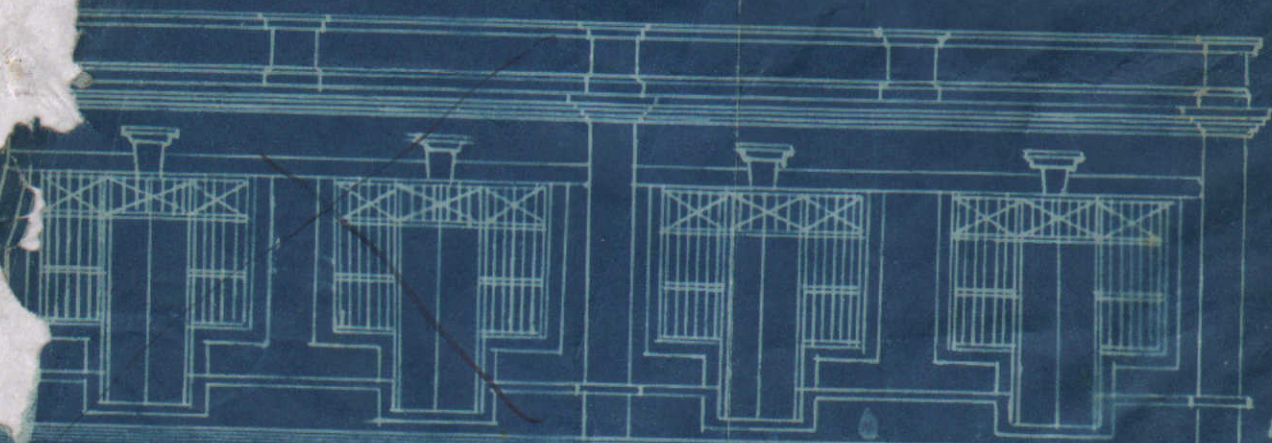

FRONT ELEVATION