

38



Heritage

KMR.CDD.NaQ.1928.01

Form No. 37/A-200-24-7-23.

BUILDING COMPLETION REPORT.

LAND MANAGER AND ARCHITECT'S OFFICE,

Karachi, _____ 192 .

To

THE LAND MANAGER AND ARCHITECT,
KARACHI MUNICIPALITY.

SIR,

I beg to report the building work on plot No. 32 Sheet N.P.10

~~Rafiq~~ Quarter owned by Mr. Hussain bhay Mohomed bhay
completed according to the plan approved by the Municipality. Orders are
requested to file the correspondence.

Yours obediently,

Shawanda I C M
Building Surveyor "B" Section,
Karachi Municipality.

19/12

No. L. M. A. 16145 of 1928 .Karachi, 20/12 1928 .

Copy to the Assessor & Collector for information.

B
20/12/28

B. Sc. A. M. Isnt C. E.
Land Manager and Architect.
Karachi Municipality.



2

274

Form No. 6—300—28-6-27

No. L. M. A.

15966

of 1928.

MUNICIPAL OFFICE,

Karachi, 18/12 1928.

MEMO:


Building Surveyor Section 'B' is informed
that Mr. G. N. Kala has been permitted
to build
his house
on plot No. 52 N.P. 10 Street
Napier Quarter, report should be made to the
undersigned when house is completed.

M. S. T. N. A.
Executive Engineer,
Karachi Municipality.


4/12

AMENDED PLAN SHOWING BUILDING ON PLOT
NO. 52 SHEET NO. N-P.10.
NAPIER Q^M
SCALE 8"=1'


OWNER - HUSAINBHAI MOHAMMADHAI

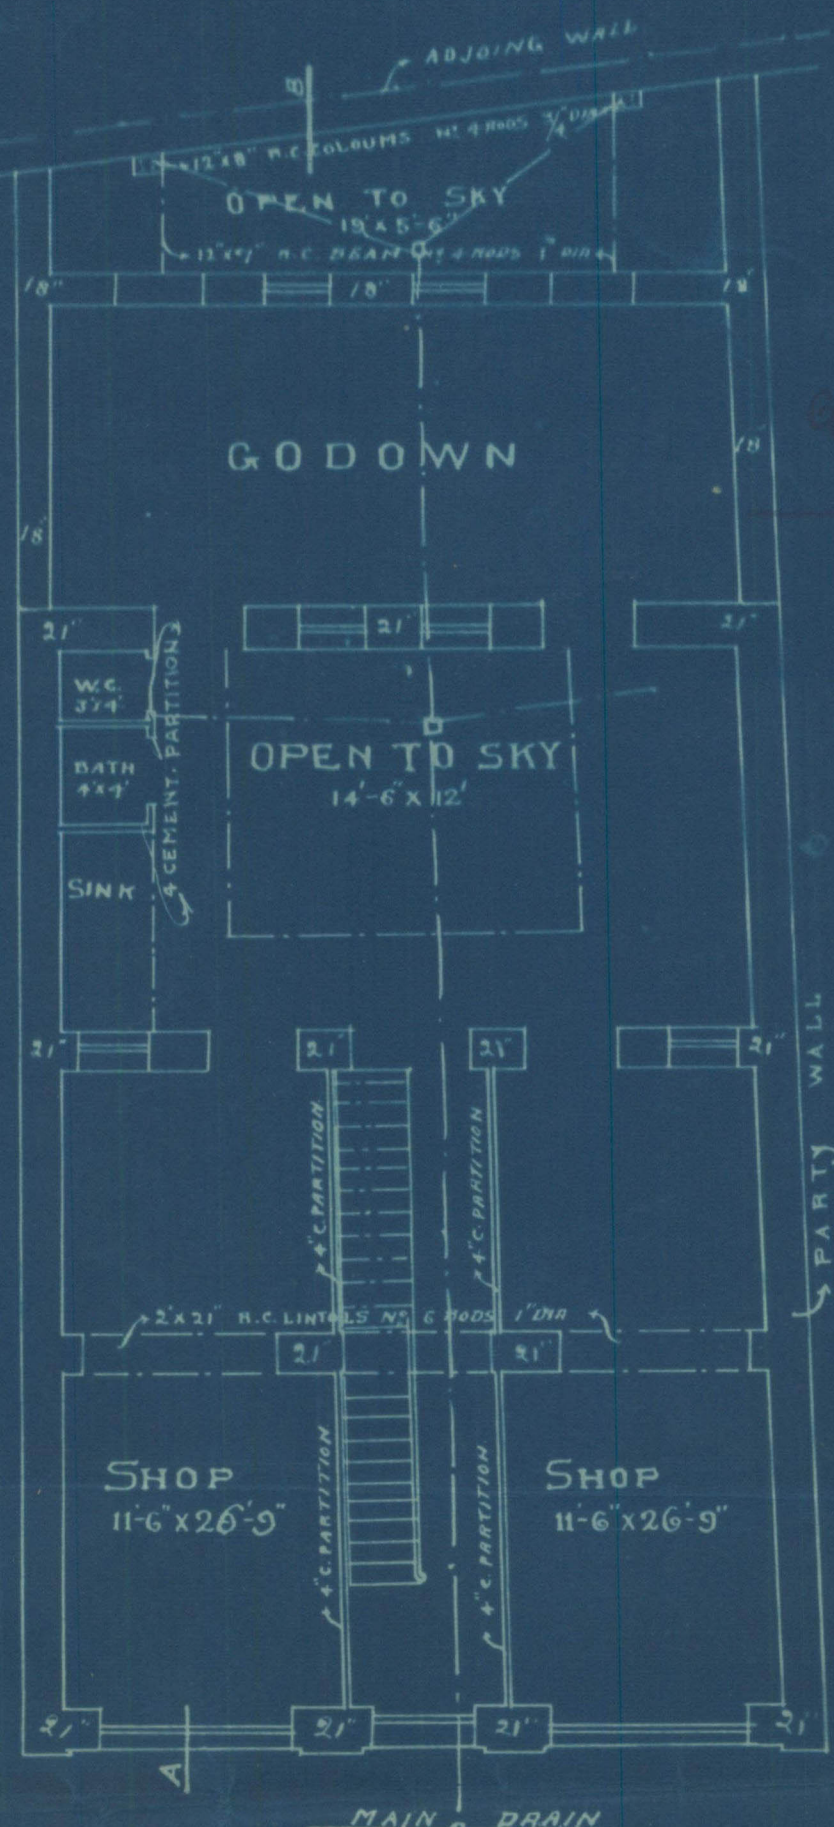


GROUND PLAN

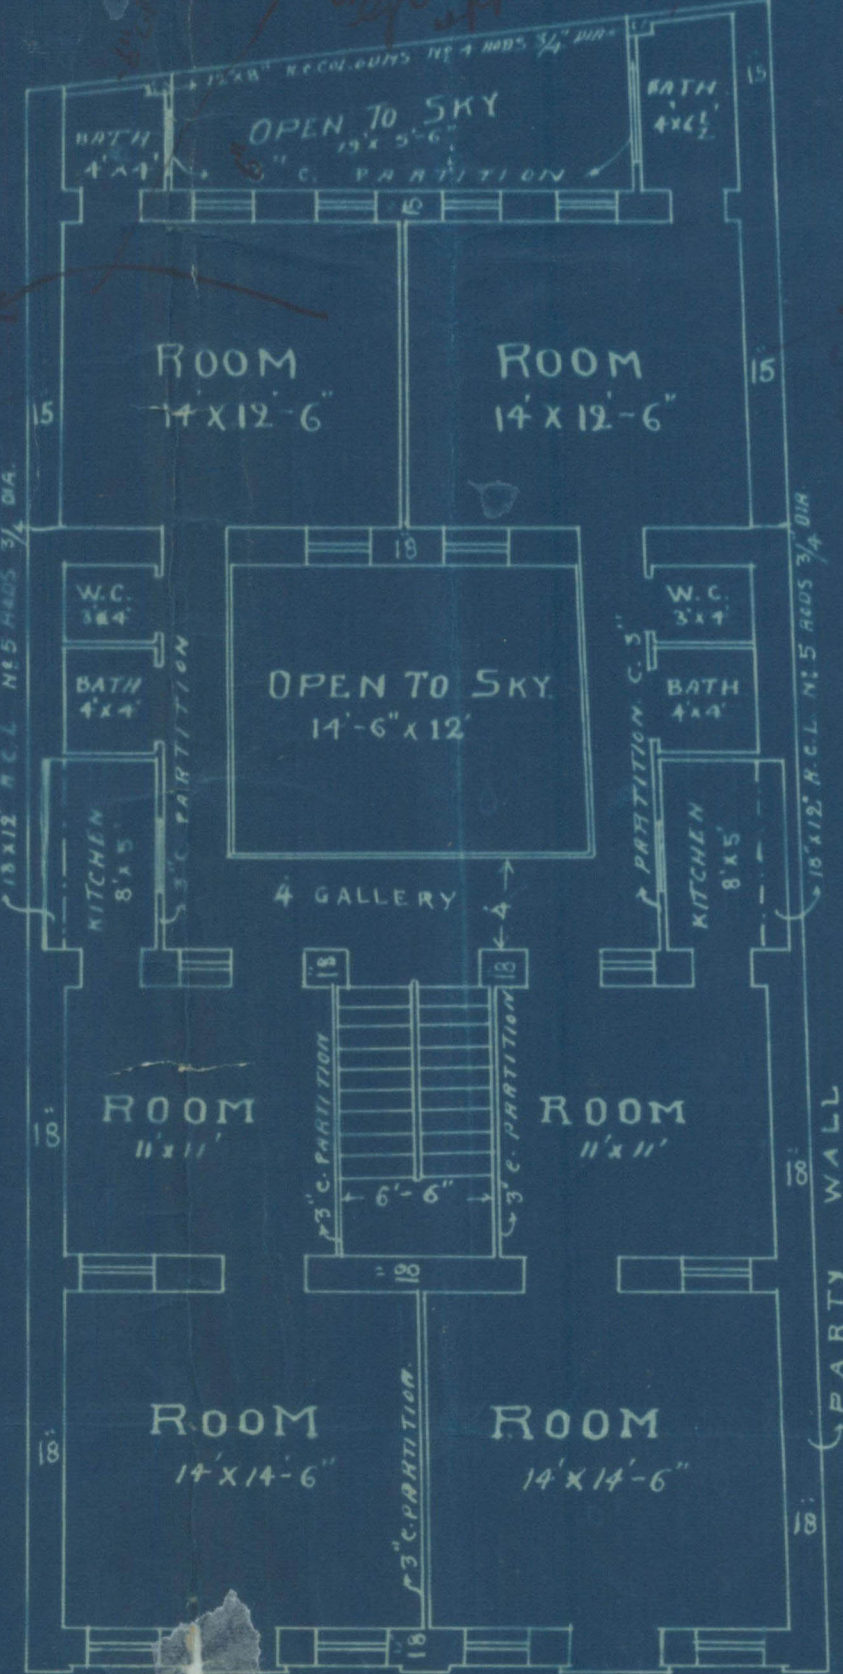


1ST 2ND & 3RD FLOOR PLAN

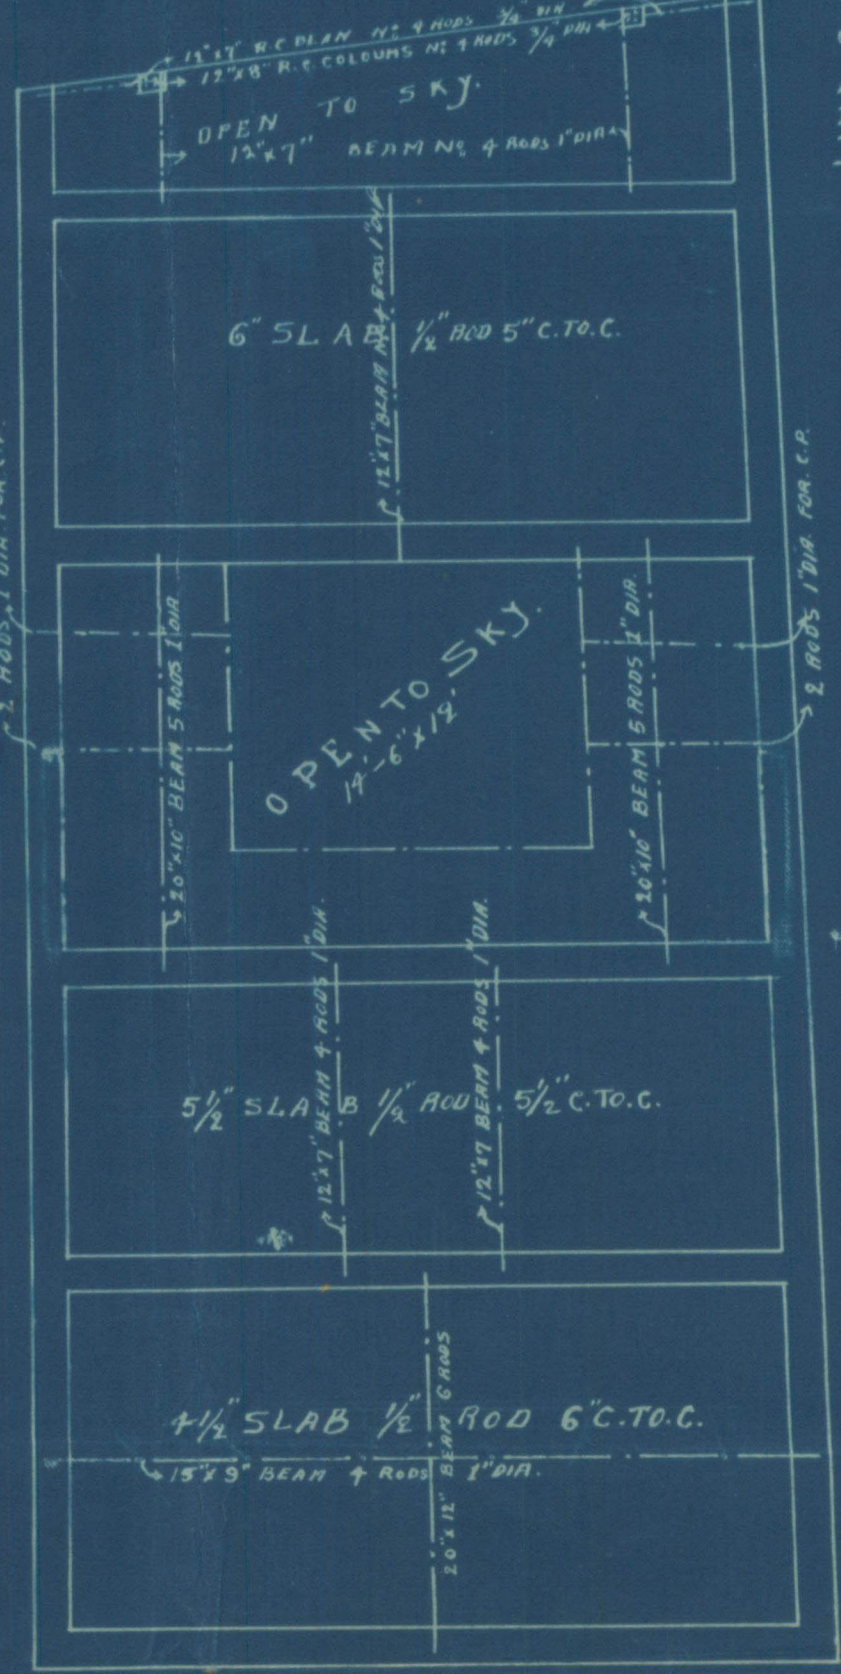


ELEVATION

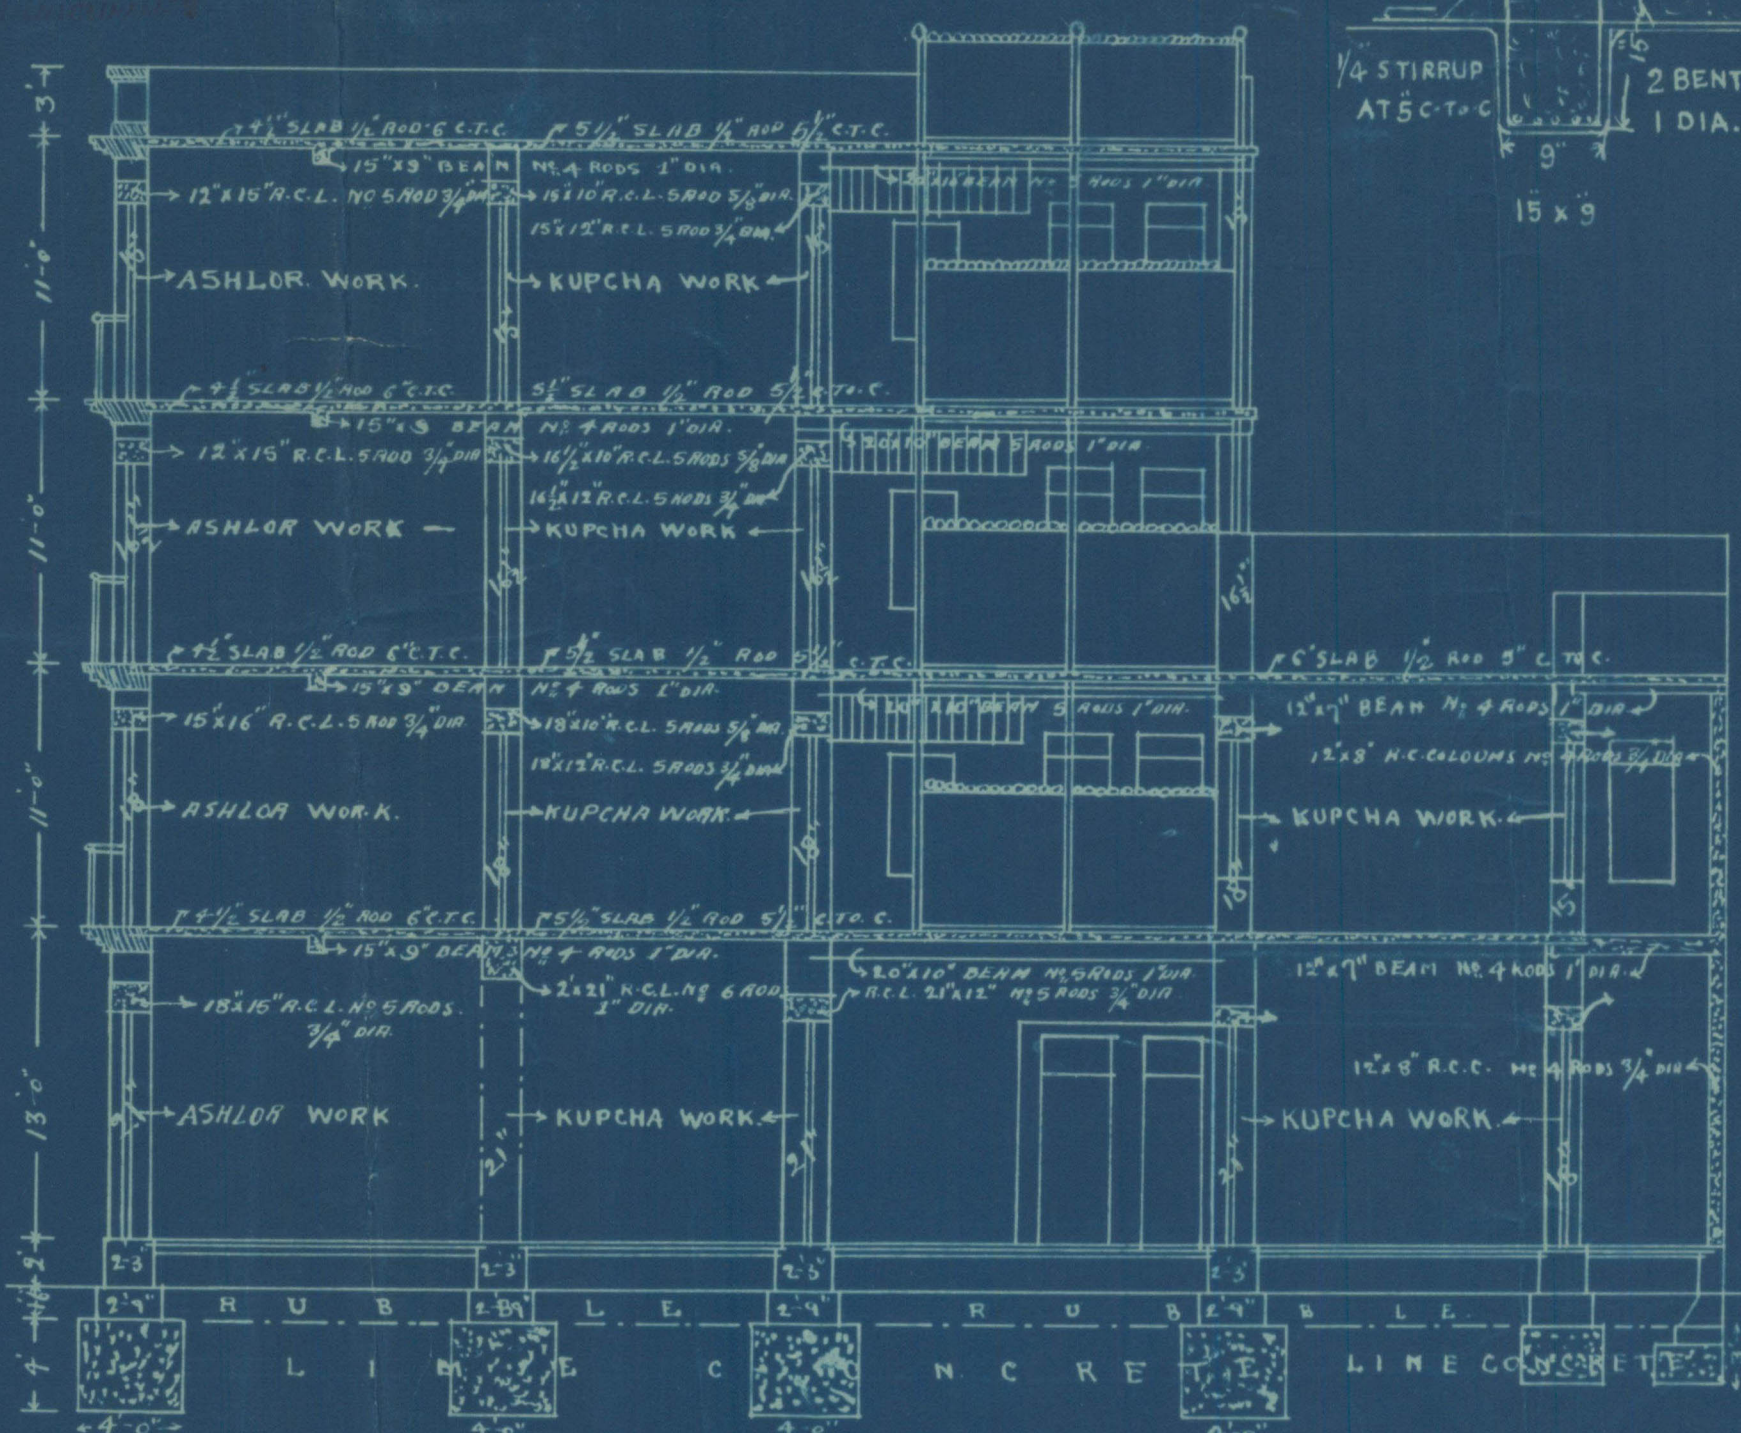

SECTION ON A.B.

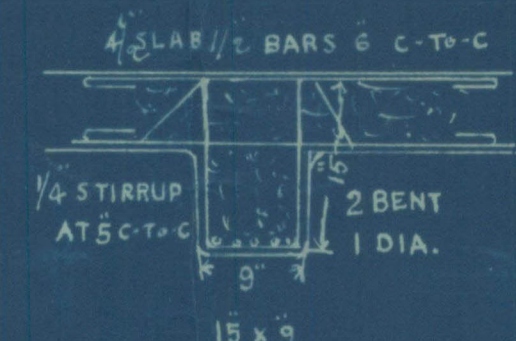

SITE PLAN
SCALE 20"=1'

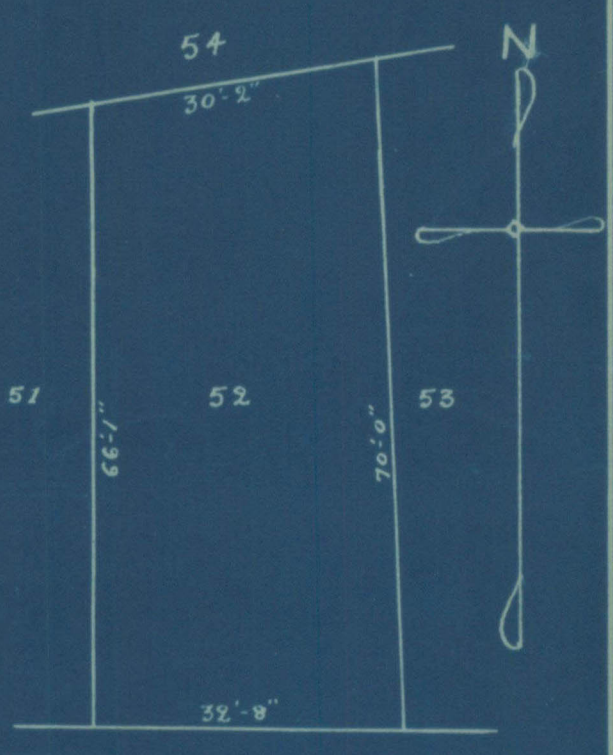

DARYALAL ST 35'