




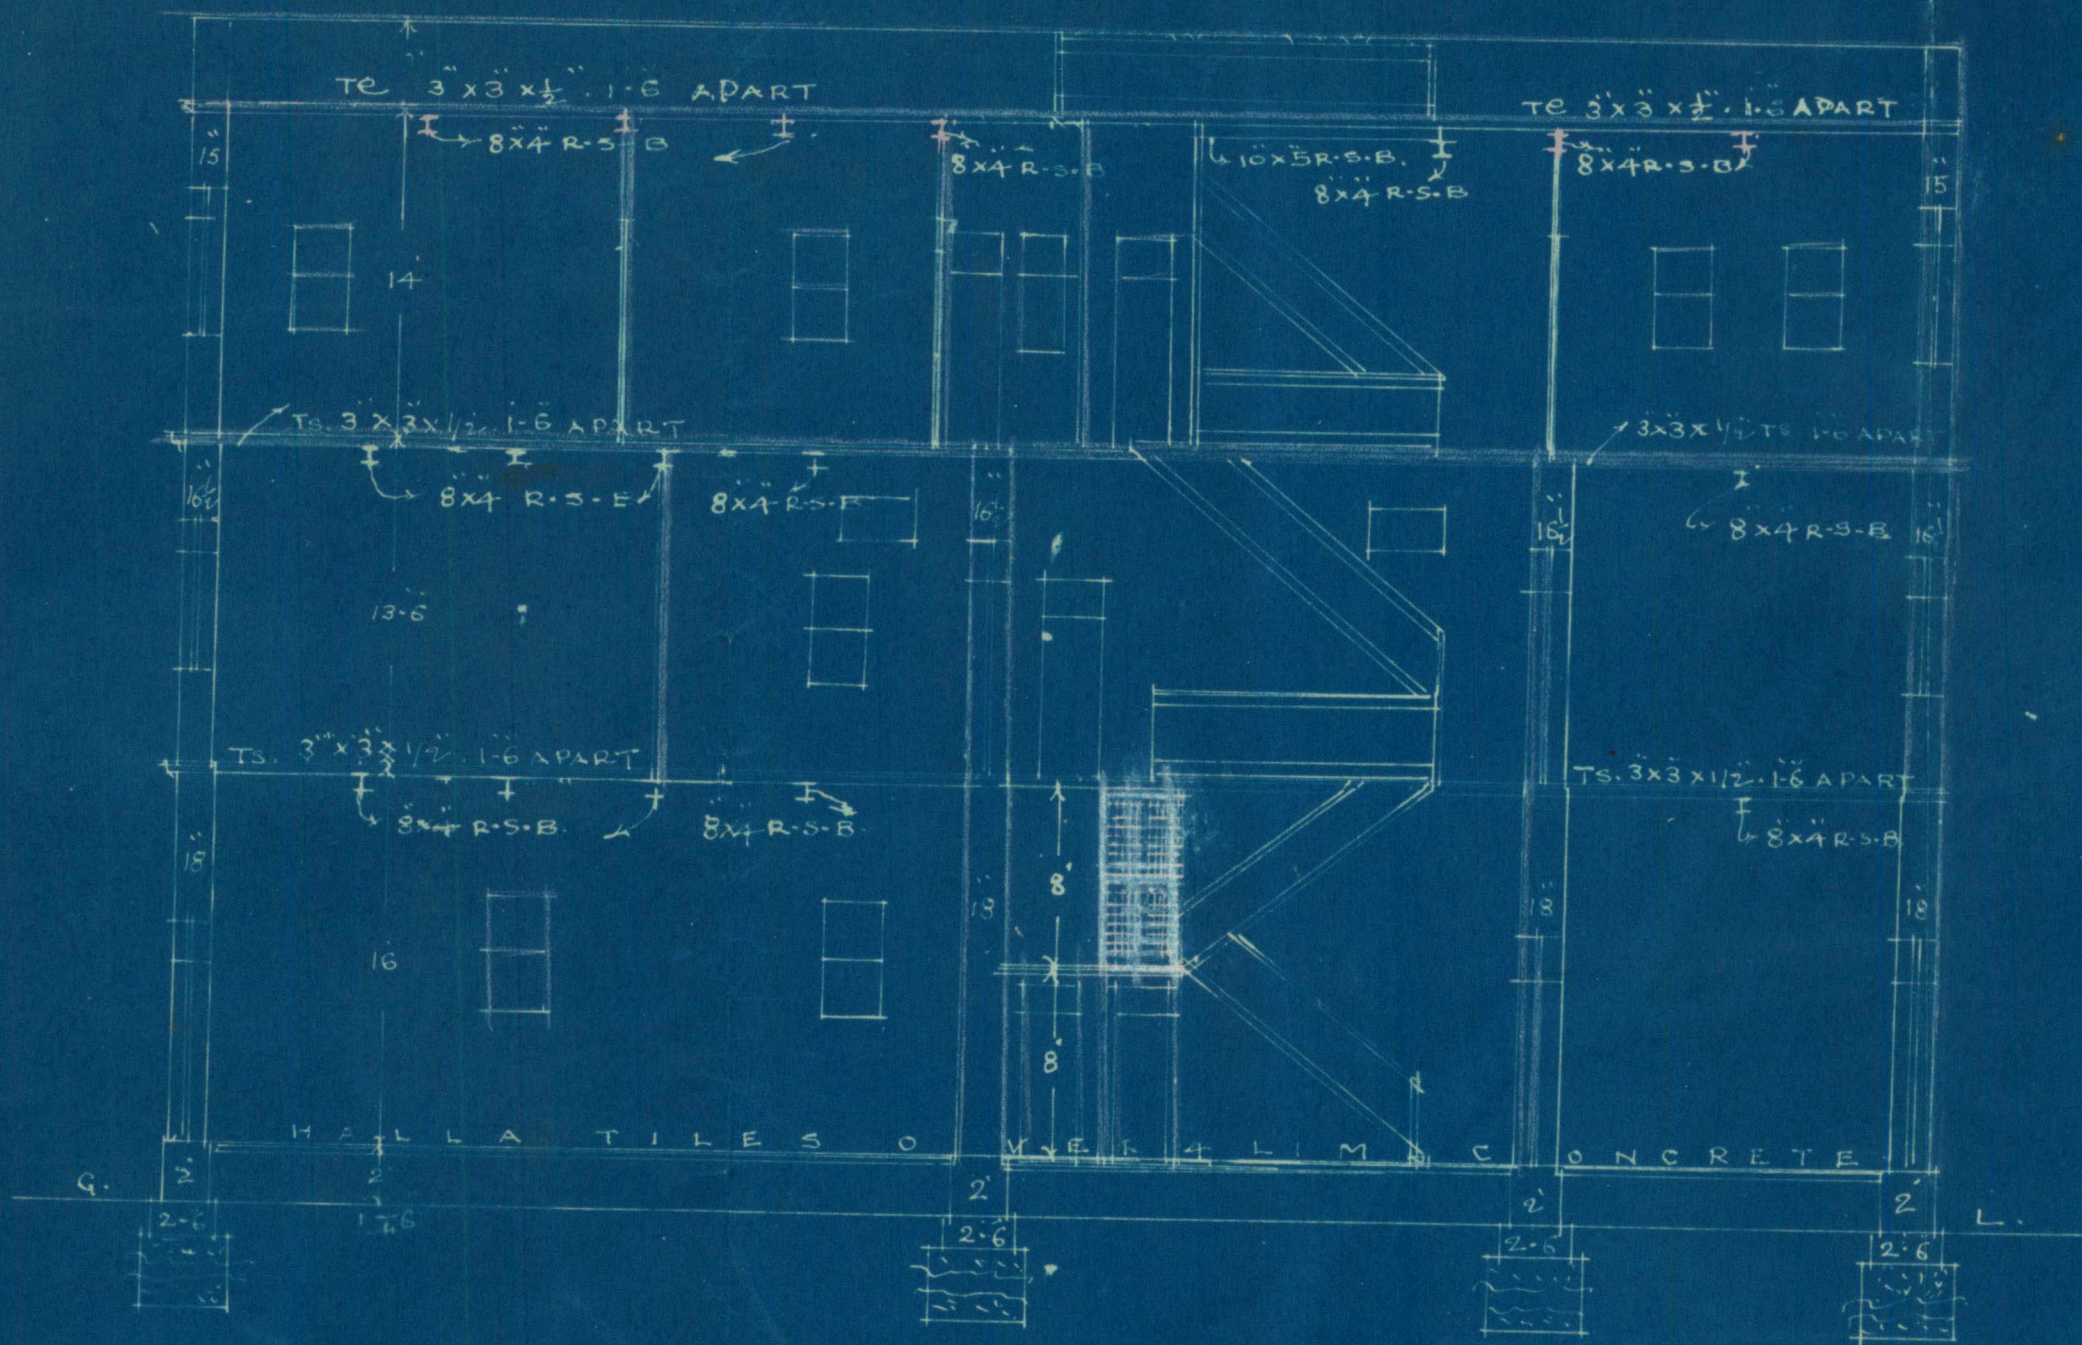


SECTION ON A-B.

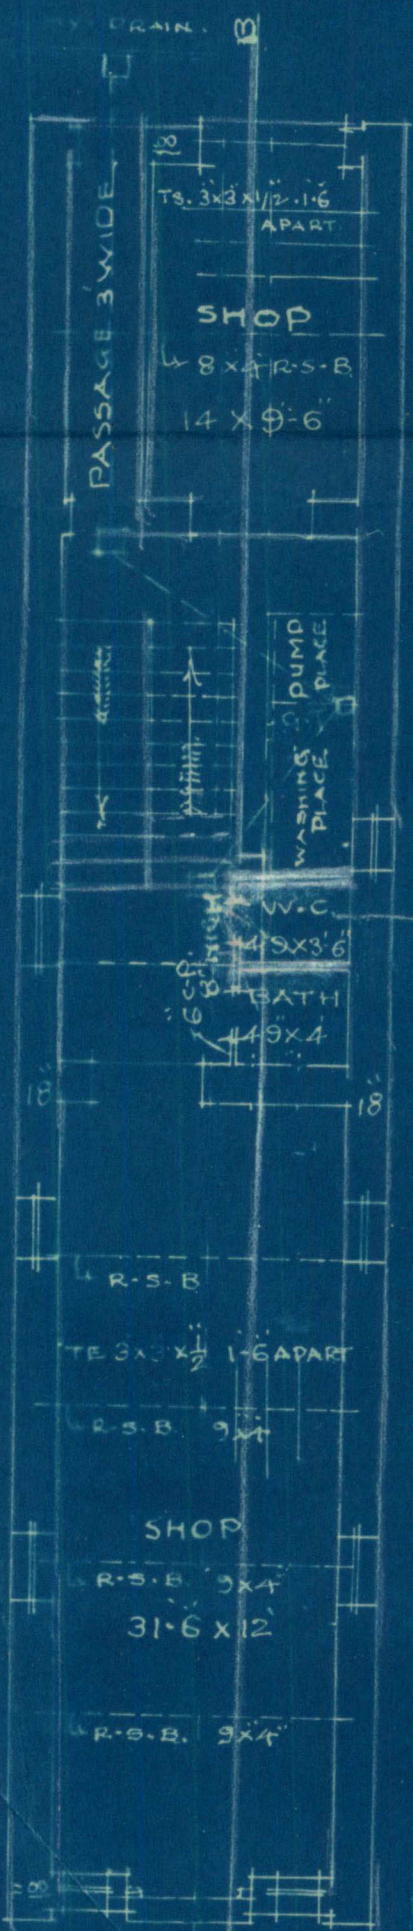

GROUND FLOOR

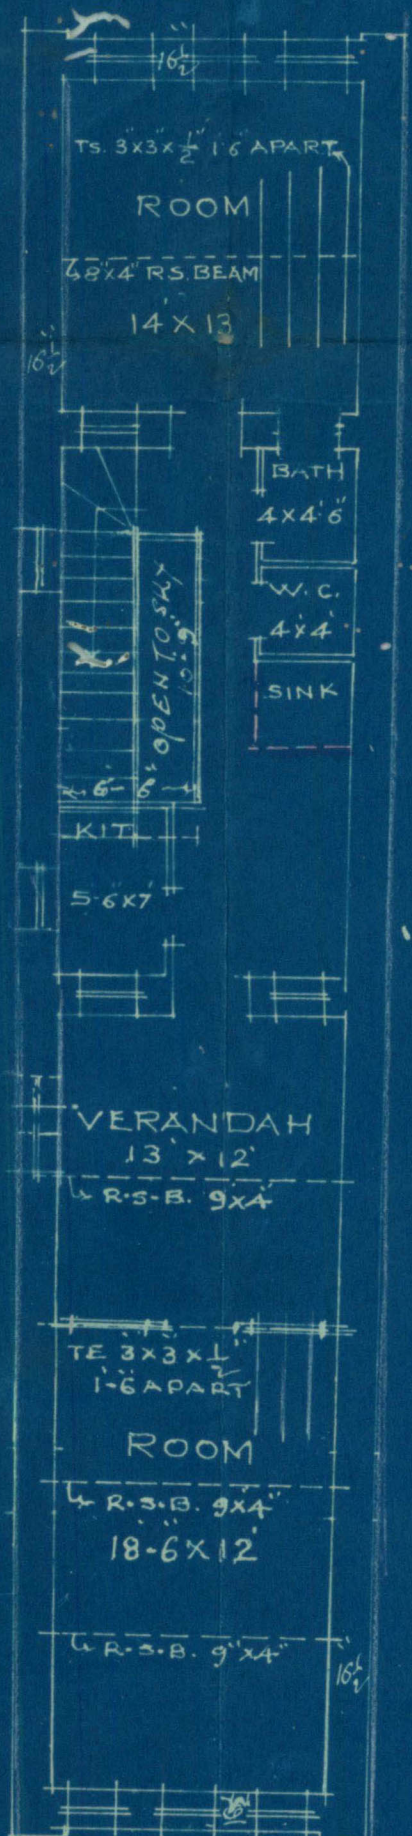


FIRST FLOOR

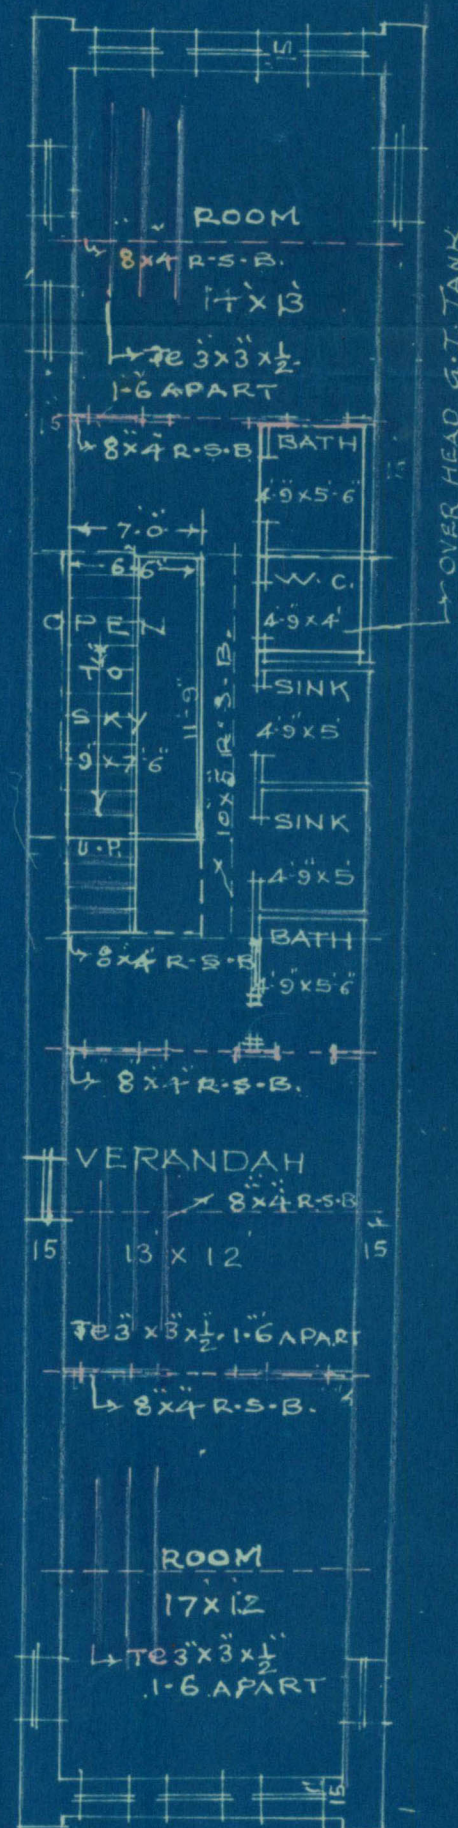

SECOND FLOOR

COMPLETION
PLAN SHOWING PROPOSED RENEWAL
ROOFS ON PLOT NO 9 M R 2
MARKET QUARTER
SCALE 8"=1"

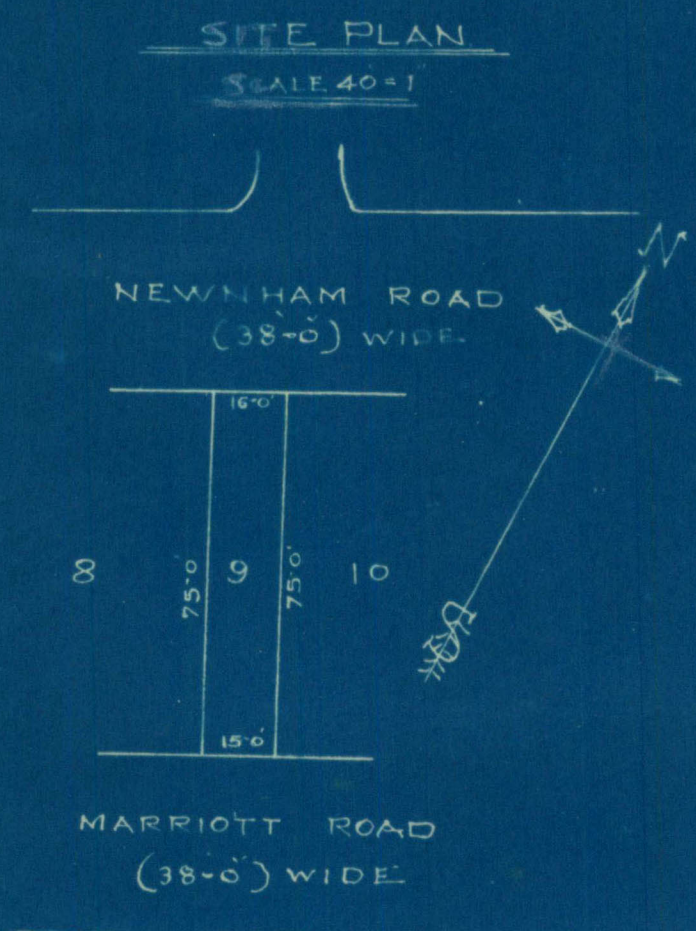



2

Municipal Office,
Karachi,
3rd July 1942.

To,

The Members of the water supply Committee,
KARACHI.

Dear Sirs,

I have to inform you that I have convened a Meeting of the Water supply Committee jointly with that of standing Committee with the Chairman, standing Committee's approval, in the standing Committee Room tomorrow the 4th instant, @ 9-15 a.m. to consider the subject of High Pressure scheme further and to request you to kindly make it a point to attend the same.

Yours faithfully,

Mayor,
Chairman, water supply
Committee.

M. J. SHAH & CO.,
ARCHITECTS & ENGINEERS.

COURT CHAMBERS,

KARACHI, 194

B.S.'s objection.

(2) - Objections No. 8, 9, 2, 12 & 11-20

have now been Confirmed
with.

(3) - Confirmed with.

(4) - The same as No. (1).

(5) - The C.O.'s permission
may please be obtained

The plans may please
therefore be approved at an
early date & oblige

Yours faithfully
M. J. Shah

M. J. SHAH & CO.
Architects & Engineers
Court Chambers, KARACHI.

NOTICE OF COMPLETION UNDER SECTION 187 (1) OF THE
CITY OF KARACHI MUNICIPAL ACT, 1933.Karachi, 11.11.38

To,

The Chief Officer,
Karachi Municipal Corporation.

DEAR SIR,

I hereby inform you that my following building and drainage
work (insert full particulars of the work) 97/105 etc - 1301
110-13, Street S.B.1

has been completed and the certificate of completion signed by the Licensed
Surveyor, who supervised the work, is submitted here-below.

Owner.

Yours faithfully,

Address

:o:

Reference No. B. S. C. 12/1051

Municipal Office,

Karachi,

DEC 3 - 1938

1. Copy forwarded to the Assessor, Karachi Municipal Corporation for
information. The above notice of completion was received on 14.11.38

2. Copy forwarded to the Superintendent of Machinery, Karachi Muni-
cipal Corporation to communicate direct to the owner if there is any objection
to occupy the building and to send copy of his objection to the Undersigned.

3. Copy to the Land Surveyor, Karachi Municipal Corporation to take
action at once if there is any encroachment on Municipal Land.

✓ 4. Copy with original and F. C. forwarded to the Building Surveyor
to please report if the work is done in accordance with the approved plan.

P. put up comp report

3/12

For Land Manager & Architect,
Karachi Municipal Corporation.

28/11

40/724
40

28th May 1940.



To,

R.B. Shivratan G. Mohatta,
Karachi.

Dear Sir,

I have to acknowledge the receipt of your letter dated the 25th instant, making some suggestions in connection with water supply, and to state that the matter is receiving attention.

Yours faithfully,

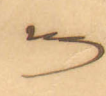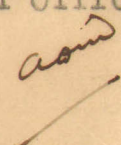
Chief Officer.


MGK/-

R.C.

Please return to the Council Clerk for placing before the Sub-Committee.

21/5
at 3-15 PM.



BSP 502/40.

33/34 BRS

6

1000-3-40.

KARACHI MUNICIPAL CORPORATION.

Diary sheet in respect of Building Regulation plans received.

Date of receipt.	Date When sent.	Date When Retd.	Date when sent to B. S.	Date when put up to L. M. A.	Date when obj sent.	Remarks.
9 12/12/40 B. S. ...						
H. O. ...						
E. E. ...						
L. S. ...	12/12/40	17/12	17/12			
10/1/41 B. S. ...			10/1			
H. O. ...						
E. E. ...						
L. S. ...						
B. S. ...						
H. O. ...						
E. E. ...						
L. S. ...						