



KARACHI MUNICIPALITY.

Extract from the Proceedings of the Managing Committee Meeting of the
Karachi Municipality, held on the 20th March 1926

SUBJECT—

499 ~~of~~ The following subject is submitted for information: be recorded.

Permission granted to Mr. Tayabali Allibhoy Jiwanji to erect a house
on Plot No. 88/A, 88/B and 107, B-21, Serai Quarter.

RESOLUTION No.



No. 499
67 of 192

Municipal Office,

Karachi, 23rd March 1926

MEMO:—

True extract forwarded to the Executive Engineer

for disposal with F.C.

Handwritten signature
26/3

Handwritten signature
For Chief Officer,
Karachi Municipality.



Form No. 9-500-18-5-25.

ORDER UNDER SECTION 96 (2) OF ACT, III OF 1901.

No. L. M. A.

OF 1926

MUNICIPAL ENGINEER'S OFFICE,

Karachi, 1/3/1926.

MEMO.

With reference to ~~their~~ ^{his} application, dated 20. 11. 1925.Mr. Layaballi Alibhoi Jivraji is informed
Messrs. arethat the plan submitted by ~~them~~ ^{him} for building a houseon plot No. 88A, 88B & 107 Survey Sheet B-21situated in Serai Street,
Road

Quarter, is approved and permission to build in accordance therewith is granted. The building must be erected, in accordance with the By-laws and Rules of the Municipality.

Ex. Engineer,
Karachi Municipality.

25.2.26

26 FEB. 1926

NOTICE 1.—This pass does not give permission to occupy Municipal land with building materials. This can only be allowed when the Street is wide enough to permit building materials being deposited on it without it being a source of danger to the public, and only then on a hoarding being placed round the land to be occupied and on payment, in advance, of fees for occupation of Municipal land, at the following rates:—

	Rs.	a.	p.
(1) For the first three months, per square yard per diem	...	0	0 ½
(2) For the next three months	...	0	0 1
(3) For any subsequent time	...	0	0 2

NOTICE 2.—Windows, steps and doors of the building will not be permitted to project on or overhang any public street or Municipal land.

NOTICE 3.—Plinths will not be allowed to project more than 2 inches on any Public street for ornamental purposes.

2060. Copy to B-5

2061. " " "

2062. " " "

2063. " " "

E E
26 FEB. 1926



No: S.R.9/32

of 1926


Revenue Department,
City Deputy Collector's Office.
Karachi, 23 February, 1926.

Memorandum,

With reference to his application dated 16.2.1926. requesting permission to build on plot Nos: 88A.88B and 107 Sheet B 21 Serai Quarter in accordance with plan No: 169 approved by the Engineer Karachi Municipality Mr: Tayebally Allibhay is informed that the permission applied for is granted provided he obtains permission of the Karachi Municipality before commencing the work.

Plan No: 169 returned herewith duly sanctioned.

B.S.
me
24/2

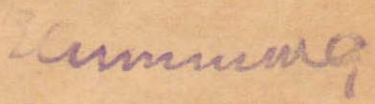
City Deputy Collector, Karachi

1 Mr: Tayebally Allibhai Jivrajji

Mandvi Wall, Marriot Road, Karachi.

- 2 The Engineer Karachi Municipality, with one copy of plan No: 169 for information with reference to his endorsement No: L.M.A. 11802.
- 3 The Income Tax Officer Karachi for information.

GTJ.



Form No. 30-400-12-6-25

L. M. A. 1180/1925

MUNICIPAL OFFICE,

Karachi, 5/12/1925

MEMO:

With reference to ^{his}~~their~~ application with plan received on 24th

Mr. 1925, for building on plot No. 88A, 88B, 810)

Sheet B21 Serani Quarter,

Mr. Hussainbhai Abdulhali

Messrs.

^{is}~~are~~ requested to apply for permission to the City Deputy Collector with three

Copies of plans herewith returned duly signed and approved.

Permission to build will only be granted after the approval of the plans by the City Deputy Collector.

He ~~They~~ must not start any building operations until ^{he}~~they~~ hears further from this office.

Encl
28/11

Executive Engineer,
Karachi Municipality.

35/11

30 NOV 1925

L. M. A. 11802 of 1925

MUNICIPAL OFFICE,

Karachi, 5/12/1925

MEMO:

Copy to City Deputy Collector for information and with a request that *one* copy of plan after approval may be sent to owner direct and the other to this office.

Executive Engineer,
Karachi Municipality.

35/11

NAZERETH & KHIMJI
ENGINEERS

817°


No.

of 192

Bunder Road,

ARCHITECTS & SURVEYORS.

Karachi, 20th Nov 1925

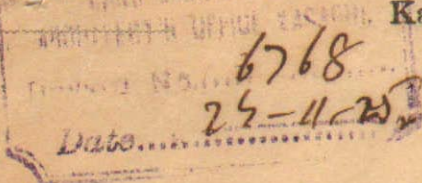

To

The Executive Engineer
Karachi Municipality

Sir,

As requested, I submit
herewith an additional blue print
copy of plan for building on
plots nos 88 A, 88 B and 107.
Sheet B.21. Jirai Quarters.

Yours faithfully
M. Nazareth

Lm.
a/
Mn

B.S. Green-Plan
24/11

The plans correct
C.E.P.

200-12-1-25.

KARACHI MUNICIPALITY.

N. J. MODI.

B. Sc. (Engineering London.)

A. M. INST., C. E., L. C. E.

A. M. I. S. E., M. R. San, I.

Land Manager & Architect.

REFERENCE No. L. M. A. 11329

LAND MANAGER & ARCHITECT'S OFFICE,


KARACHI.

Karachi, 16. 11. 1925

MEMO,

Re: Plot No. 88 A + 88 B Sheet B-21 Quarter Sec 11

With reference to his application dated 11-11-25
 for the proposed building on the above plot Mr. M. Nazaretti
 is informed that unless one more copy of the plan on blue print
 is submitted, the plans cannot be disposed off.

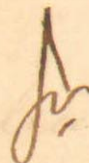


15 NOV. 1925

B. Sc., A. M. I. C. E.,

Land Manager & Architect.

24/

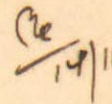

1534

LAND MANAGER & ARCHITECT'S OFFICE,

KARACHI MUNICIPALITY.

Dated.....14. 2.....1925

To

.....*Mr. Margaretta*.....
.....*Architect*.....

Sir,

Re. Plot No. ~~88~~ ^{88, 88, 8107} Sheet No. *B-21* *Serici* Quarter.

With reference to the plans for proposed.....*building*.....
.....submitted for the
above plot, I have the honour to request you to see the undersigned at
the Municipal Office any week day from 1-30 to 4-30 p. m. when the require-
ments of this Office will be pointed out to you.

P. See my remarks
of 9/2/25

5
11/11/25

see the
architect's plan.
pass the plan
for

ask for one more copy.

Illud
12/11/25

I have the honour to be,

Sir,

Your most obedient servant,

13/12/25

B. Sc., A. M. INST C. E.,
Land Manager & Architect,
Karachi Municipality.

B-1

4th Feb. 1925

To

The Land Manager & Architect
Karachi Municipality

Sir,

With reference to your No. L.M.A 760 of 22nd Jan. 1925 regarding building on plot No. 88^A, 88/B. 107 Sheet B.21 Surai Qe, I have the honour to return the plan duly amended in the light of your remarks.

1. outer wall of passage is now made pacca.
2. R.S.B. 10"x5" is provided below partition wall 14' long
3. R.S.B. 9"x4" is provided below partition walls of out houses with a stone pillar 18"x18" in the middle.
4. Clerestory windows above 7' height are provided for ventilating the middle rooms.
5. width of road is now given.
6. width of foundation is now increased to 3'6"
7. a note is made in the plan stating that the Kitchen wall is 7'0 high with the upper portion grated.

8. arrangements of joists have been shown on plans of ground and upper floors.

9. Since the outer wall is made pacca, the necessity of providing posts disappears.

R.C.

Call Architect

Ap 6/2

5/2/25

L.M.

Plans may now be appd

Ap 6/2

My Age

Sent for the Architect &

ask him to initial

the correction in the

width of the clerestory

space & remove

9/2/25

P.T.O.


The plan may now kindly be approved.

I have the honour to be,

Sir,

Your most obedient servant

M. Nazarete

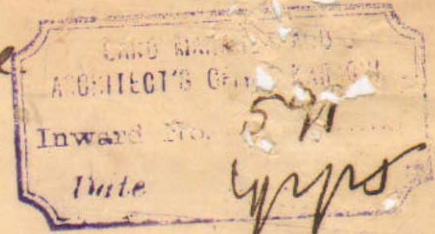

Building Surveyor for
disposal with plans.


Sum 4/2

L. M. 4/2



PLAN SHOWING PROPOSED
BUILDING ON
PLOTS Nos 88A 88B & 107 SHEET B.21
SERAI QR
SCALE 1/4" = 1'


BLOCK PLAN
SCALE 1/4" = 1'

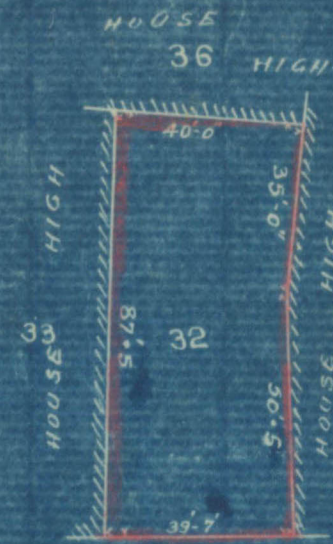

OUTRAM ROAD

M. Nazam
3/1/25


ELEVATION

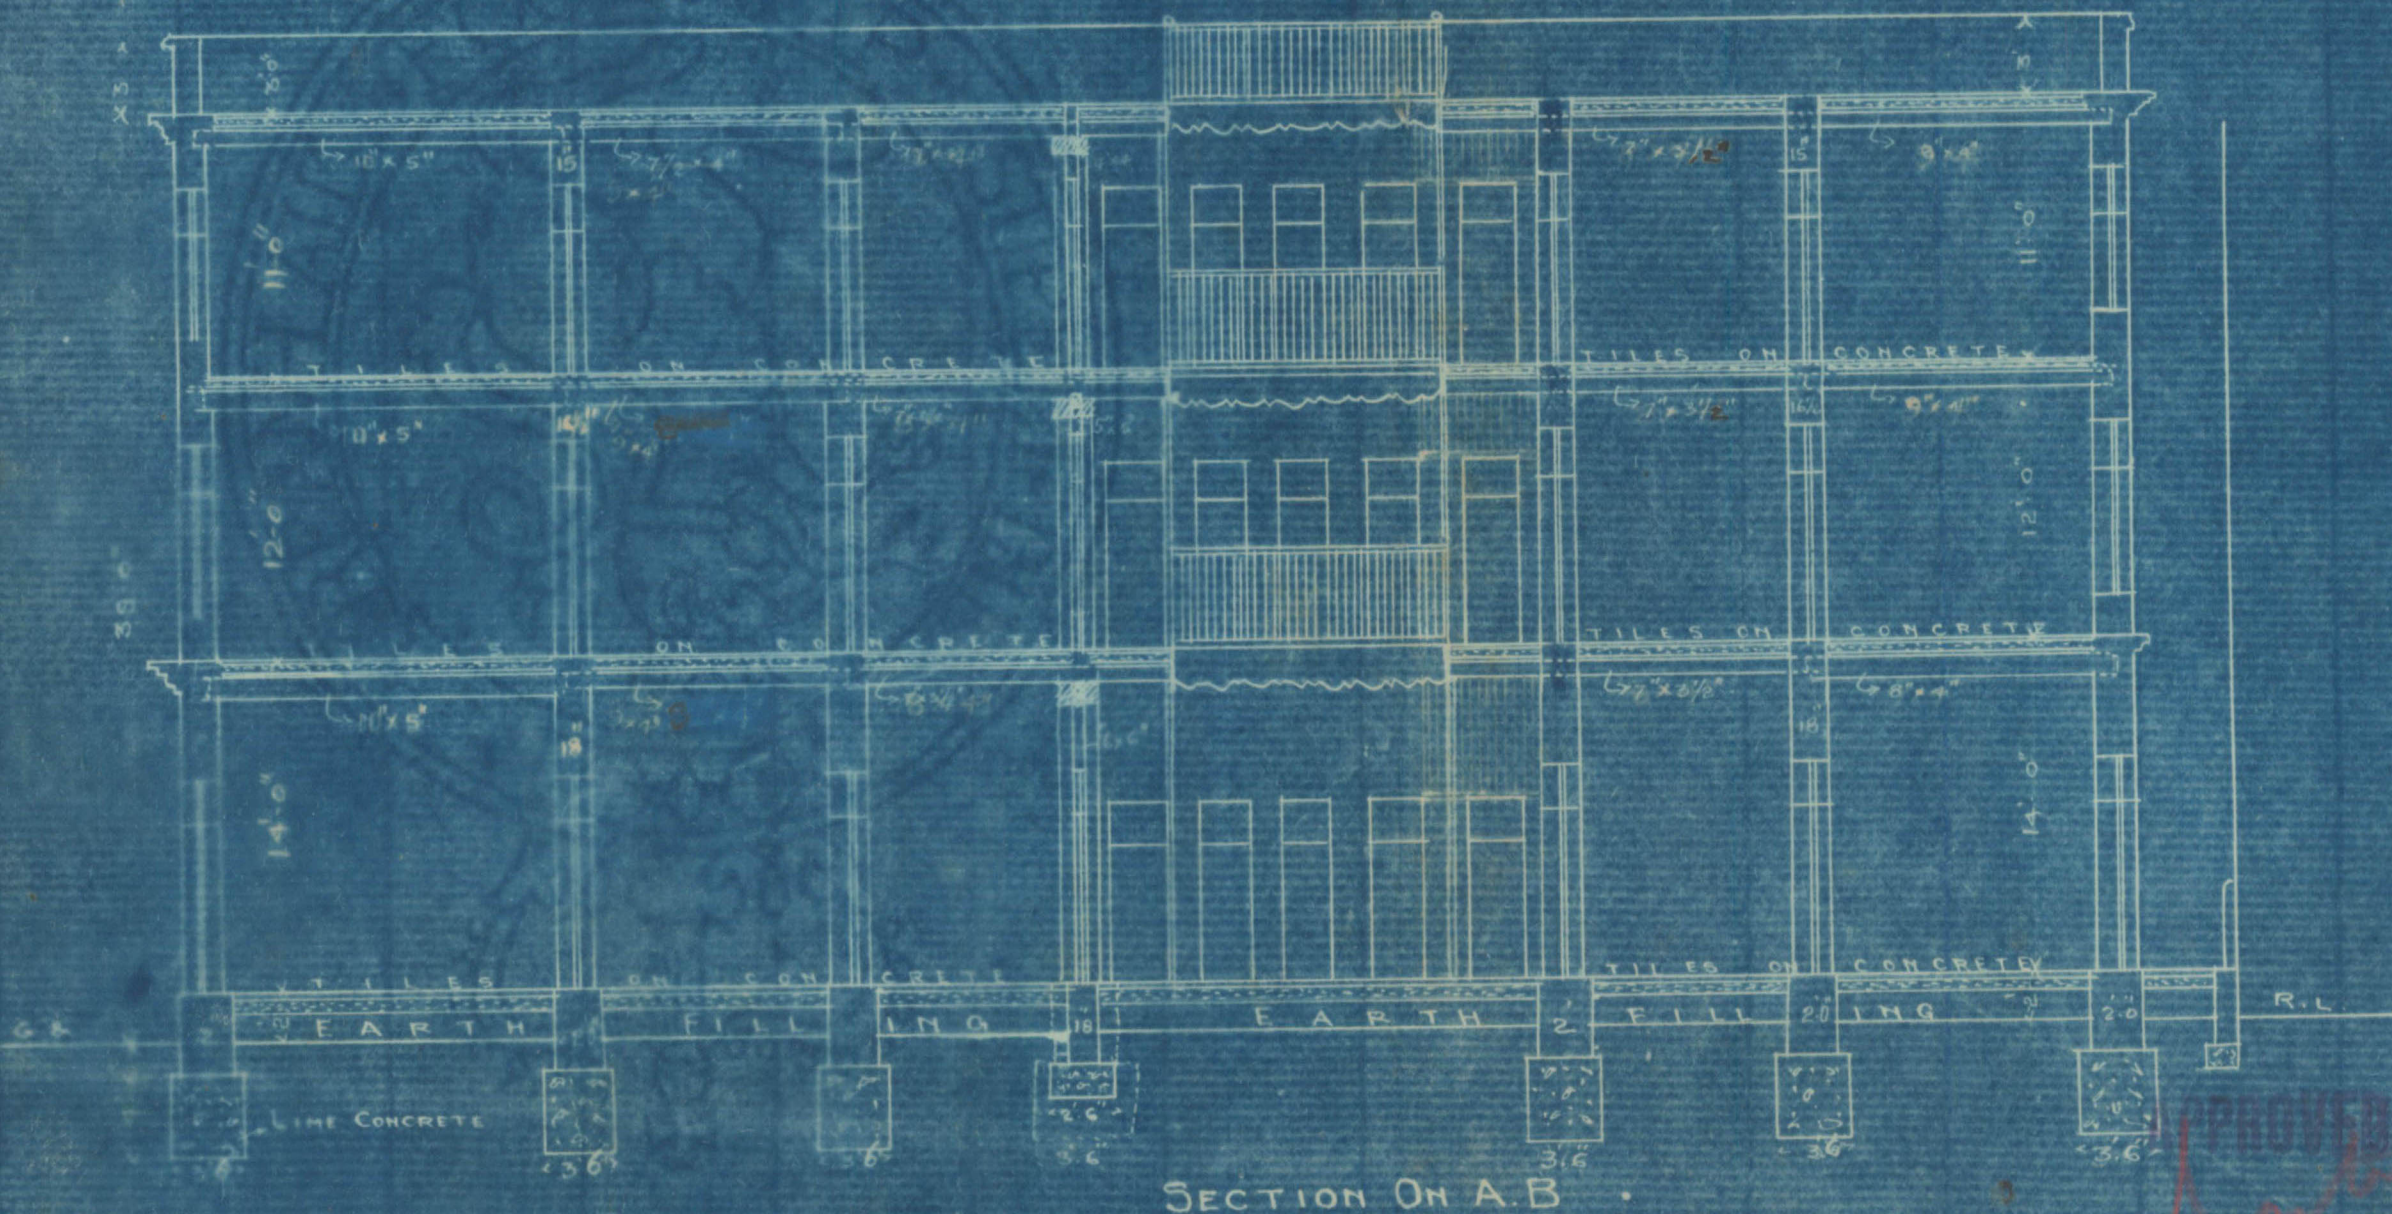


SECTION ON A.B

PROVED

Executive Engineer
Karnal District

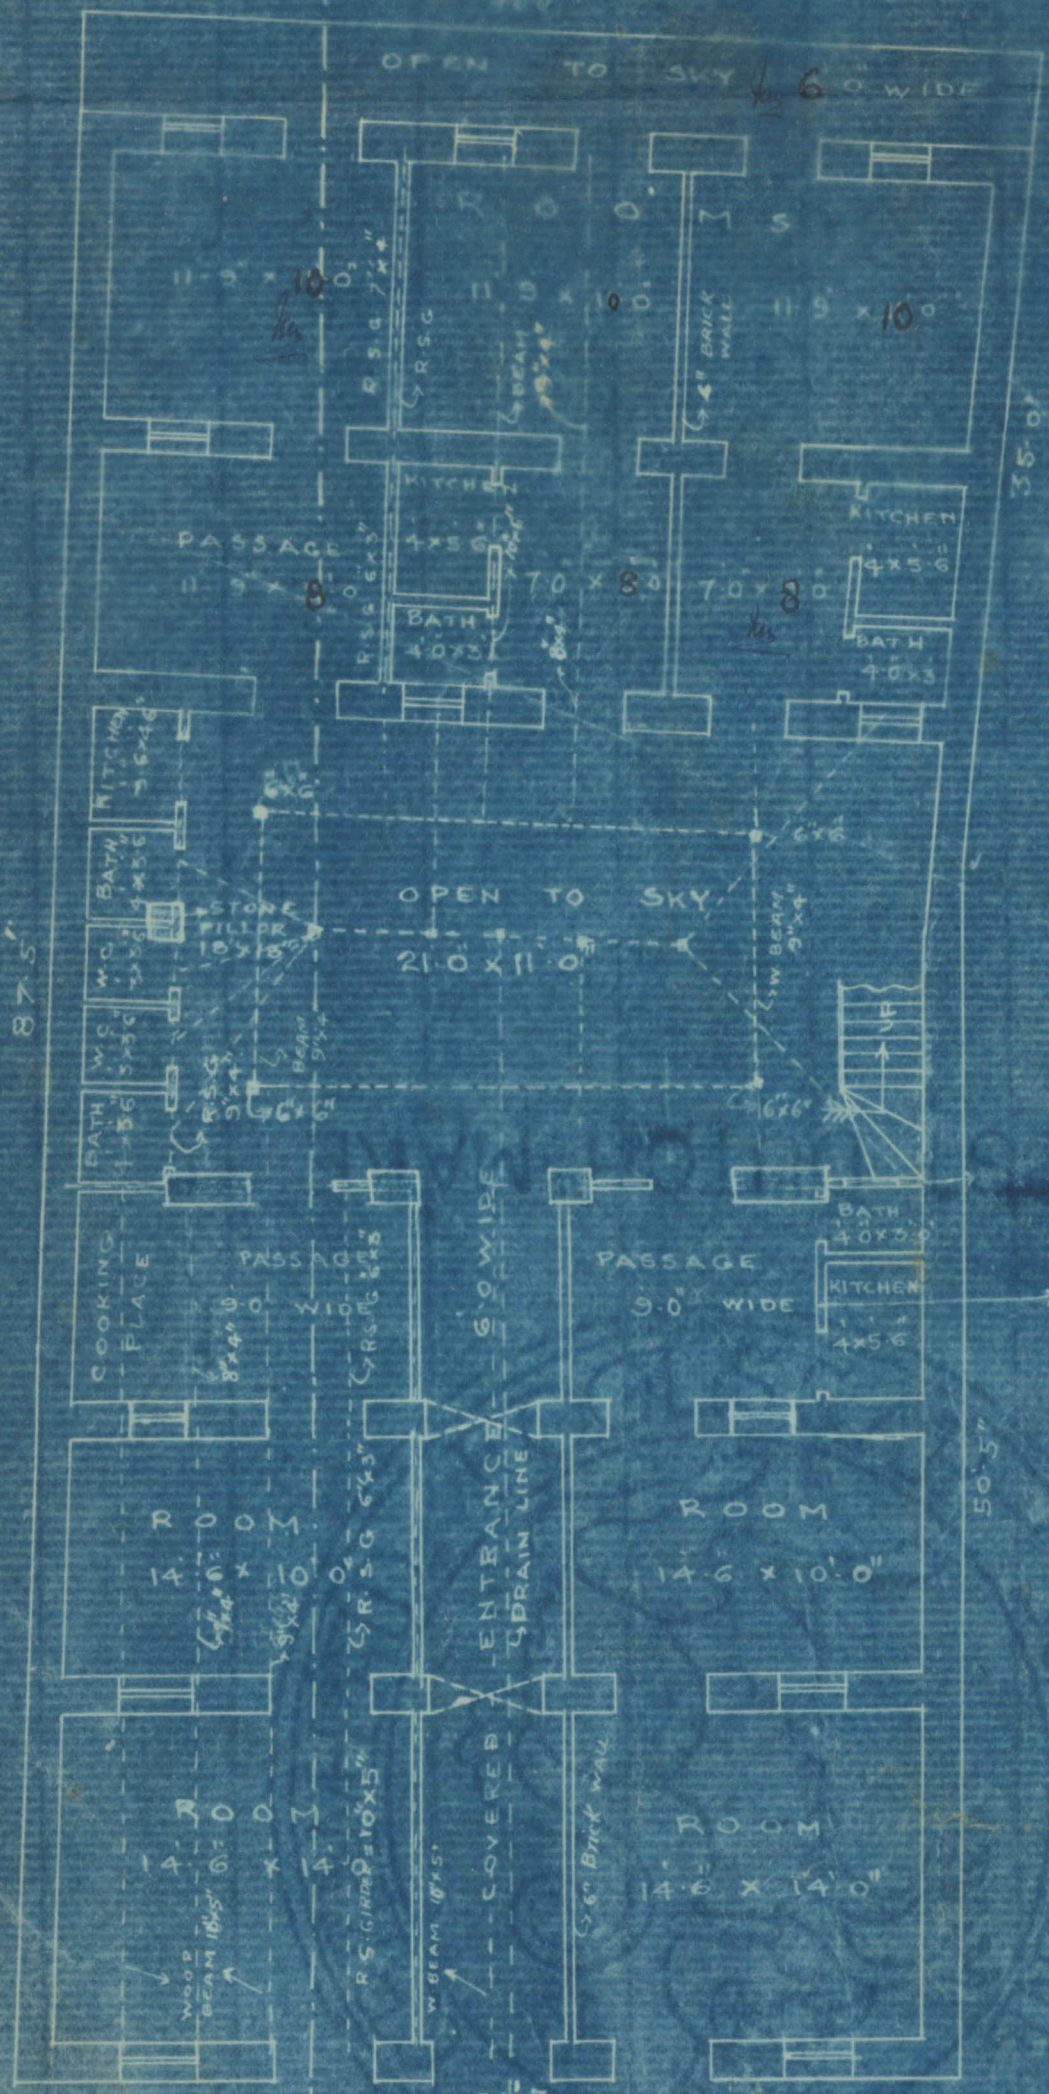

PLAN OF GROUND FLOOR

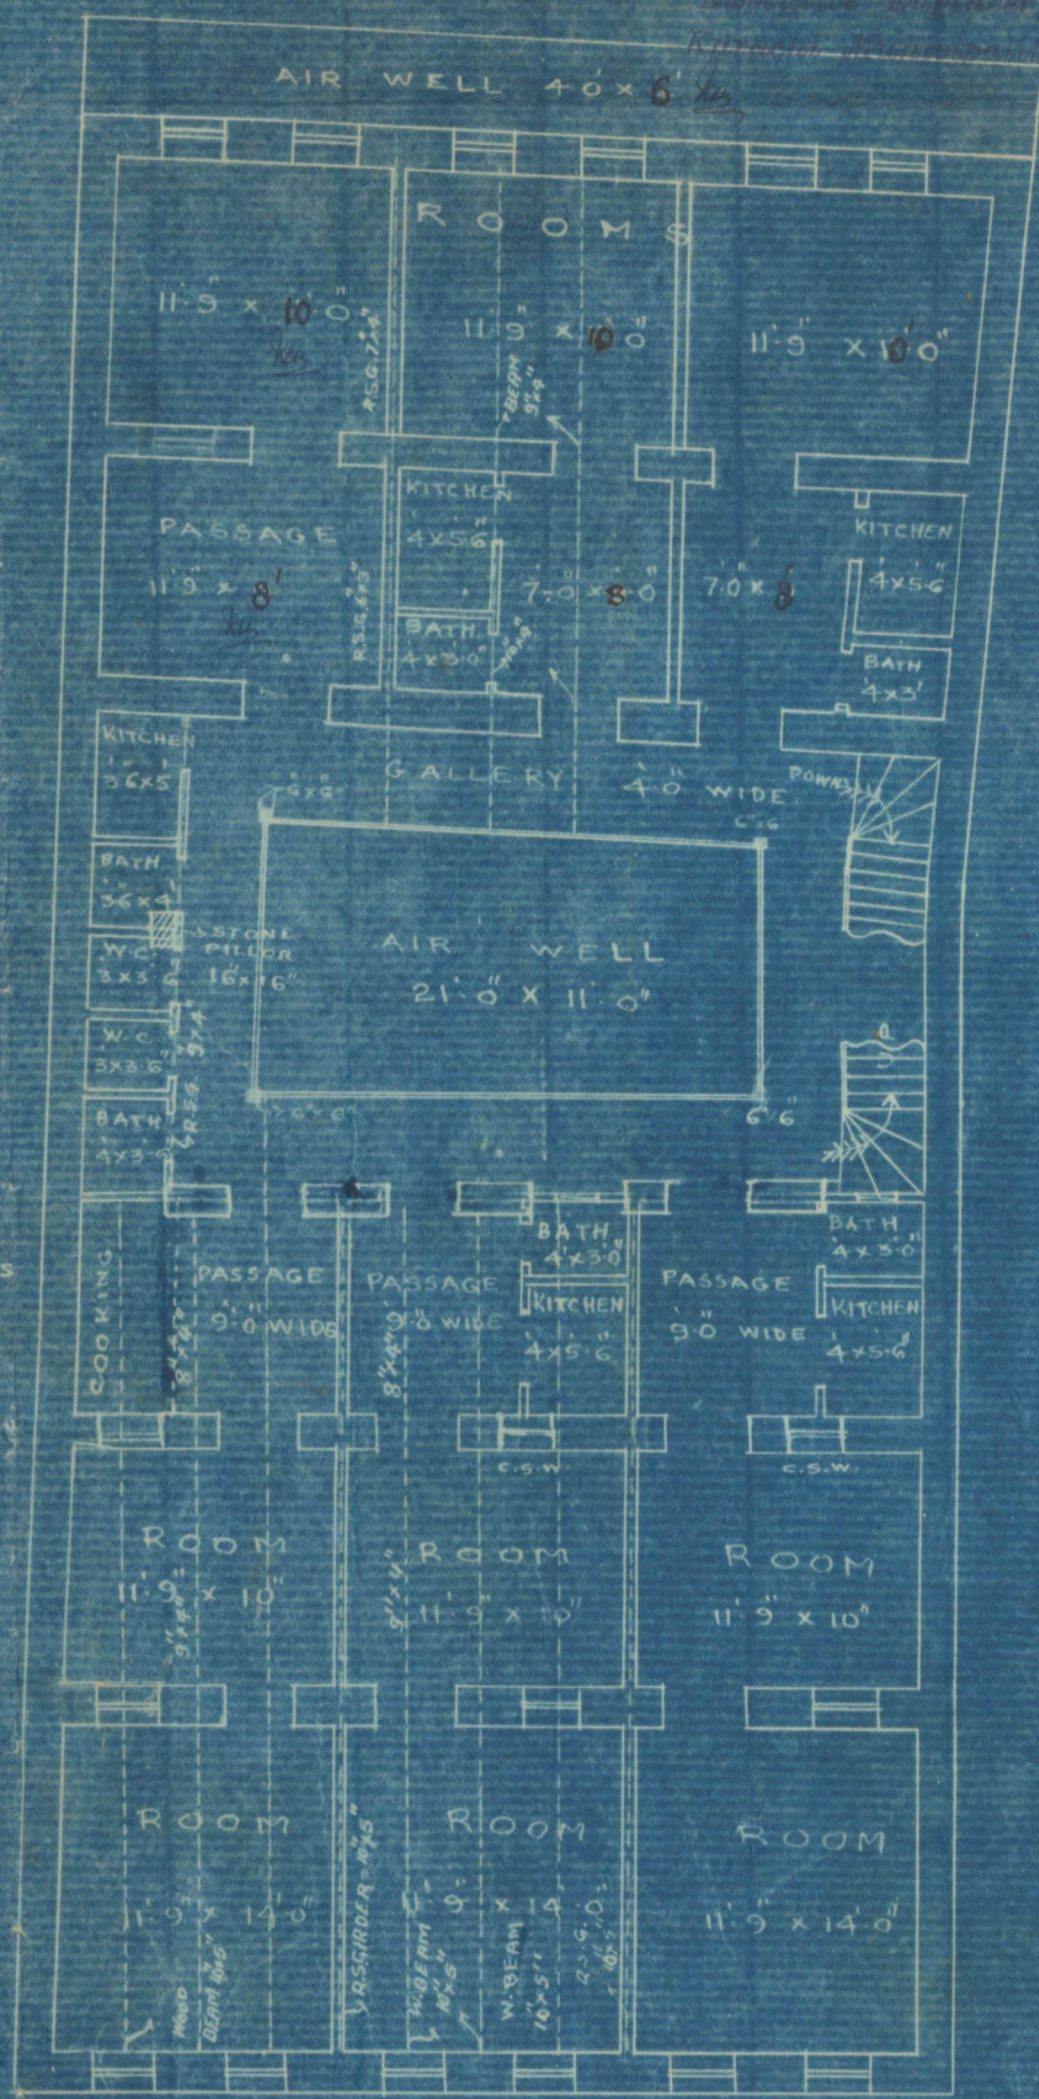

PLAN OF 1ST & 2ND FLOORS

KARACHI MUNICIPALITY.

500—17-9-24.

N. J. MODI,

B. Sc. (Engineering London).

A. M. INST. C. E., L. C. E.

M. R. San. I., A. M. I. S. E.

Land Manager & Architect.

REFERENCE No. L. M. A. 76th

LAND MANAGER & ARCHITECT'S OFFICE,

Karachi, 21/11 1925.

MEMO:—

With reference to ^{his}~~their~~ application dated 5th instant with a plan for the proposal ^{Building}~~additional~~ on plot No. 88, 88, 107 Survey Sheet No. B-21 Serai Quarter Mr. Mussainbhay Alideelali is informed that until the following requirements are complied with the plans cannot be passed.

- (1) Outer wall of passage should be built pucca.
- (2) 12x7 beam should be provided below p. wall (14' plan)
- (3) 16x9 beam must be provided below p. wall of bath + w.c.
- (4) Middle room will be dark, windows should be provided with ventilators.
- (5) Width of road should be given.
- (6) Width of foundation should be increased to 3' 6"
- (7) Kitchen walls should be 7' high & the ^{above} portion to be ^{grated}
- (8) Arrangement of joints should be shown on plan
- (9) Posts must be provided as shown on one of the blue print.

The plans are returned herewith for amendment.

B. Sc., A. M. I. C. E.,

Land Manager and Architect.

gpr



Form No. 1-1-10-1924.

Karachi, 5th January 1925

NOTICE UNDER SECTION 96 OF ACT III OF 1901.

THE CHIEF OFFICER,

KARACHI MUNICIPALITY.

SIR,

I beg to inform you that I intend building a house
on plot Nos 88A 88B and 107
Survey Sheet No. B-21 Situate in okhtam
Street, Serai, Quarter.

As required by the Rules of the Municipality I beg to submit herewith a plan of the same for your approval.

I beg to remain,
Sir,

Address:—

Your most obedient Servant,

Tajehab Ali Khan Jemari
Tajehab Ali Khan Jemari
Haosam Ali Jemari
Signature of the Applicant

No. G. 84 of 192.

MUNICIPAL CHIEF OFFICER OFFICE,

Karachi, 5. 1. 1925.

Forwarded to the Health Officer for favour of passing on to the Land Manager and Architect after putting his remarks,

Infor Bhatt
Show to HO
82
5/1

83 Hajwan
for Chief Officer
Karachi Municipality.

Re
14/1