

SERAI Q^E

FINAL N^o $\frac{9}{32}$ (OLD N^o $\frac{B-21}{882,888,2107}$)


Scale 40=1



Name of Applicant
Date of Application
Copy Prepared on
" Delivered on
" Prepared by *M. M. M.*
" Compared by
Cost of paper
Copying Fees.




Prepared by
M. M. M.

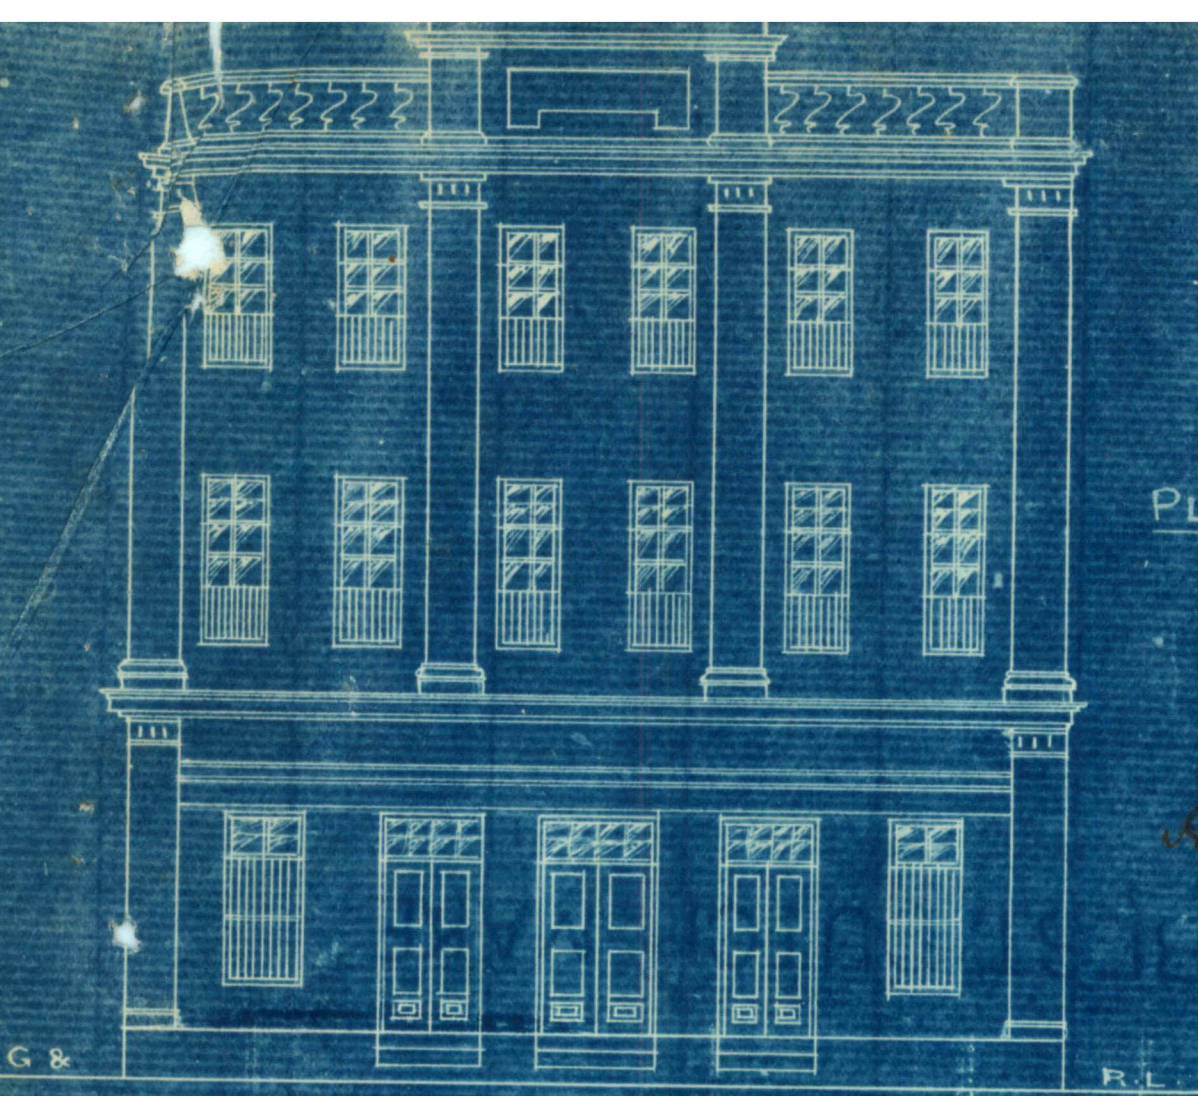


PLAN SHOWING PROPOSED
BUILDING ON
PLOTS Nos 88A, 88B & 107 SHEET B-1
SERAI QR
SCALE 8"=1'

BLOCK PLAN
SCALE 40'=1"

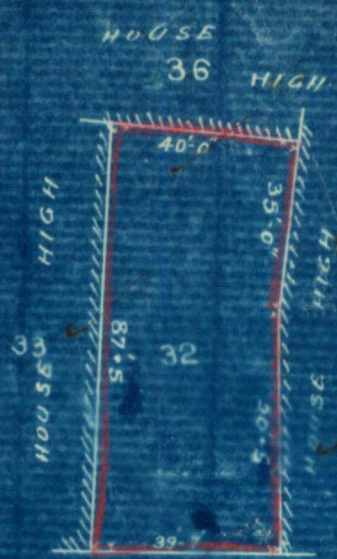

OUTRAM ROAD
WIDE


M. Nazam
3/1/25

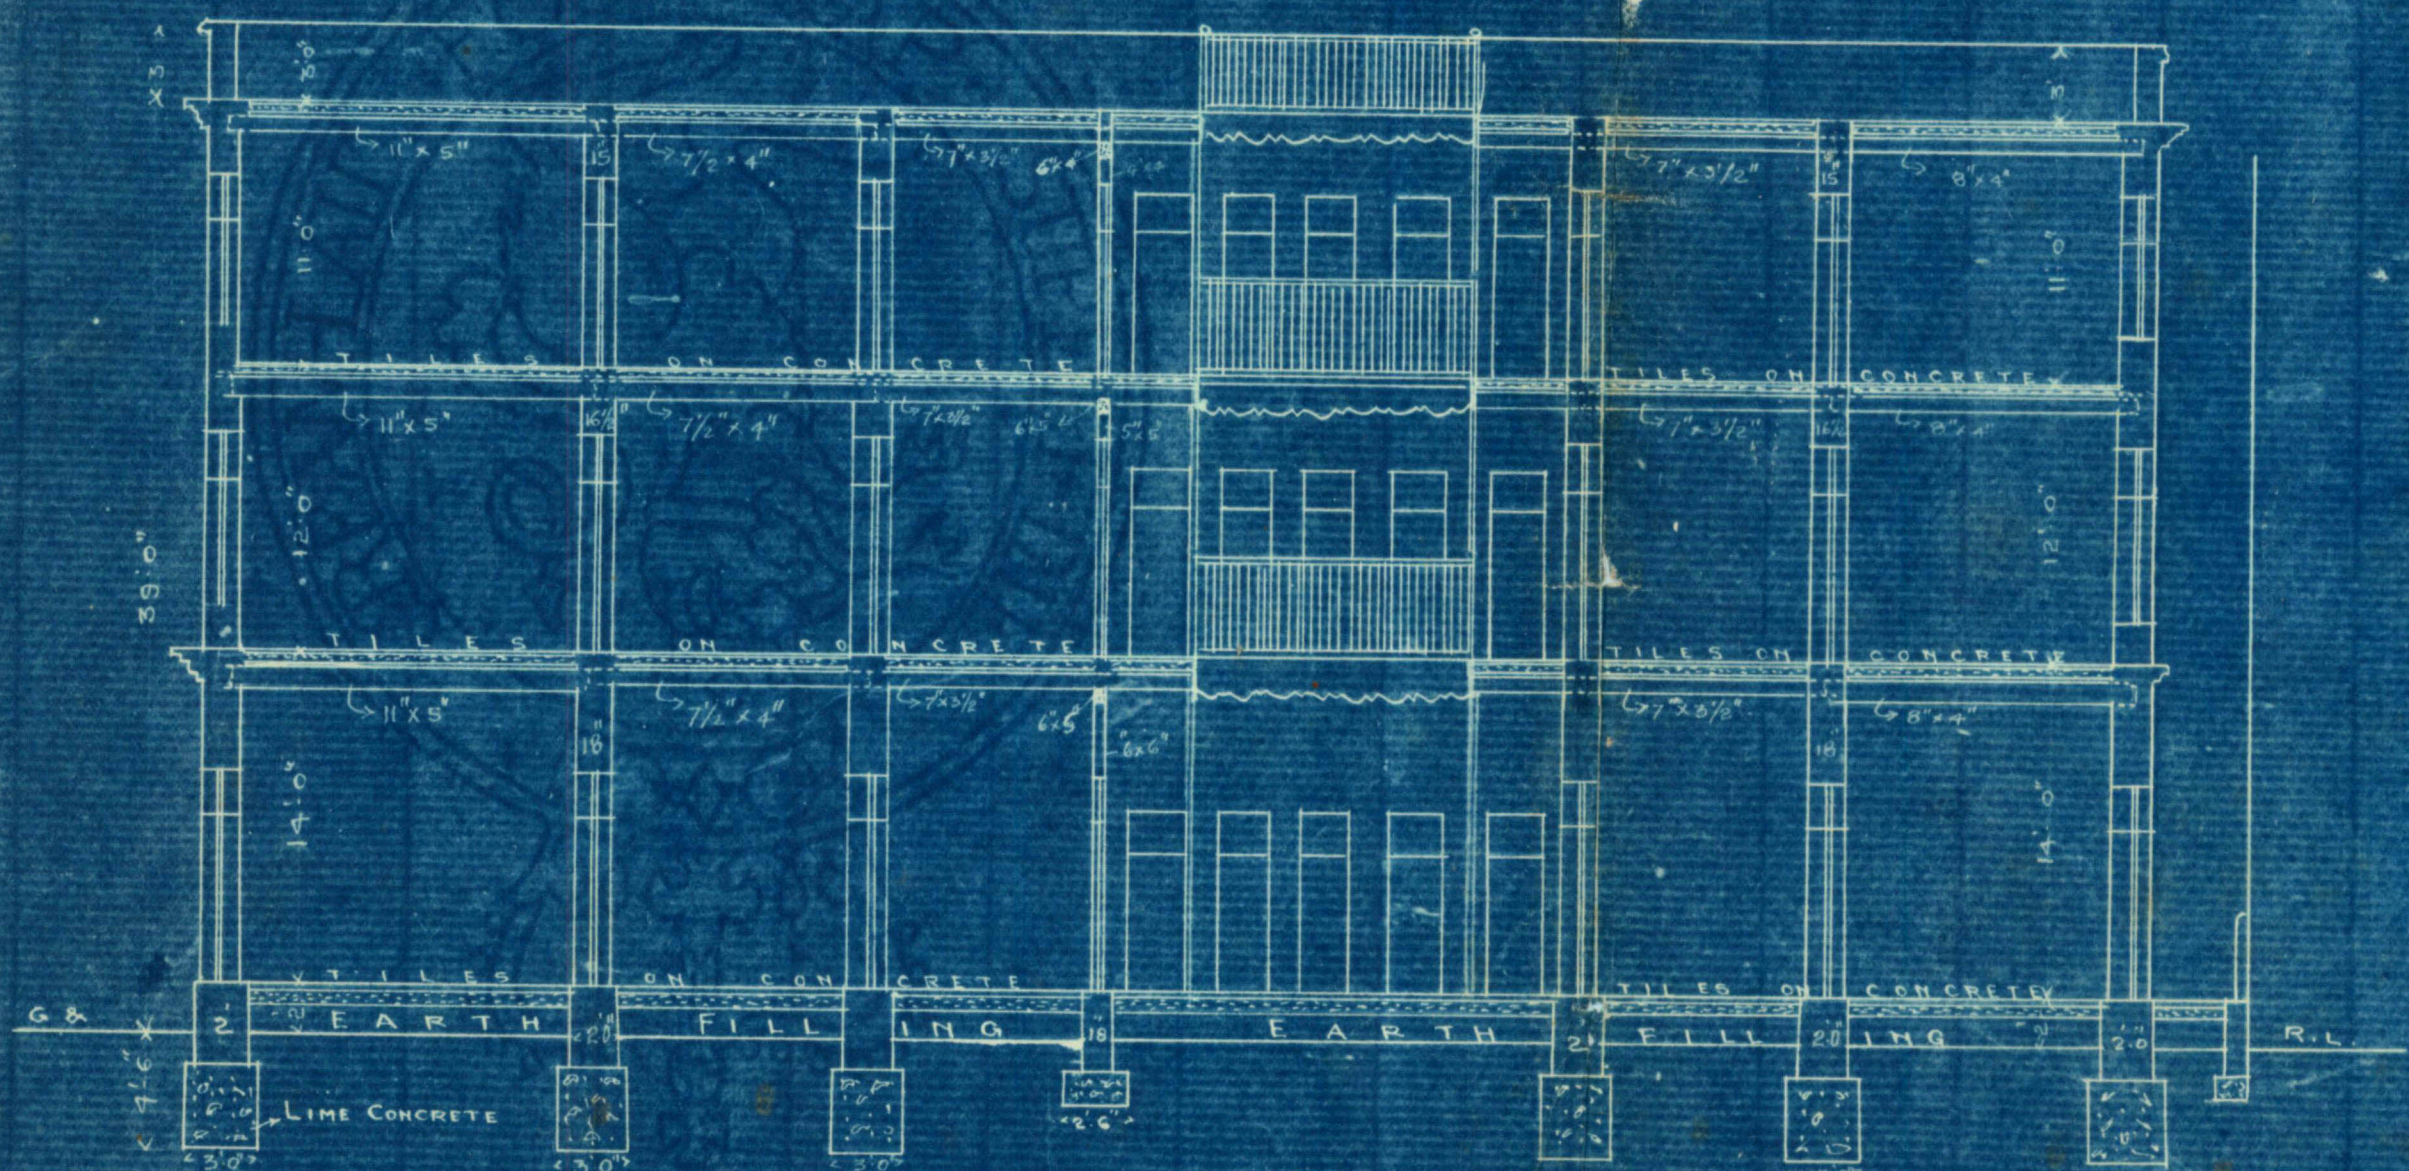

SECTION ON A.B.



PLAN OF GROUND FLOOR

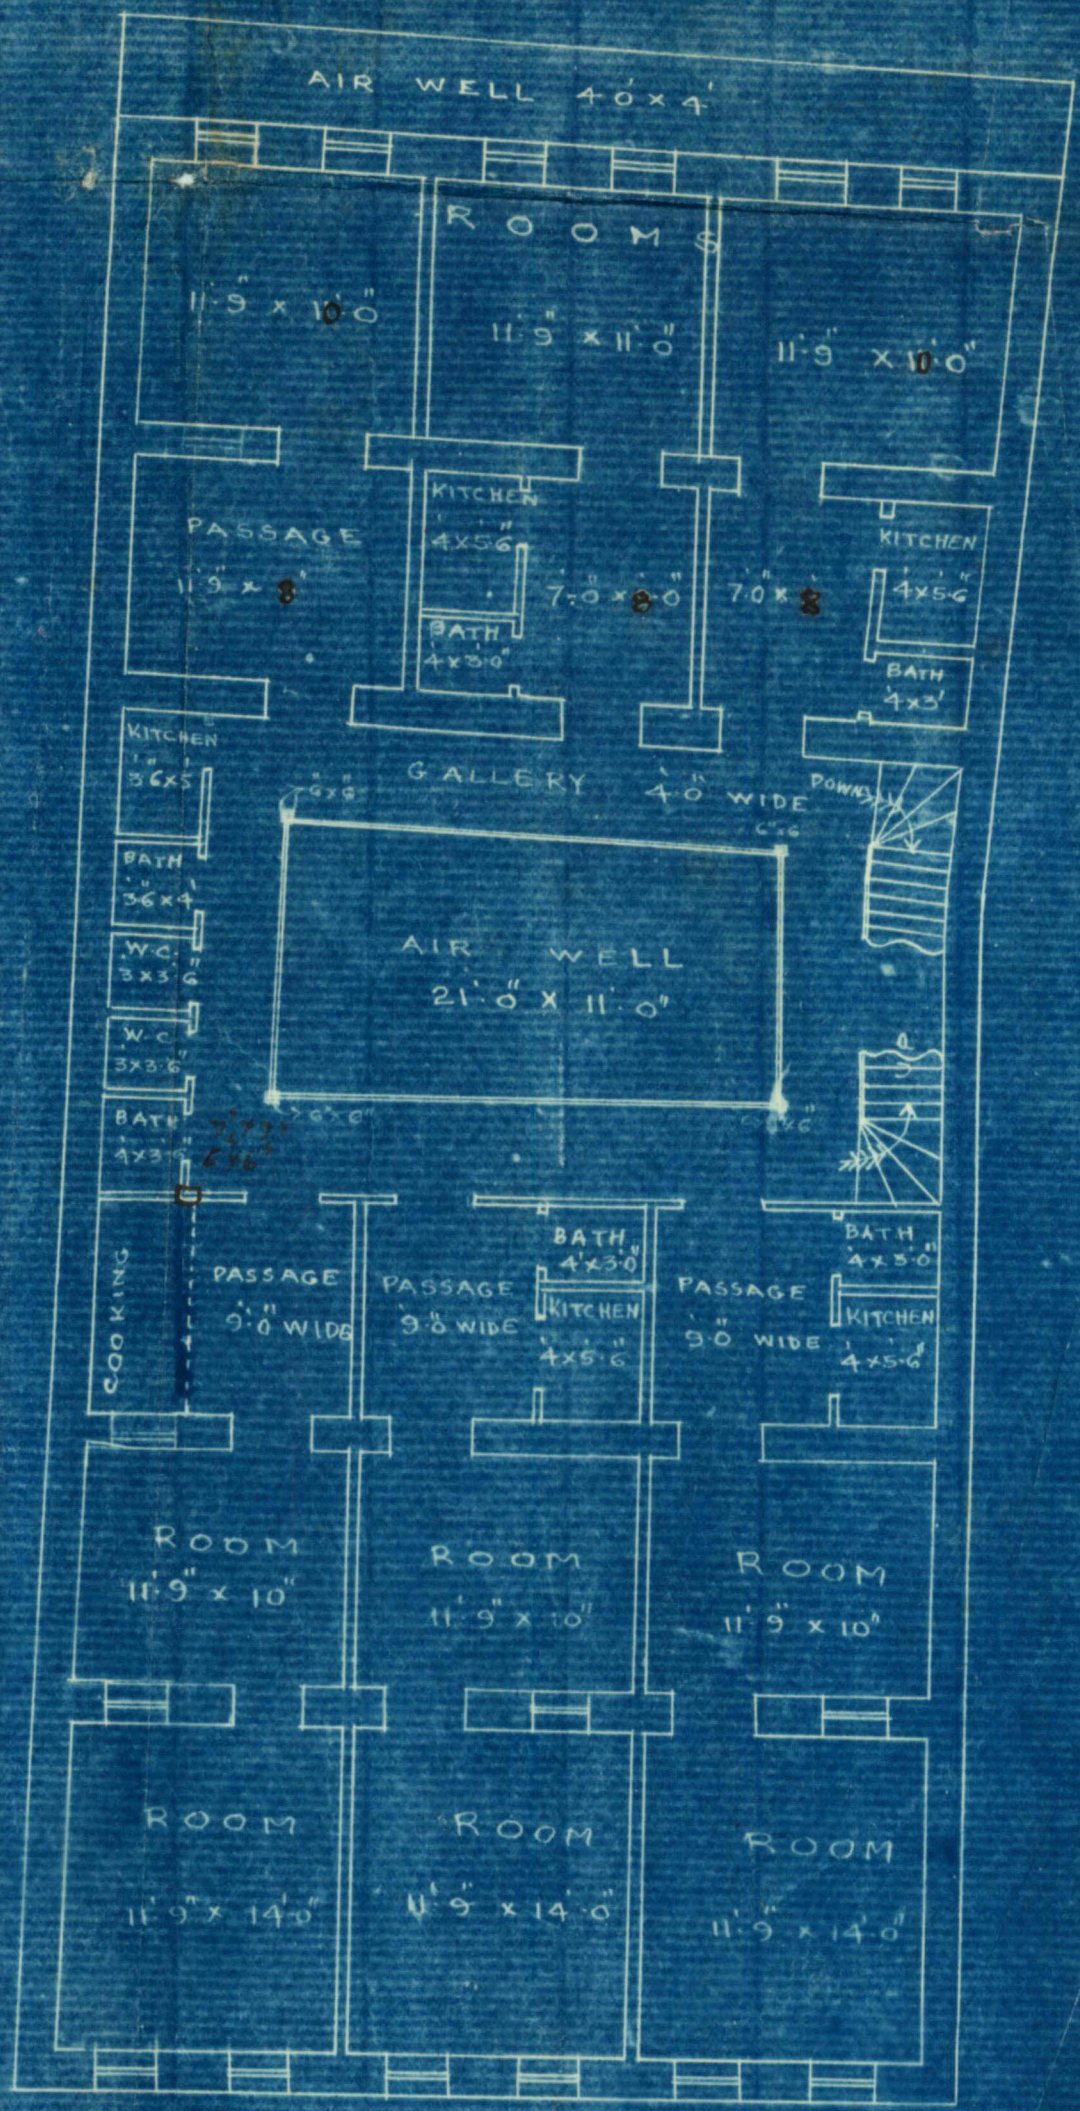


PLAN OF 1ST & 2ND FLOORS




PLAN SHOWING PROPOSED
BUILDING ON
PLOTS Nos 88A, 88B & 107 SHEET B-1
SERAI QR
SCALE B-1

BLOCK PLAN
SCALE B-1

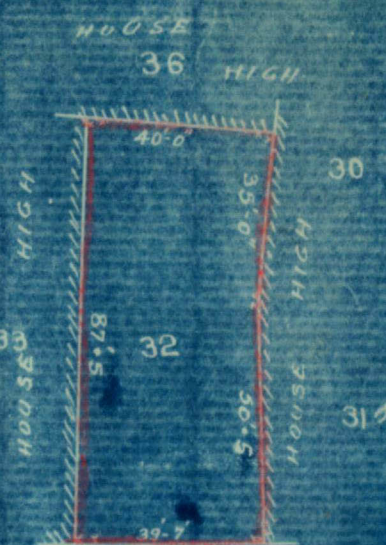


OUTRAM ROAD


N. Nazareth
3/1/25

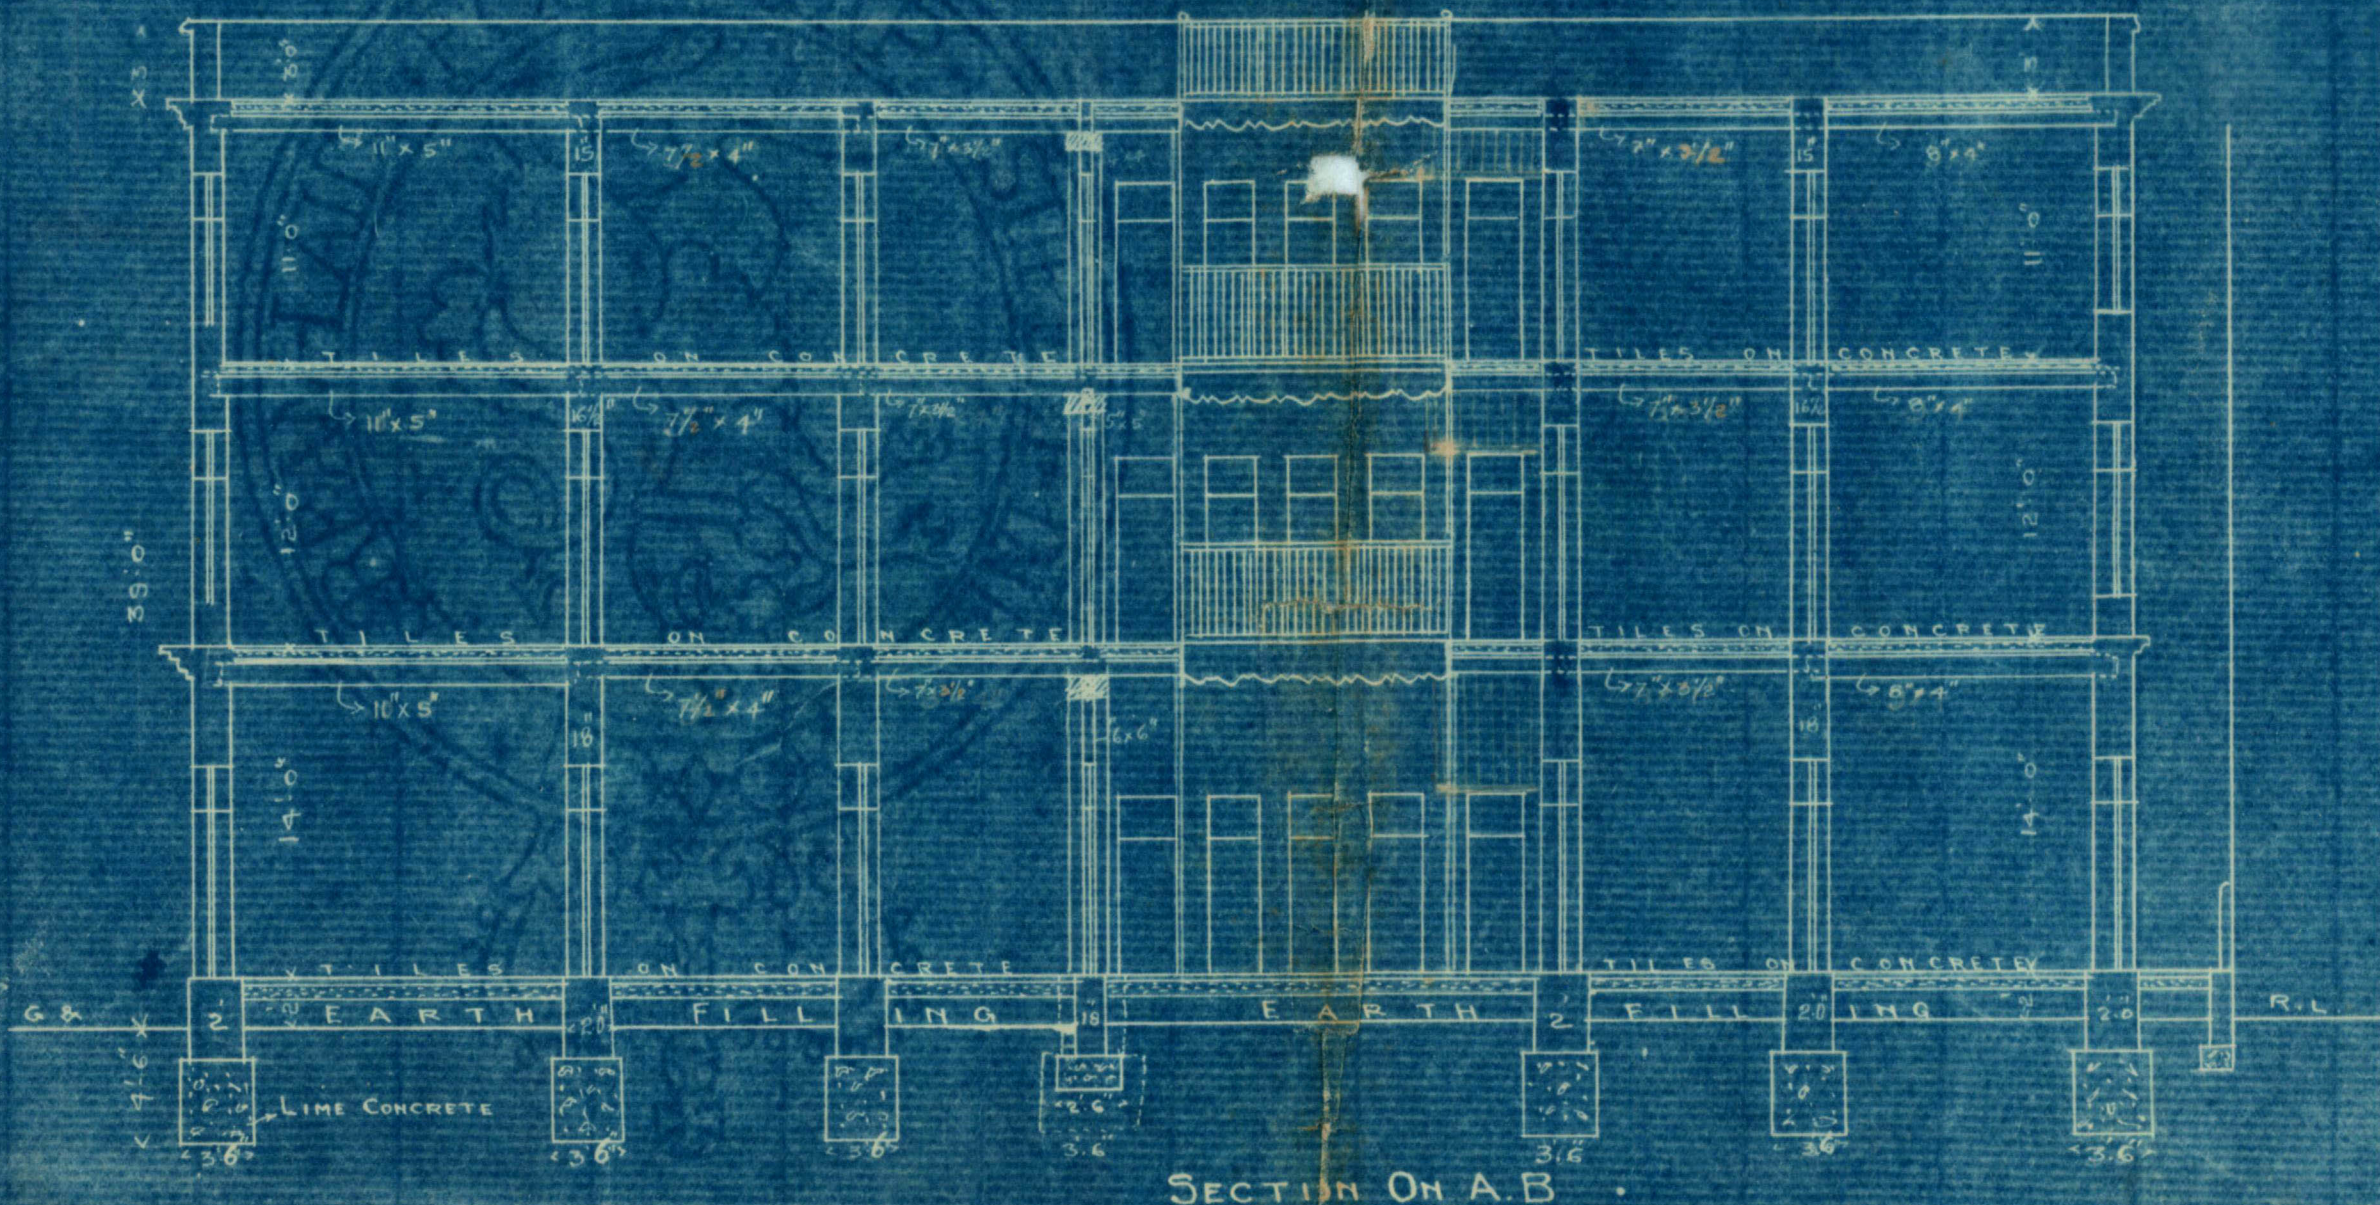

SECTION ON A.B

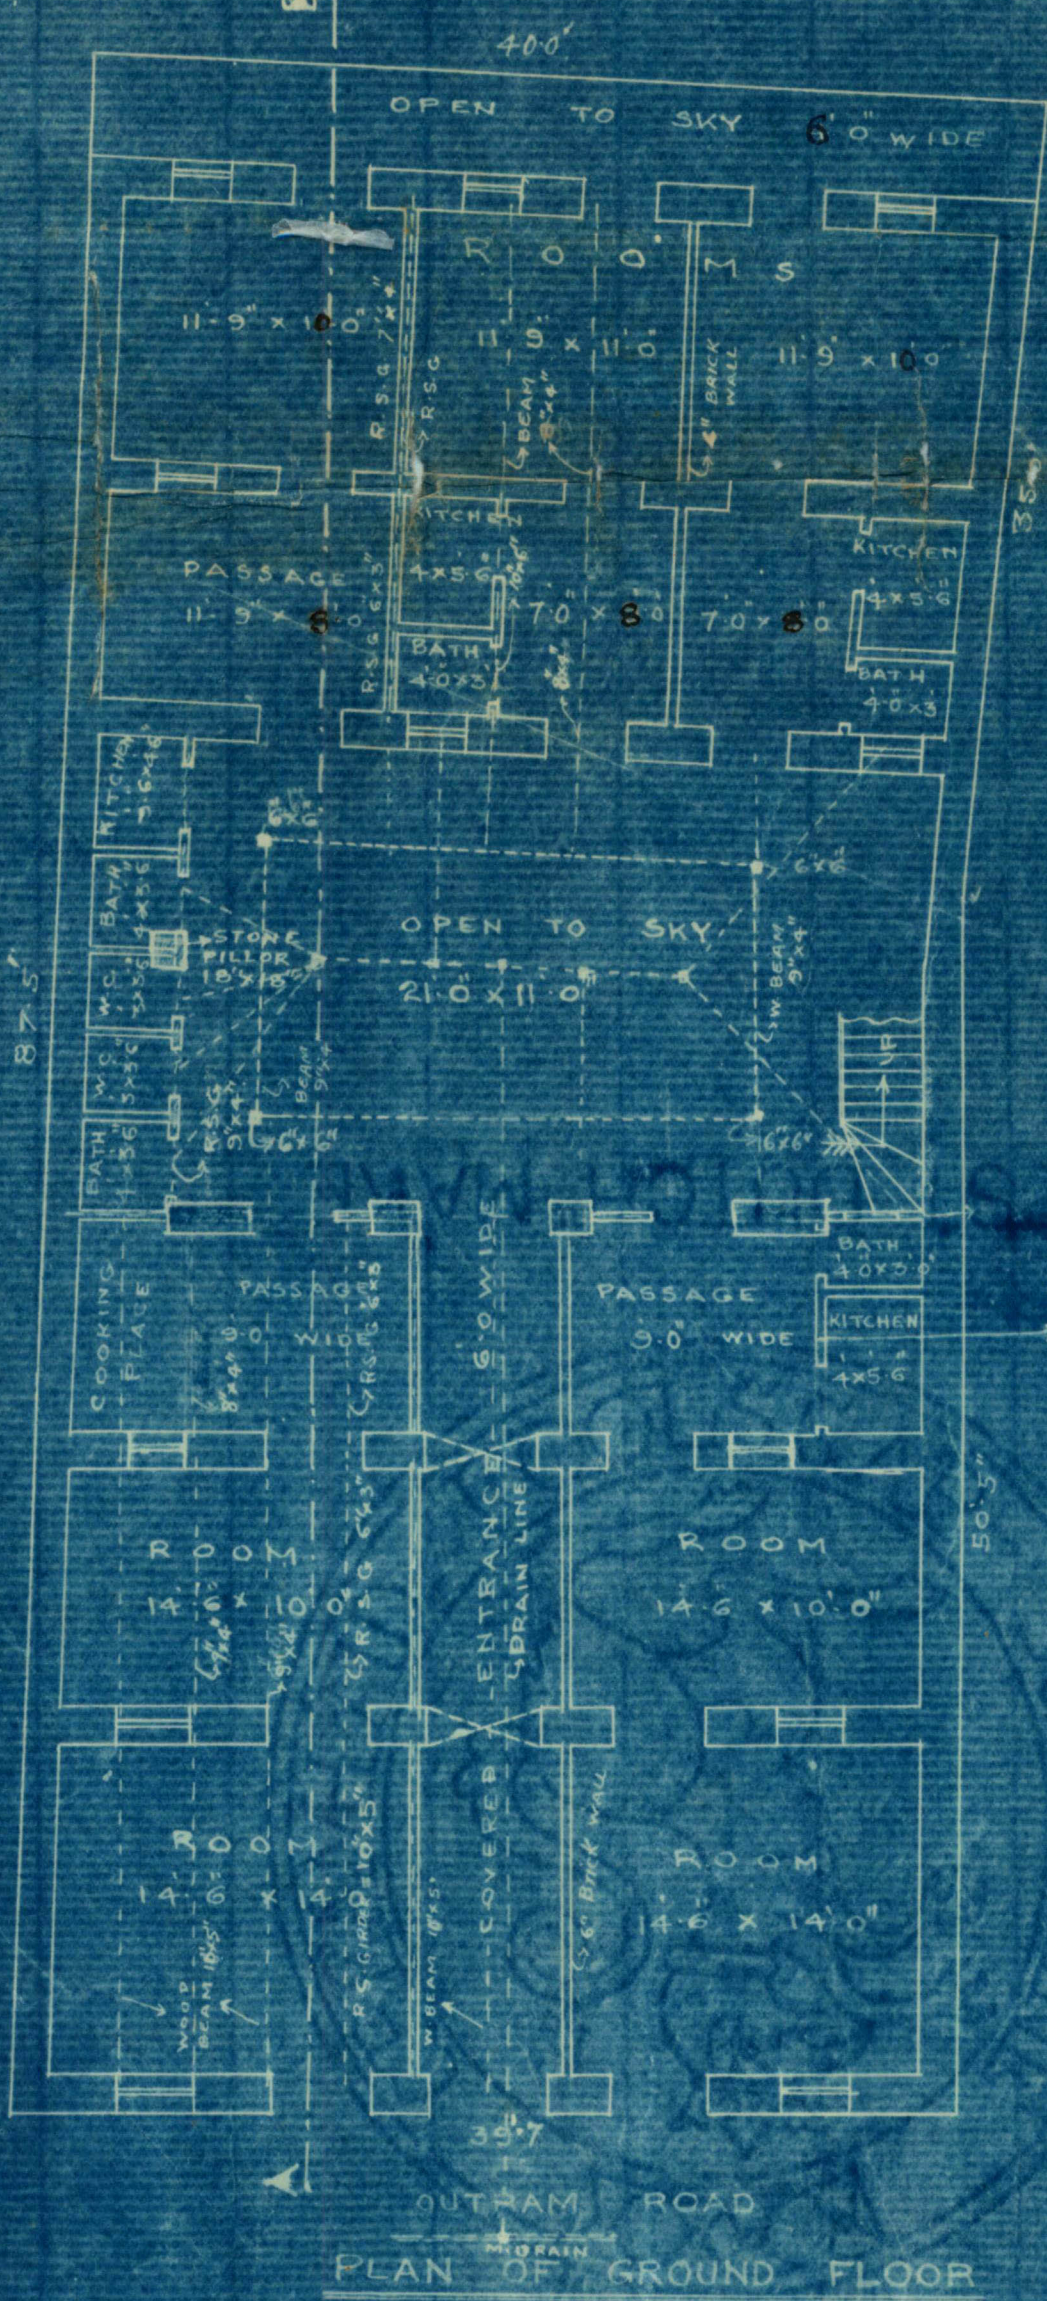

PLAN OF GROUND FLOOR

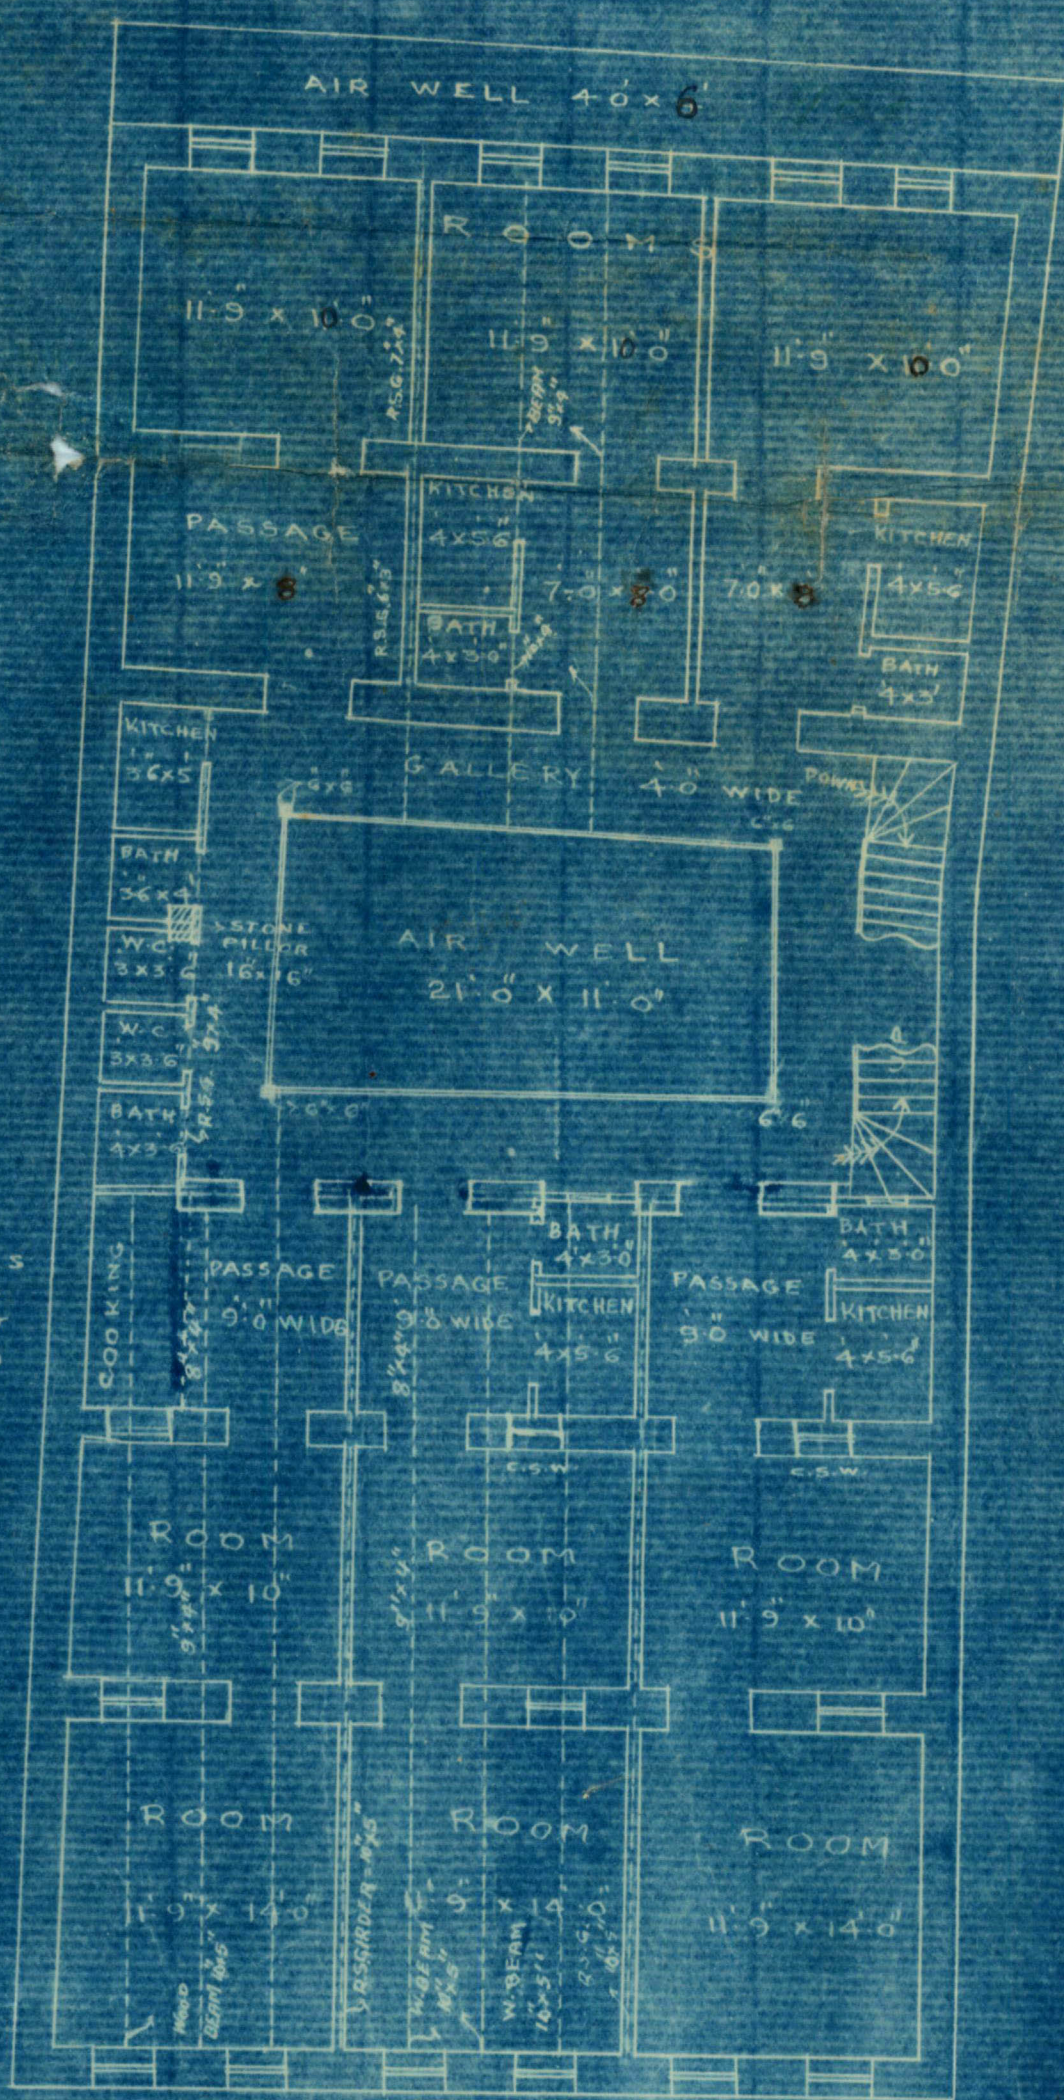

PLAN OF 1ST & 2ND FLOORS

NOTE: KITCHEN WALLS
TO BE 7' HIGH &
PORTION BOVE IT
TO BE RATED



15-1

Form No. 1 A-500-6-4-24.

No. G. _____ of 192 .

MUNICIPAL CHIEF OFFICER'S OFFICE,

Karachi, _____ 192

MEMO :

The above application is forwarded to the Municipal Health Officer
for favour of report.

Chief Officer.

MUNICIPAL HEALTH OFFICER'S REPORT.

Returned to the Land Manager and Architect, K arachi Municipality
with the following Remarks:—

Date of receipt _____

No objection

Date of disposal _____

Date 7-1- 1925.

[Signature]
Health Officer



15-2

3

LAND SURVEYOR'S REPORT.

Does the plot come under Alignment no

Area of plot _____

Area under Alignment nilRemarks no objection to the site plan.

Date _____ 192

[Signature]
14/11
Land Surveyor.

Remarks of.

LAND MANAGER AND ARCHITECT.

Br's doors + kitchen walls should be
7' & the front is about 5 1/2' to be fixed, windows
must be provided to the middle doors & ventilating
for rear rooms to allow cross ventilation
arrangement of pots should show a plan, pots
must be provided as shown on one of the blue prints

[Signature]

17/11/25

Date of disposal _____

Submitted to Ex. Engineer :

Land Manager and Architect.

15-3



No. L. M. 192

Date of receipt:

LAND MANAGER AND ARCHITECT'S OFFICE,

Karachi, 192

Forwarded to the Building Surveyor and Land Surveyor for report.

Land Manager and Architect.

BUILDING SURVEYOR'S REPORT.

Applicant's Name M Hussain Ali Abdul LatifWhether he is the owner of the plot on which it is proposed to build Plot under whose control Household GovtWhether it is permanent or temporary PermanentThe work proposed buildingBuilding Surveyor's Report passage is

1. Outer wall should be built pucca
2. 12' x 7' beam should be provided below p. wall, 14 feet long.
3. ^{16' x 9'} beam must be provided below bath & w.c. p. walls.
4. Middle room will be dark
5. width of road should be 3'.
6. width of ground should be increased to 3' 6"
7. There will be no light in kitchen

Date 13/1114A. D. Agha
Building Surveyor.

15-4



4

No E. of 192

MUNICIPAL ENGINEER'S OFFICE,

Karachi, 192

Ex. Engineer's orders

Plans passed.

Returned to Land Manager and Architect for necessary action and submission to Managing Committee.

E.E.
5 MAR 1926

Ex. Engineer,
Karachi Municipality.

SM
26.3.26

26/3

6 MAR 1926

No. L.M. 2388 of 1926

by 9/3/26

Submitted to the Managing Committee through the Chief Officer.

For M.C.

to

9/3

R. J. Wood 9/3

Land Manager and Architect.

Me

RESOLUTION OF THE MANAGING COMMITTEE.

Resolution No. dated

[Faint handwritten text, likely bleed-through from the reverse side of the page]