



PROPOSED ADDITIONS & ALTERATIONS IN BUILDING ON PLOT NO 7 SHEET B-4. SERAI QUARTERS.

SCALE 16 FEET TO AN INCH.


NOTE.
NEW WORK SHOWN IN RED
WORK TO BE REMOVED SHOWN IN YELLOW.

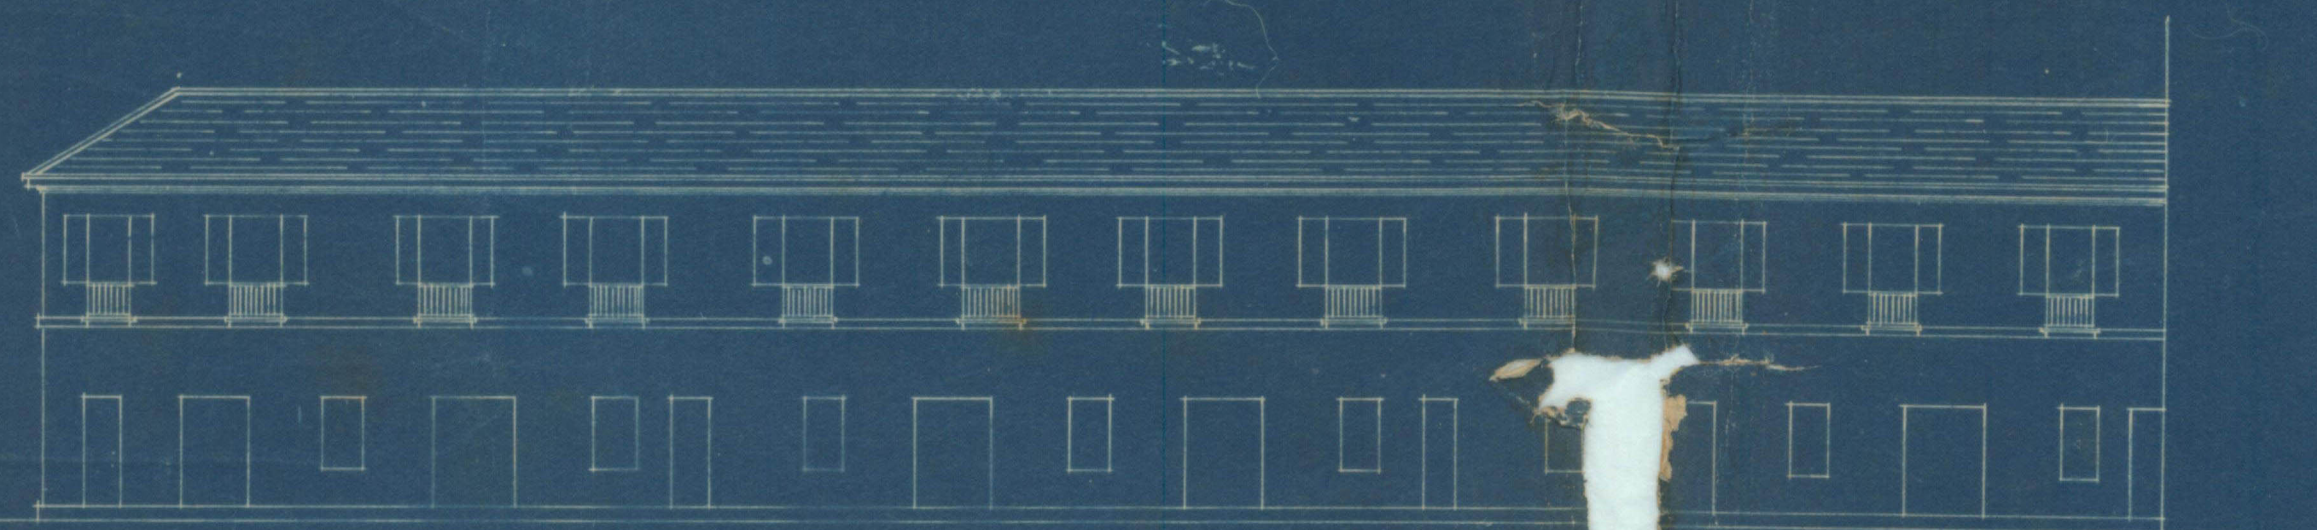

ELEVATION ON GRANT ROAD

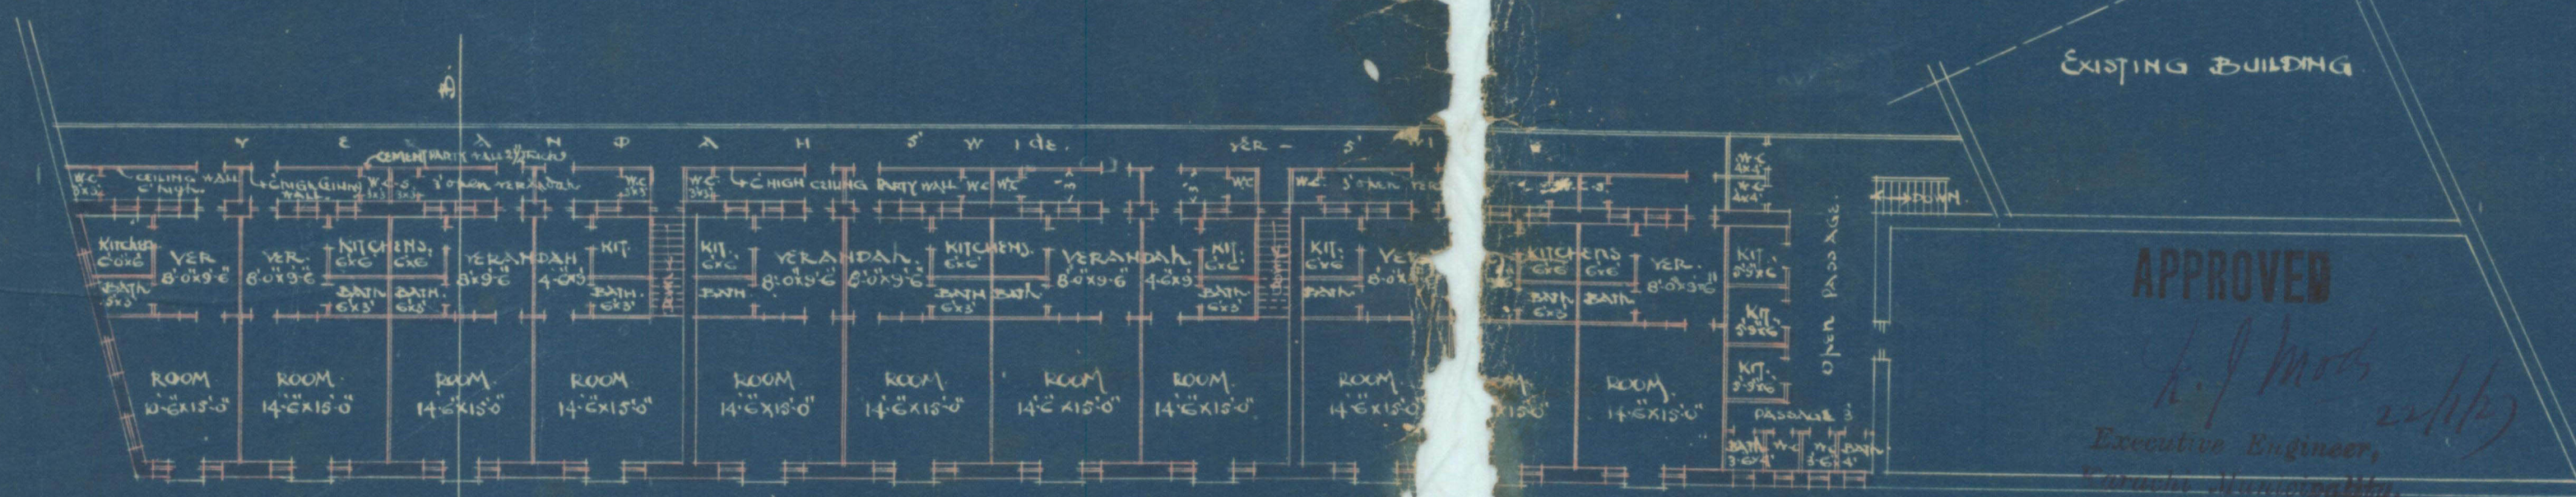


PLAN OF FIRST FLOOR

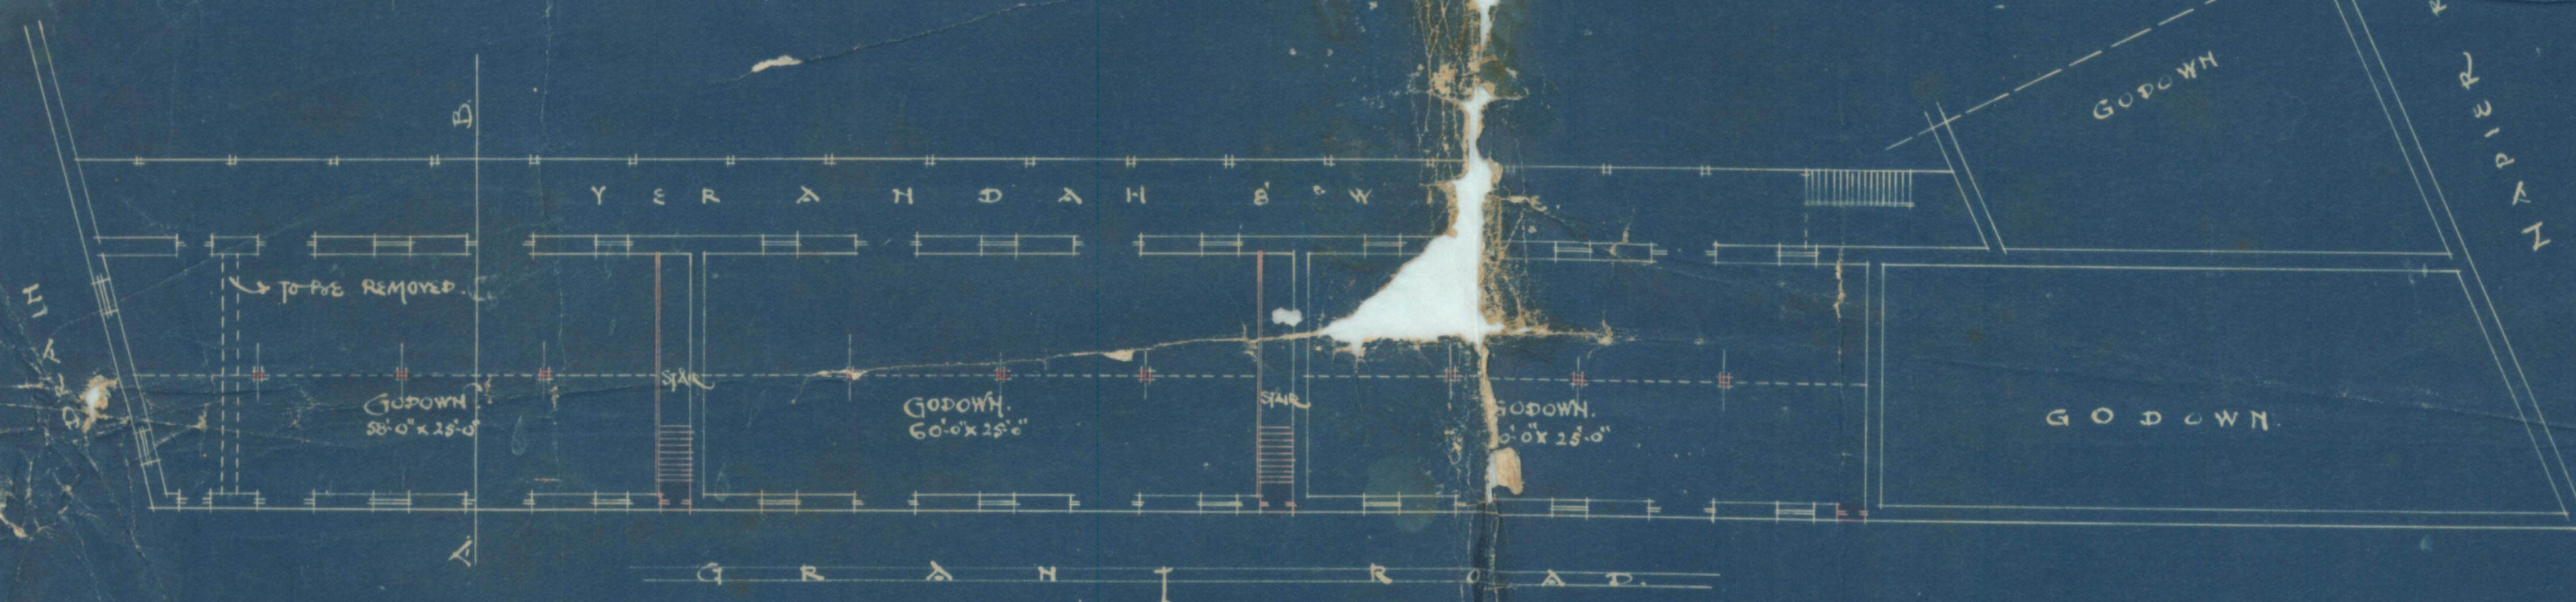

PLAN OF GROUND FLOOR


SITE PLAN SCALE 40 FEET TO AN INCH.

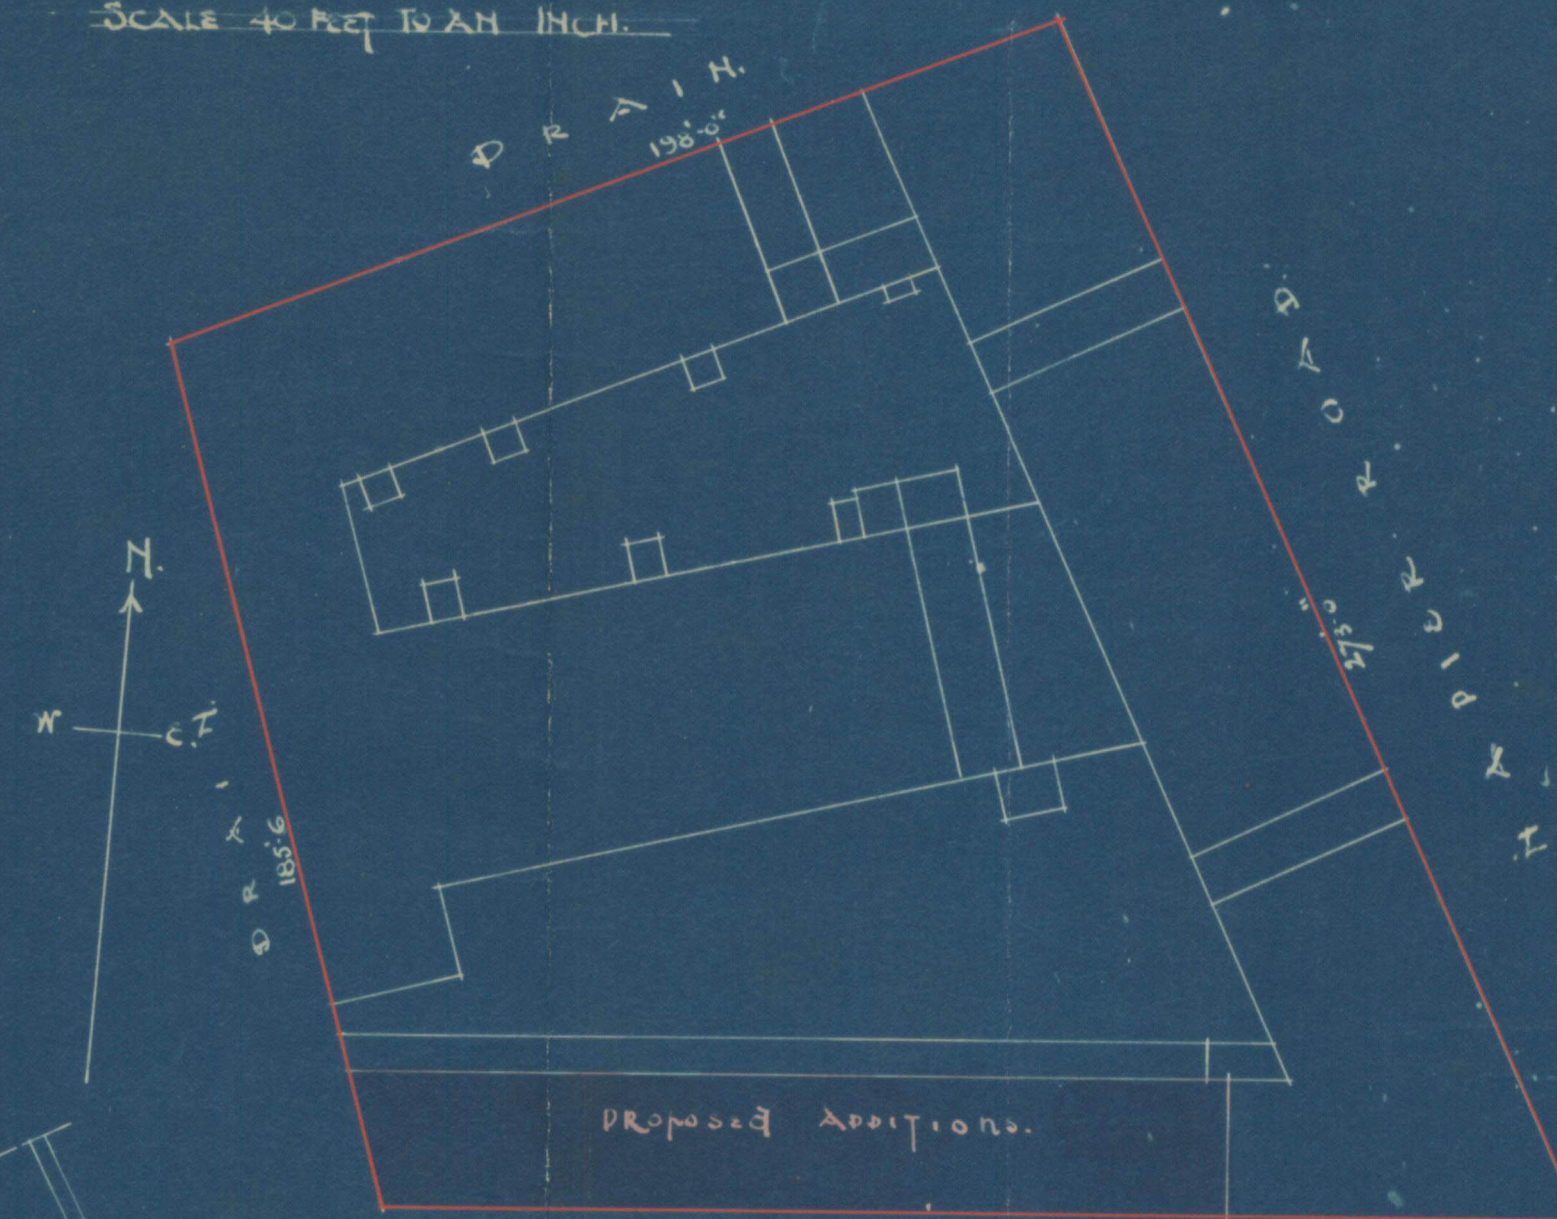

PROPOSED ADDITIONS.

252.0

GRANT ROAD

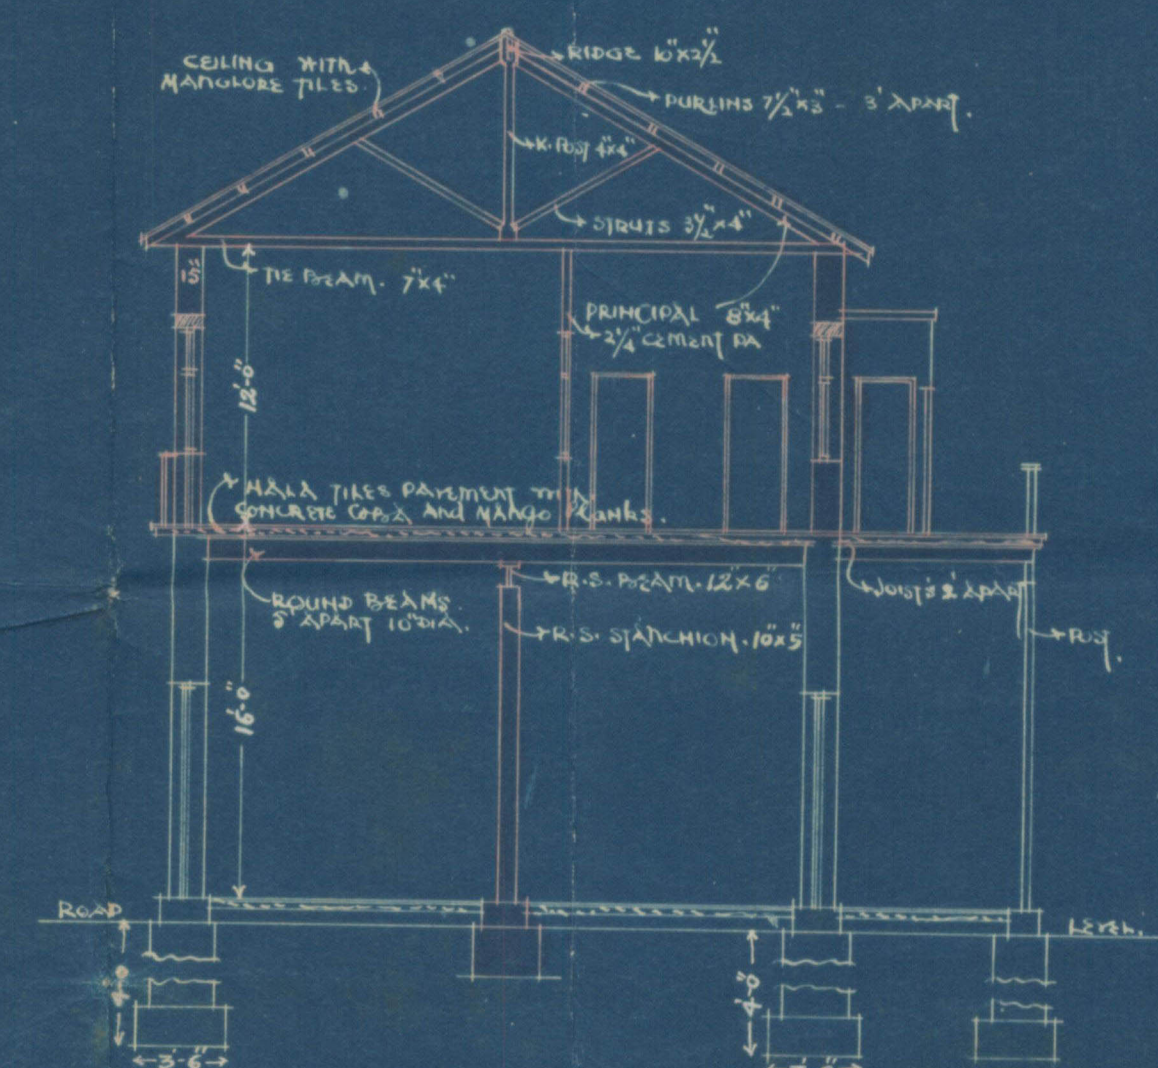

SECTION ON A-B
SCALE 8 FEET TO AN INCH.

M. J. BHADRA
P. A. S. L. C. E. S.
ARCHITECTS AND CIVIL ENGINEERS

24



Heritage

KMR.CDD.MiQ.1926-1938.01

KARACHI MUNICIPALITY.

N. J. MODI.

B. Sc., (Engineering London).

A. M. INST. C. E., L. C. E. & C.

Land Manager & Architect.

REFERENCE No. L. M. A.

1608

LAND MANAGER & ARCHITECT'S OFFICE,
KARACHI.Karachi, 20/2/ 1926.

MEMO :

With reference to his application, dated 8.2 - 1926, with
~~their~~plans for the proposed add: salt on plot No. 104
Nos.Survey Sheet E.7 Ranchore Quarter,Mr. Moose mittoo is
Messrs. are

informed that the same is under consideration.

He must not start any building operations until he hears further
~~They~~ they hear

from this office.

B. Sc., A. M. I., C. E.

Land Manager & Architect,
Karachi Municipality.

C. N. C. N. K. K. K.

C. N. C. N. K. K. K.

19/2

KARACHI MUNICIPALITY.

R. J. MODI.

(B. Sc., Engineering London.)

A. M. INST., C. E., L. C. E.

A. M. I. S. E., M. R. San. I.

Land Manager & Architect.

REFERENCE No. L. M. A.

LAND MANAGER & ARCHITECT'S OFFICE,

KARACHI,

2177 OF 1926
4/3/1926

MEMO:—

With reference to ^{his}~~their~~ application dated 8.2.26 with aplan for the proposal ^{Building}~~additional~~ on plot No. 104 Survey Sheet No. E-7.

Rameela Quarter Mr. Moosa Mithoo is informed that

until the following requirements are complied with the plans cannot be passed.

- (1) Existing building is unfit for human habitation.
- (2) Back to back rooms let to different tenants are objectionable.
- (3) Existing building must be improved & sanitary conveniences must be provided.
- (4) Thickness of walls are insufficient.
- (5) Foundation must be opened out.
- (6) Dimensions for rooms on new floor must be given. W.C. & bath over staircase cannot be allowed & their dimensions at all places must be put on plan.
- (7) The existing Calm on 3rd floor must be shown on plan.
- (8) Title deed must be produced.
- (9) The walls for ground & 2 upper must be 18" at bottom & 15" for ground & 1st floors.

The plans are returned herewith for amendment.

B. Sc., A. M. I. C. E.,

Land Manager & Architect.

2.3.26

pl. keep
pending
Shr
25.5.26

pl. Keep pending
ie the corrected plans
are received.
CN.
5.3.26



13

Ms. Jalesh

Lipine Shells

 $\frac{2}{24\frac{1}{2}}$

complete

 $\frac{26}{25\frac{1}{2}}$



No. G _____ of 192 .

MUNICIPAL CHIEF OFFICER'S OFFICE,

Karachi, 15 - 2 - 1926.

MEMO:

The above application is forwarded to the Municipal Health Officer for favour of report.

*Imptr Shatt
show my*

15/2

for *Chief Officer.* *15/2*

MUNICIPAL HEALTH OFFICER'S REPORT.

Returned to the Land Manager and Architect, Karachi Municipality with the following Remarks:—

Date of receipt _____

6 story building is unfit for human habitation. Back to back rooms let at different tenancies are objectionable. A special work improve the 6 story building & provide sanitary conveniences & it will be considered

Date of disposal _____

Date 16 - 2 - 1926.

Health Officer.



No. L. M. _____ 192

Date of receipt: _____

LAND MANAGER AND ARCHITECT'S OFFICE,

Karachi, _____ 192

Forwarded to the Building Surveyor and Land Surveyor for report.

Land Manager and Architect.

BUILDING SURVEYOR'S REPORT.

Applicant's Name Musa DithooWhether he is the owner of the plot on which it is proposed to build noPlot under whose control MplWhether it is permanent or temporary PermanentThe work proposed Add. & alt.

Building Surveyor's Report Thickness of walls are insufficient.
Foundation must be opened out. Sizes Dimensions for
rooms on new floor must be given. W.C & bath over
Staircase cannot be allowed and their dimensions at
all places must be put on plan. There is a cabin
on 3rd floor existing on the north side, Is and from
enquiry on site the owner does not want to remove it.
Architect has seems to have forgotten about it. It
must be shown on plan. Title deed must be produced.

Date 17-2-26C. Paneth
Building Surveyor.



LAND SURVEYOR'S REPORT.

Does the plot come under Alignment

no alignment

Area of plot

Area under Alignment

Remarks

side means according toS.O.C recordno objectionDate 19/2 1926.

Land Surveyor.

Remarks of.

LAND MANAGER AND ARCHITECT.

Super as per H.O. & B's sketch
the walls for gr + 2 up to must be
18" at bottom + 15" for gr + 1 at top

1/3/26C/o P. L. L. L.SKN1-3-26

Date of disposal

Submitted to Ex. Engineer :

Land Manager and Architect.



KMR.CDD.MiQ.1926-1938.01

4

No. E.

of 192 .

MUNICIPAL ENGINEER'S OFFICE,

Karachi, _____ 192 _____

Ex. Engineer's Orders.

Returned to Land Manager and Architect for necessary action and submission to Managing Committee.

Ex. Engineer,
Karachi Municipality.

No. L. M.

of 192 .

Submitted to the Managing Committee through the Chief Officer.

Land Manager and Architect.

RESOLUTION OF THE MANAGING COMMITTEE.

Resolution No.

dated

Telegrams:—"ARCHITECT."

CHIMANDAS N. LALA & CO.

Architects & Engineers

DENSO HALL

Bunder Road,

KARACHI, 8th Feb 1926



90

Land Manager & architect

Karachi Municipality -

Karachi

Dear sir, I am herewith sending you the plans showing alterations and additions in the existing Building on Plot No 134, E7, Ranchore Quarter and shall be obliged for early approval

Yours faithfully
(Mats)

Building Survey with
Plans Mess.

Diakhi
9/2/26

Seen the Bldg.

c/c M. forward to H.O. for

C.L.P.
14/2

Karachi, 8th Feb 1926

NOTICE UNDER SECTION 96 OF ACT III OF 1901.

THE CHIEF OFFICER,

KARACHI MUNICIPALITY.

SIR,

I beg to inform you that I intend ~~building~~ making alterations
and additions in the ^{Building} on plot No. 104

Survey Sheet No. E7 Situate in Ranchore QuarterStreet, _____ Quarter. Kalyanji Street

As required by the Rules of the Municipality I beg to submit herewith a plan of the same for your approval.

I beg to remain,
Sir,

Your most obedient Servant,

Address:—

Signature of the Applicant

No. G.


oF 192. .

MUNICIPAL CHIEF OFFICER OFFICE,

Karachi, _____ 192 .

Forwarded to the Health Officer for favour of passing on to the Land Manager and Architect after putting his remarks.


for Chief Officer
Karachi Municipality.

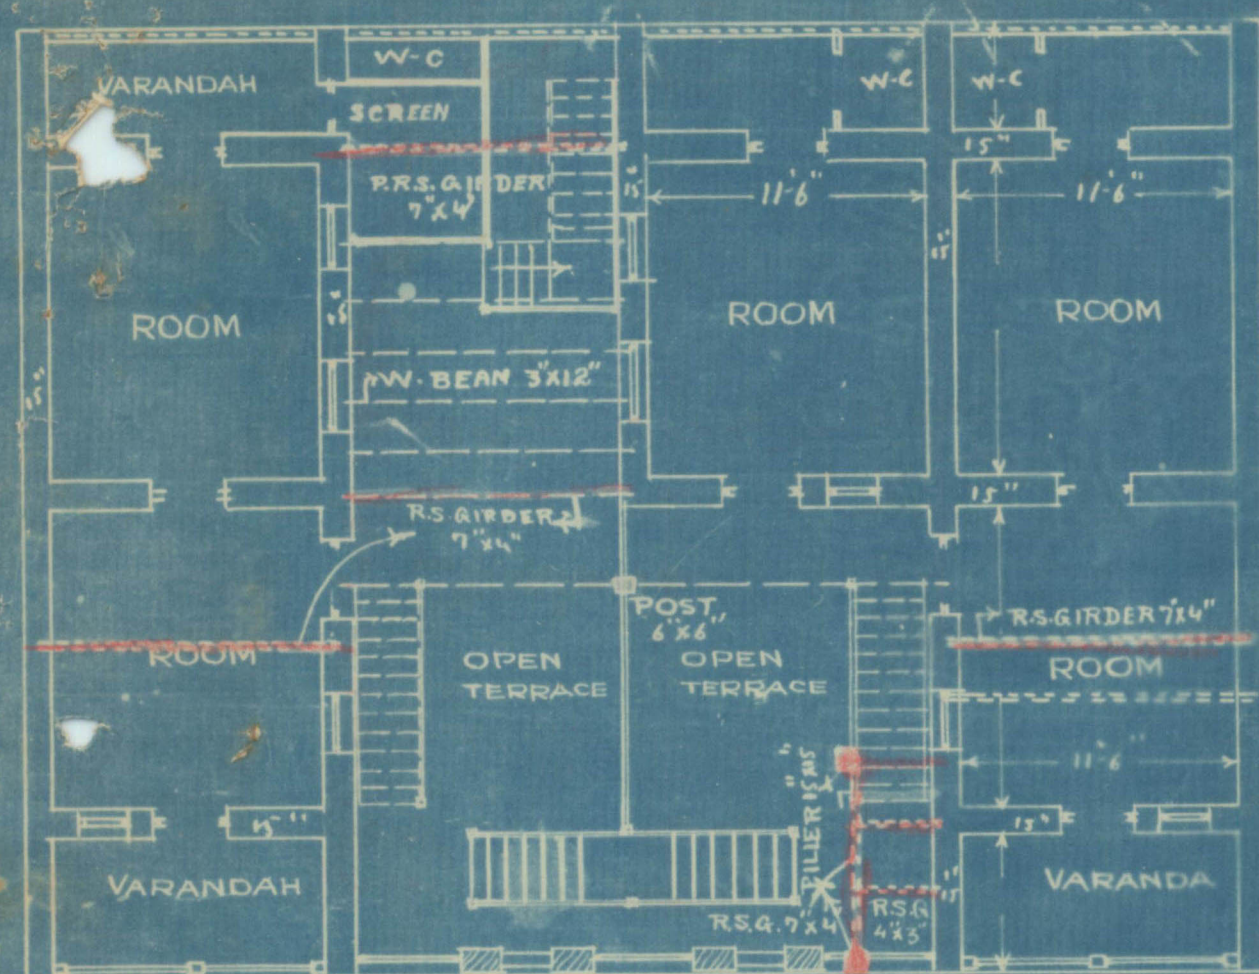


— FIRST FLOOR PLAN —

NOTE:-


R.C. BLOCKS WILL BE LAID AROUND BEFORE CARRYING PROPOSED FLOOR

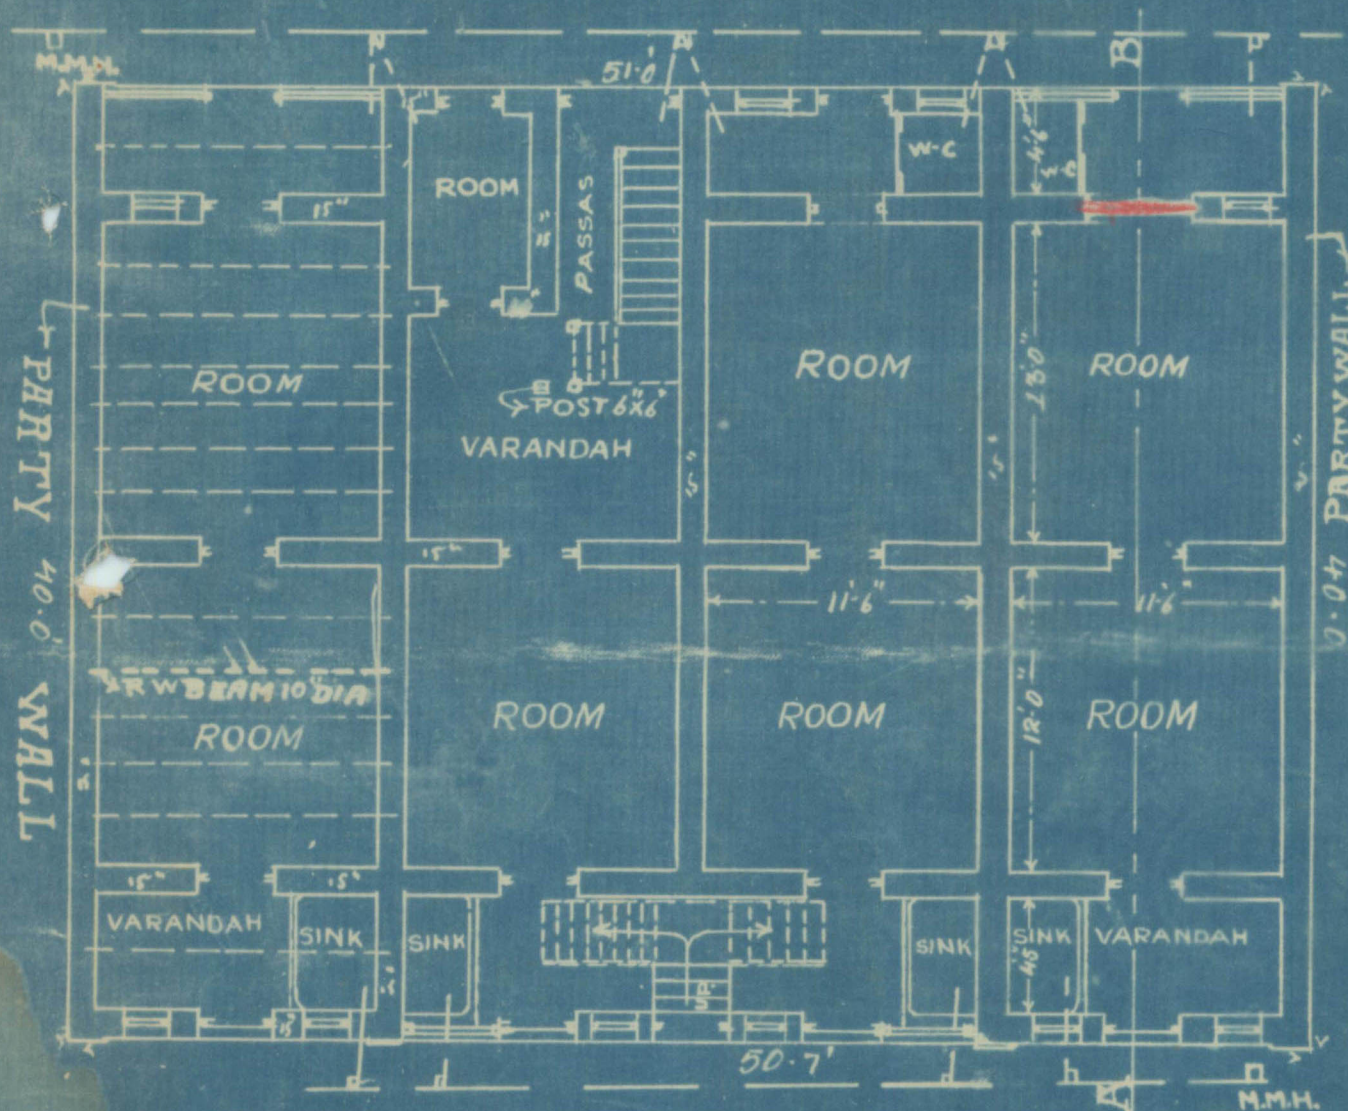

— GROUND PLAN —

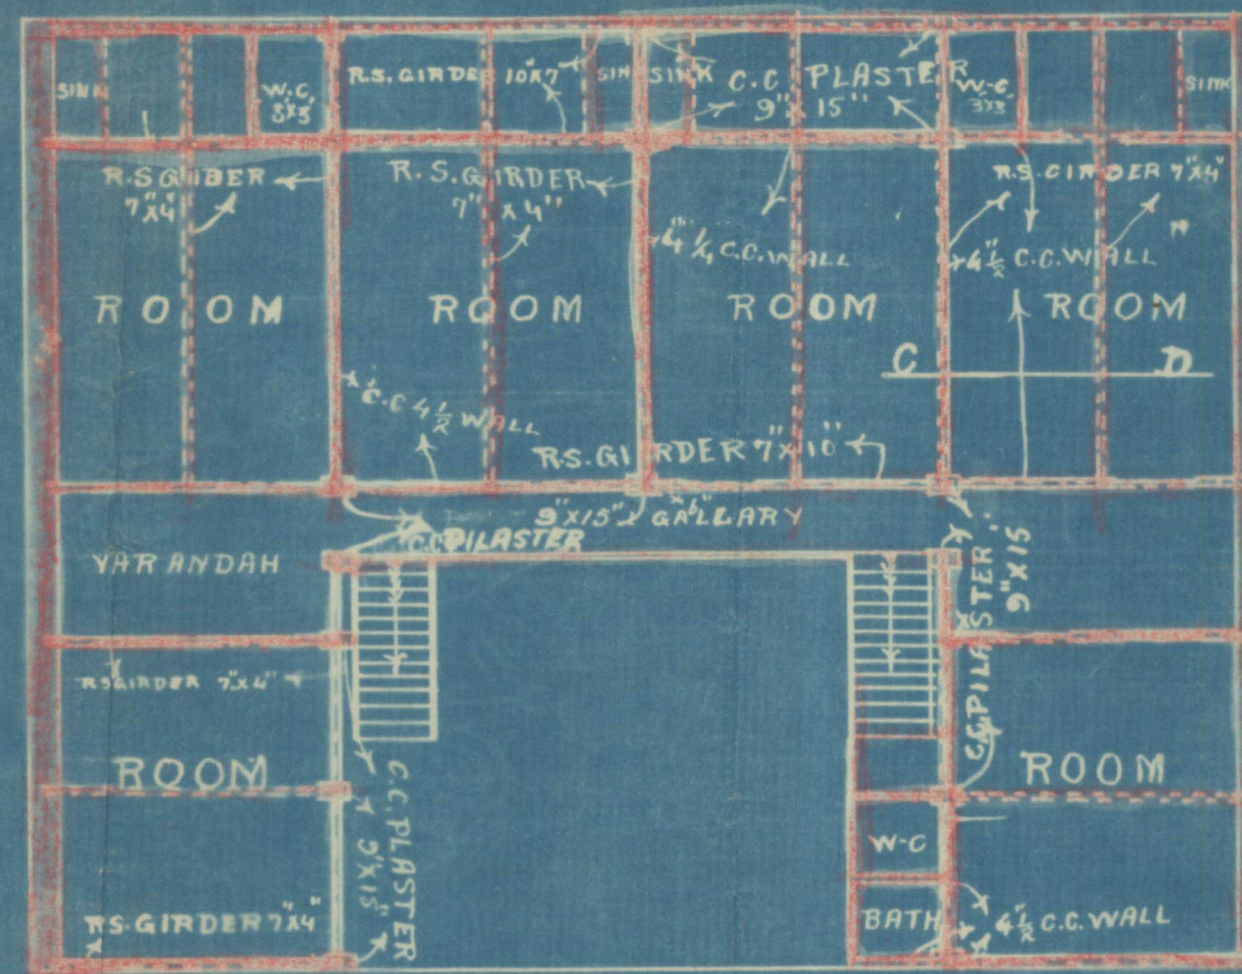

SECOND FLOOR PLAN

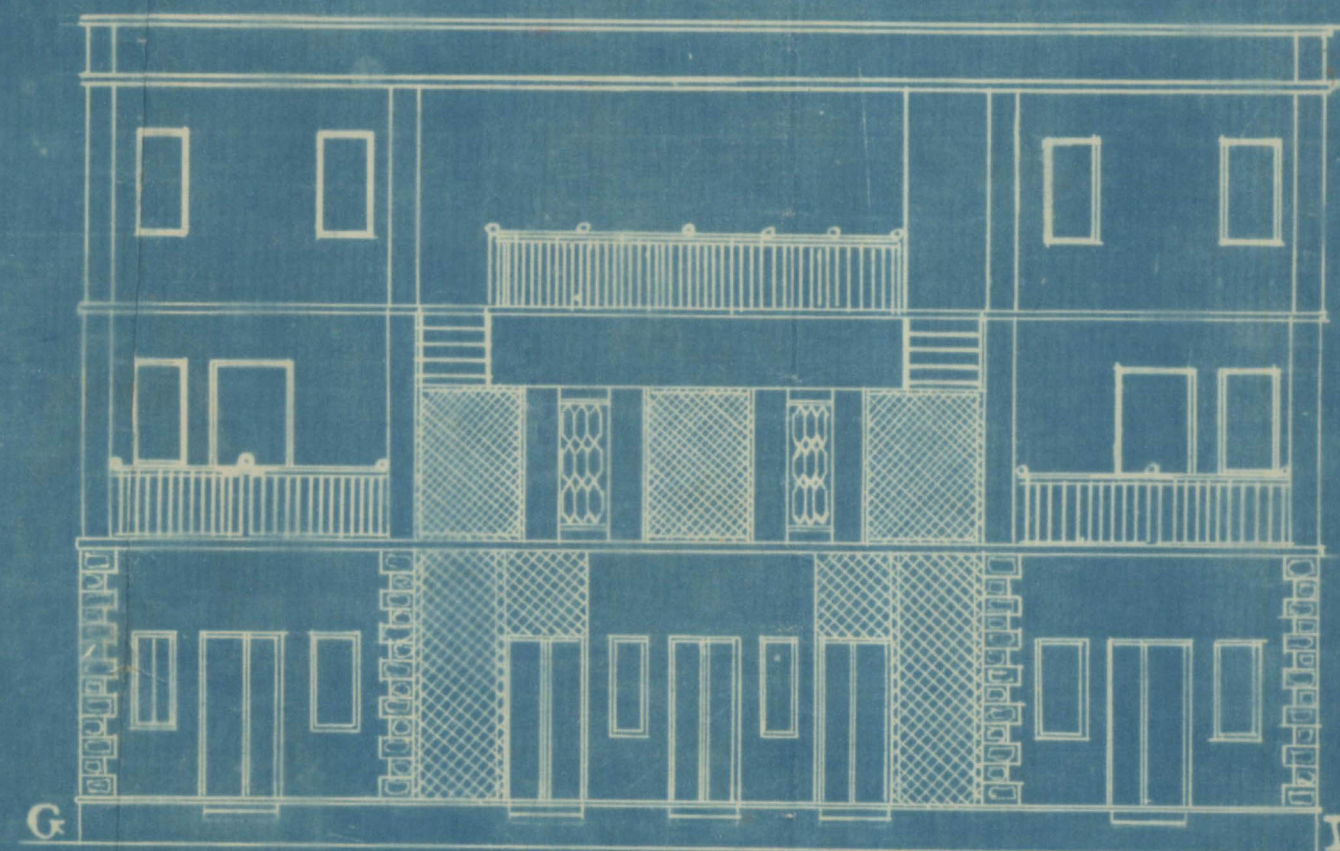


FRONT ELEVATION

— PLAN SHOWING ADDITIONS & ALTERATIONS IN BUILDING ON —
— PLOT N^o 104 SHEET E-7 —

— RANCHORE Q^o —

— Scale 8'-1" —

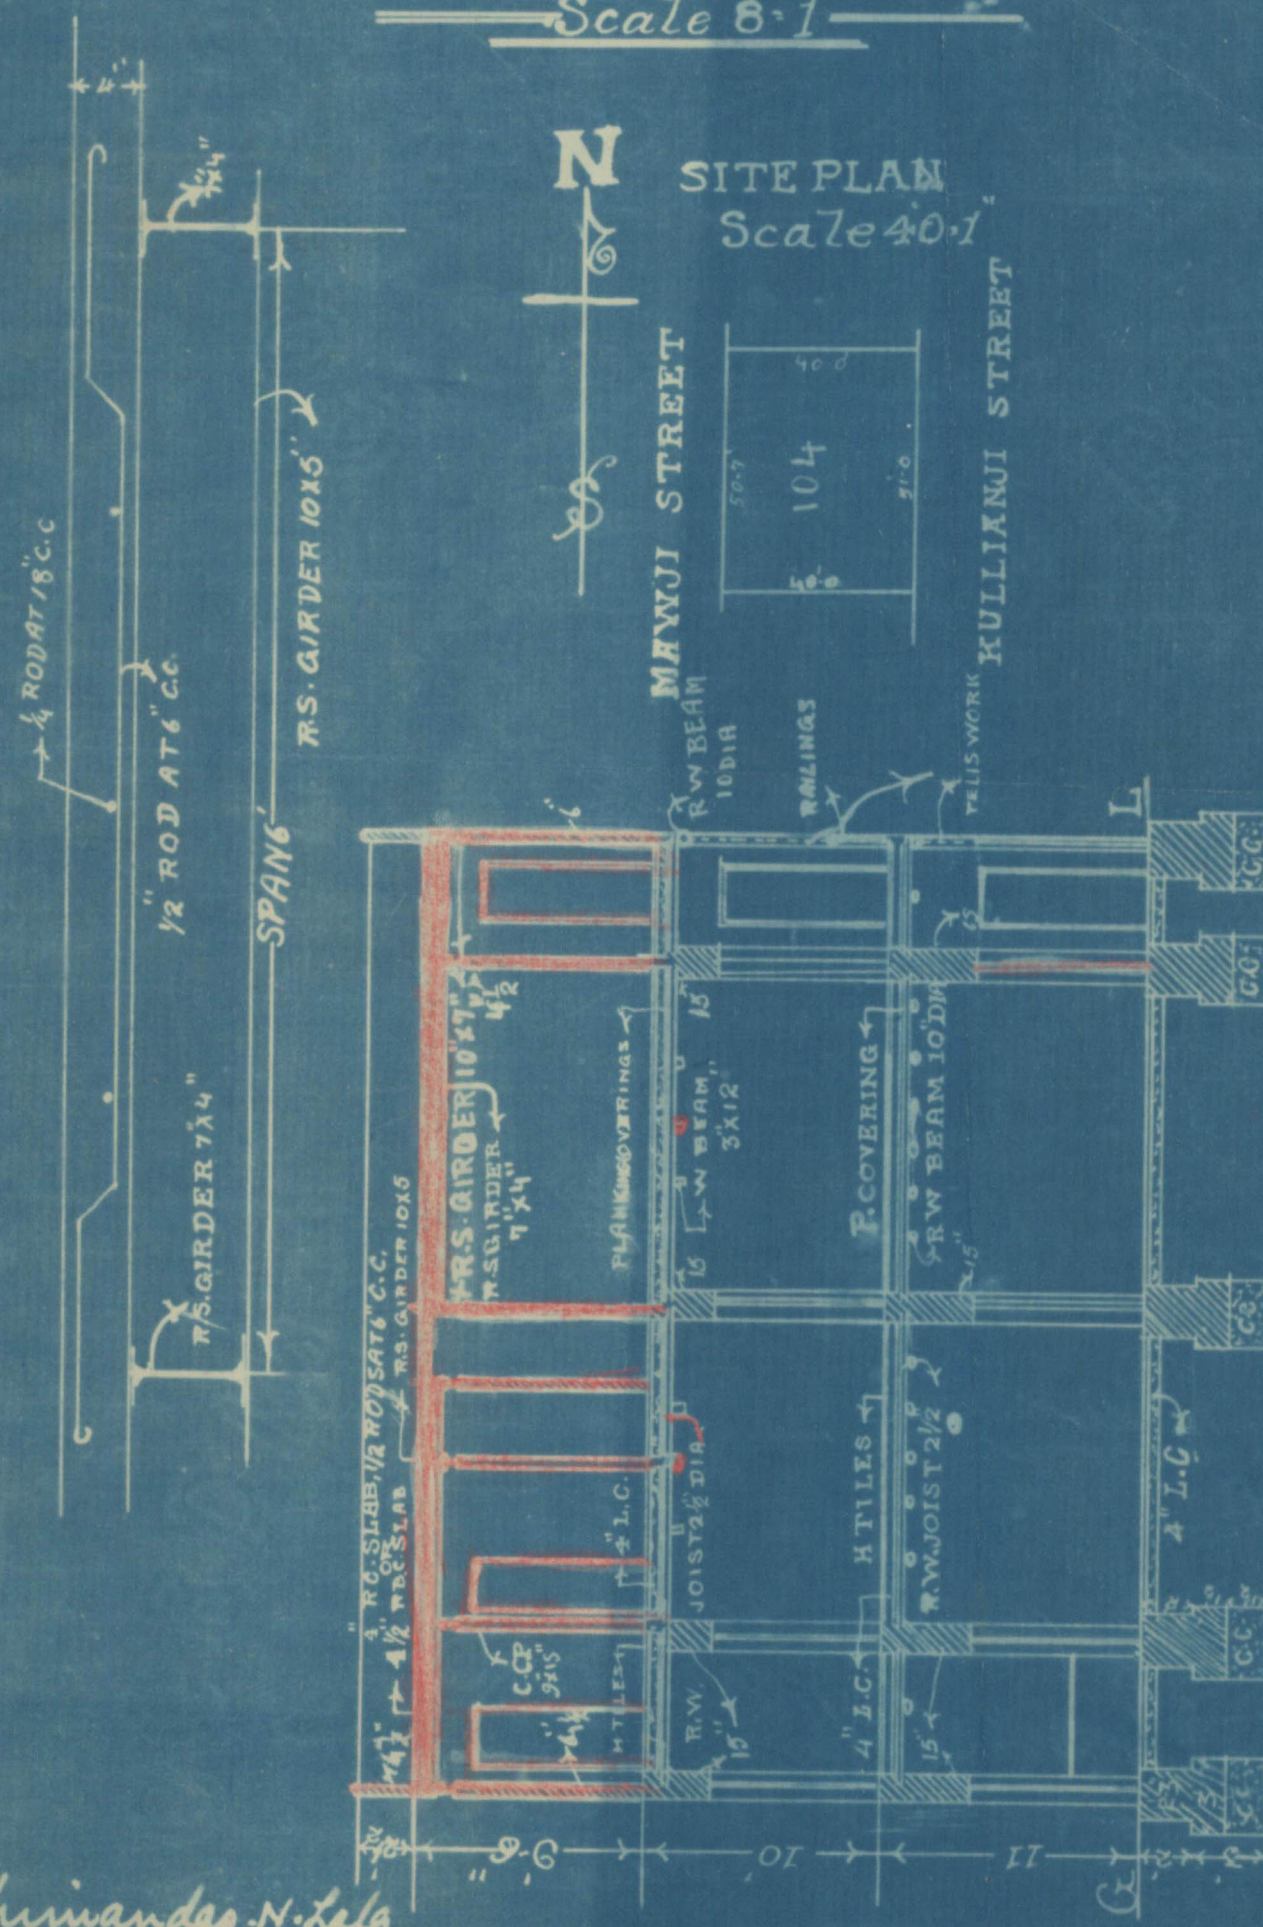


SECTION ON C-D

Scale 1'-1"

1/2" ROD AT 18" C.C.

1/2" ROD AT 6" C.C.

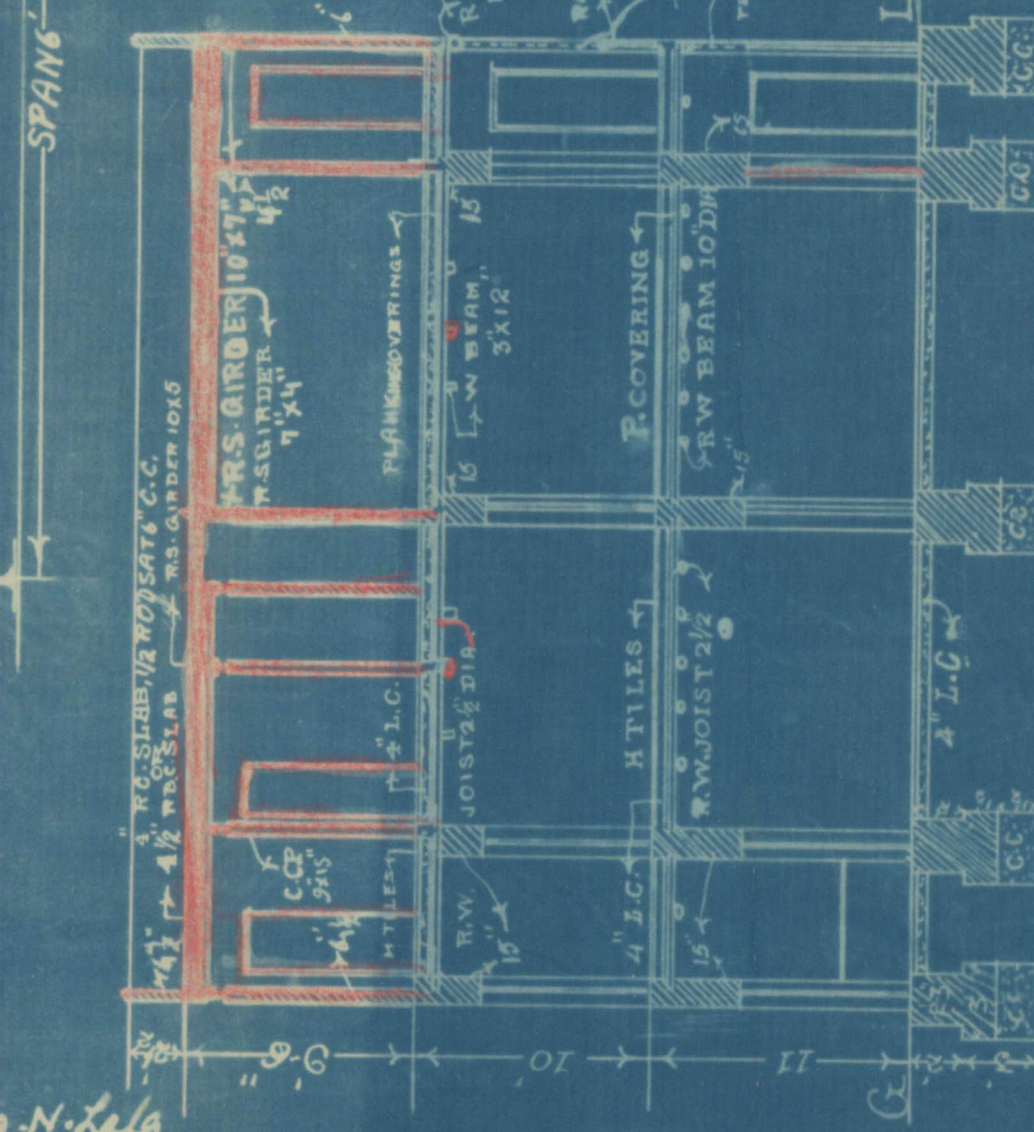

SECTION ON A-B



OWNER

Chirandas N. Lala
ARCHITECT & ENGINEER.

30-1 Blue side
(3) 30-2

KMR.CDD.MiQ.1926-1938.01

(4)
KMR.CDD.MiQ.1926-1938

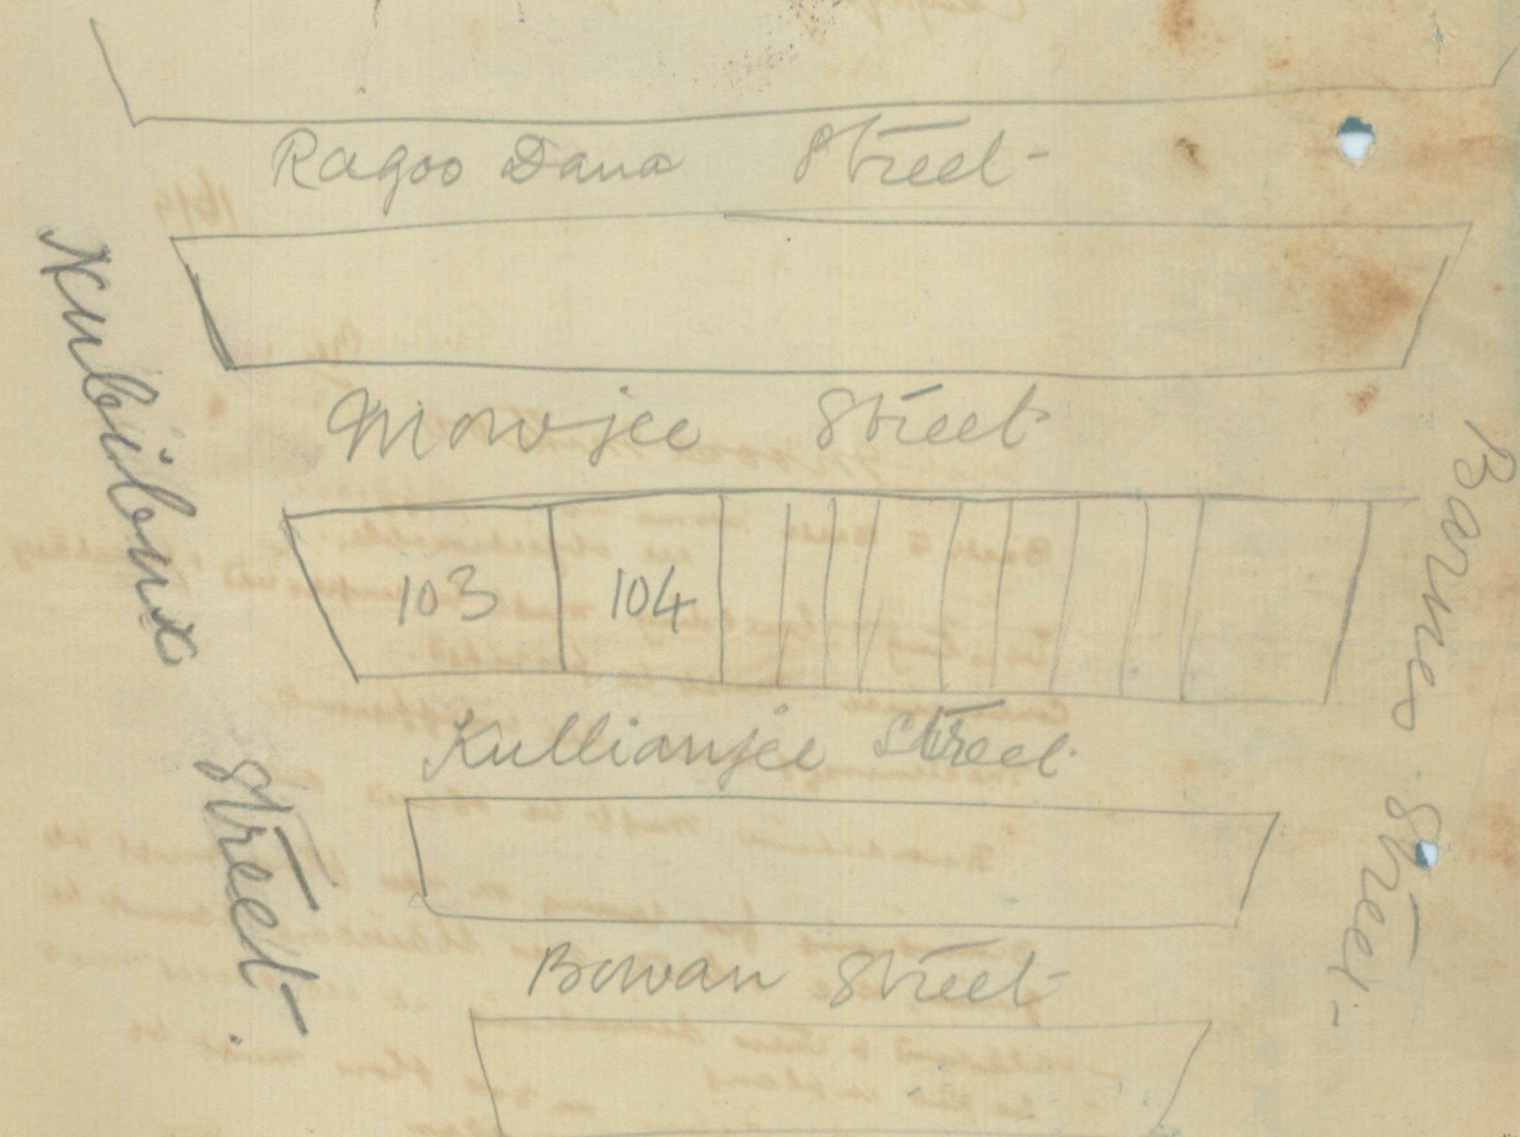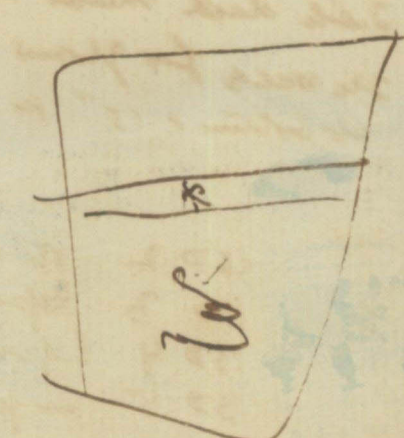

31

Heritage

KMR.CDD.MiQ.1926-1938.01

500-1-4-26.

KARACHI MUNICIPALITY.

N. J. MODI.

B. Sc., (Engineering London.)

N. M. INST., C. E., L. C. E.

A. M. I. S. E., M. R. San. I.

Land Manager & Architect.

REFERENCE No. L. M. A. 9217

OF 192

LAND MANAGER & ARCHITECT'S OFFICE,

KARACHI, 17.5. 1926.

MEMORANDUM.

18 REMINDER

Plot No. 104 Sheet E-7 R. shore Or.

Letter No. L. M. A. 7336 dated 23-7-1926

Regarding Complying with requirements

The undersigned requests the favour of and early compliance to this Office reference noted in the margin.

B.S.
For necessary action

To,

Mr.

M. M. Mithoo

B. Sc., A. M. INST. C. E.,
Land Manager & Architect,

15.9.26