



000-4.32

Department

FILE No. of 1932.

SECTION

PART

Disposal No. 1184/34

Subject

36/61 Jm 3 Janned

1442. A. Jm. J.

NOTE :—Former Correspondence filed in

file

Compilation No.

Subsequent Correspondence filed in

file

Compilation No.

No. B. S. P. 184/34



MUNICIPAL CORPORATION
KARACHI.

2

KUMBERALI BHALEDINO Esq., L.C.E.,

Land Manager & Architect,

ORDER UNDER SCH. VI CLER. XI, RULE 5 (I) OF
ACT XVII OF 1933.

~~Mx Secty. Hyd. Amil Cooperative Housing Societ~~

C/o Mr. N. M. Siddiqui (Architects)
KARACHI.

With reference to your application with plan for building
on plot No. 36/6 Sheet No. JM 3, Jamshed Quarter received in this
office on 28. 3. 1934, I have to inform you that the said plan
approved and permission to build in accordance therewith is hereby granted.
The building must be erected in conformity with the Bye-laws and rules of
the Karachi Municipal Corporation.

A copy of approved plan is attached herewith.

*P. note to him that
the color on cloth is
insufficient & requires
correction*

1/6

Lambard
Land Manager & Architect
Karachi Municipal Corporation

ce
Rs 1/6

NOTICE, 1 :—This sanction holds good provided the work of construction
commenced in earnest within a year from this date, whereafter the sanction
deemed to have lapsed.

NOTICE, 2 :—This sanction does not entitle the owner to build
conveyed to him either by the Government or the Municipality by a
in a Sanad.

NOTICE 3 :—This pass does not give permission to occupy Municipal
building materials. This can only be allowed when the Street is
permit building materials being deposited on it without it being a source
the public and only then on a hoarding being placed round the land
and on payment in advance, of fees for occupation of Municipal land
rates.

- | | |
|--|---------|
| (1) For first 12 weeks, per square yard per diem | ... Rs. |
| (2) For the next 12 weeks, " " | ... " |
| (3) For any subsequent time " " | ... " |

NOTICE, 4 :—Windows, steps and doors of the building will not
project on or overhang public street or Municipal land.

NOTICE, 5 :—Plinth cornice will not be allowed to project
on any Public street for ornamental purposes.

NOTICE, 6 :—You are required to give timely intimation to
and Architect before filling in the foundation and before concrete
inforced concrete work.

NOTICE, 7 :—In case of set back or set forward, the first
be laid after the line is checked by the Land Surveyor.

S.P. 438/30

4 - SEP 1934



Municipal Office
Karachi.

Corporation of Karachi

From

Kumberali Bhaledino Esq., L.C.E.,

Land Manager & Architect

ORDER UNDER SCH. VI CHP. XI, RULE 5 (1) OF

ACT XVII OF 1933.

Mr.

Kamherali: Baledina Sefura

Go rap. to the barometer (indicated)

KARACHI.

With reference to your application with plan for addition valuation on plot No. 3C sheet No. 2, 2nd gr., received in this Office on 12.7.1934, I have to inform you that the said plan is approved and permission to build in accordance therewith is hereby granted. The building must be erected in conformity with the Bye-laws and rules of the Karachi Municipal Corporation.

A copy of approved plan is attached herewith.

Lambareal: Phreoria

Land Manager & Architect.

Karachi Municipal Corporation.

Notice 1:- This sanction holds good, provided the work of construction is commenced in earnest within a year from this date, whereafter the sanction will be deemed to have lapsed.

Notice. 2- This sanction does not entitle the owner to build on land not conveyed to him either by the Govtt or the Municipality by a Sanad or entry in a Sanad.

Notice.3.-This pass does not give permission to occupy Municipal land with building materials. This can only be allowed when the street is wide enough to permit building materials being deposited on it without it being a source of danger to the public and only then after hoarding being placed round the land to be occupied and on payment in advance, of fees for occupation of Municipal land, at the following rates.

- | | | |
|--|-----|--------|
| (1) For the first 12 weeks, per sq.yard per diem.. | Rs. | 0-0-3½ |
| (2) For the next 12 weeks, " " " " | " | 0-0-7 |
| (3) For any subsequent time " " " " | " | 0-1-2 |

Notice.4:- Windows, steps and doors of the building will not be permitted to project on or overhang public street or Municipal land.

Notice. 8:- Plinth cornice will not be allowed to project more than 2 inches on any public street for ornamental purposes.

Notice.6:-You are required to give timely intimation to the Land Manager & Architect before filling in the foundation and before concrete is filled in for Reinforced concrete work.

Plinth 7:- In case of setback or set forward the first course of Plinth must be laid after the line is checked by the Land Surveyor.



Recd. on 5 P.M.
27/3
FORM A.

NOTICE UNDER SCHEDULE VI CHAPTER XI, RULE 2 (1) OF
THE CITY OF KARACHI MUNICIPAL ACT, 1933.

Karachi, 28/3/34

Date of delivery at Municipal Office

To,

THE CHIEF OFFICER,
MUNICIPAL CORPORATION,

Dear Sir,

KARACHI.

Pursuant to the provision of Schedule VI, Chapter XI, Rule 2 (1) of the City of Karachi Municipal Act 1933, I hereby give you notice that I intend with the meaning of that rule to erect a building on plot No. 346 Survey Sheet

Im-3 Situated in Jamshed street Jamshed Quarter as per Ground plan, Elevation and Section sent herewith in quadruplicate.

The said building will be of the following description, _____

It is intended for the purpose of _____

Residence.

†Specification of the work will be as follows :—

*I also submit herewith a certificate from the Electrical Inspector to Government as required under Rule 92 (3) of the Indian Electricity rules.

I further beg to inform you that the name of the person whom I intend to employ to supervise the erection of the said building is Mr. N. M. Gidwani & Co.

I hereby under take to abide by the City of Karachi Municipal Act 1933, and all rules and bye-laws framed pursuant to the Act.

Yours faithfully,

Signature of the owner

Address of the owner

Jamshed Gidwani
HON. SECRETARY

†See on the reverse.

*This line to be struck off if there is no electric line passing by the plot.



4-2

2

Nature of soil in foundation Hard Murram.
Nature of masonry in foundation Chupcha Stone.
do. Plinth do
do. Superstructure do
Kind woodwork in trusses, post, ect. Pukka
Teak wood.
Kind of Roof R. C. C. Roof.
Kind of Floor Bajri Plaster.
Method of Drawing Sullage Water _____

NOTE.—Specification and nature of work should be given against items of work mentioned above.

Karachi 28/3/34.

To,

The Chief Officer,

Municipal Corporation,

Sir,

Karachi.

With reference to the notice under Schedule VI, Chapter XI, Rule 2(1) of the City of Karachi Municipal Act 1933, submitted to you by ~~me~~

The Hon. Secretary, The H. A. S. Society Ltd.
for the building at Jamshed Quarter.

I beg to inform you that I have agreed to supervise the erection of building work mentioned therein,

I beg to remain,

Sir,

Your most obedient Servant.

N. M. Firdausi
Licensed Surveyor.



5
p 184
34

Re. Plot no. 36/6, Jm 3, Jm 5

Forwarded with compliments
to the Health Officer for
favour of remarks.

signed 4/4

Land Manager & Architect

As there is no drainage in this
area there is no objection to allow
privies with cess pits.

M 5/4

28/4/35

[Faint mirrored handwriting, likely bleed-through from the reverse side]



6-1

KARACHI MUNICIPALITY.

NOTES SECTION.

Building Department.

Case No. P/Q 184/34

Plot No. 36/6 Sheet No. 3, Karachi Quarter

Applicant's Name Syed Amir Ali

Architect's Name H. H. Sidani

The above application with plans is forwarded with compliments to the Health Officer for favour of report.

Date of despatch 4/4

ms 60

Insp. Tremdi

to show 5000/4

4/4.

for Land Manager and Architect,
Karachi Municipality.

MUNICIPAL HEALTH OFFICER'S REPORT.

Returned with compliments to the Land Manager and Architect, Karachi Municipality with the following Remarks:—

N.S. cannot be permitted as no drainage is laid in this area

In highway
please
22/7/4.

no objection plan
25/5-2

Date 5-4-34

Health Officer.

EXTRACT FROM THE LAND REGISTER.

New plot No. _____ Sheet No. _____ } _____ Quarter.
 Old plot No. _____ Sheet No. _____ }

Whether under Govt. or Municipal Control ...		
Registered plot.	Holder ...	of ...
Area.	Government ...	
	Municipal ...	
	Total ...	
Title and period of lease...		
Form of lease ...		
Any Special conditions of lease ...		
Remarks.		

BUILDING SURVEYOR'S REPORT

1. The various structures are not completely dimensioned with the result that the built up area calculations cannot be checked. (Dining Hall & Drawing Room not completely specified. Large gallery passage near the hall projections etc)
2. Rec beams & slab, pillars with reinforcement be specified
3. Thin exterior walls must be 6" CP.
4. Section requires correction.
5. Court yard walls be specified with thickness & height
6. Bay windows must be specified in their dimensions
7. gallery passages have to be taken in built up area.
8. WCs cannot be allowed as there is no drainage.
9. Landing for stairs be shown
10. It must be shown how main staircase for out house is supported
11. Section through the garage with separate loft plan be given

Date 17/4/34.

Thames & Co.
Building Surveyor.

LAND SURVEYOR'S REPORT.

- (1) Does the plot come under Alignment? no
- (2) Is the Alignment Correctly Shown? -
- (3) Are the Site Measurements correct? yes
- (4) Is there any encroachment? no
- (5) Is the plot affected by T. P. Scheme? no
- (6) Is the plot subject to any conditions of previous sub-division and Amalgamation?

no objection

Date 17. 4. 34

Land Surveyor.

Remarks of

LAND MANAGER AND ARCHITECT.

Ho & B's direction
21/8/4

Date

Land Manager and Architect.



Heritage

KMR.CDD.JmQ.1934.02

MUNICIPAL CORPORATION,
KARACHI.Office Telephone Nos. 1140 & 1141.
Residence " " 199.AMBERALI BHALEDINO,
L. C. E.,
LAND MANAGER & ARCHITECT

Reference No. B. S. P. 184/34

19 APR 1934

To,

Secy, ~~Hyd.~~ Hyd. Amil. Society

c/Omr. H.M. Adwani, architect.

Dear Sir,

With reference to your application dated 29/3/34.

with a plan for the proposed building/additions and alterations on plot
No. 36/6, Survey Sheet No. J.M.3, Jamsheed Quarter

I have to request you to comply with the following requirements:—

- ✓ 1. The various structures are not completely dimensioned with the result that the built up area calculations cannot be checked (dining hall and drawing room not completely specified. Gallery passage near the bath projections etc)
- ✓ 2. R.C.C. beams and slab pillars with reinforcement be specified.
- ✓ 3. Thin external walls must be 6" c.p.
- ✓ 4. Section requires correction.
- ✓ 5. Court yard walls be specified with thickness and height.
- ✓ 6. Bay windows must be specified in dimensions.
- ✓ 7. Gallery passages have to be taken in built up area.
- ✓ 8. W.c.s. cannot be allowed as there is no drainage
- ✓ 9. Landing for round stairs be shown.
- ✓ 10. It must be shown how main staircase for out houses is supported.
- ✓ 11. Section through the garage with separate loft plan be given.
- ✓ 12. W.C.s. cannot be permitted as no drainage is laid in this area.

Submitted, the required plans are
 Complied with the plans may please be
 approved
 The plans are returned herewith rejected. Shuz 29/5

Yours faithfully

18-4-34.

Amberali Bhaledino

Land Manager & Architect.



NARAINDAS M. GIDVANI & CO.

ARCHITECTS & ENGINEERS

KARACHI.

478, BUNDER ROAD,

KARACHI, 25th. July 1934.

*BS
me
28/7.*

The Land Manager & Architect,
Karachi Municipality,
Karachi.

Dear Sir,

Re: Plot No.36/6. J.M.3.

We are herewith sending you a tracing cloth copy together with 3 blue prints of the plan of the above plot for favour of your approval.

Yours faithfully,


*N.M. Gidvani**for attached to
27/7/34*

*Submitted to L.M.O.A with the report that the
is no objection to plan as amended. The garage is made 25'-
and the loft 12'-6" x 9'. The design is as personally
agreed by the architect & the owner with you.*


*Man approved
23/7.**SKG**31/7*



Cancelled

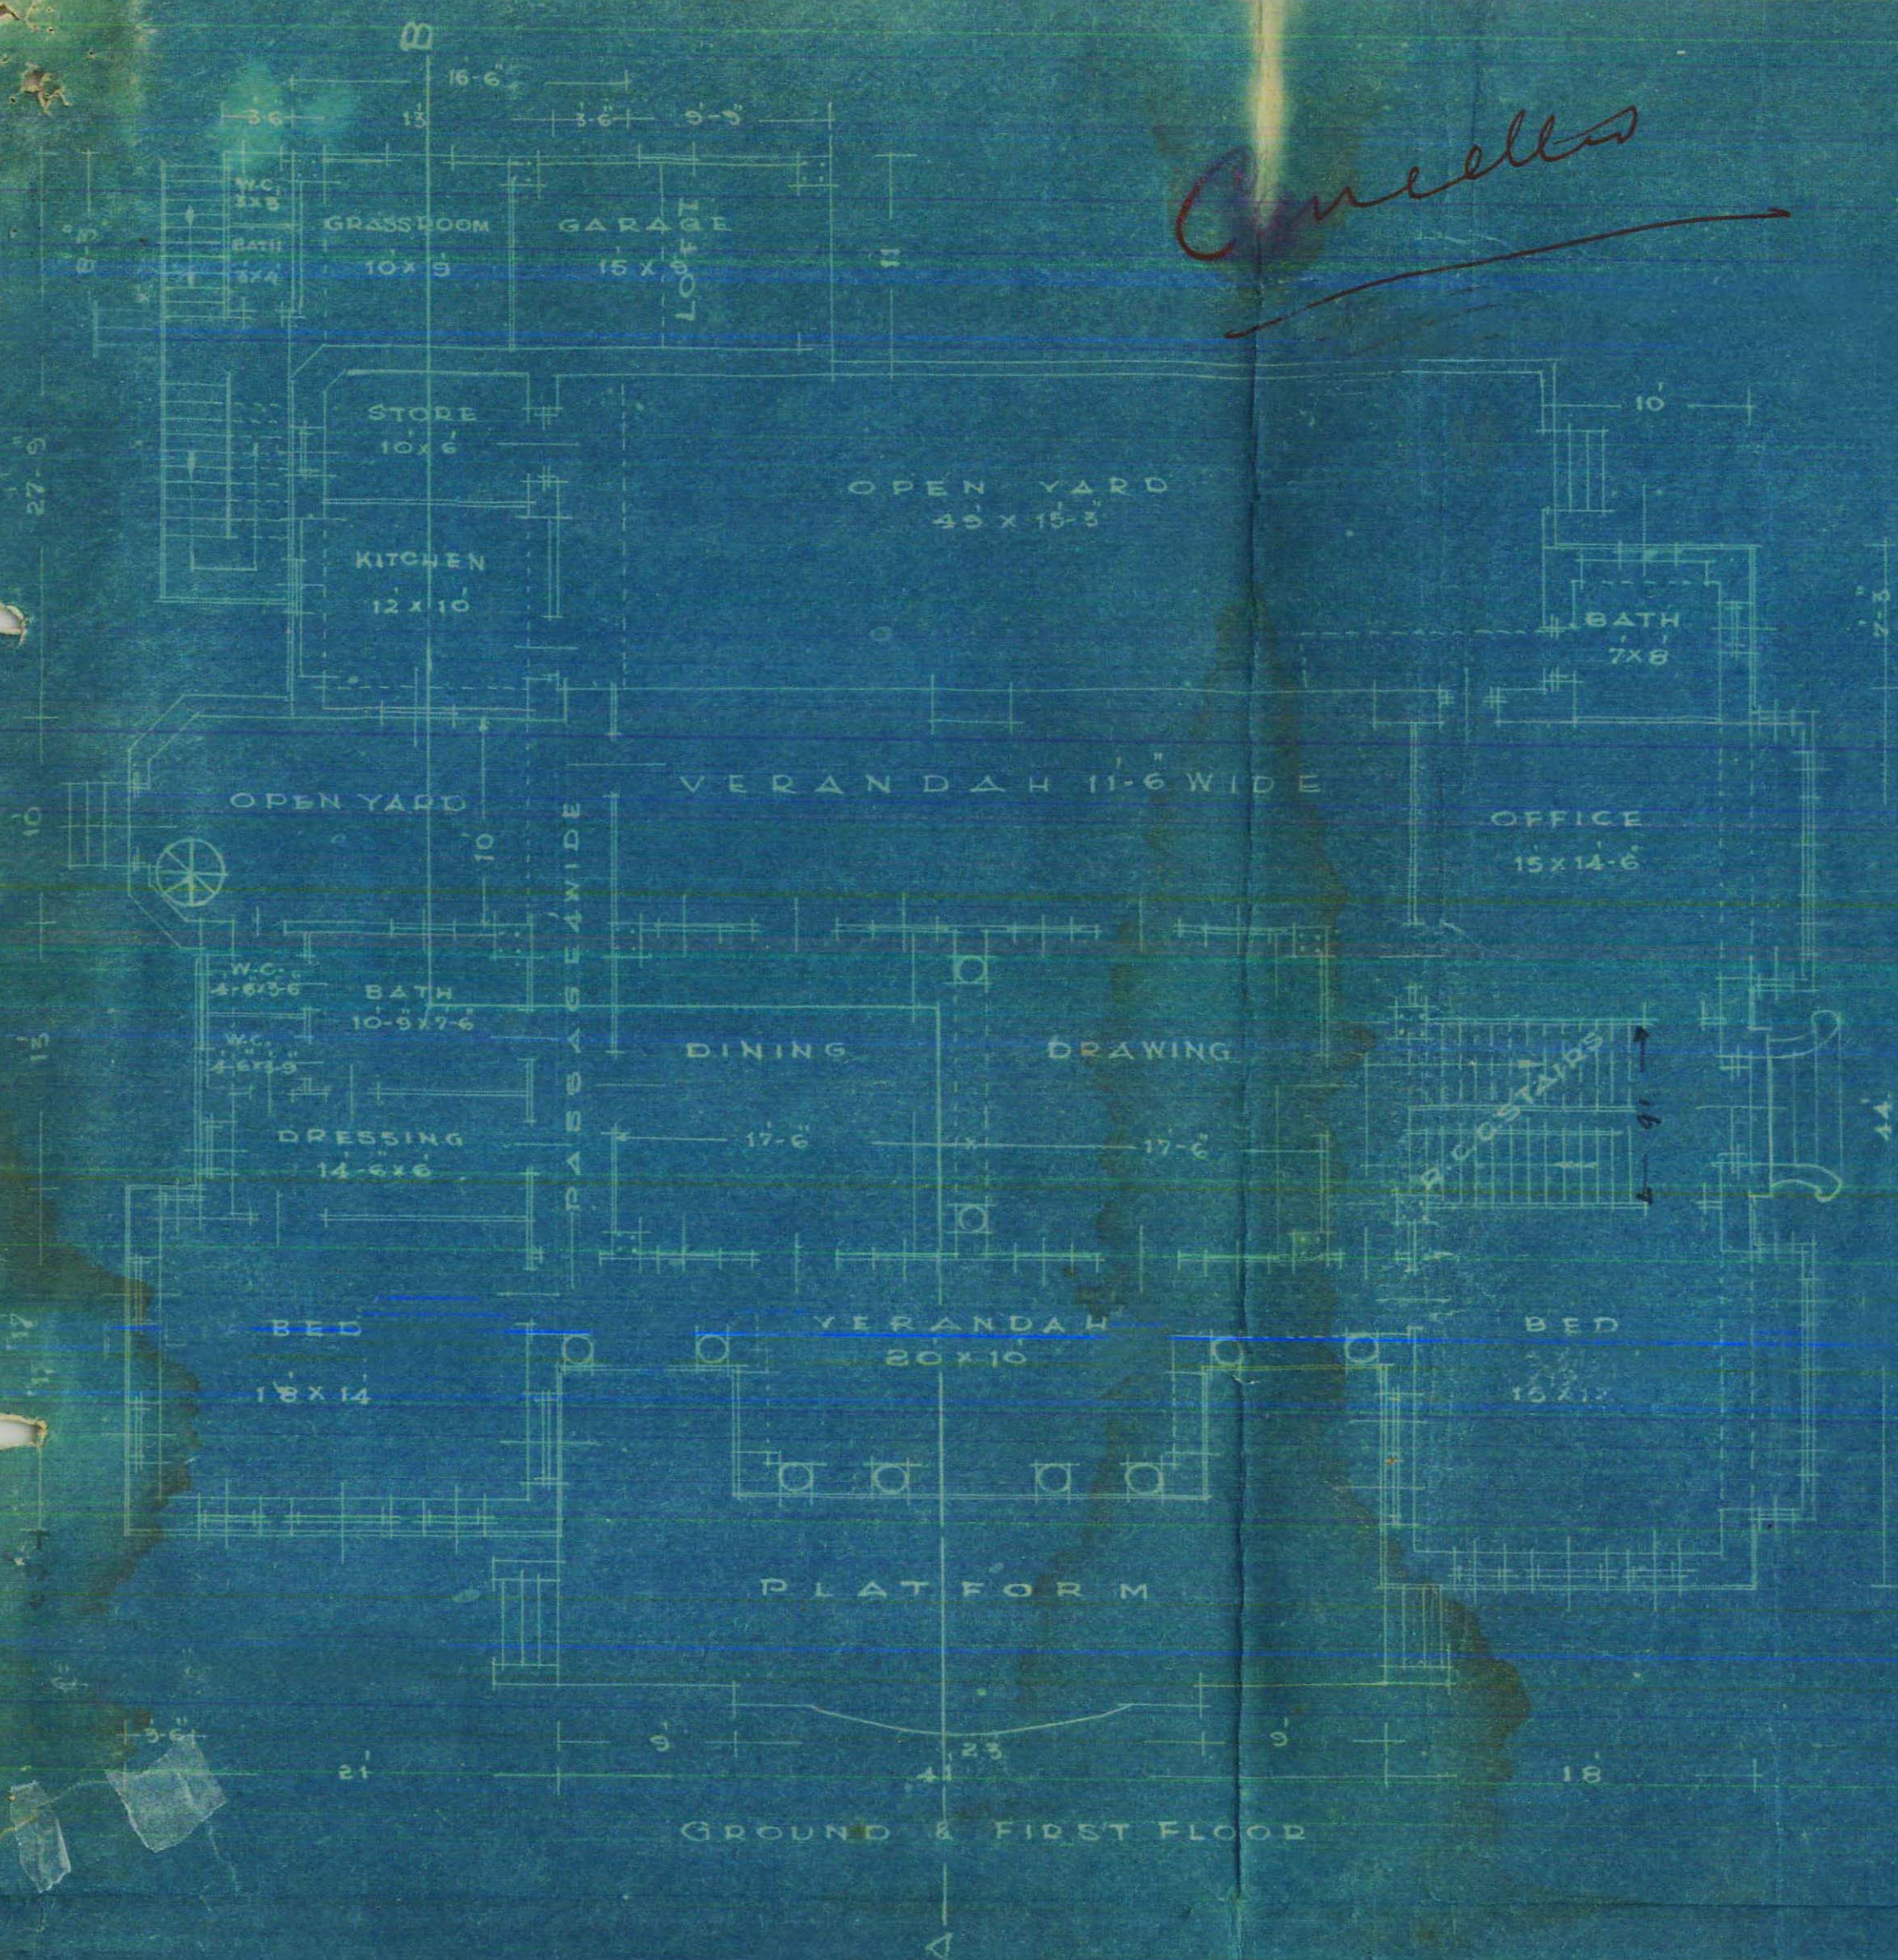

SECTION ON A.E.

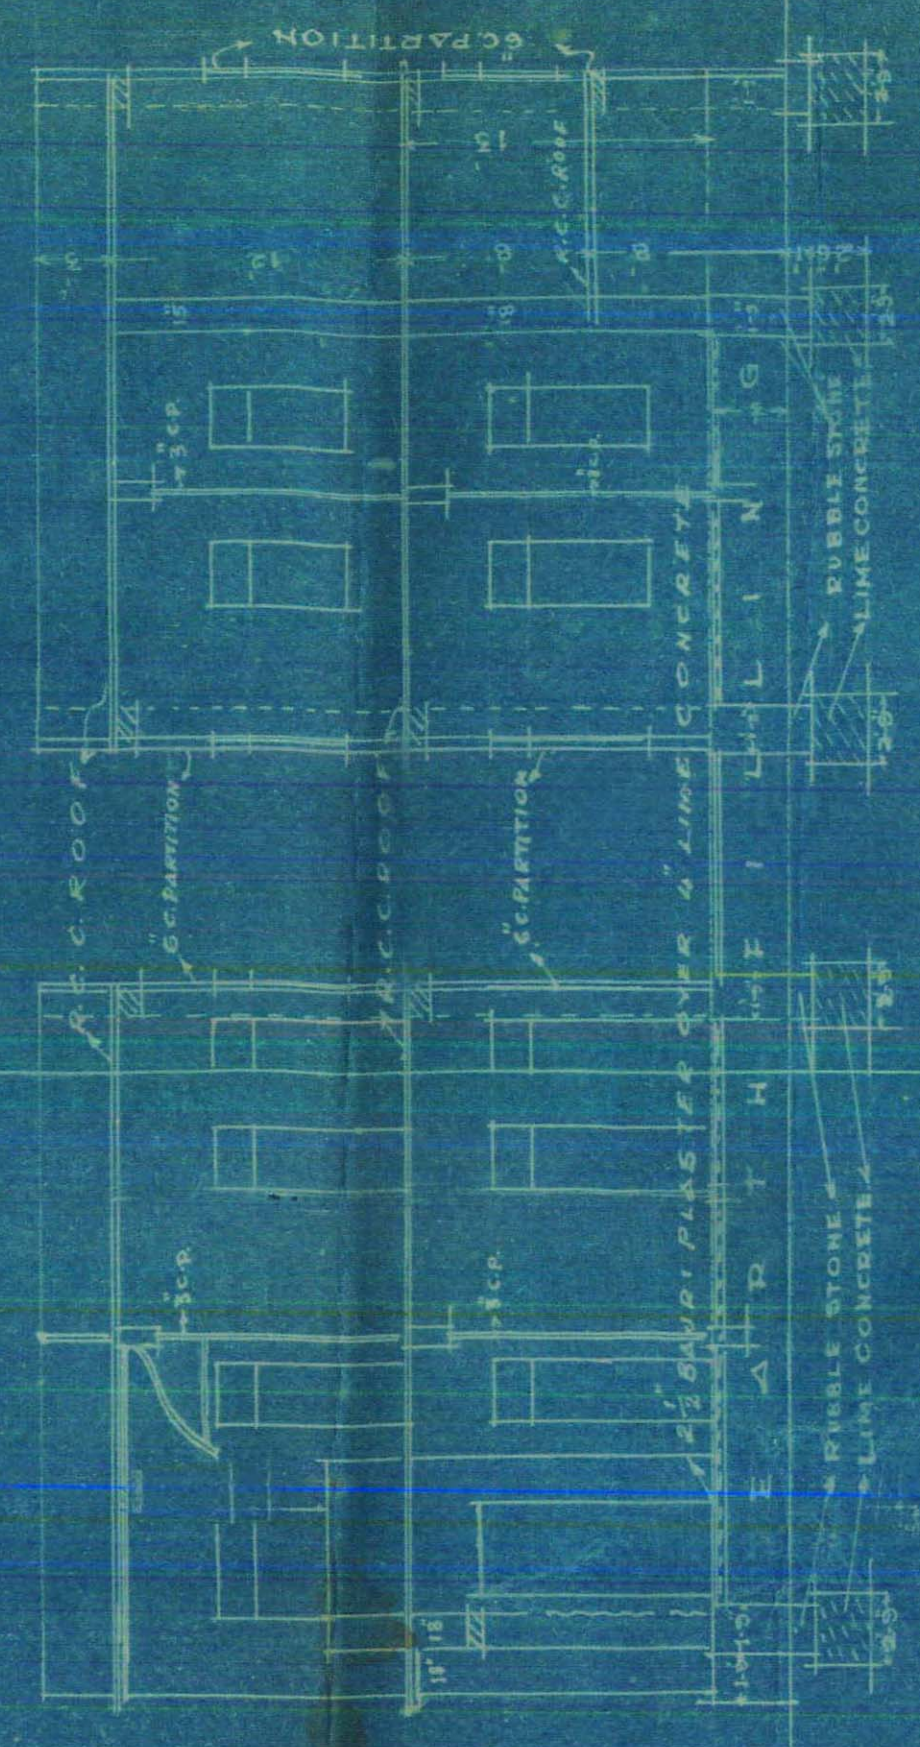


CEMENT LINTELS

SPAN	3-6	TO 4-7	4 RODS 3/8"
"	4-7	TO 5-8	3 RODS 3/8"
"	5-8	TO 6-9	3 RODS 3/8"
"	6-9	TO 7-10	4 RODS 1/2"
"	7-10	TO 8-11	5 RODS 1/2"
"	8-11	TO 9-12	4 RODS 5/8"

TOTAL AREA 1200 Sq. YDS.
BUILT AREA 399 Sq. Yds.


1 x	44	x	18	=	792
1 x	41	x	30-5	=	1619-5
1 x	50	x	21	=	630
1 x	7-25	x	10	=	72-5
1 x	12	x	3	=	36
1 x	27-75	x	16-5	=	457-87
1 x	9-75	x	11	=	107-25
1 x	8-25	x	8-6	=	28-75
1 x	27-75	x	10-0	=	371-25
1 x	15 x 35	=	45-5		
2 x	9 x 6	=	108-0		
			155-5		
					3590-27 ÷ 9 = 399 Sq. Yds.

PLAN
SHOWING PROPOSED BUNGALOW
ON PLOT N^o 36/6. SHEET N^o J.M.3.
FOR
THE HYDERABADI AMIL CO-OPERATIVE
HOUSING SOCIETY
SCALE 8 FT. TO 1 IN.

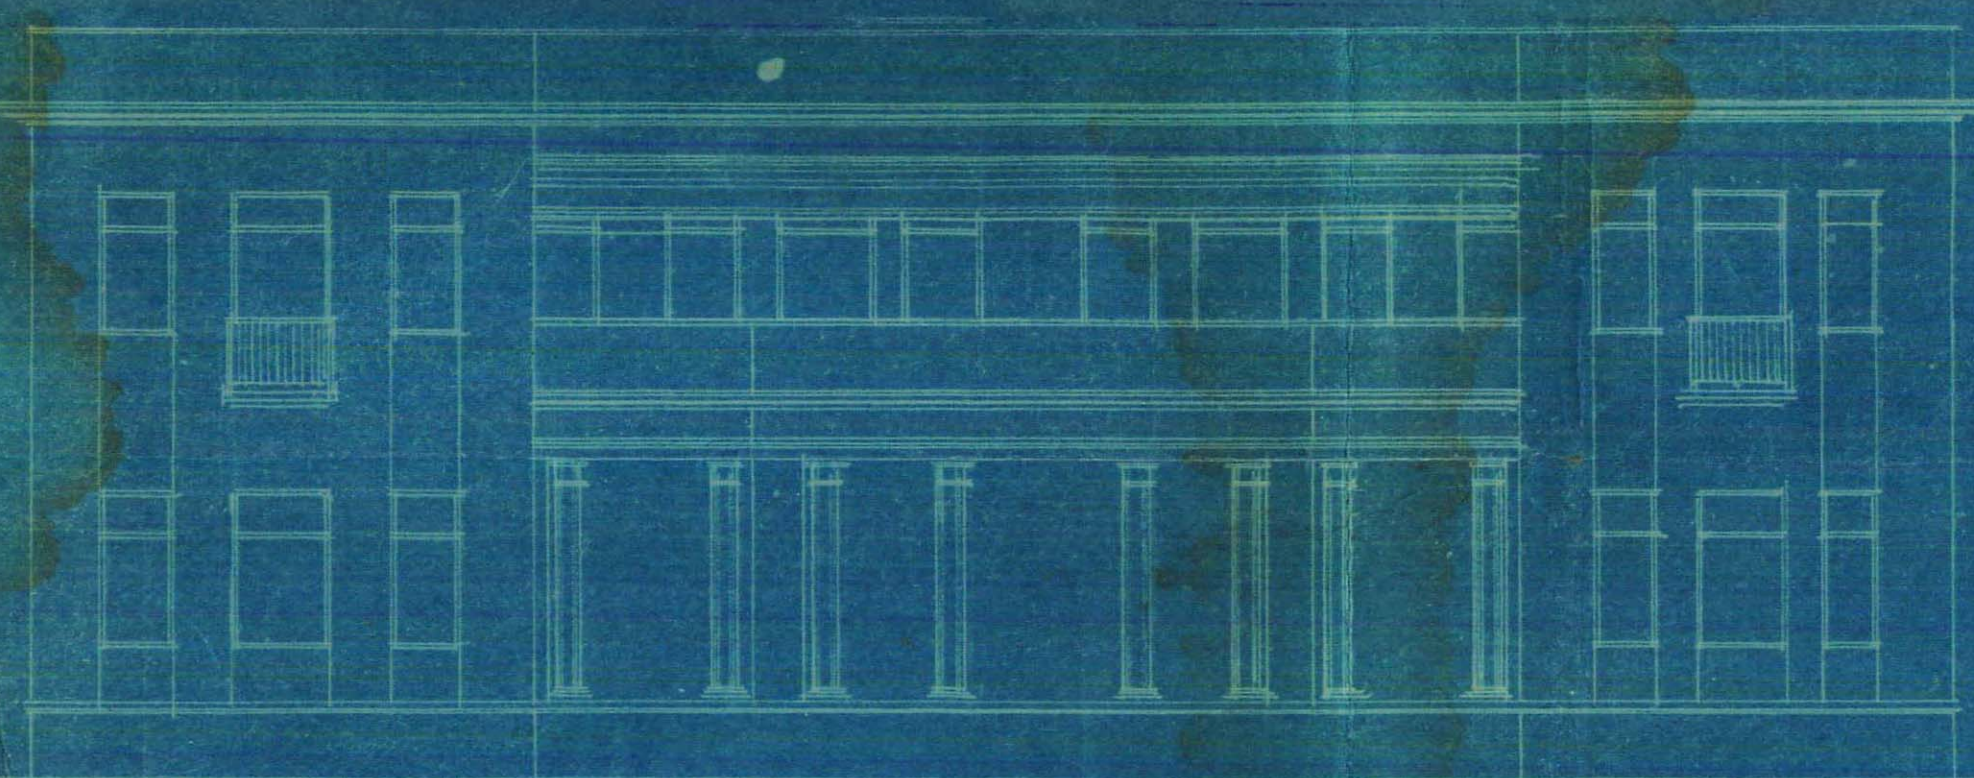

ELEVATION

LONGITUDINAL SECTION OFT. BEAM () CROSS SECTION OFT. BEAM

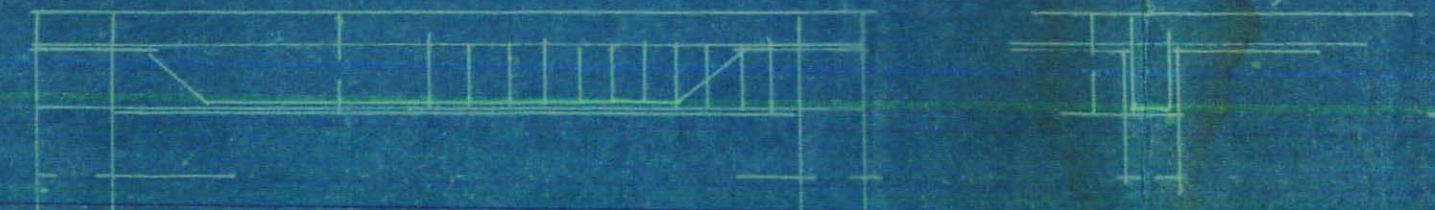


Thammasai Bidunai
LAND LORD

Thammasai Bidunai
HON. SECRETARY,
THE HYDERABADI AMIL CO-OPERATIVE
HOUSING SOCIETY LTD.

N. M. Gidvani & Co.
NARAIN DAS M. GIDVANI & CO.
ARCHITECTS & SURVEYORS,
KARACHI.



BLOCK PLAN
SCALE 20 FT. TO 1 IN.

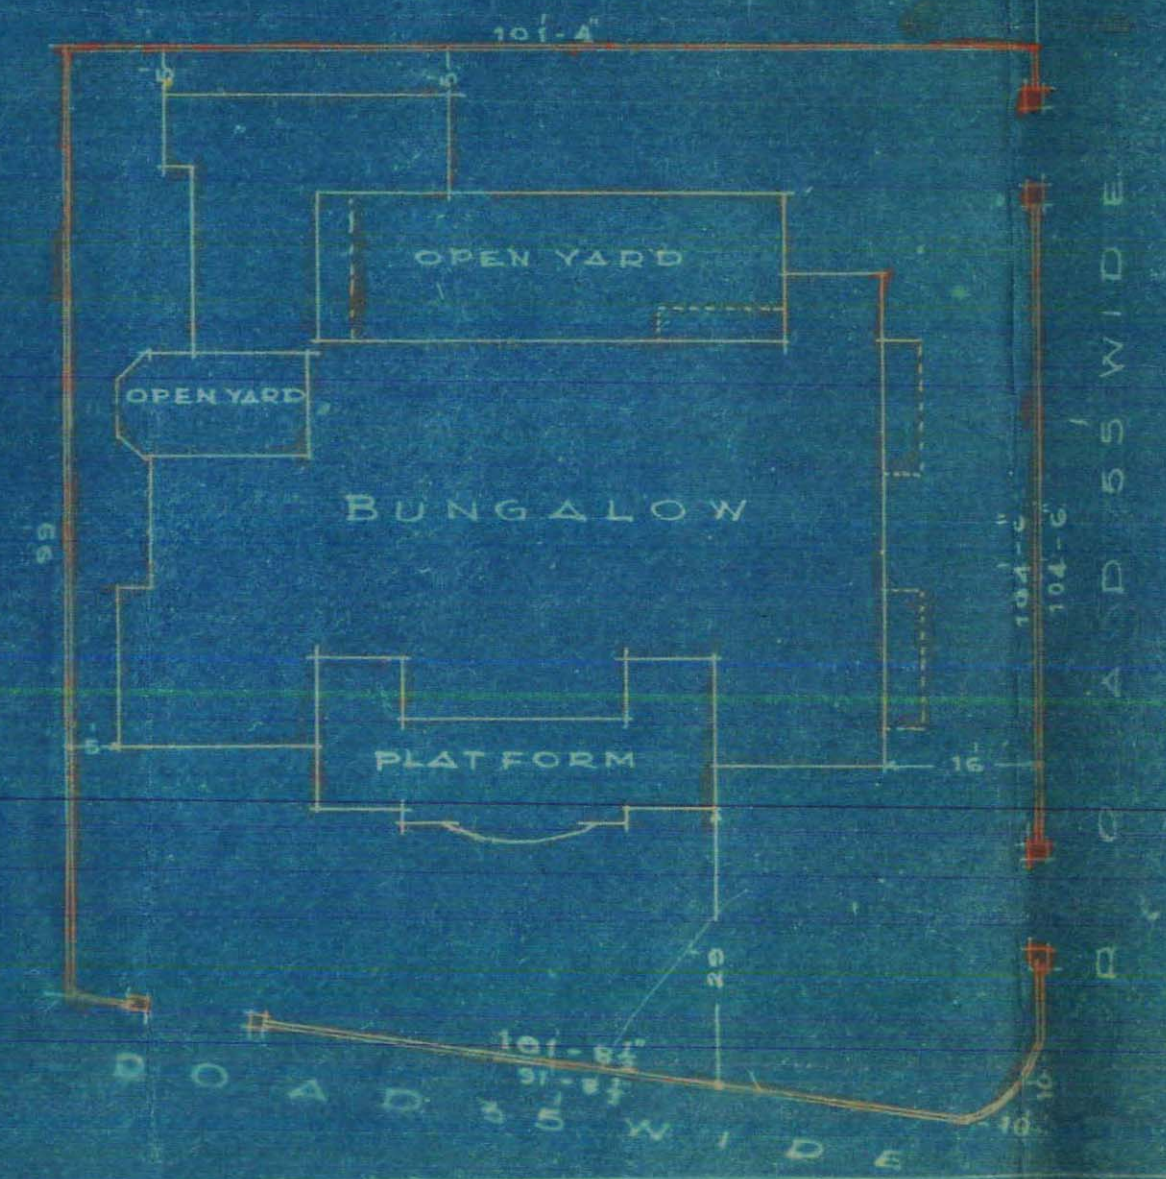



Heritage

KMR.CDD.JmQ.1934.02

NARAIN DAS M. GIDVANI & Co.

ARCHITECTS & ENGINEERS,

478, Bunder Road,



To,

The Land Manager & Architect,
Karachi Municipality,
Karachi .

Dear Sir,

Re: Plot No.36/6.J.M.3.
Jamshed Quarter.

With reference to your letter No.
B.S.P.184/34 dated 19th. April 1934 , we
have the honour to return the plans
herewith duly corrected with all objections
complied with.

The favour of an early permission
is requested.

Yours faithfully,

Karain L. Dalm

Naraindas M. Gidvani & Co.

ARCHITECTS.

BUNDER ROAD, KARACHI.



Heritage

KMR.CDD.JmQ.1934.02

Office Telephone Nos. 1140 & 1141.

Residence " " 199.

KUMBERALI BHALEDINO,
L. C. E.,
LAND MANAGER & ARCHITECT



MUNICIPAL CORPORATION,
KARACHI.

Reference No. B. S. P. 184/34

8 JUN 1934

To,

Mr. N.M. Gidwani, architect

Dear Sir,

With reference to your application dated..... 31-5-34.....
with a plan for the proposed building/additions and alterations on plot
No. 36/6, Survey Sheet No. J.M. 3, Jamshed Quarter
I have to request you to comply with the following requirements:—

1. The copy on cloth now submitted is quite indistinct and require correction.
2. Till this is done the plans could not be approved.

5-6-34

The plans are returned herewith rejected.

Yours faithfully

Kumberali Bhaledino

Land Manager & Architect.

B. s. 24.

1000-1-34

32
7/6

NARAINDAS M. GIDVANI & CO.

ARCHITECTS & ENGINEERS

KARACHI.

Heritage KMR.CDD.JmQ.1934.02

478. BUNDER ROAD,

KARACHI, 20th. June 1934

LAND MANAGER &
ARCHITECT'S DEPTT.
KARACHI MUNICIPALITY

21. JUN 1934

No. 2299

Pls. file
- me
- info.

The Land Manager & Architect,
Karachi Municipality,
Karachi.

Dear Sir,

Re: Plot No. 36/6. J.M.3.

With reference to your letter No. B. S. P.

184/34 dated 8th. June 1934, we have the honour to send

you herewith a tracing cloth copy of the plan of the above
plot, duly ~~complied~~ with all objections. *duly complied with*

An early approval is therefore requested.

Yours faithfully,

N. M. Gidvani

See Mills to M.A.

*for orders. The part of
the construction written*

as first floor is proposed. The copy on cloth

the servants room requires corrections

with 8 ft height. This

the architect has made clear

to say and is continuous with

toft.

217

217

22/6.

*Grass room
must be detached from
the main Bldg & 8' is
too small a height for a
locality like J.M. 3.*