



Heritage

KMR.CDD.JmQ.1934.02 13

Office Telephone Nos. 1140 & 1141.

Residence " " 199.

KUMBERALI BHALEDINO,

L. C. E.,

LAND MANAGER & ARCHITECT

MUNICIPAL CORPORATION,
KARACHI

Reference No. B. S. P. 134/34

To,

Mr. N.M. Gidwani, architect

Dear Sir,

With reference to your application dated...20-6-34.....
with a plan for the proposed building/additions and alterations on plot
No. 36/6, Survey Sheet No. 1.M.3, Jamshed Quarter
I have to request you to comply with the following requirements:—

1. Grass room must be detached from the main building.
2. 8' is too small a height for a ^{room in a} locality like Jamshed or
- ~~3. The copy on plot require correction.~~

4-7-34,

mf 4/7/34

The plans are returned herewith rejected.

Yours faithfully

Lambaree Shreevatsa

Land Manager & Architect.

NARAINDAS M. GIDVANI & Co.

ARCHITECTS & ENGINEERS,



Heritage

KMR.CDD.JmQ.1934.02

478, Bunder Road.

KARACHI. 31st. May 1934.

The Land Manager & Architect,
Karachi Municipality,
Karachi.

Dear Sir,

Re: Plot No. 36/6. J.M.3.

We are herewith sending you
one tracing copy of the plan of the
above plot for favour of your early
approval.

Yours faithfully,

Kanwar Lal Dahi

20

The Lm + A

Kanechi way

1st floor level
~~sh~~ should be the
same as the
main floor.
6.7/7.

Dear Sir,

Re: plot No: 36/6 Tm

With reference to your letter No: B.S.P 184/34 dated 4th instal, we have the honor to state that:-

(1) Grass room has been removed. Instead a room for cycles + Perambulator is provided. Really no grass room is required.

(2) 10' height has now been kept as desired.

The favour of an early permission is therefore requested.

16/7/34 Yrs M
N.M. Firas

Submitted for
order.

The architect
has converted grass
room into a room
for ~~cycles~~ cycles
perambulator which
has no height but
a height of 8 ft.

The height of room on
it which is first floor
is made 10 ft

8/2
16/7



Heritage

KMR.CDD.JmQ.1934.02

16

Office Telephone Nos. 1140 & 1141.
Residence " " 199.
KUMBERALI BHALEDINO,
L. C. E.,
LAND MANAGER & ARCHITECT



**MUNICIPAL CORPORATION,
KARACHI.**

Reference No. B. S. P. 194/34

To,

Mr. N. M. Qidwani 20 JUL 1934

Dear Sir,

Architect, Karachi

With reference to your application dated 16th July 1934...
with a plan for the proposed building/additions and alterations on plot
No. 36/6, Survey Sheet No. Jan-3, Janabhed Quarter
I have to request you to comply with the following requirements:—

1. The roof of 1st floor level should be the same as the main building.
2. The work must be stopped till the plans are got approved

The plans are returned herewith rejected.

Yours faithfully


Kumberali Bhaledino

Land Manager & Architect.


22
19/7



Cellar

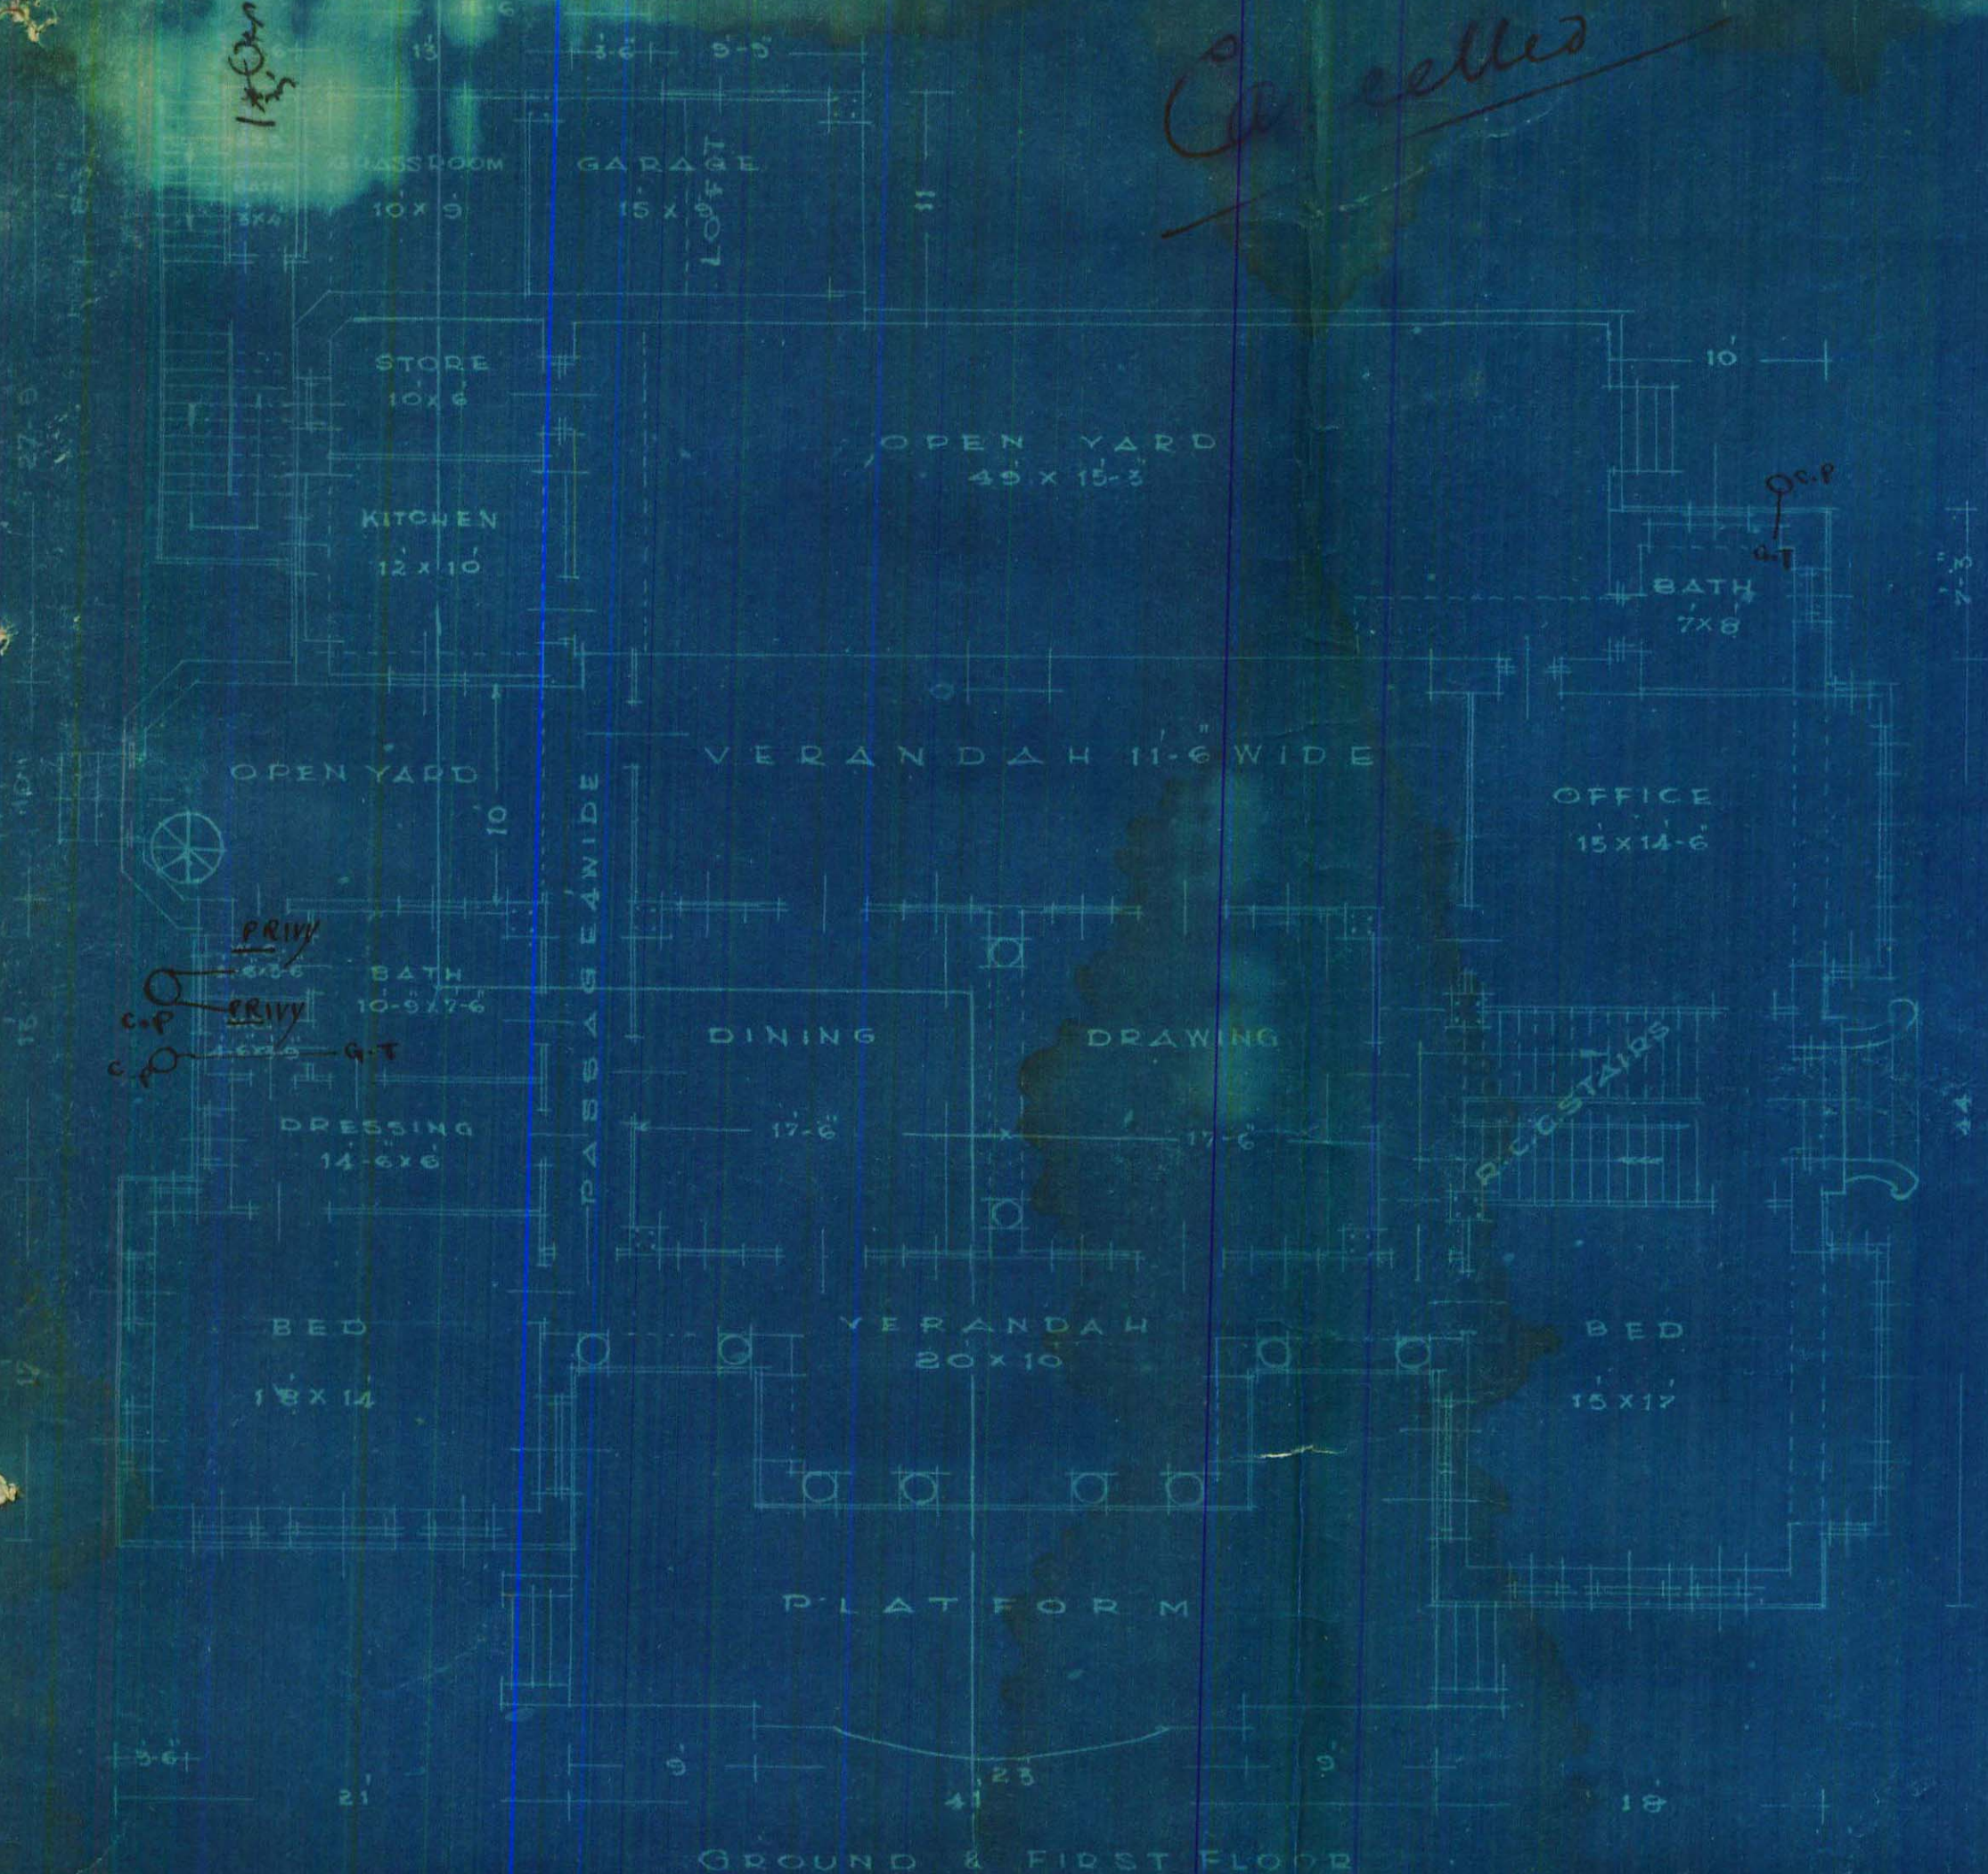

SECTION ON A.B.

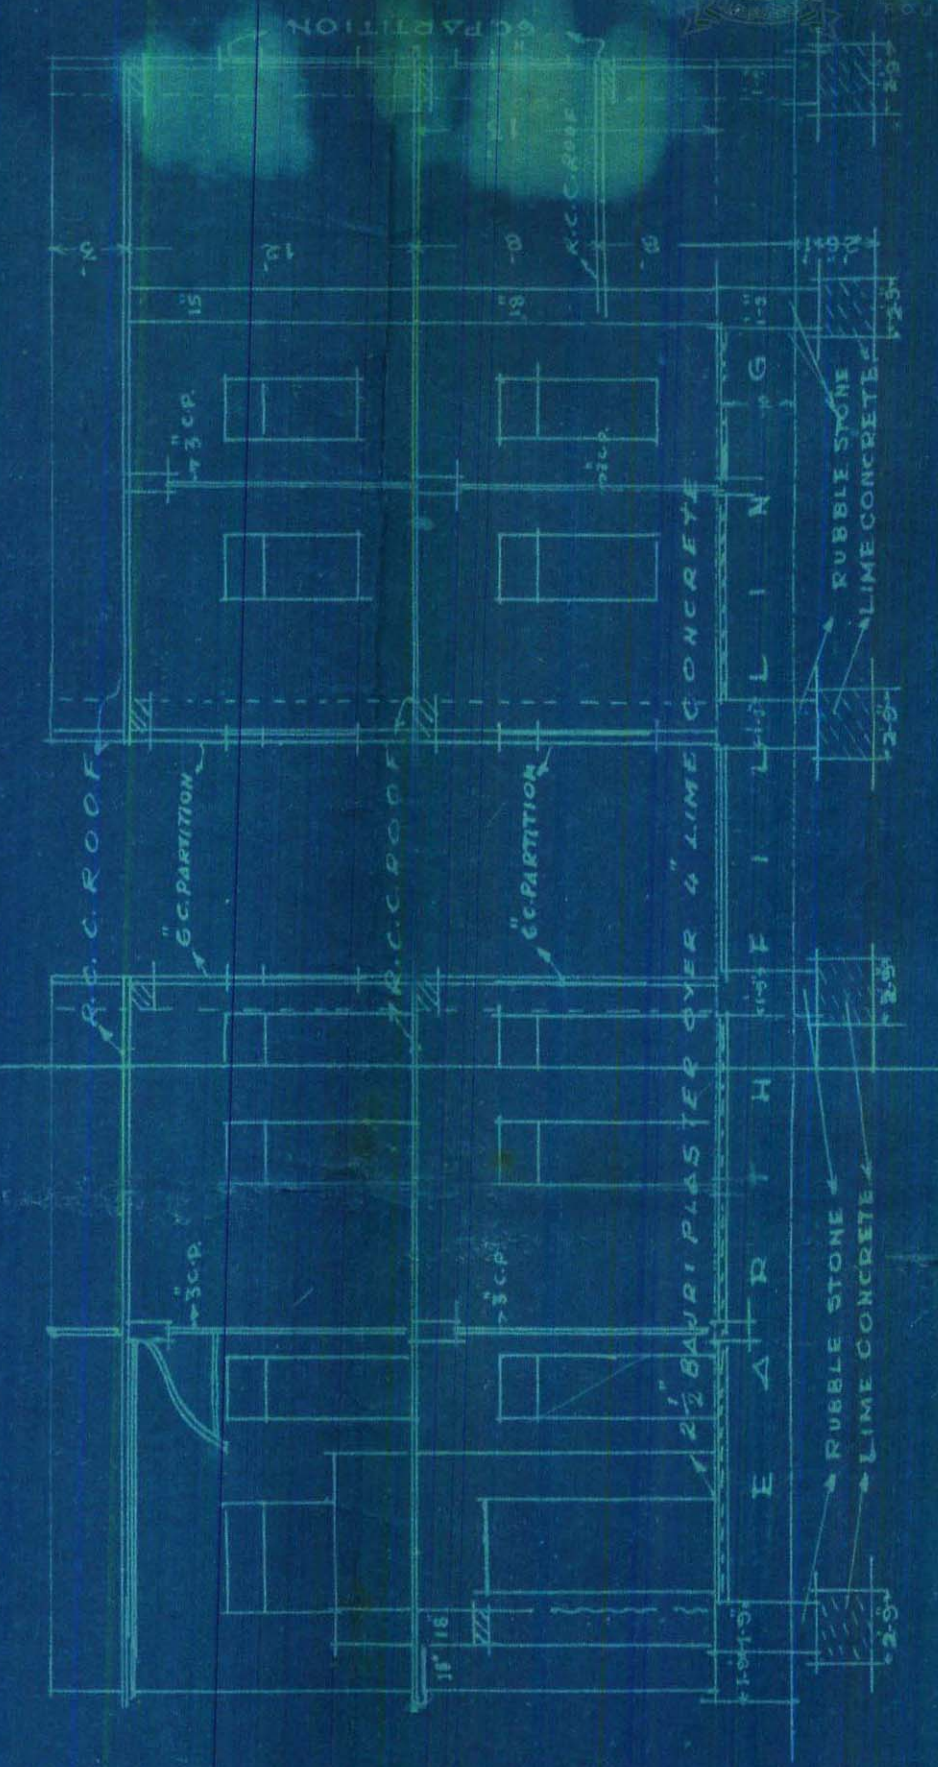



CEMENT LINTELS	
SPAN 5'-6"	To 4 = 7 4 Rods 3/4"
2'-6"	To 3'-6" = 5 Rods 3/4"
1'-6"	To 2'-5" = 3 Rods 3/4"
4'-6"	To 5'-0" = 4 Rods 1/2"
6'-6"	To 6'-10" = 5 Rods 1/2"
6'-6"	To 7'-11" = 5 Rods 1/4"
7'-6"	To 8'-12" = 4 Rods 3/4"

TOTAL AREA	1200 Sq. Yds.
BUILT AREA	399 Sq. Yds.
1 x 44	x 18 = 792
1 x 41	x 39.5 = 1619.5
1 x 30	x 21 = 630
1 x 7.25	x 10 = 72.5
1 x 12	x 3 = 36
1 x 27.75	x 16.5 = 457.87
1 x 9.75	x 11 = 107.25
1 x 8.25	x 3.5 = 28.75
	3743.87
DEDUCT	153.5
1 x 15 x 3.5	= 45.5
2 x 9 x 6	= 108.0
	153.5
	3590.27
	3590.27 ÷ 9 = 399 Sq. Yds.

PLAN
SHOWING PROPOSED BUNGALOW
ON PLOT No 36/6. SHEET No J.M.3.
FOR
THE HYDERABADI AMIL CO-OPERATIVE
HOUSING SOCIETY
SCALE 8 FT. TO 1 IN.




BLOCK PLAN
SCALE 20 FT. TO 1 IN.

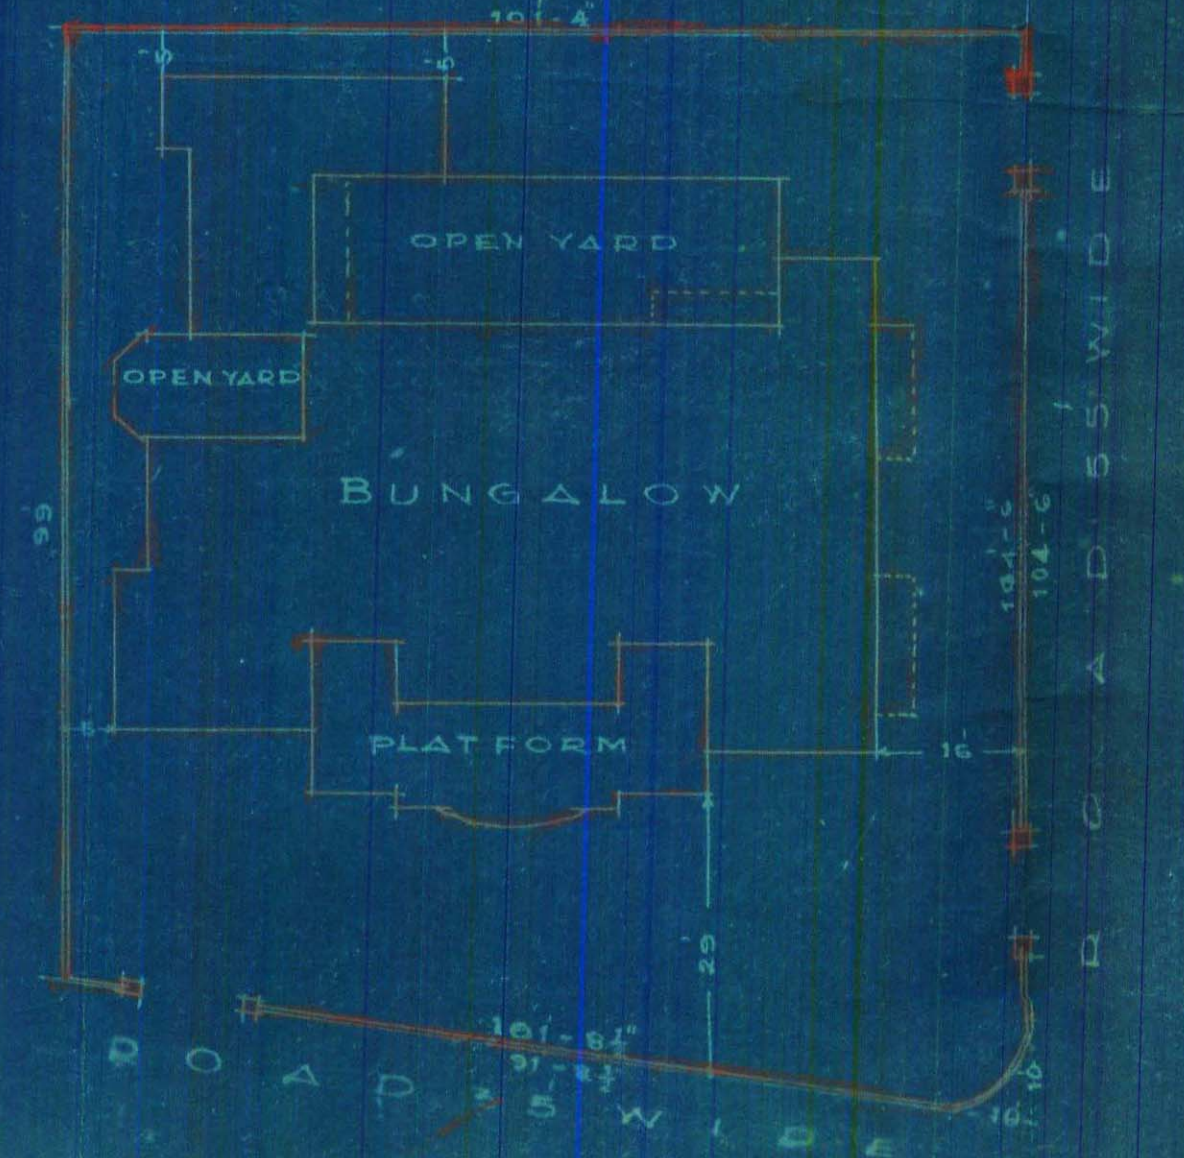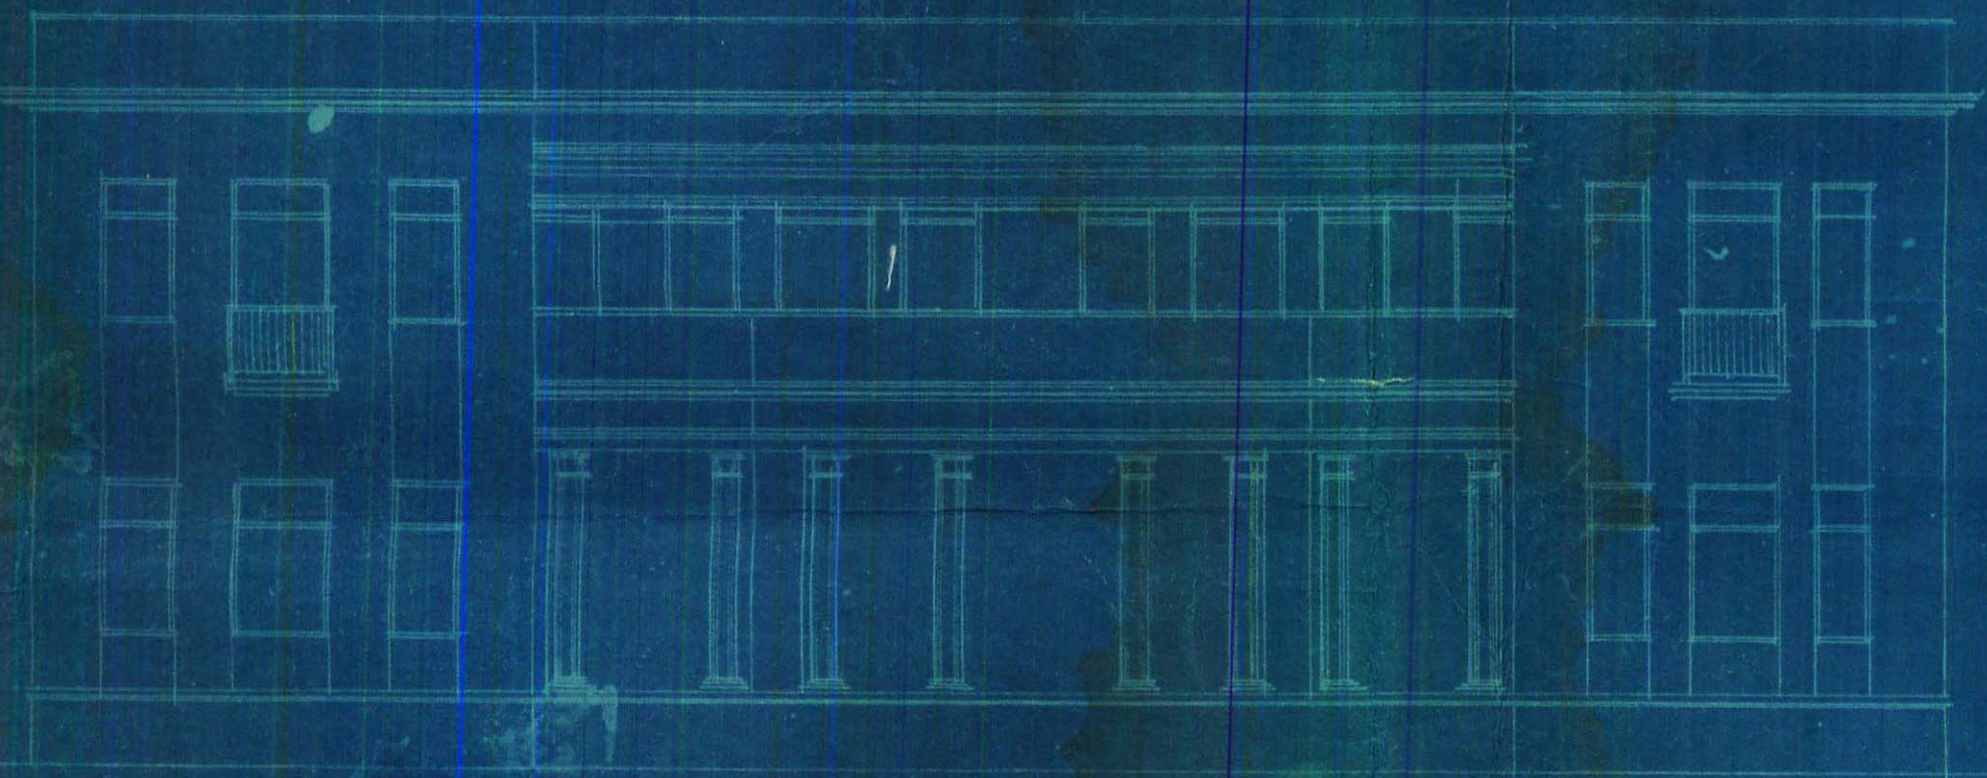

ELEVATION

LONGITUDINAL SECTION OF T. BEAM () CROSS SECTION OF T. BEAM ()

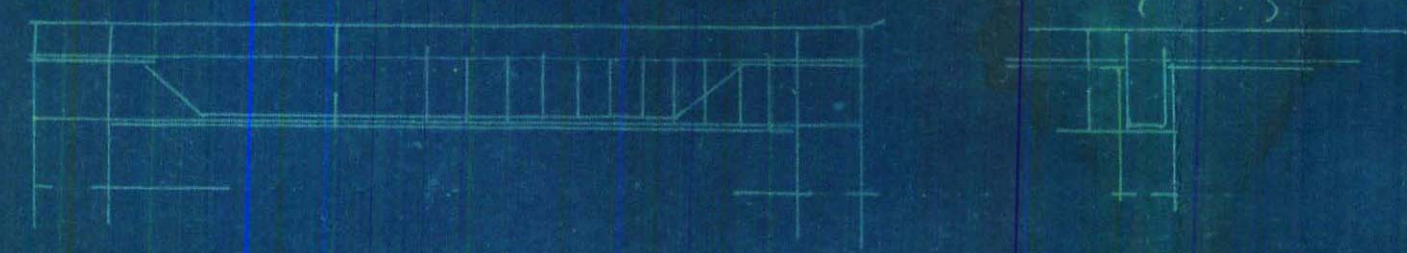

Tharimal Bilaran
LAND LORD



Jhannai Sidmal
HON. SECRETARY,
THE HYDERABADI AMIL CO-OPERATIVE
HOUSING SOCIETY LTD.

N. K. Girani
NARAIN DAS M. GIDVANI & CO.,
ARCHITECTS & SURVEYORS,
KARACHI.

CEMENT LINTELS

SPAN	3'-6"	To 4' =	7 4 RODS $3/8$
"	2'-6"	To 3' =	3 RODS $3/8$
"	1'-6"	To 2' =	3 RODS $3/8$
"	4'-6"	To 5' =	5 4 RODS $1/2$
"	5'-6"	To 6' =	10 5 RODS $1/2$
"	6'-6"	To 7' =	11 5 RODS $1/2$
"	7'-6"	To 8' =	12 4 RODS $5/8$

BLOCK PLAN
SCALE 20 FT. TO 1 IN.

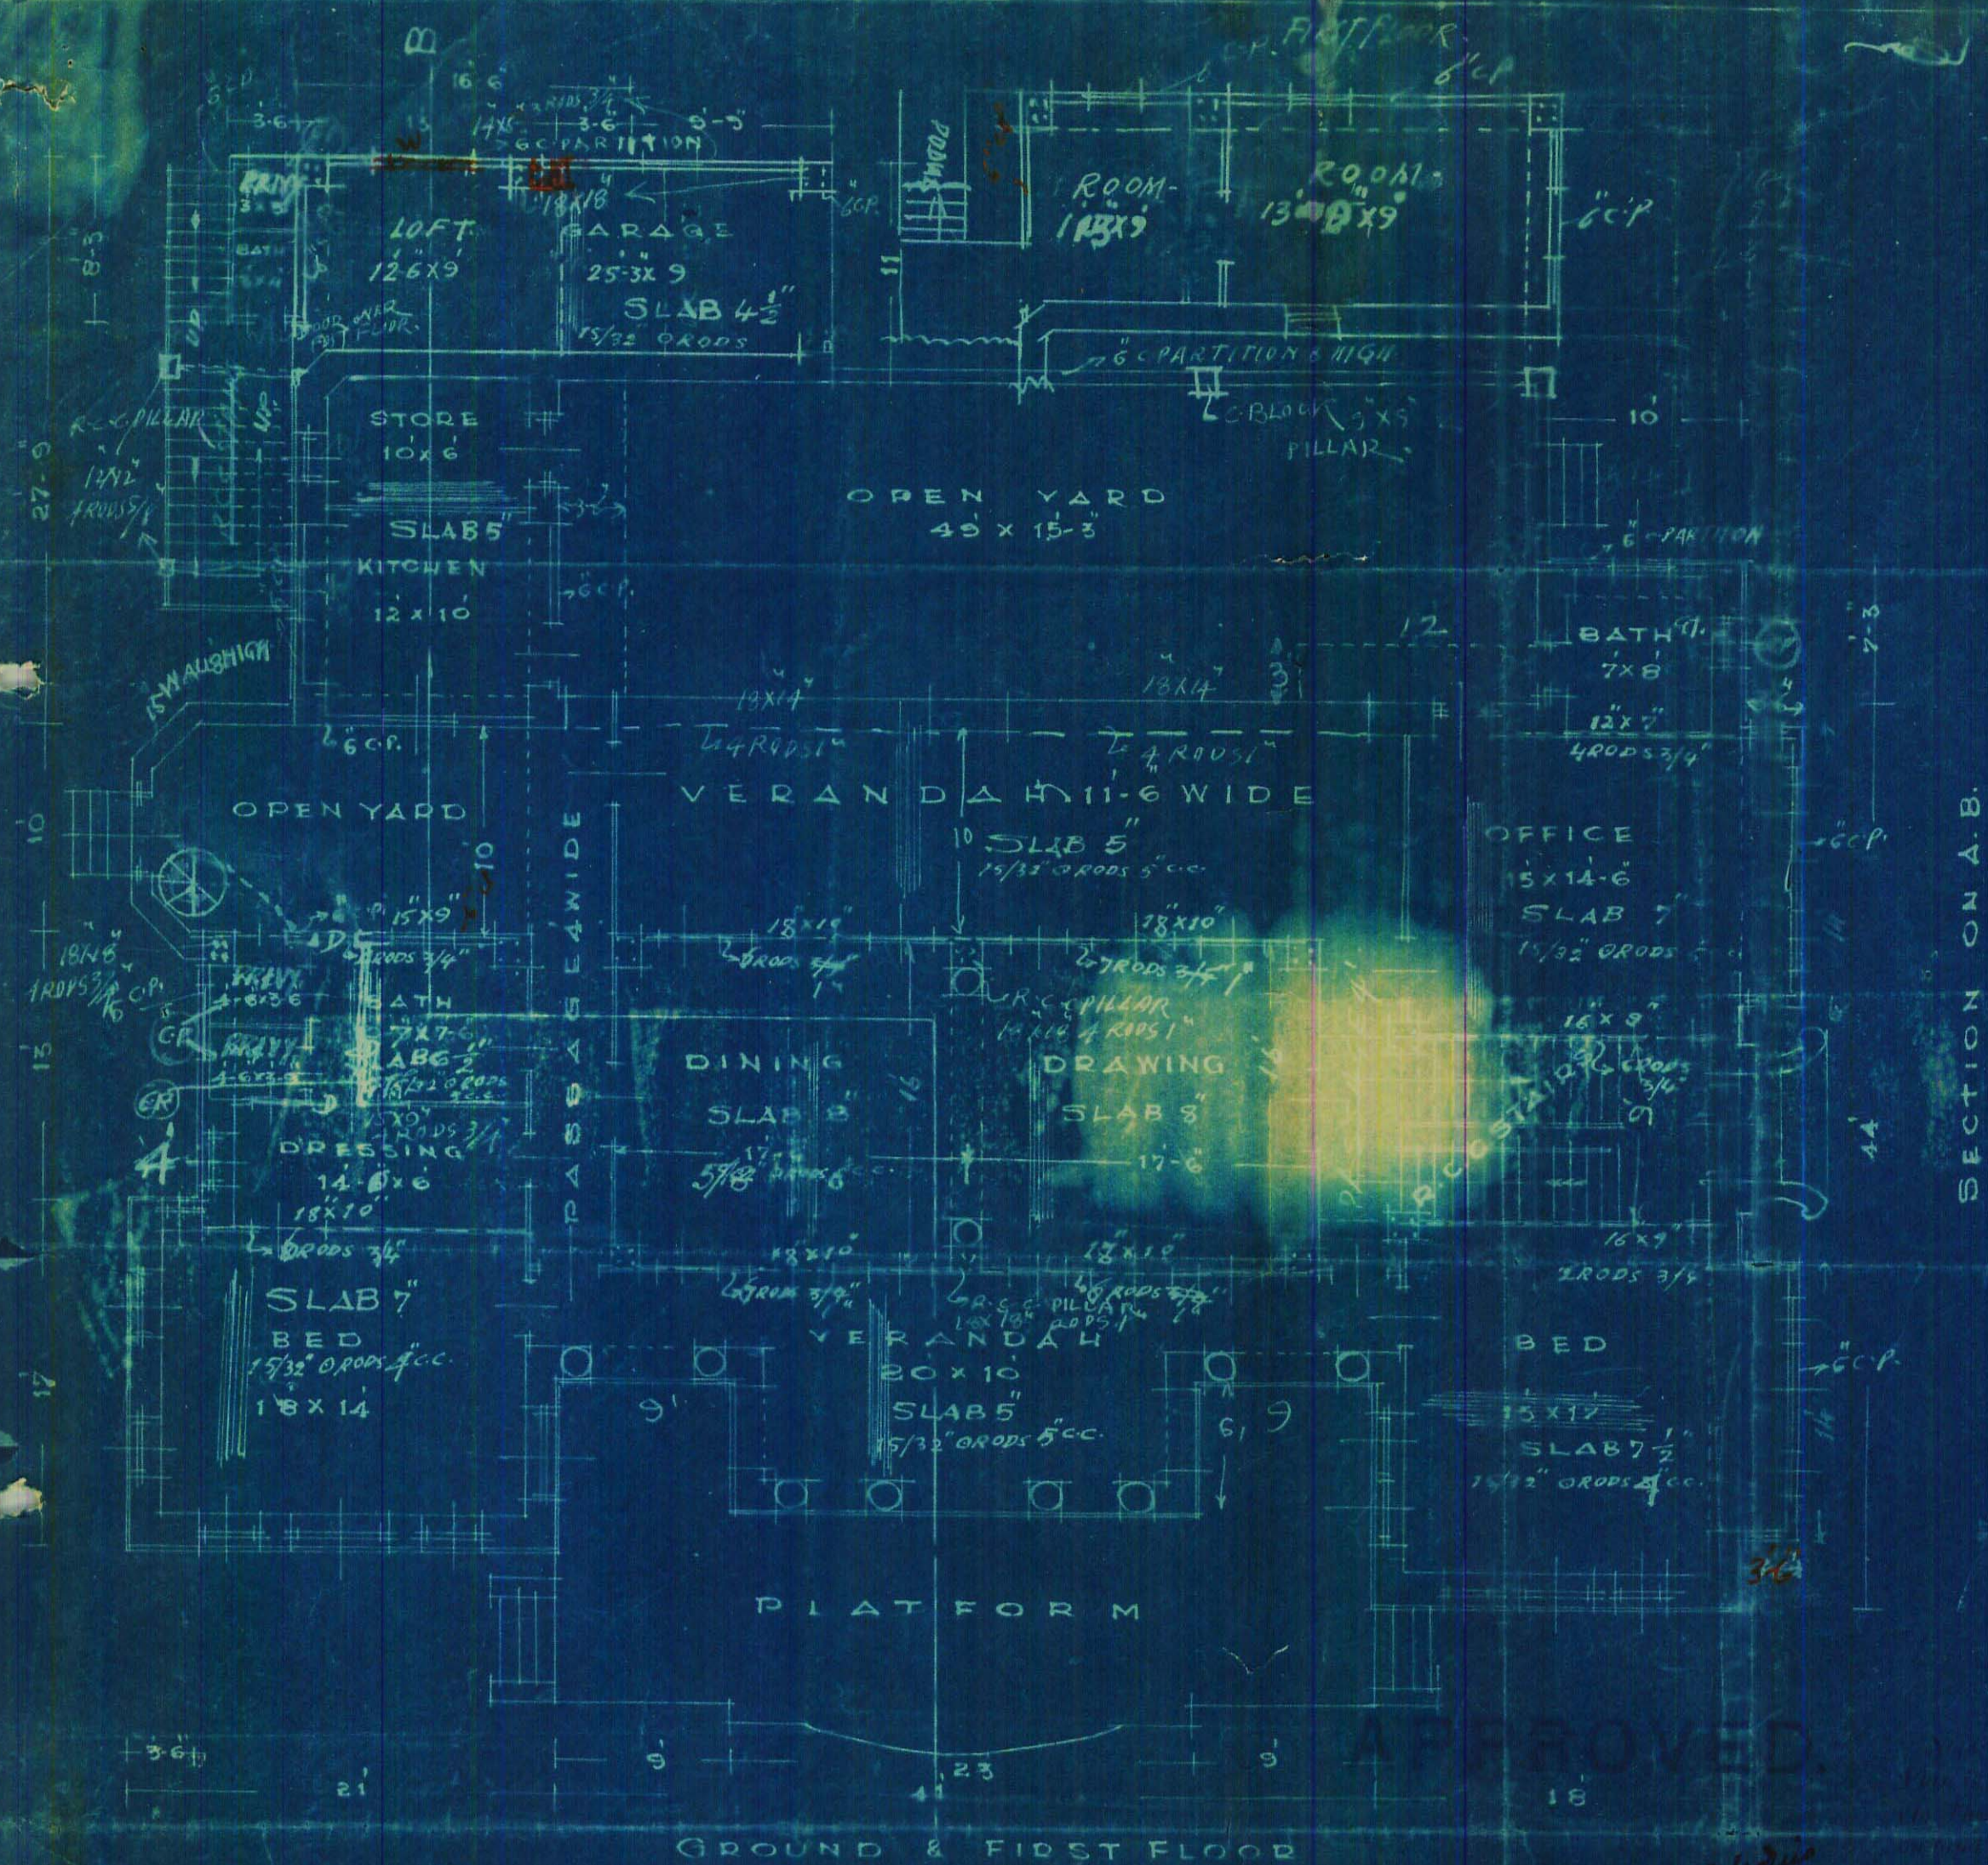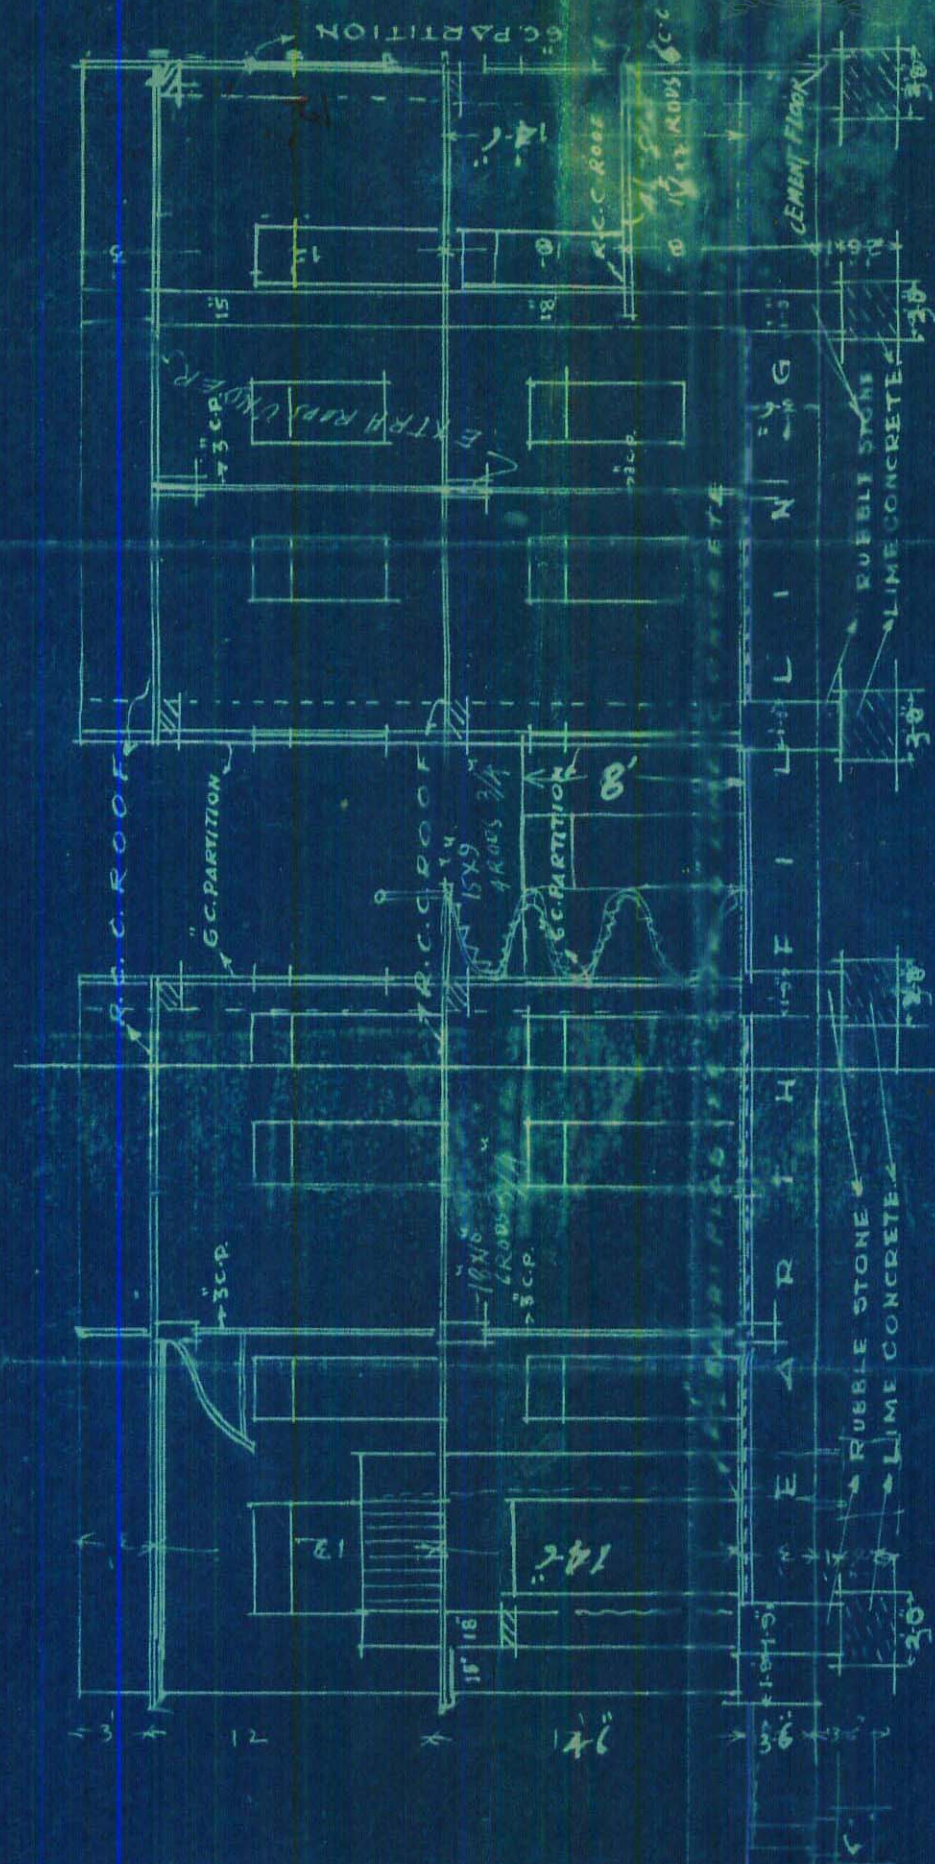

CEMENT LINTELS

SPAN 5-6	TO 4-7	4 RODS 3/8"
5-6	TO 3-4	3 RODS 3/8"
4-5	TO 2-3	3 RODS 3/8"
3-4	TO 2-3	3 RODS 3/8"
2-3	TO 1-2	3 RODS 3/8"
1-2	TO 0-1	3 RODS 3/8"
0-1	TO 0-1	3 RODS 3/8"

TOTAL AREA 1200 SQ. YDS.

BUILT AREA 358.22 SQ. YDS.

A	1 x 44	x 18	=	792
B	1 x 41	x 39.5	=	1619.5
C	1 x 30	x 21	=	630
D	1 x 7.25	x 10	=	72.5
E	1 x 12	x 3	=	36
F	1 x 27.75	x 16.5	=	457.87
G	1 x 9.75	x 11	=	107.25
H	1 x 8.25	x 3.5	=	28.87
				374.39


DEDUCT

1 x 15	x 4	=	60
2 x 9 x 6	=	108.0	
		168.0	

358.22 - 168.0 = 190.22 SQ. YDS.

PLAN
SHOWING PROPOSED BUNGALOW
ON PLOT No 36/6. SHEET No J.M.3.
FOR
THE HYDERABADI AMIL CO-OPERATIVE
HOUSING SOCIETY

SCALE 1/8" = 1'-0"

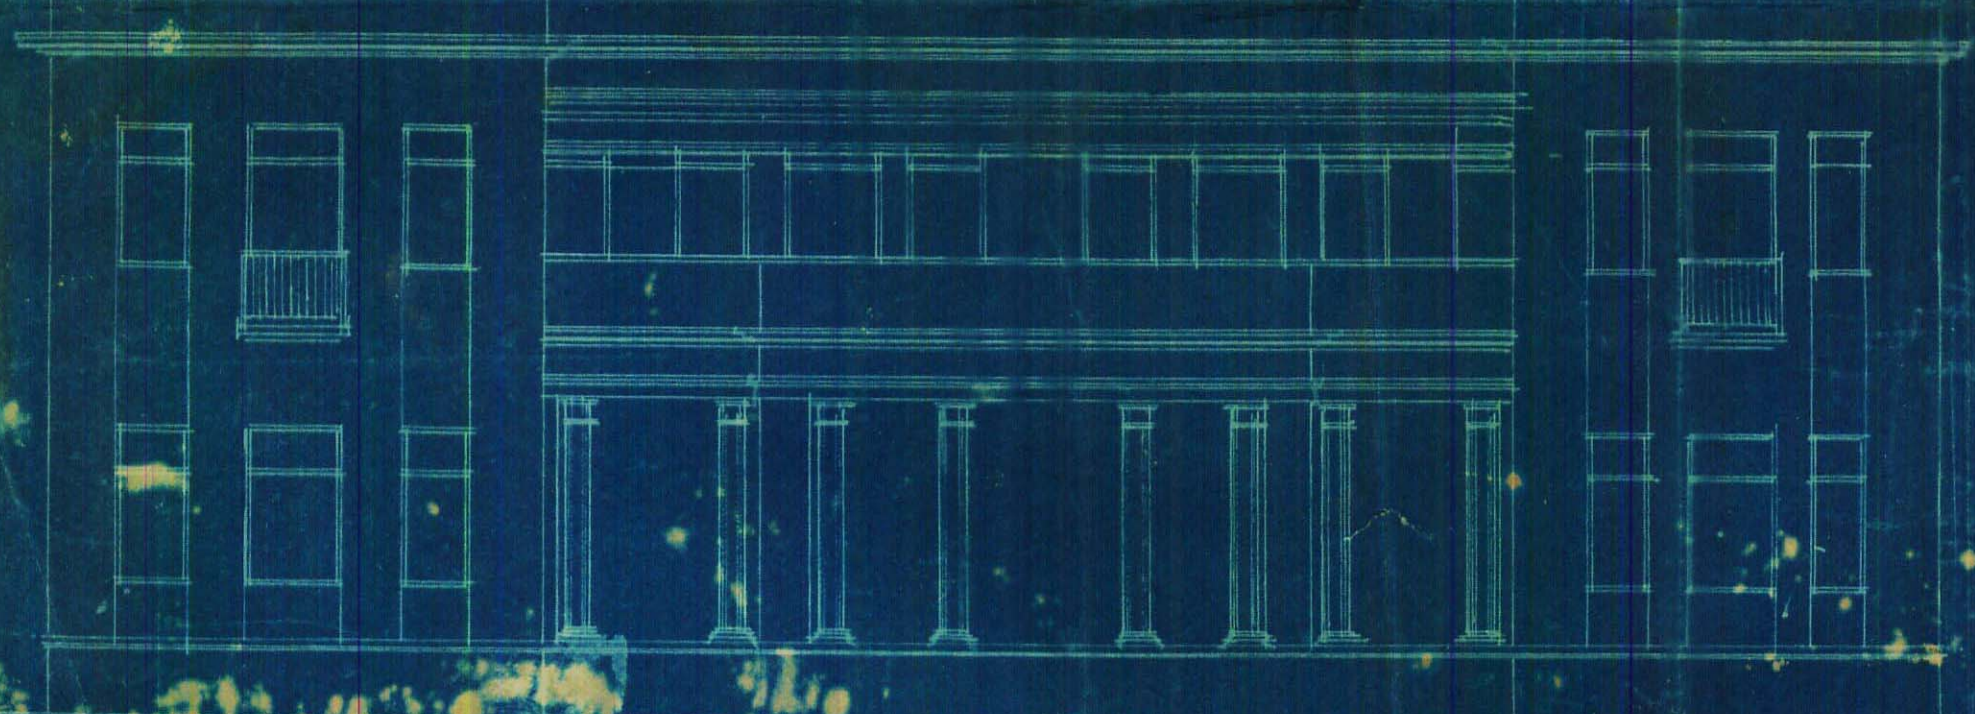


ELEVATION




BLOCK PLAN

SCALE 20 FT. TO 1 IN.

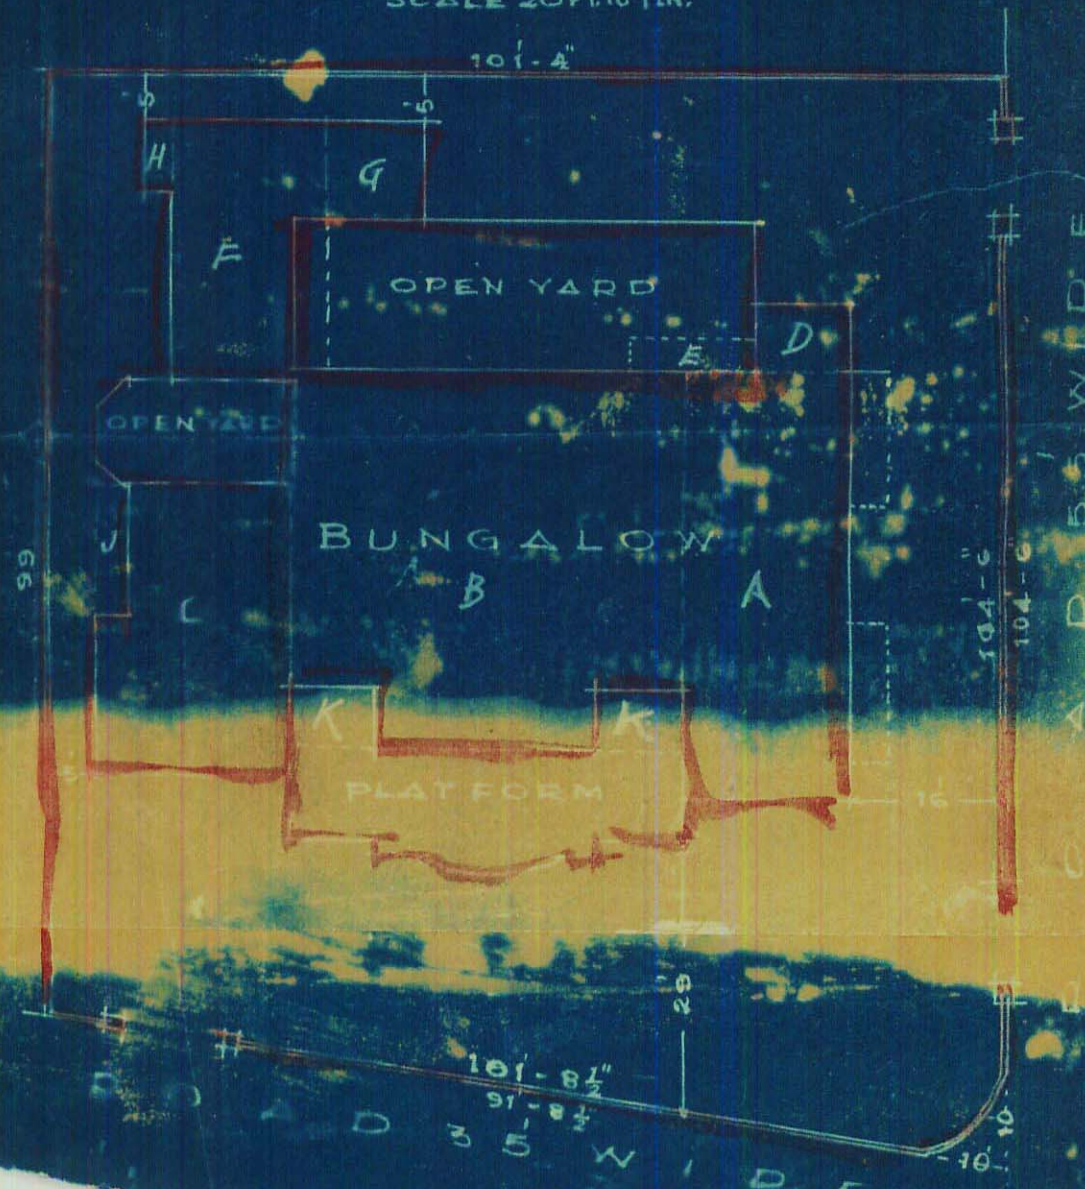


LONGITUDINAL SECTION OFF BEAM () CROSS SECTION OFF BEAM ()

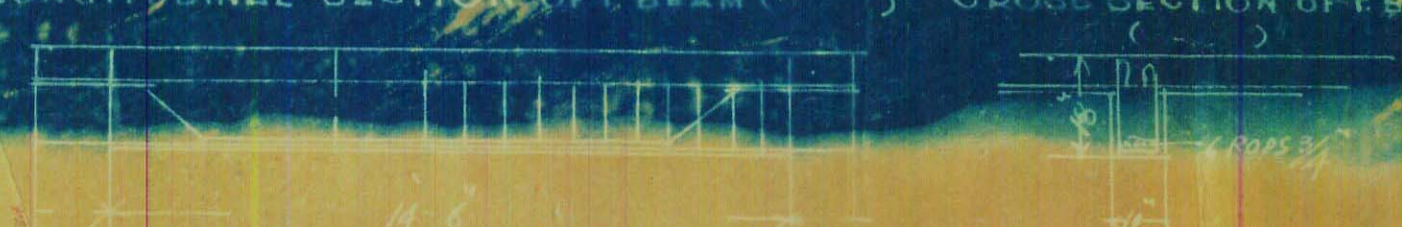


Tharawal Bilaran
LAND LORD

THE HYDERABADI AMIL CO-OPERATIVE
HOUSING SOCIETY

NARAYAN M. GILVARI & CO.
ARCHITECTS & SURVEYORS
KARACHI

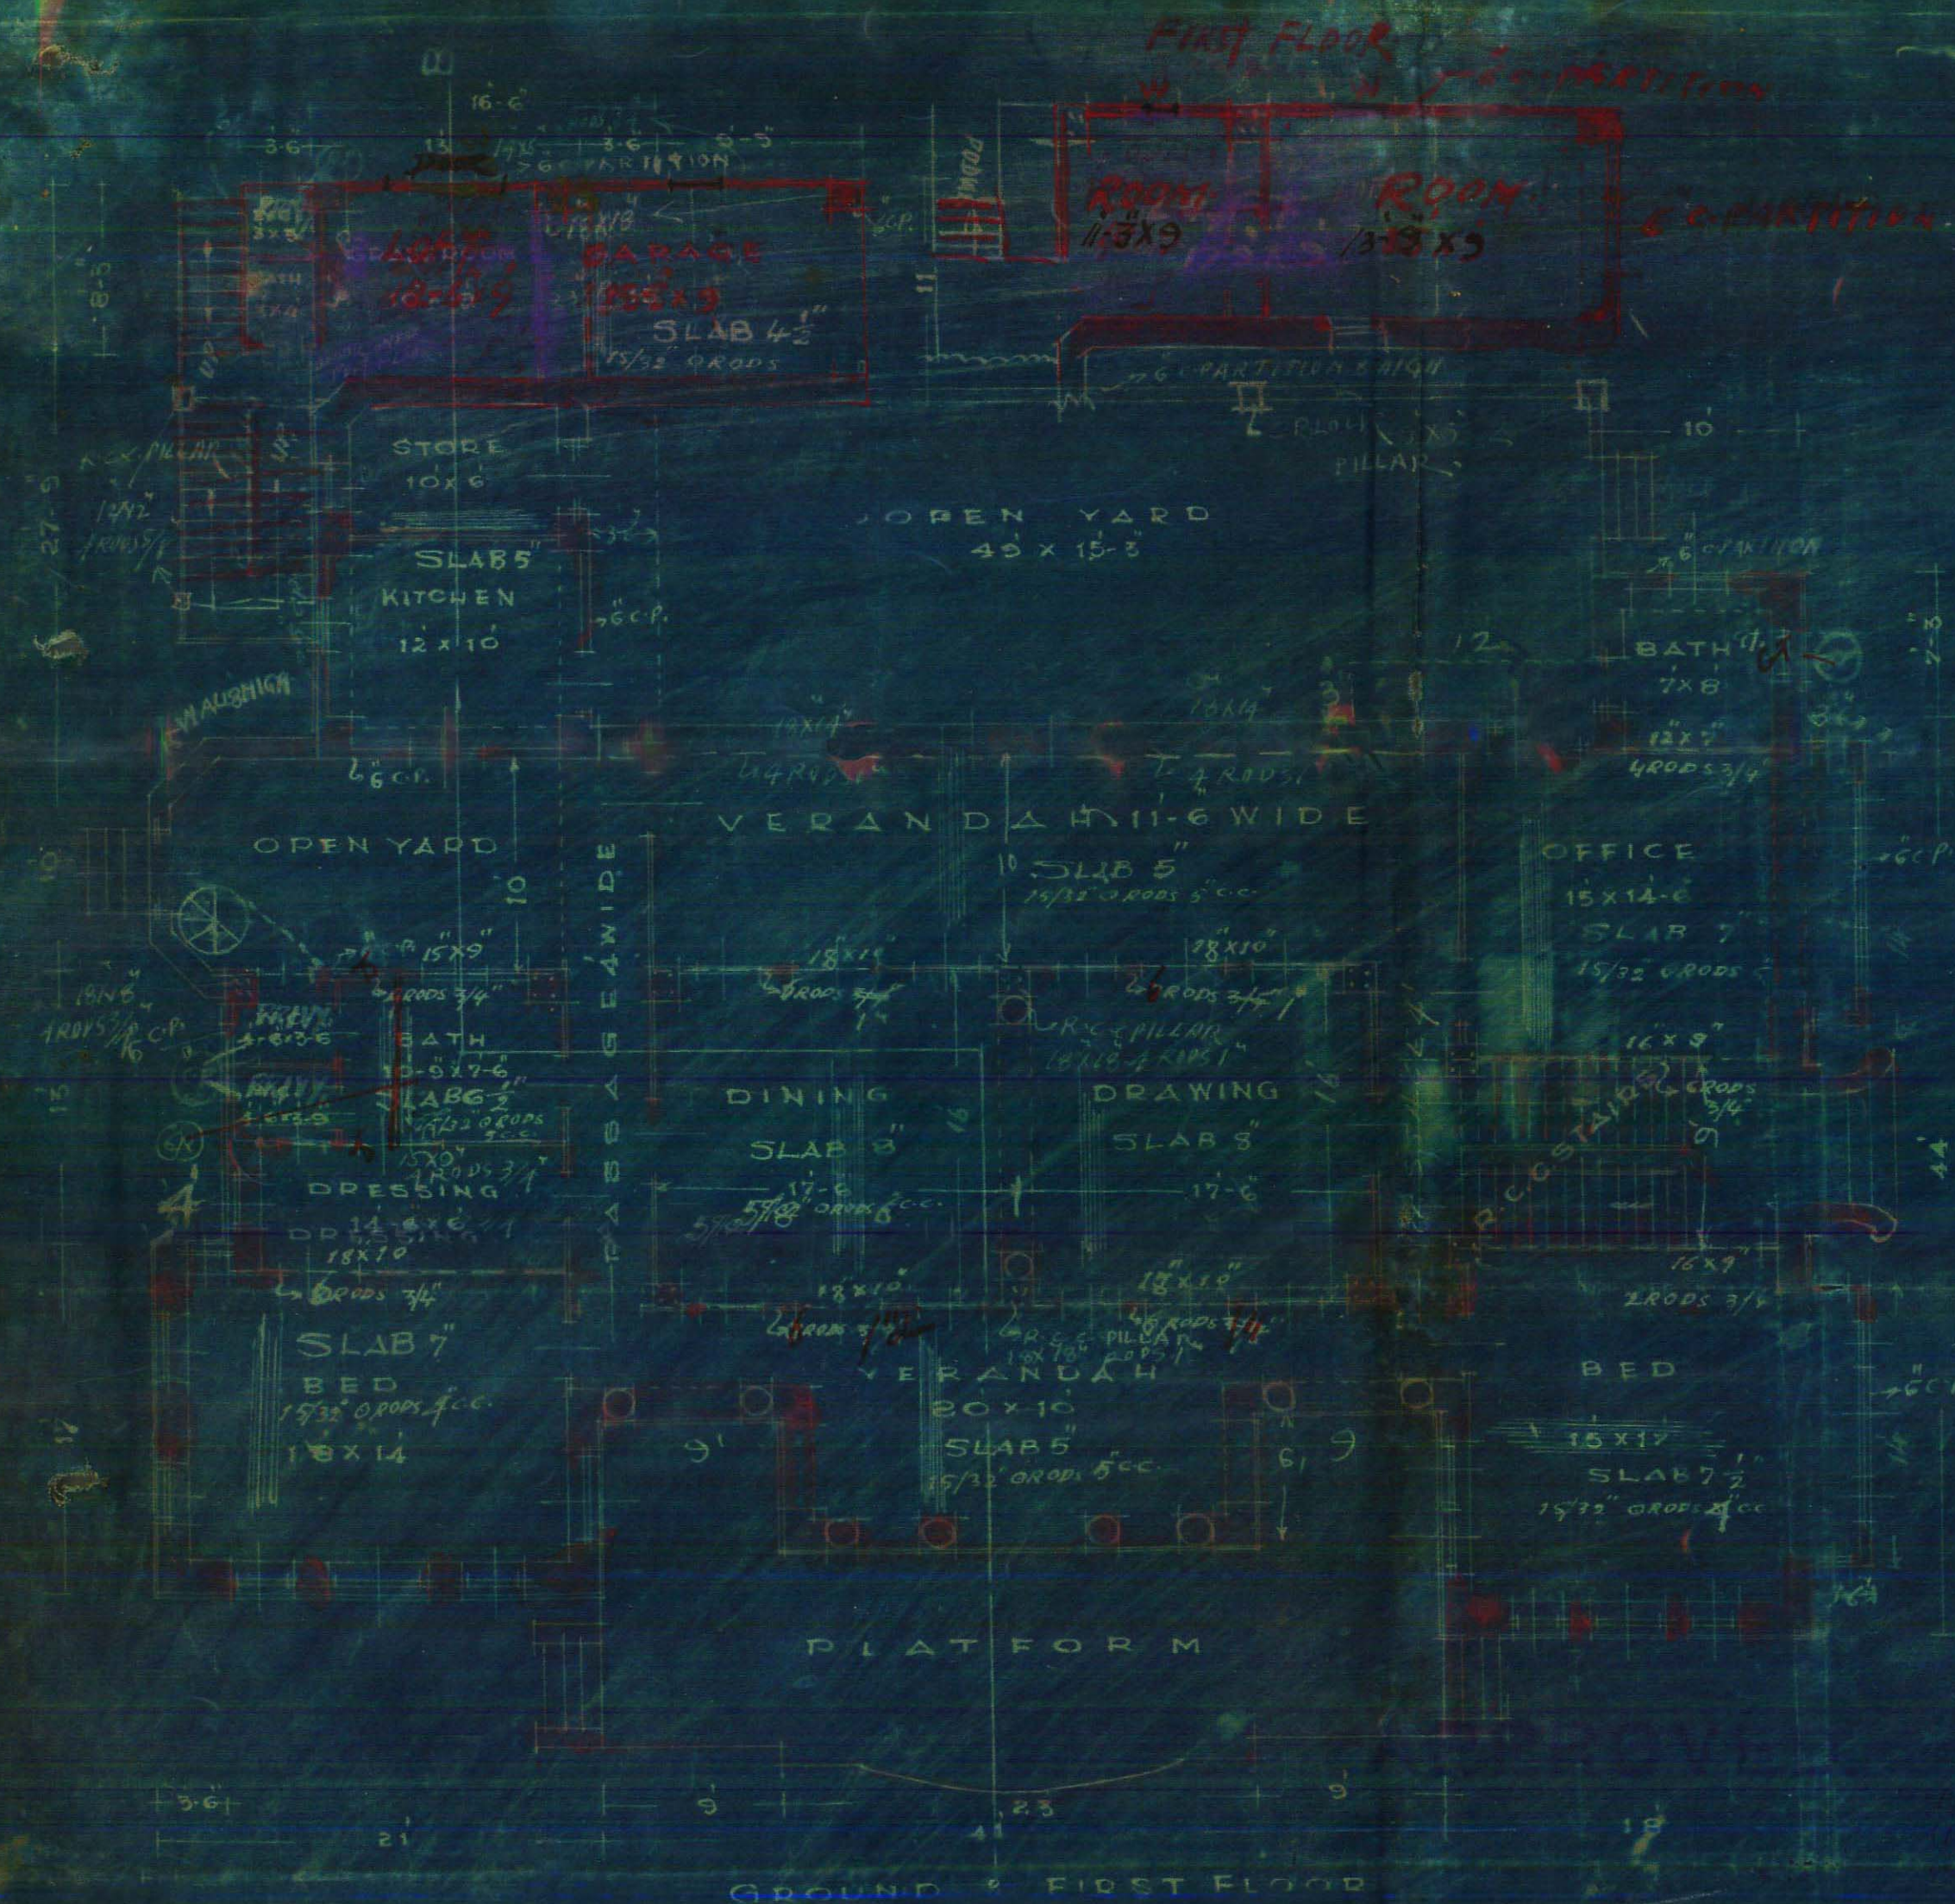

SECTION ON A.B.

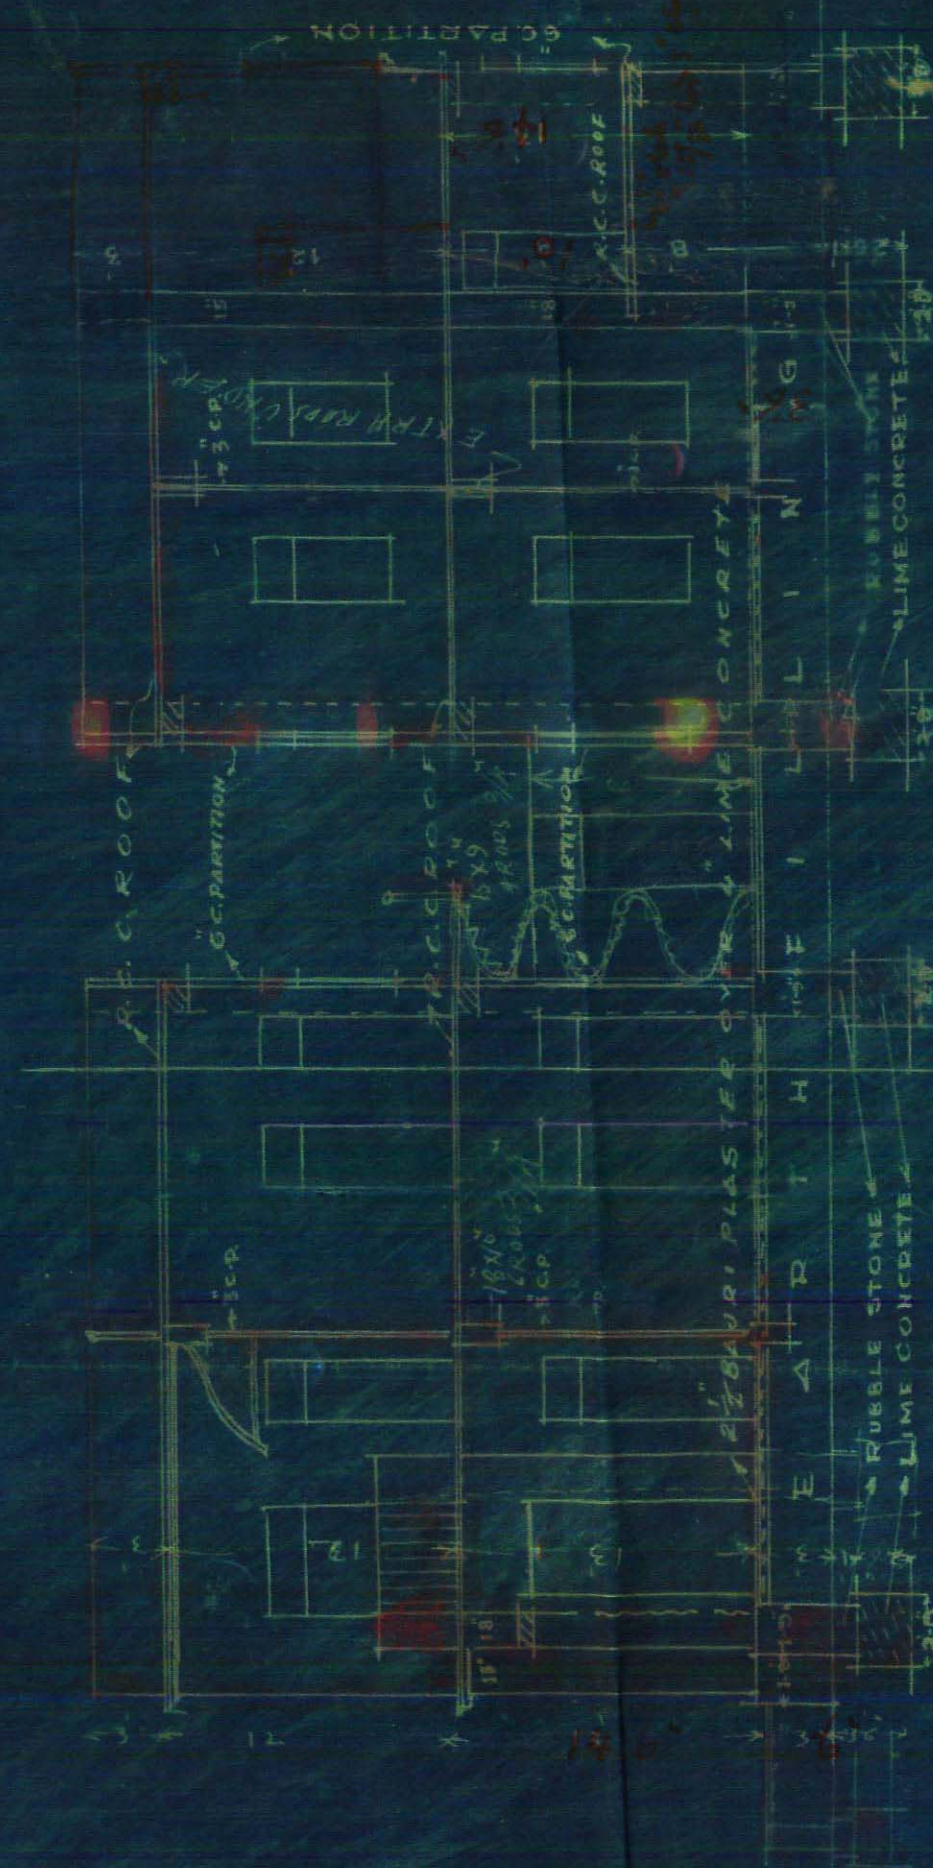

CEMENT LINTELS


SPAN	5-6	TO 4-7	4 RODS 3/8"
"	2-6	TO 3-5	3 RODS 3/8"
"	1-6	TO 2-5	3 RODS 3/8"
"	4-6	TO 5-7	4 RODS 3/8"
"	5-6	TO 6-7	5 RODS 3/8"
"	6-6	TO 7-11	5 RODS 3/8"
"	7-6	TO 12-12	4 RODS 3/8"

TOTAL AREA 1200 Sq. YDS.

BUILT AREA 398.24 Sq. Yds.


A	1 x 44	x 18	= 792
B	1 x 41	x 39.5	= 1619.5
C	1 x 30	x 21	= 630
D	1 x 7.25	x 10	= 72.5
E	1 x 12	x 3	= 36
F	1 x 27.75	x 16.5	= 457.87
G	1 x 9.75	x 11	= 107.25
H	1 x 8.25	x 3.5	= 28.87
			3743.34
DEDUCT			- 163.5
	1 x 15 x 4	= 60	
	2 x 9 x 6	= 108.0	
		168.0	
			358.37
			3584.00 ÷ 9 = 398.24 YDS

PLAN
SHOWING PROPOSED BUNGALOW
ON PLOT No 56/6. SHEET No J.M.3.
FOR
THE HYDERABADI AMIL CO-OPERATIVE
HOUSING SOCIETY
SCALE 8 FT. TO 1 IN.

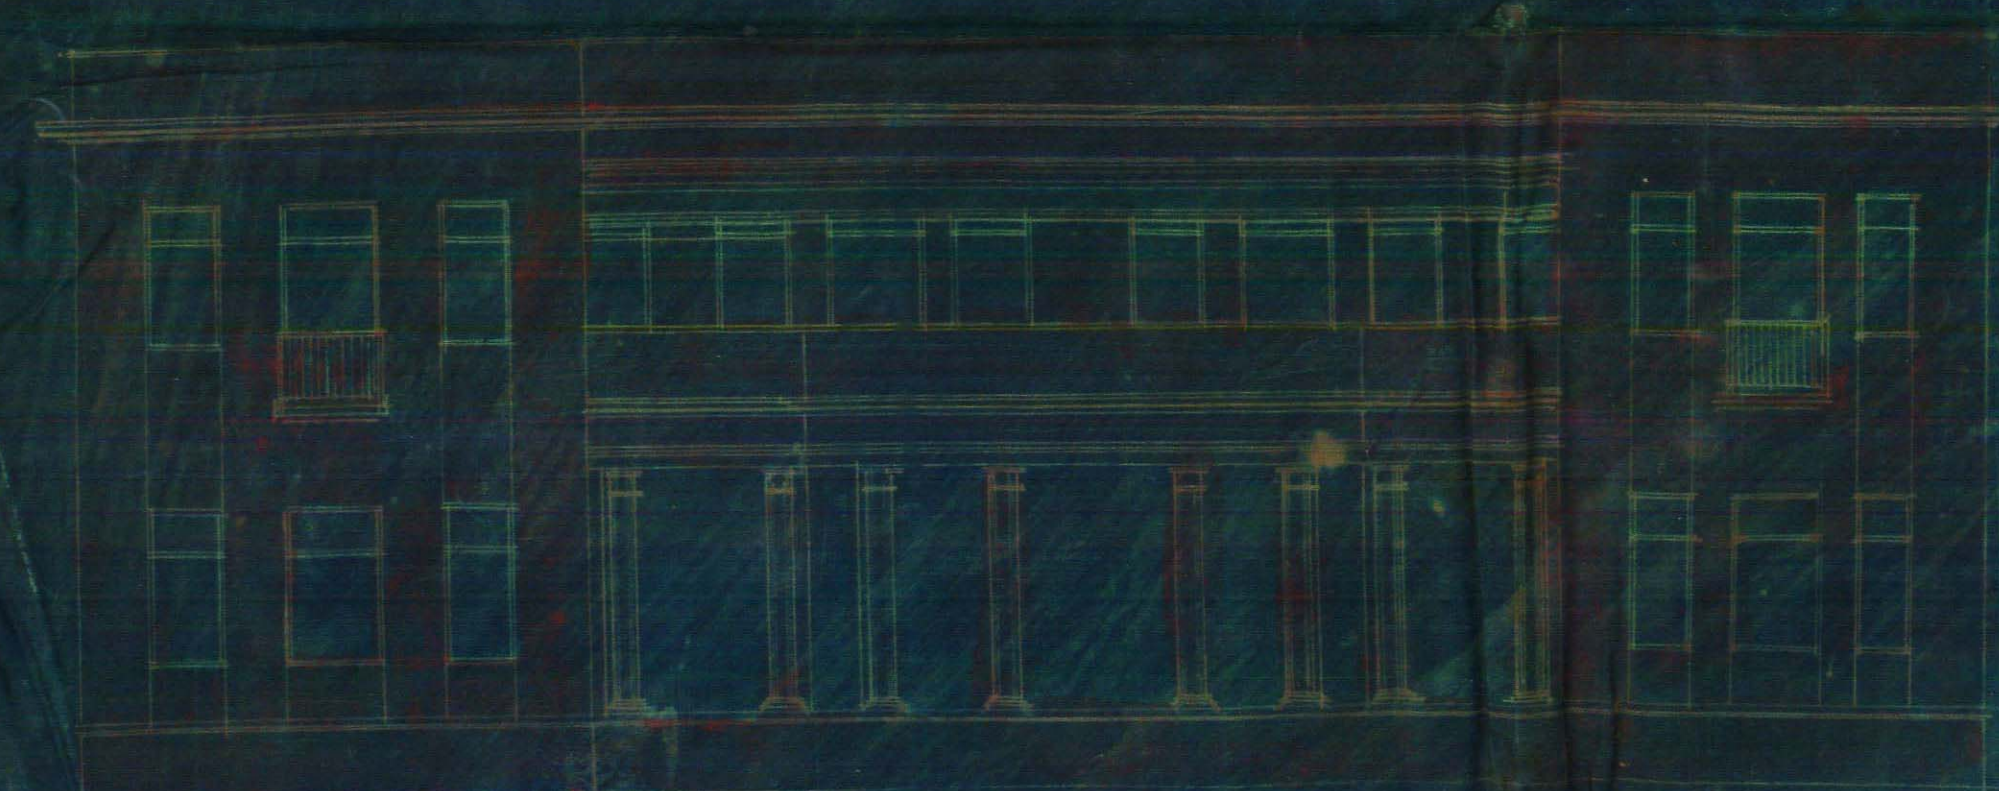

ELEVATION

LONGITUDINAL SECTION OF TEAM () CROSS SECTION OF TEAM

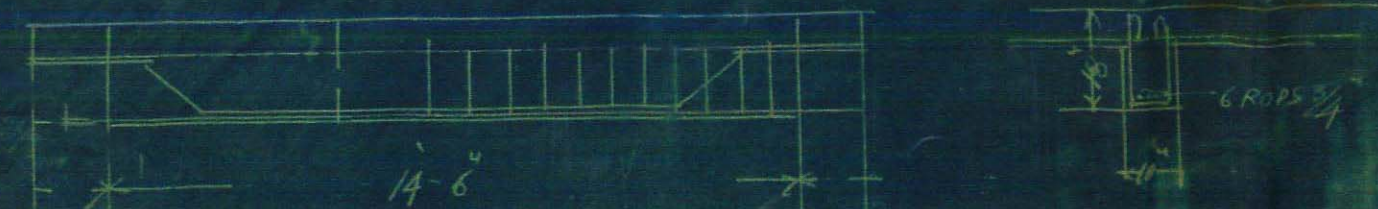

Tharamal Bilaram
LANDLORD

Tharamal Bilaram
HON. SECRETARY
THE HYDERABADI AMIL CO-OPERATIVE
HOUSING SOCIETY LTD.

NARAYAN M. GIDYANI & Co.
ARCHITECTS & SURVEYORS
KARACHI

BLOCK PLAN
SCALE 20 FT. TO 1 IN.

