



Form No. 37/A-500-12-7-26.

BUILDING COMPLETION REPORT.

MUNICIPAL ENGINEER'S OFFICE,

Karachi, 4-7- 1928

To

THE ENGINEER,

KARACHI MUNICIPALITY.

SIR,

I beg to report the building work on plot No. 26 Sheet J. 1/3Freer Town Quarter owned by Mr. Lalji Lakhmidassome time ago
completed according to the plan approved by the Municipality. Orders are requested to file the correspondence.

Yours obediently,

4/6/28 2/2/28Building Surveyor "A" Section,
Karachi Municipality.N. L. S. 8082 of 1928Karachi, 4-7- 1928Copy to the Assessor and Collector for
information4/7/28

B. SC., A. M. INST. C. E.,

Land Manager & Architect.

Karachi Municipality.

2

Heritage
FOUNDATION

KMR.CDD.FrQ.1925-1928.01

Form No. 6-200-13.7.24.

No. L. M. A.

7687

OF 192

MUNICIPAL ENGINEER'S OFFICE,

Karachi,

19 AUG 1925

192

MEMO.


Building Surveyor Section Frere Town is informed
that Mr. Lajji Lakhmadas has been permitted
to put down
his house
on plot No. 26 J-1 B Street
Frere Town Quarter, report should be made to the
undersigned when house is completed.

Small
copy
only

Sketch at the back

Executive Engineer,
Karachi Municipality.

18 AUG. 1925

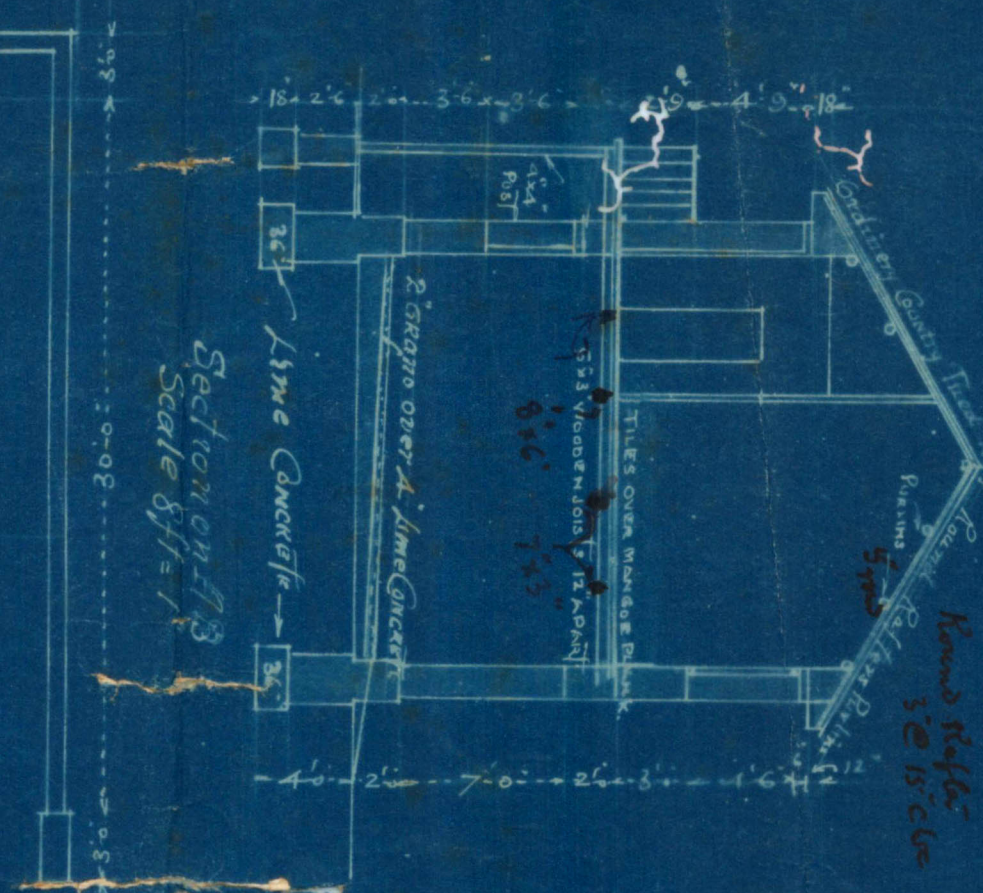

Elevation.
Scale 8 ft = 1"

AREA OF THE PLOT 4200 SQ. YDS.
AREA OF THE MAIN BUNGLOW WITH OUT-HOUSES
AS PREVIOUSLY CONSTRUCTED AND APPROVED BY
THE MUNICIPALITY 700 SQ. YDS.
AREA OF PROPEL EXTENSION TO OUTHOUSES 53,665 SQ. YDS.

①

3-1 (Blue Side)


3-2 (Back Side)

KMR.CDD.FrQ.1925-1928.01

F.T. 4.

8

Commanght Road

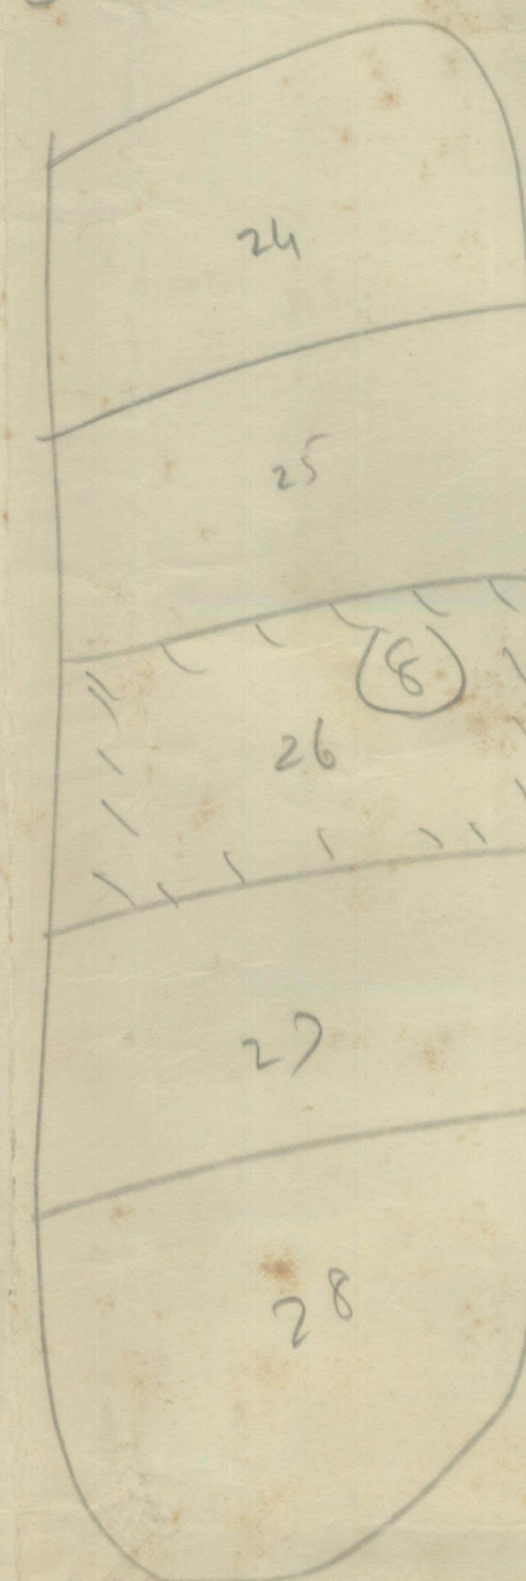

Ratu Island Road

Chutis Road