


AMENDED PLAN
OF BUILDING ON PLOT NO 3A - F 14
R A M BAUGH QUARTER
SCALE 5' = 1"

FIRST & SECOND FLOOR



THIRD FLOOR

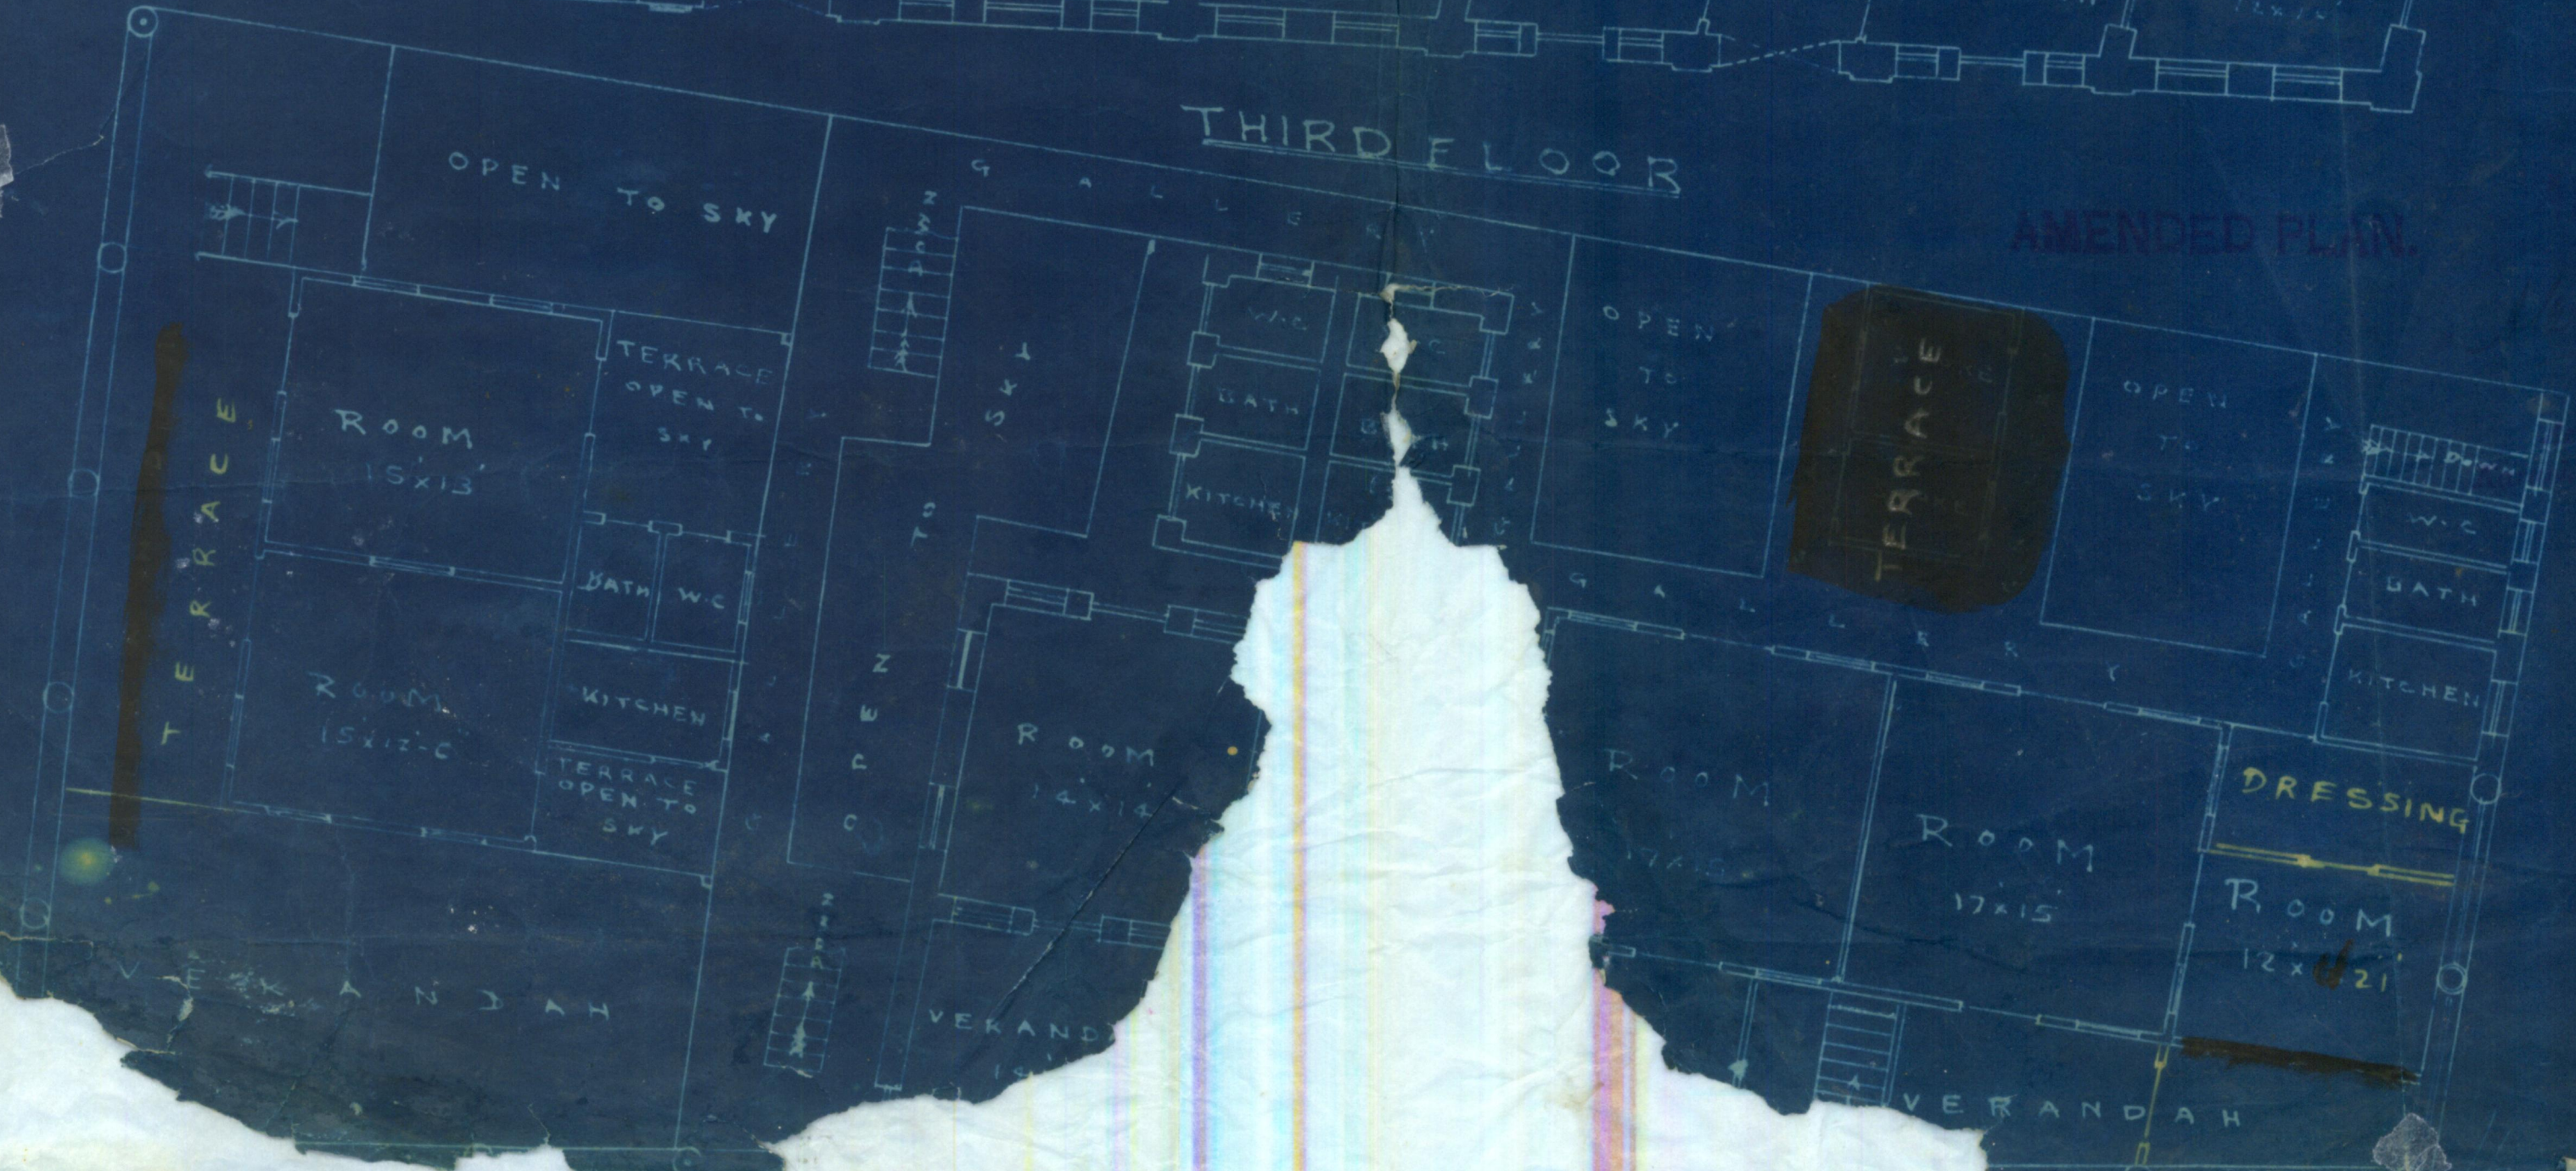

AMENDED PLAN

AMENDED PLAN
OF BUILDING ON PLOT NO 3A & E 14
R. A. M. B. O. G. H. QUARTER
SCALE 2"=1'

APPROVE

15/4
Barington Bros.

M. C., A. M. I. C. E.
Engineer,
Karachi Municipality

GROUND FLOOR



SITE PLAN
SCALE 20' = 1"

3
BUILDING




BURNS ROAD

ROBSON ROAD 45

Barington Bros.

AMENDED PLAN
OF BUILDING ON PLOT NO 3A - F 14
RAMBAUGH QUARTER
SCALE 8"=1"

GROUND FLOOR

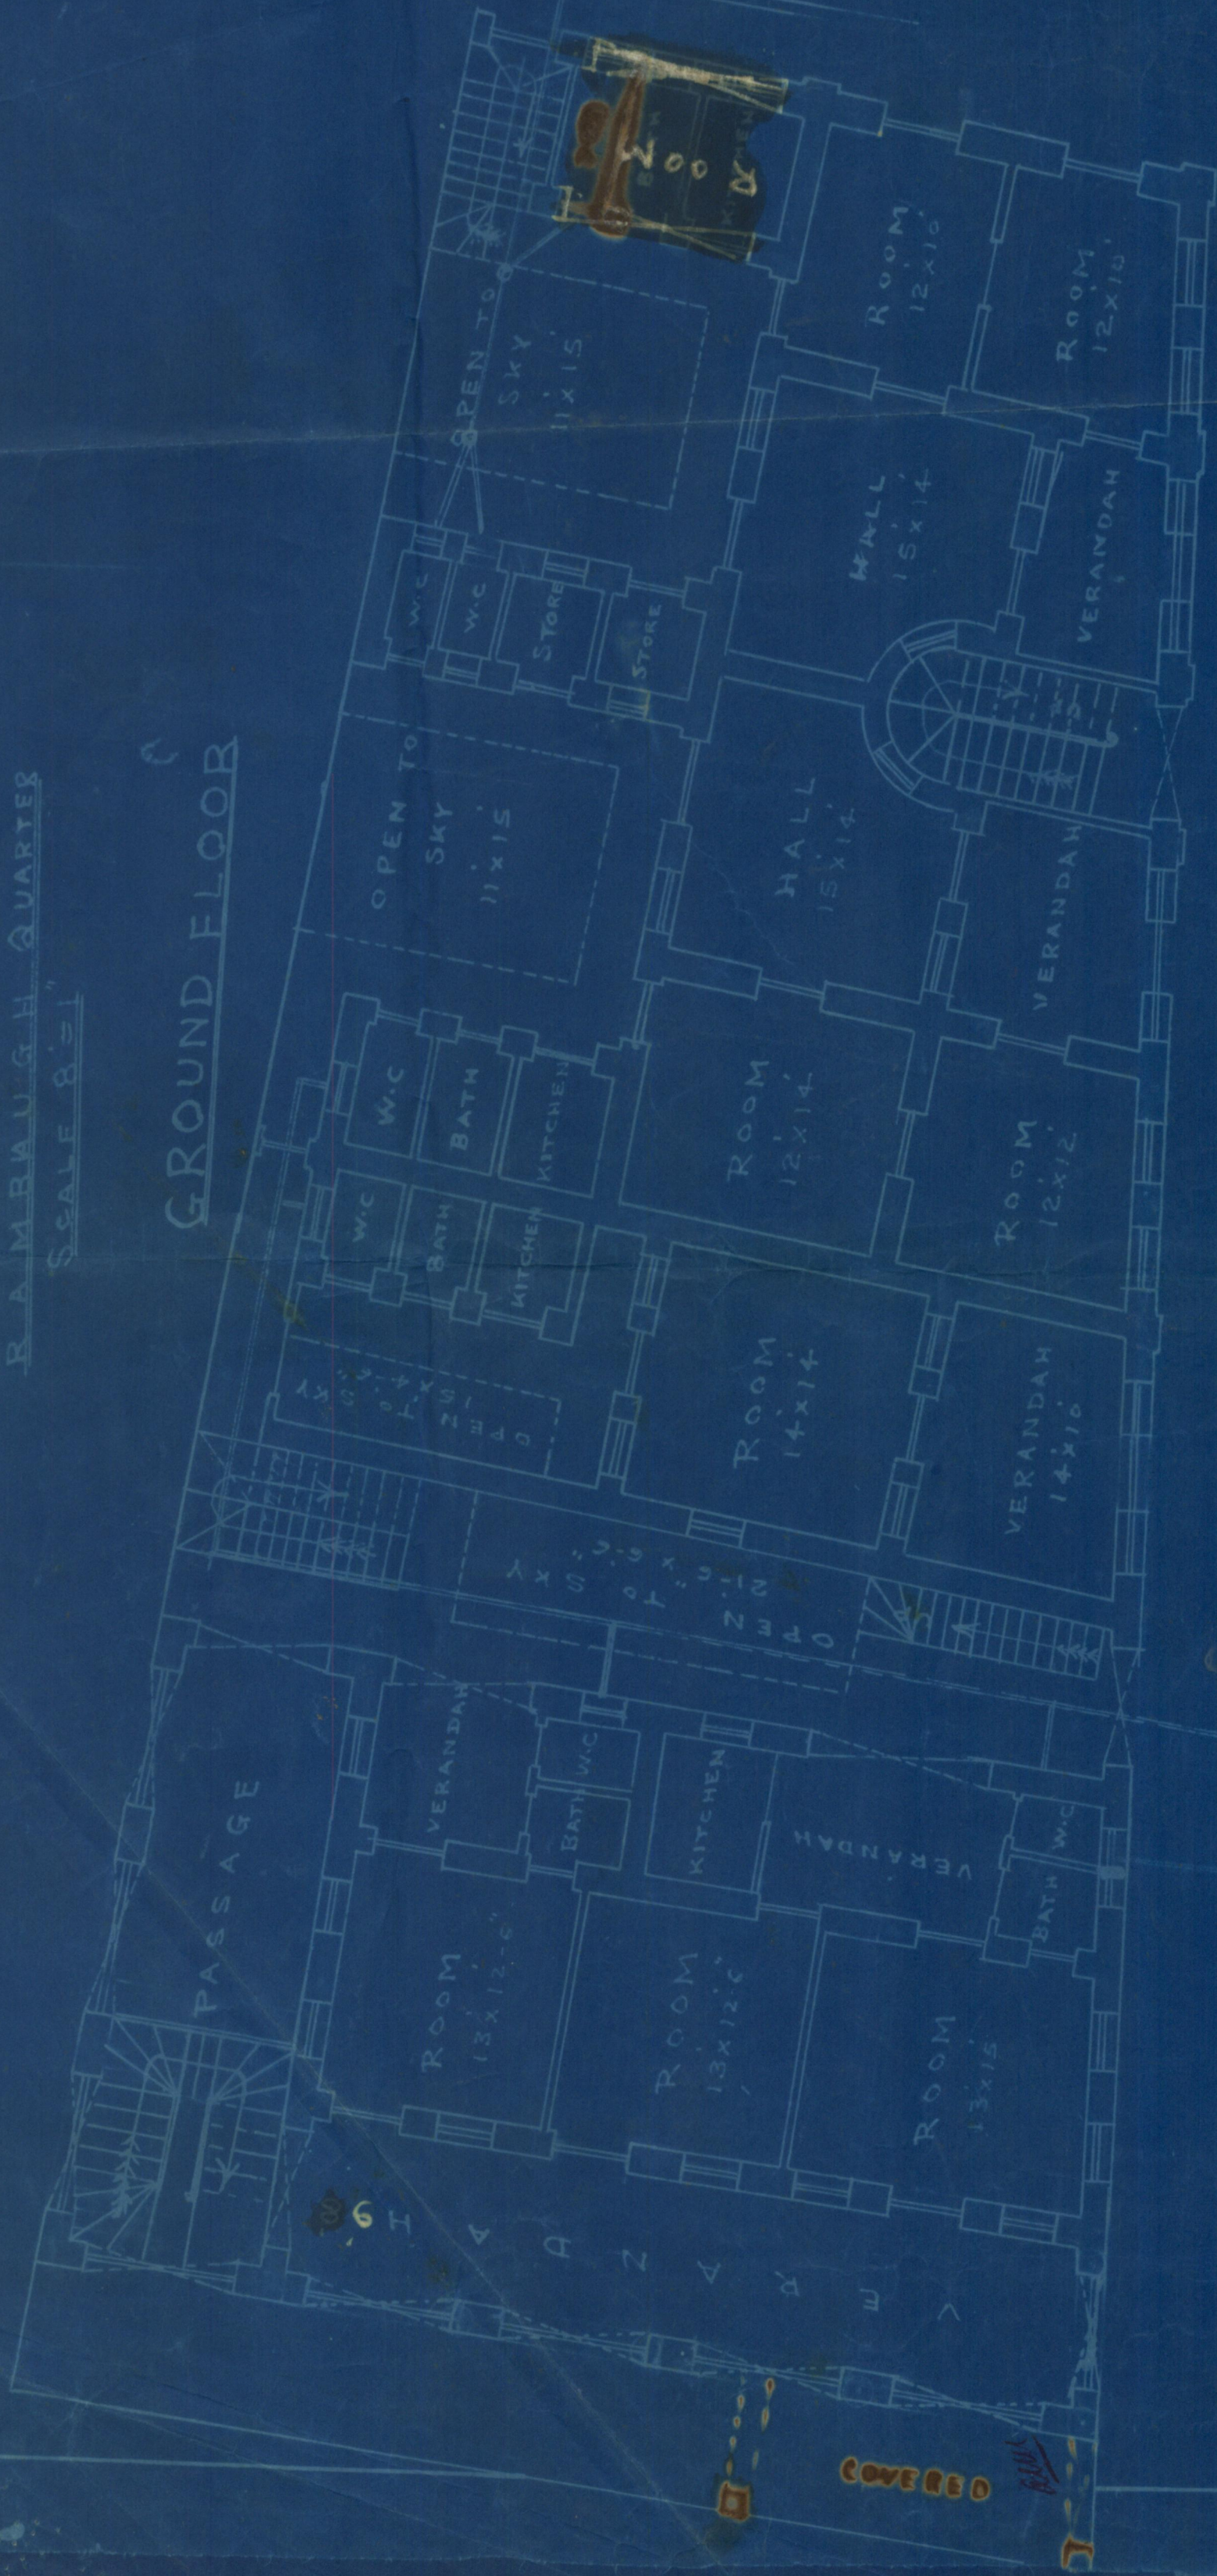

AMENDED PLAN

SITE PLAN
SCALE 20"=1"

N

BUILDING

BURNS ROAD

ROBSON ROAD 45

Harvey H. Brown

AMENEF PLAN

OF BUILDING ON No 3A - F 14

M. I. M. E.

AMENDED PLAN
OF BUILDING ON PLOT NO 3A - F 14
R A M A U G H Q U A R T E R
SCALE 8'-1"


PROJ.

15/4 *Bunning Bros.*

M. C. J. M. I.

Karachi Municipal

FIRST & SECOND FLOOR

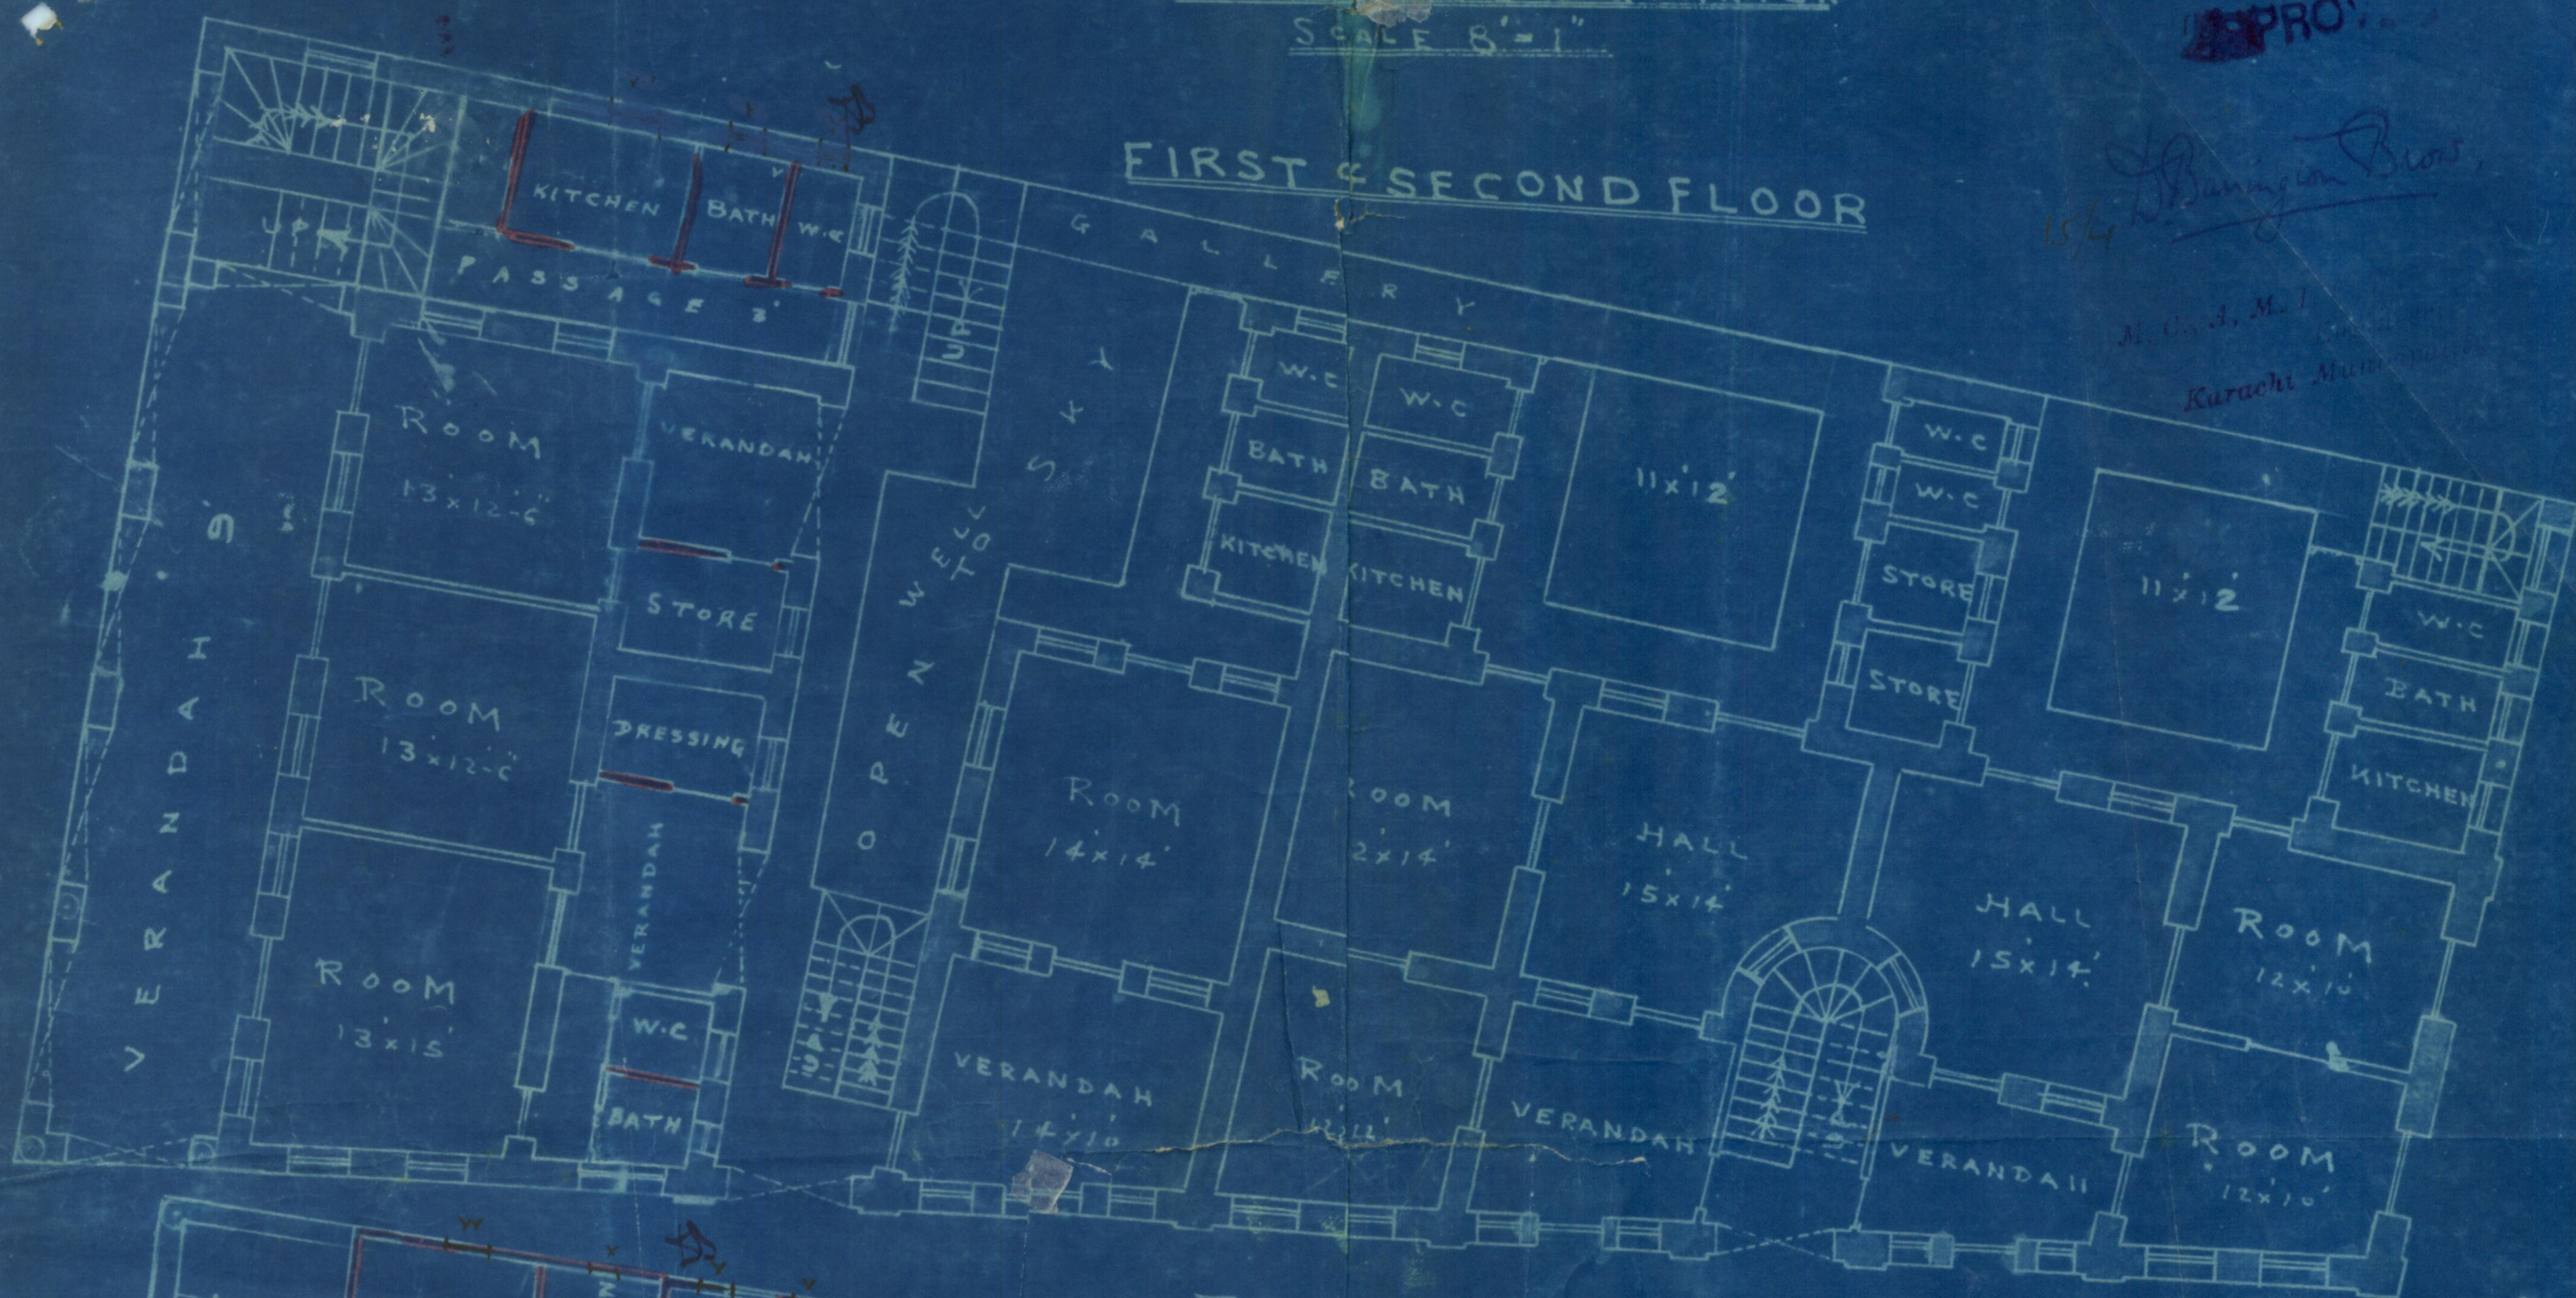

THIRD FLOOR



by J. S. B. S.